

PAINTED ISLAND
STA. 2+244 RT. - STA. 2+335 RT.

REMOVING SIGNS
6 EACH

REMOVAL & DISPOSAL OF GUARDRAIL
STA. 2+267 RT. - STA. 2+324 RT.
STA. 2+309 LT. - STA. 2+363 LT.


PAINTED CURB
STA. 2+244 - STA. 2+253 (MEDIAN ISLAND)
STA. 2+314 RT. - STA. 2+333 RT.
STA. 2+355 LT. - STA. 2+373 LT.

ANCHOR FOR STEEL BEAM GUARDRAIL
STA. 2+322 RT.
STA. 2+311 LT.

STEEL BEAM GUARDRAIL
STA. 2+278 RT. - STA. 2+320 RT.
STA. 2+313 LT. - STA. 2+352 LT.

MANUFACTURED TERMINAL SECTION (FLARED)
STA. 2+267 RT. - STA. 2+278 RT.
STA. 2+352 LT. - STA. 2+363 LT.


TRAILING END TERMINAL
STA. 2+320 RT. - STA. 2+324 RT.
STA. 2+309 LT. - STA. 2+313 LT.

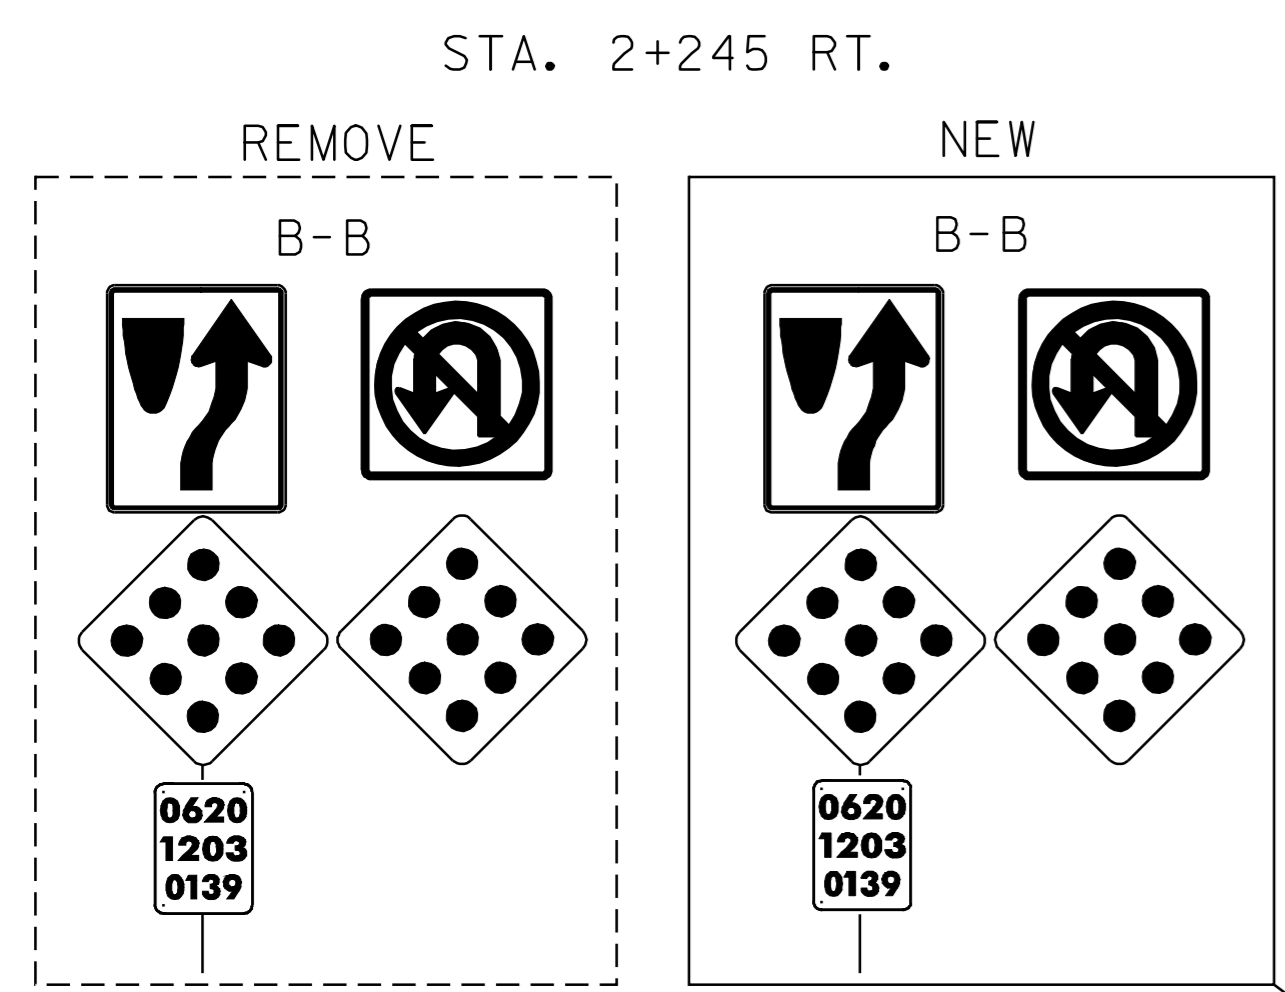

150 mm YELLOW LINE W/300 mm YELLOW DIAGONALS

BEGIN BASE LINE
STA. 2+224.113 =
MM 1.382

TO INTERSTATE 89

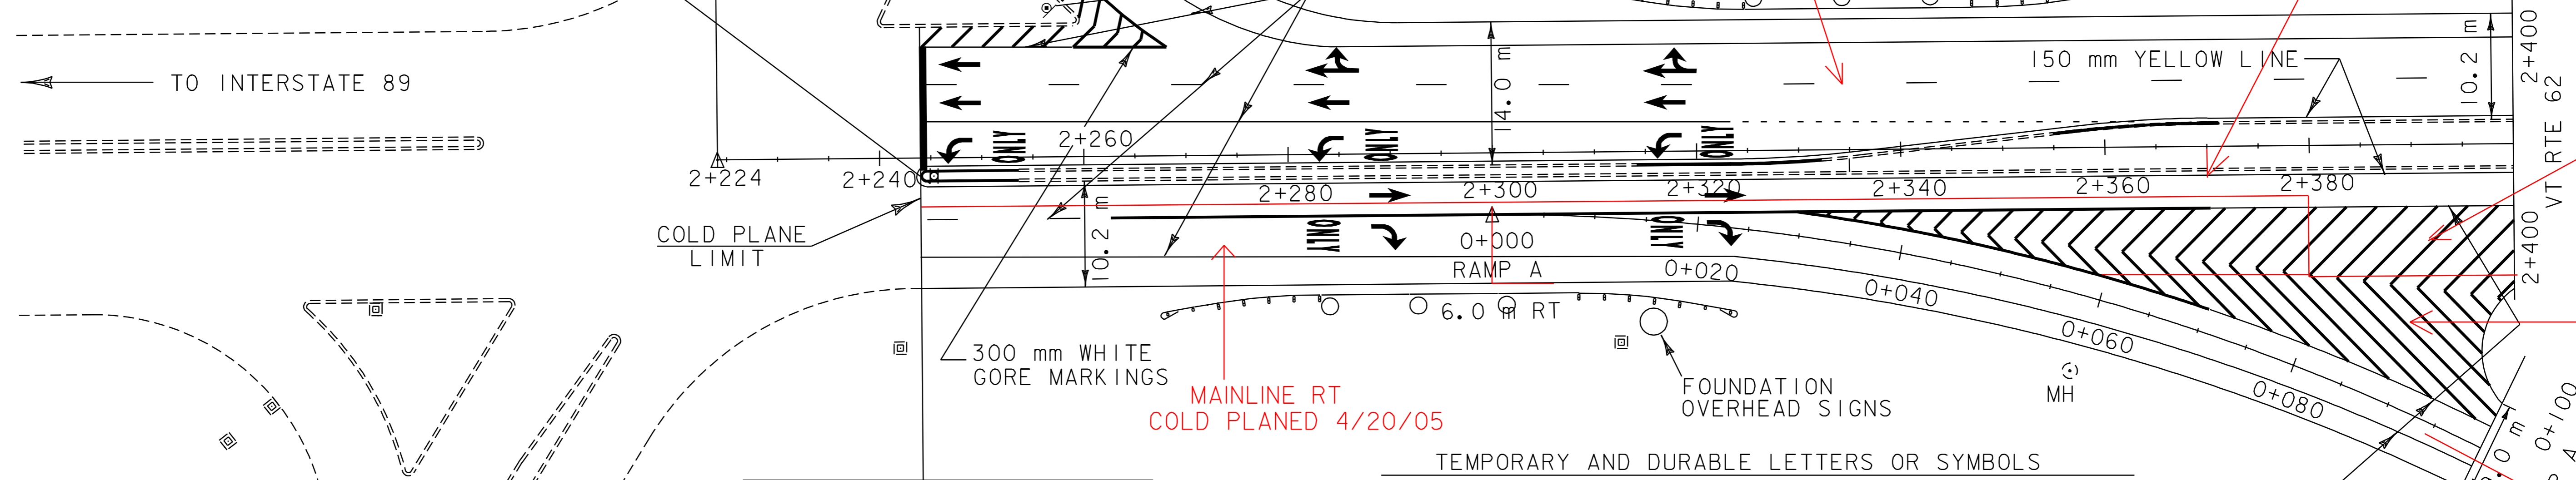

**BEGIN STP 2321(1)S
VT RTE 62
BERLIN
STA. 2+244.00 = MM 1.394**

TEMPORARY AND DURABLE 150 mm WHITE LINE

STA. 2+255 LT. - STA. 2+400 LT. (SOLID)
STA. 2+244 LT. - STA. 2+400 LT. (DASHED)
STA. 2+244 LT. - STA. 2+322 LT. (SOLID)
STA. 2+322 LT. - STA. 2+369 LT. (DOTTED)
STA. 2+244 RT. - STA. 2+263 RT. (DASHED)
STA. 2+244 RT. - STA. 2+300 RT. (SOLID)
STA. 0+000 RT. - STA. 0+100 RT. (SOLID)
STA. 0+070 LT. - STA. 0+100 LT. (SOLID)
STA. 2+370 RT. - STA. 2+400 RT. (SOLID)
STA. 2+244 LT. - STA. 2+259 LT. (SOLID)

TEMPORARY AND DURABLE 300 mm WHITE LINE

STA. 2+259 LT. - STA. 2+268 LT. (GORE MARKINGS)
STA. 2+263 RT. - STA. 2+370 RT. (GORE MARKINGS)
STA. 2+244 LT. - STA. 2+259 LT. (DIAGONALS)
STA. 2+370 RT. - STA. 2+400 RT. (DIAGONALS)
STA. 0+070 LT. - STA. 0+100 LT. (DIAGONALS)

TEMPORARY AND DURABLE LETTERS OR SYMBOLS

STA. 2+248 LT. (LEFT TURN ARROW, 2 THROUGH ARROWS)
STA. 2+252 LT. (ONLY)
STA. 2+284 LT. (THROUGH/RIGHT TURN ARROW, THROUGH ARROW, LEFT TURN ARROW)
STA. 2+284 RT. (ONLY)
STA. 2+289 LT. (ONLY)
STA. 2+289 RT. (THROUGH ARROW, RIGHT TURN ARROW)
STA. 2+318 LT. (THROUGH/RIGHT TURN ARROW, THROUGH ARROW, LEFT TURN ARROW)
STA. 2+318 RT. (ONLY)
STA. 2+322 LT. (ONLY)
STA. 2+322 RT. (THROUGH ARROW, RIGHT TURN ARROW)
STA. 2+253 LT. (YIELD)

TEMPORARY AND DURABLE 150 mm YELLOW LINE

STA. 2+250 LT. - STA. 2+260 LT. (SLIP RAMP)
STA. 2+244 - STA. 2+400 RT. & LT. OF MEDIAN ISLAND

2+400 TO 2+244 LT
COLD PLANED
5/2/05

GORE AREA LT
COLD PLANED
4/21/05

MAINLINE LT
COLD PLANED
4/21/05

MAINLINE RT
COLD PLANED
4/20/05

RAMP A
COLD PLANED
4/20/05

GORE AREA RT
COLD PLANED
4/20/05

TEMPORARY AND DURABLE 600 mm STOP BAR
STA. 2+244 LT. & RT.

TEMPORARY AND DURABLE 300 mm YELLOW LINE
STA. 2+250 LT. - STA. 2+260 LT. (DIAGONALS)
(SLIP RAMP)

**PAVING
PROJECT
LAYOUT
#1**

PROJECT NAME: BERLIN-BARRE CITY	PLOT DATE: 12-MAR-2007 11:09
PROJECT NUMBER: STP 2321(1)S	DRAWN BY: LOCKE
FILE NAME: pave/01b022/pb022.dgn	CHECKED BY: LOCKE
DESIGNED BY: LOCKE	SHEET 13 OF 39
pb022a1.i	