

REMOVING SIGNS

3 EACH

PAINTED CURB

STA. 2+544 - STA. 2+554 LT. & RT.

TEMPORARY AND DURABLE LETTERS OR SYMBOLS

STA. 2+495 LT. (YIELD)

BITUMINOUS CONCRETE GUTTERS AND TRAFFIC ISLANDS

STA. 2+540 LT. - RT.


REHABILITATION OF DI'S, CB'S, OR MH'S - CLASS I

STA. 2+545 MEDIAN


STA. 2+494 LT.

STA. 2+496 LT.

RETAIN

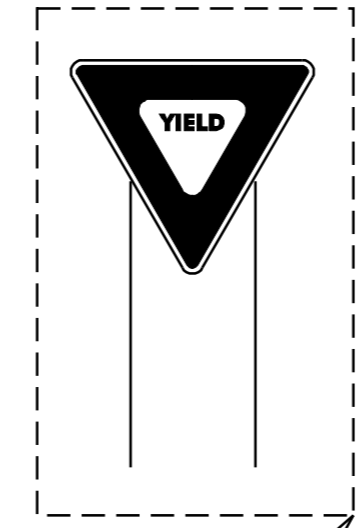

2+580 TO 2+400 LT  
& BERLIN STATE HIGHWAY  
APPROACH COLD PLANED 5/2/05

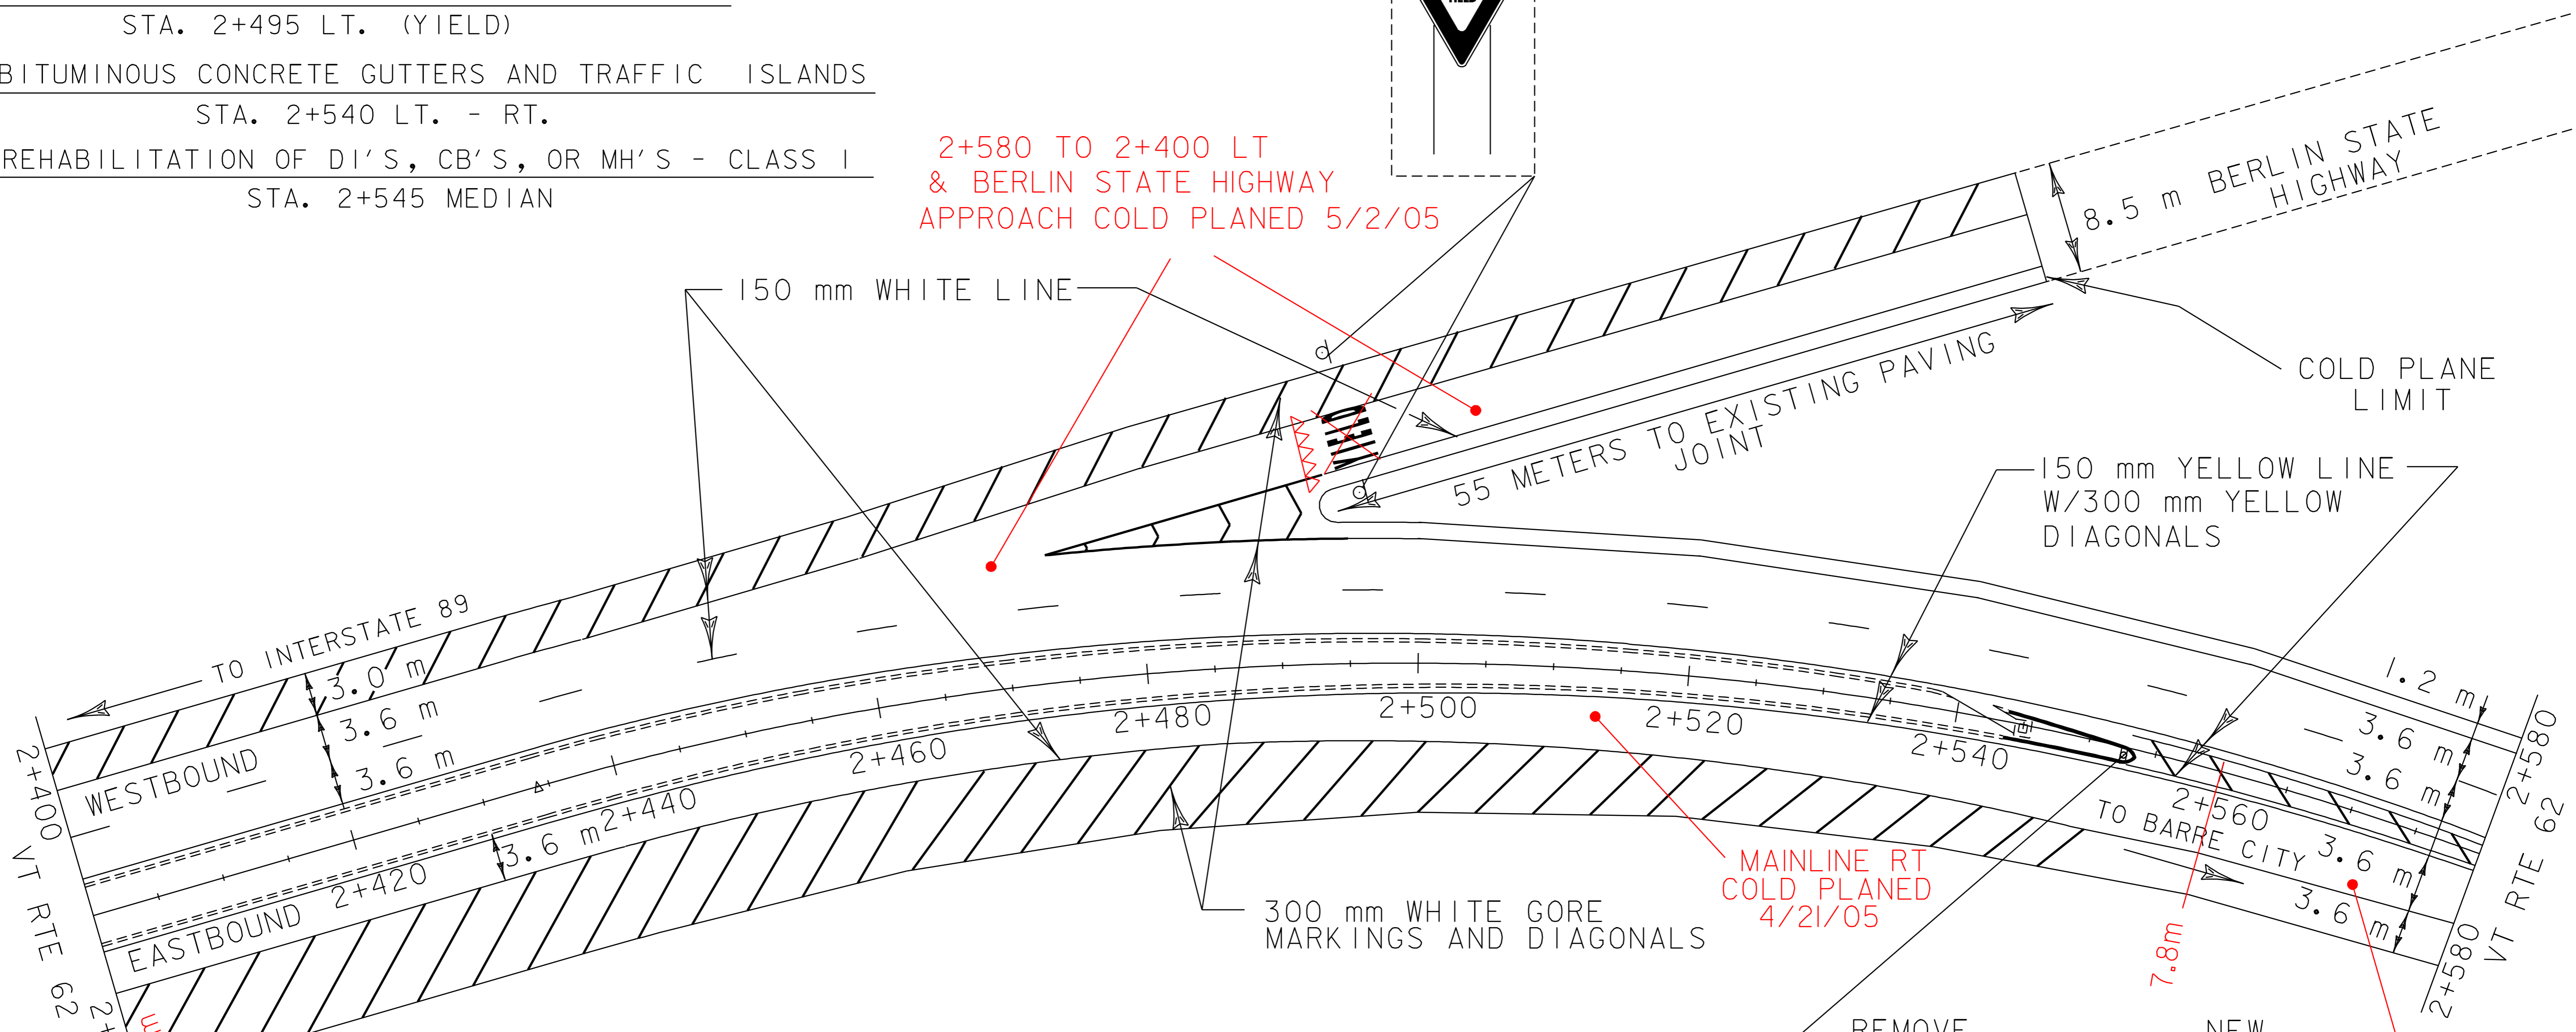

TEMPORARY AND DURABLE 150 mm WHITE LINE

- STA. 2+400 LT. (MAINLINE) - STA. 2+545 LT. (ALONG BERLIN STATE HIGHWAY) (SOLID)
- STA. 2+400 LT. - STA. 2+580 LT. (DASHED)
- STA. 2+495 LT. - STA. 2+545 LT. (ALONG BERLIN STATE HIGHWAY) (SOLID)
- STA. 2+495 LT. - STA. 2+580 LT. (SOLID)
- STA. 2+400 RT. - STA. 2+580 RT. (SOLID)

TEMPORARY AND DURABLE 150 mm YELLOW LINE



- STA. 2+400 LT. & RT. - STA. 2+580 LT. & RT. (SOLID)

TEMPORARY AND DURABLE 300 mm WHITE LINE

- STA. 2+400 RT. - STA. 2+551 RT. (DIAGONALS)
- STA. 2+474 LT. - STA. 2+495 LT. (GORE MARKINGS/DIAGONALS)
- STA. 2+400 LT. - STA. 2+541 LT. (DIAGONALS)

TEMPORARY AND DURABLE 300 mm YELLOW LINE

- STA. 2+555. LT. & RT. - STA. 2+580 LT. & RT. (DIAGONALS)

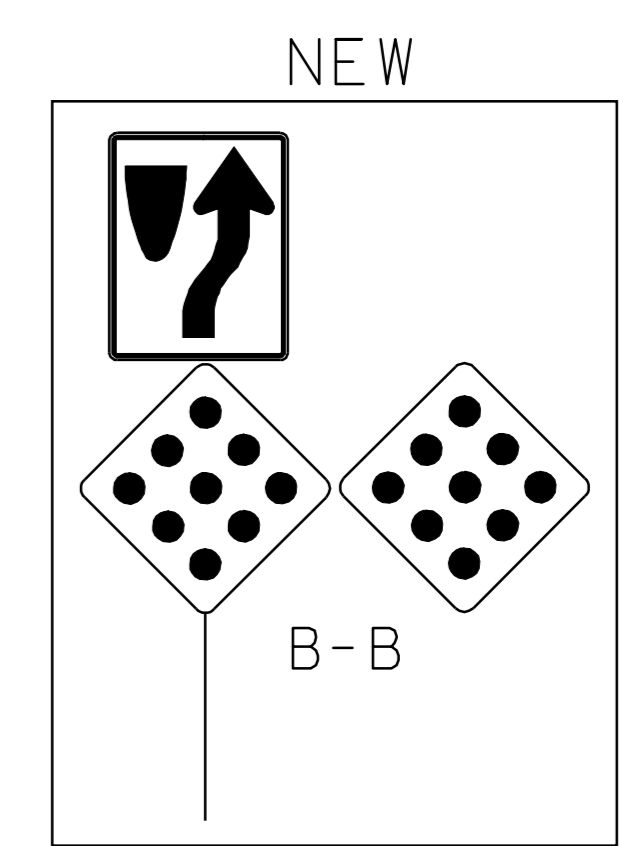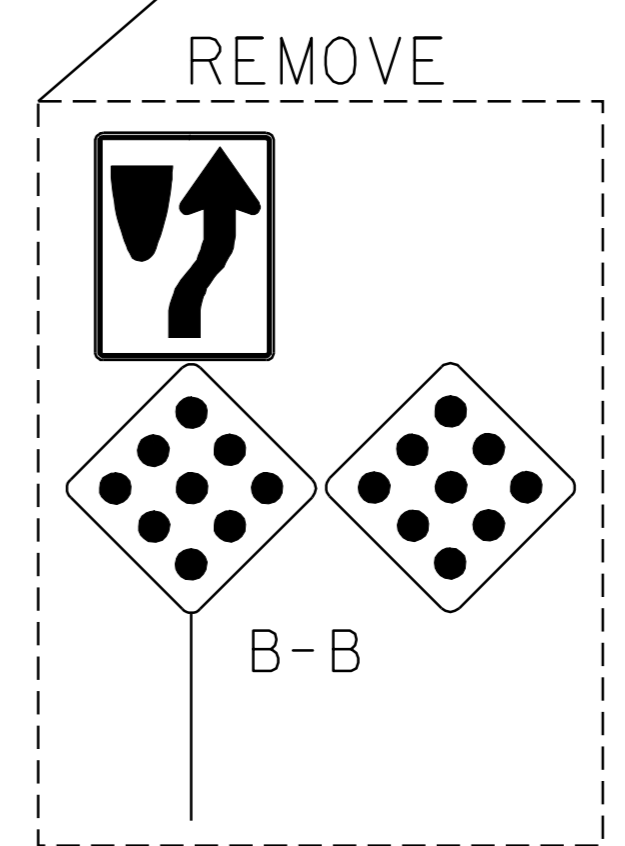

COLD PLANE  
7.8m WIDTH  
4/21/05  
2+560 TO  
2+580

STA. 2+553 RT.

<b>PAVING PROJECT LAYOUT #2</b>	PROJECT NAME: BERLIN-BARRE CITY	PLOT DATE: 12-MAR-2007 11:09
	PROJECT NUMBER: STP 232(I)S	DRAWN BY: LOCKE
	FILE NAME: /pave/01b022/pb022.dgn	CHECKED BY:
	PROJECT LEADER: WOOLLAVER	SHEET 14 OF 39