

TEMPORARY AND DURABLE 150 mm WHITE LINE


STA. 2+580 LT. - STA. 2+940 LT. (SOLID)
 STA. 2+580 LT. - STA. 2+940 LT. (DASHED)
 STA. 2+580 RT. - STA. 2+940 RT. (SOLID)

TEMPORARY AND DURABLE 150 mm YELLOW LINE

STA. 2+580 LT. & RT. - STA. 2+940 LT. & RT. (SOLID)

TEMPORARY AND DURABLE 300 mm YELLOW LINE

STA. 2+580 - STA. 2+597 (CENTERLINE/DIAGONALS)

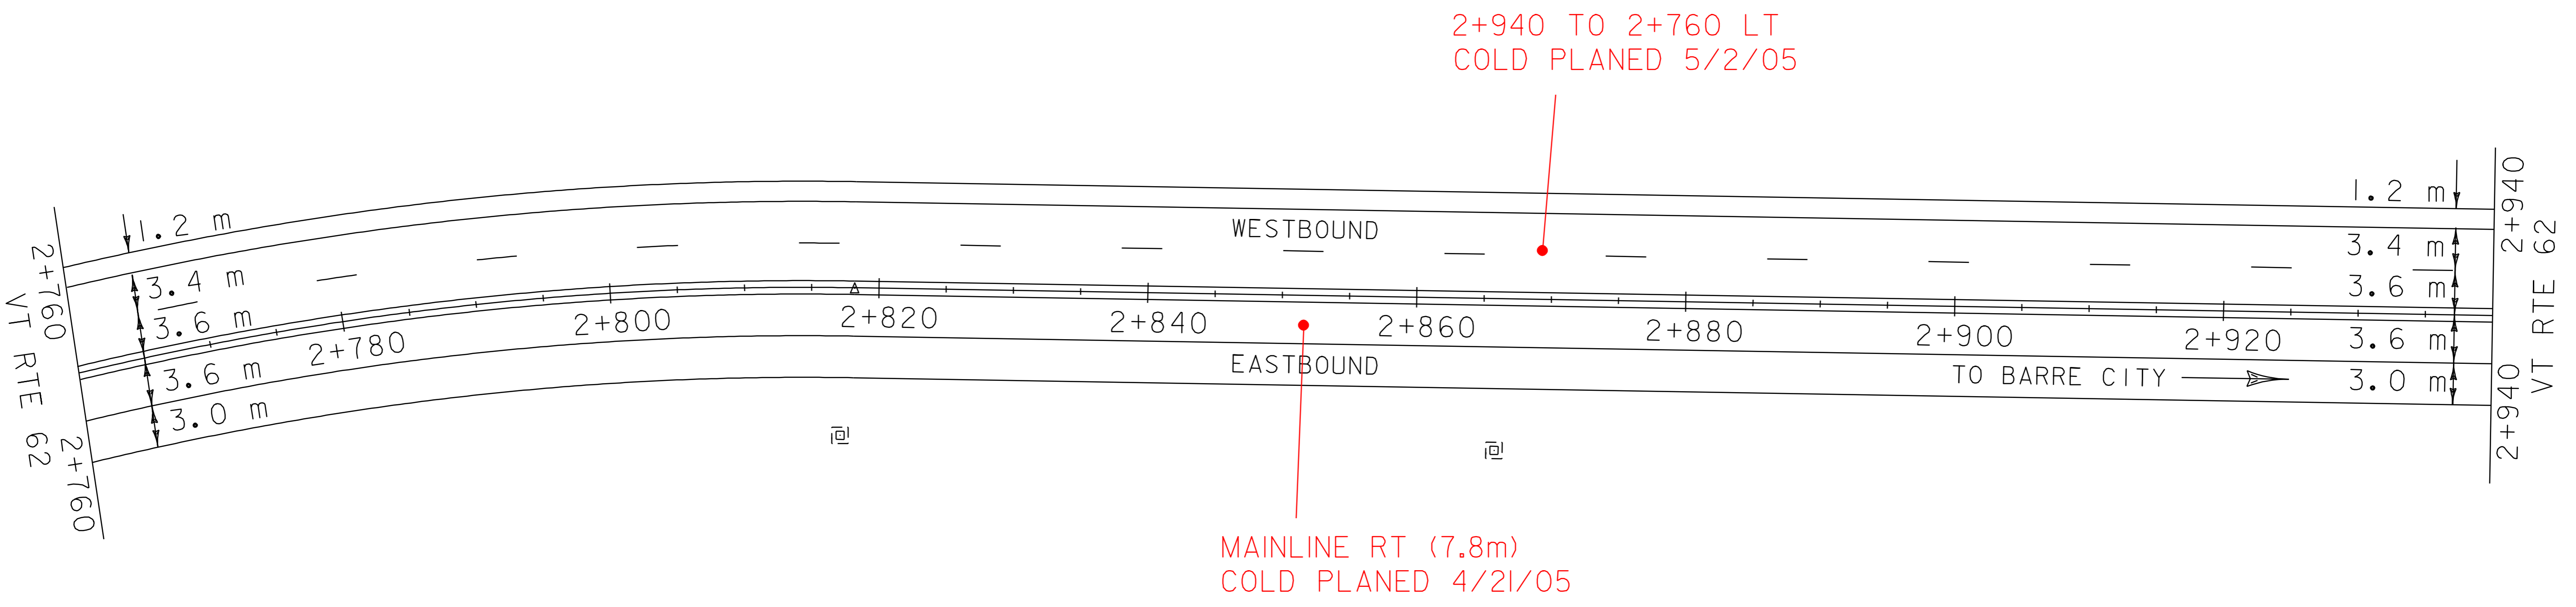

**PAVING
PROJECT
LAYOUT
#3**

PROJECT NAME: BERLIN-BARRE CITY	PLOT DATE: 12-MAR-2007 11:09
PROJECT NUMBER: STP 2321(1)S	DRAWN BY: LOCKE
FILE NAME: /pave/01b022/pb022.dgn	CHECKED BY:
DESIGNED BY: LOCKE	SHEET 15 OF 39
pb0221a3.1	