


TEMPORARY AND DURABLE 150 mm WHITE LINE
 STA. 2+940 LT. - STA. 3+300 LT. (SOLID)
 STA. 2+940 LT. - STA. 3+300 LT. (DASHED)
 STA. 2+940 RT. - STA. 3+300 RT. (SOLID)
 TEMPORARY AND DURABLE 150 mm YELLOW LINE
 STA. 2+940 LT. & RT. - STA. 3+300 LT. & RT. (SOLID)

REMOVAL AND DISPOSAL OF GUARDRAIL
 STA. 3+138 LT. - 3+300 LT.
 MANUFACTURED TERMINAL SECTION (FLARED)
 STA. 3+138 LT. - STA. 3+149 LT.
 STEEL BEAM GUARDRAIL
 STA. 3+149 LT. - STA. 3+300 LT.
 TREATED TIMBER CURB
 STA. 3+146 LT. - STA. 3+300 LT.

REHABILITATION OF DI'S, CB'S, OR MH'S - CLASS I
 STA. 3+216 LT.

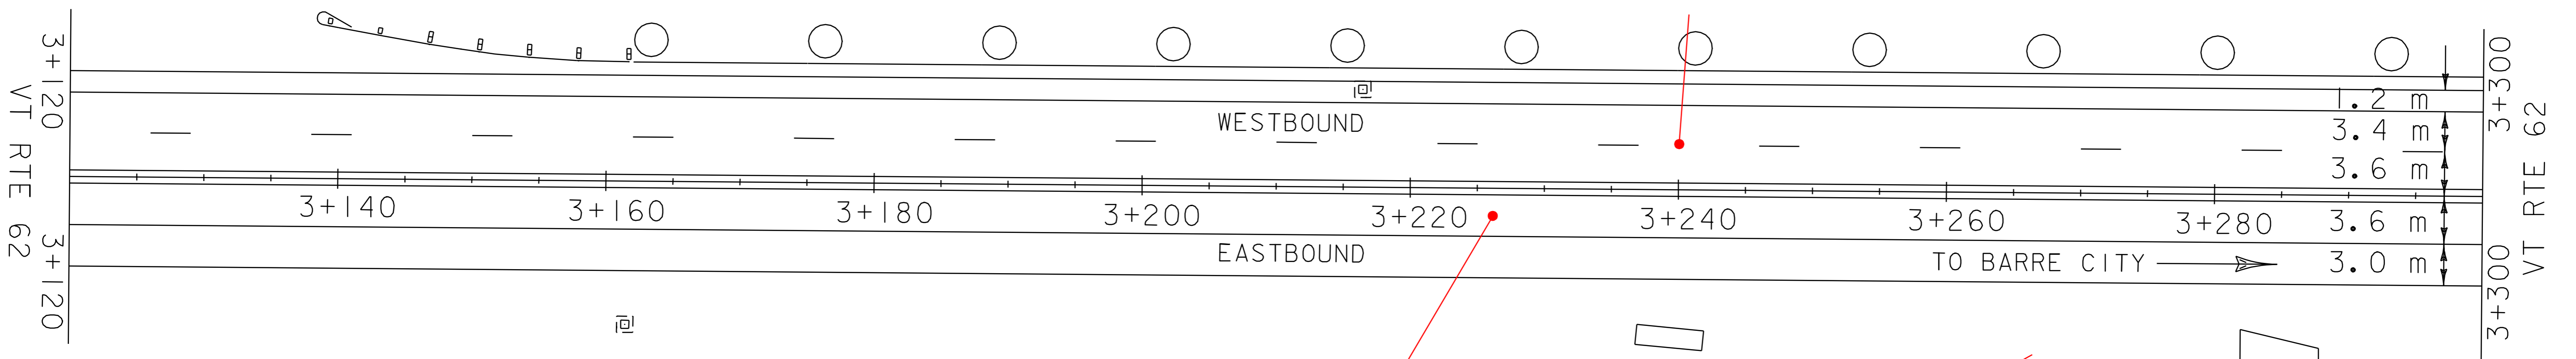

MAINLINE RT (7.8m)
 COLD PLANNED 4/21/05

~~STA. 3+237 - 3+242 RT.
 REMOVE
 EXISTING PAVED
 GUTTER
 (5 m X 1.5 m)
 REPLACE W/STONE FILL,
 TYPE I~~

~~STA. 3+282 - 3+287 RT.
 REMOVE
 EXISTING PAVED
 GUTTER
 (6 m X 3 m)
 REPLACE W/STONE FILL,
 TYPE I~~

REMOVAL OF PAVED GUTTERS
 NOT DONE, AS PER MEETING
 WITH CARL FIELDER, KEVIN LOCKE
 & CRAIG DIGIAMMARINO 4/8/05

PAVING PROJECT LAYOUT #4	PROJECT NAME: BERLIN-BARRE CITY	PLOT DATE: 12-MAR-2007 11:09
	PROJECT NUMBER: STP 2321(I)S	DRAWN BY: LOCKE
	FILE NAME: /pave/01b022/pb022.dgn	CHECKED BY:
	PROJECT LEADER: WOOLLAVER DESIGNED BY: LOCKE pb0221a4.i	SHEET 16 OF 39