

TEMPORARY AND DURABLE 150 mm WHITE LINE
 STA. 3+300 LT. - STA. 3+660 LT. (SOLID)
 STA. 3+300 LT. - STA. 3+660 LT. (DASHED)
 STA. 3+300 RT. - STA. 3+660 RT. (SOLID)

TEMPORARY AND DURABLE 150 mm YELLOW LINE
 STA. 3+300 LT. & RT. - STA. 3+660 LT. & RT. (SOLID)

BITUMINOUS CONCRETE GUTTERS AND TRAFFIC ISLANDS
 STA. 3+430 RT. - STA. 3+435 RT.

~~STA. 3+430 - 3+435 RT.
 REMOVE EXISTING PAVED GUTTER (5 m X 1.5 m)
 REPLACE W/STONE FILL TYPE I~~


NOT DONE
 SEE NOTE ON SHEET 16

REMOVAL AND DISPOSAL OF GUARDRAIL
 STA. 3+300 LT. - STA. 3+571 LT.

MANUFACTURED TERMINAL SECTION (FLARED)
 STA. 3+560 LT. - STA. 3+571 LT.

STEEL BEAM GUARDRAIL
 STA. 3+300 LT. - STA. 3+560 LT.

TREATED TIMBER CURB
 STA. 3+300 LT. - STA. 3+510 LT.

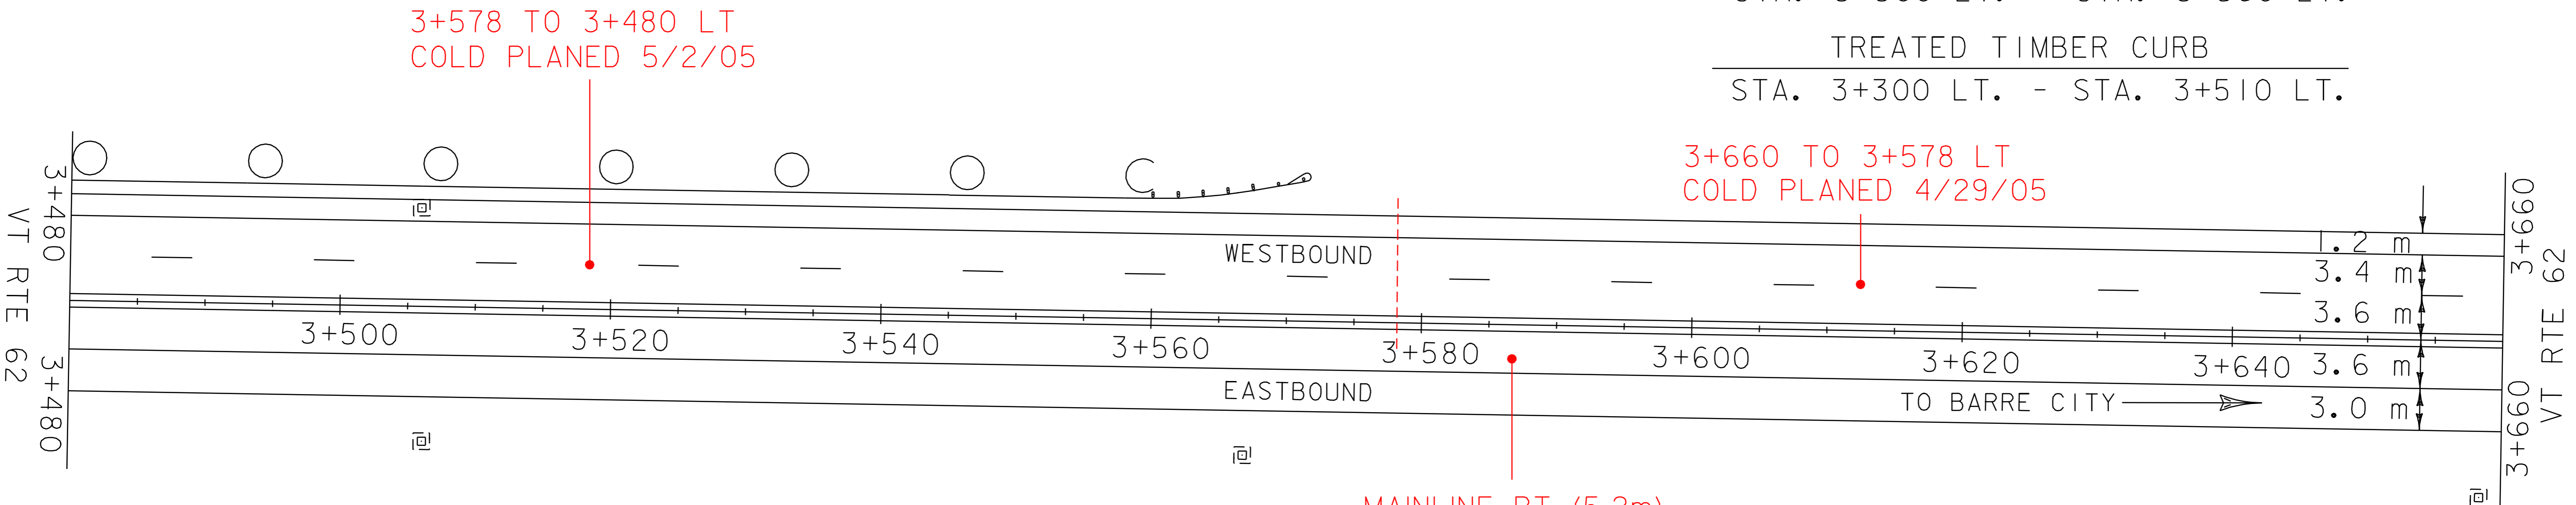

REHABILITATION OF DI'S, CB'S, OR MH'S - CLASS I
 STA. 3+308 LT.
 STA. 3+399 LT.
 STA. 3+506 LT.

PAVING PROJECT LAYOUT #5	PROJECT NAME: BERLIN-BARRE CITY	PLOT DATE: 12-MAR-2007 11:09
	PROJECT NUMBER: STP 2321(I)S	DRAWN BY: LOCKE
	FILE NAME: /pave/01b022/pb022.dgn	CHECKED BY:
	PROJECT LEADER: WOOLLAVER	SHEET 17 OF 39
	DESIGNED BY: LOCKE	
	pb022a5.i	