


MAINLINE RT (5.2m)  
COLD PLANED 4/21/05  
+2.6m WIDTH 4/22/05

3+840 TO 3+660 LT  
COLD PLANED 4/29/05

DITCH AROUND  
EXISTING JCT. BOX

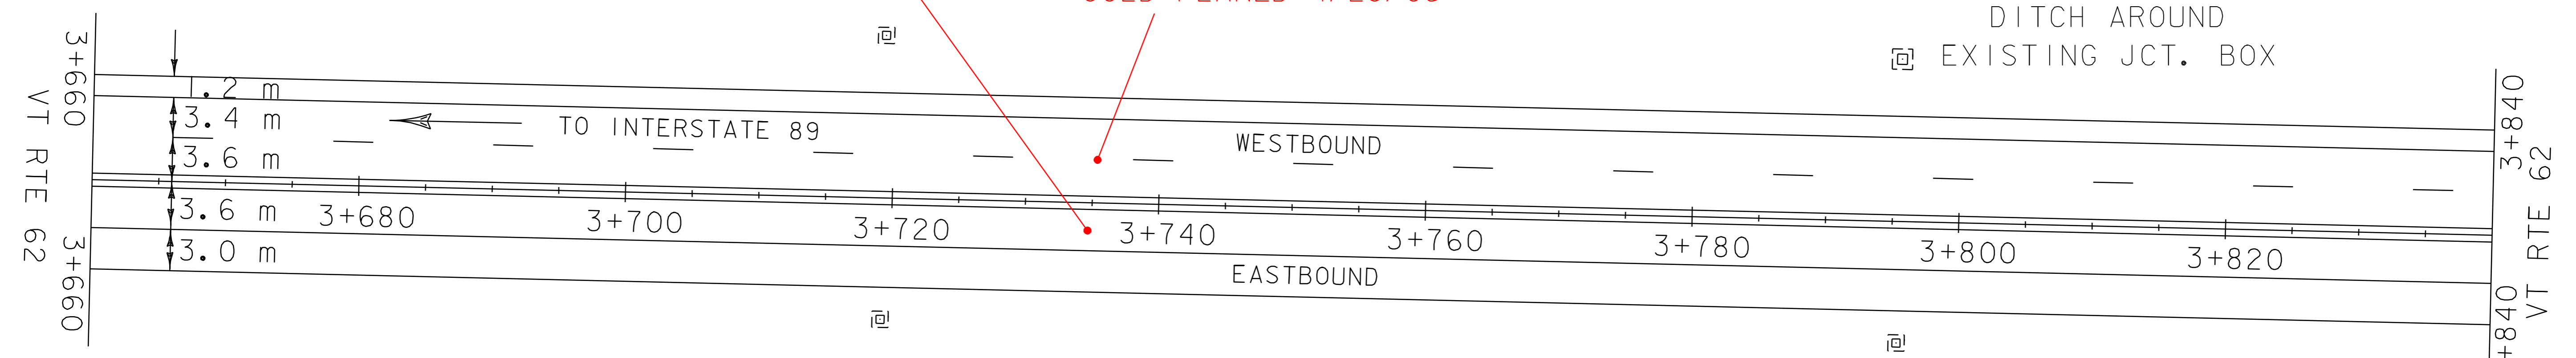

TEMPORARY AND DURABLE 150 mm WHITE LINE  
STA. 3+660 LT. - STA. 4+020 LT. (SOLID)  
STA. 3+660 LT. - STA. 4+020 LT. (DASHED)  
STA. 3+660 RT. - STA. 4+020 RT. (SOLID)

TEMPORARY AND DURABLE 150 mm YELLOW LINE  
STA. 3+660 LT. & RT. - STA. 4+020 LT. & RT. (SOLID)

REHABILITATION OF DI'S, CB'S, OR MH'S - CLASS I  
STA. 3+994 RT.

GATE FOR WOVEN WIRE FENCE  
STA. 3+932 RT. (AT R.O.W. FENCE)


REMOVAL AND DISPOSAL OF GUARDRAIL  
STA. 3+947 LT. - STA. 4+020 LT.  
STA. 3+994 RT. - STA. 4+020 RT.

MANUFACTURED TERMINAL SECTION (FLARED)  
STA. 3+947 LT. - STA. 3+958 LT.  
STA. 3+944 RT. - STA. 3+955 RT.

STEEL BEAM GUARDRAIL  
STA. 3+958 LT. - STA. 4+020 LT.  
STA. 3+955 RT. - STA. 4+020 RT.

TREATED TIMBER CURB  
STA. 3+954 RT. - STA. 4+020 RT.

BRIDGE 6 4+013.61  
1525 mm ACCGMP

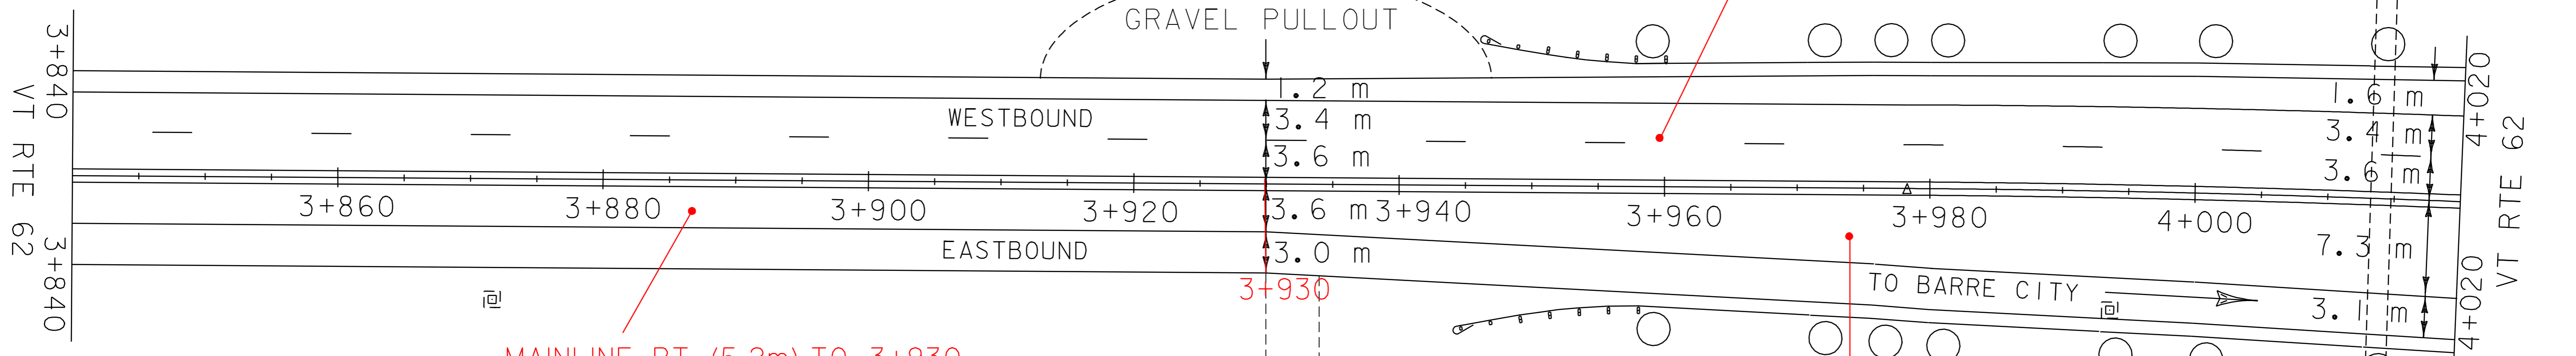

MAINLINE RT (5.2m) TO 3+930  
COLD PLANED 4/21/05  
+2.6m WIDTH 4/22/05

FIELD DRIVE  
TO GATE IN  
R.O.W. FENCE

4+020 TO 3+840 LT  
COLD PLANED 4/29/05

MAINLINE RT (7m)  
COLD PLANED 4/22/05  
+3.7 COLD PLANED 4/25/05  
TO COMPLETE RT LANE

**PAVING  
PROJECT  
LAYOUT  
#6**

PROJECT NAME: BERLIN-BARRE CITY	FILE NAME: /pave/01b022/pb022.dgn	PLOT DATE: 12-MAR-2007 11:09
PROJECT NUMBER: STP 2321(I)S	PROJECT LEADER: WOOLLAVER	DRAWN BY: LOCKE
	DESIGNED BY: LOCKE	CHECKED BY:
	pb0221a6.1	SHEET 18 OF 39