
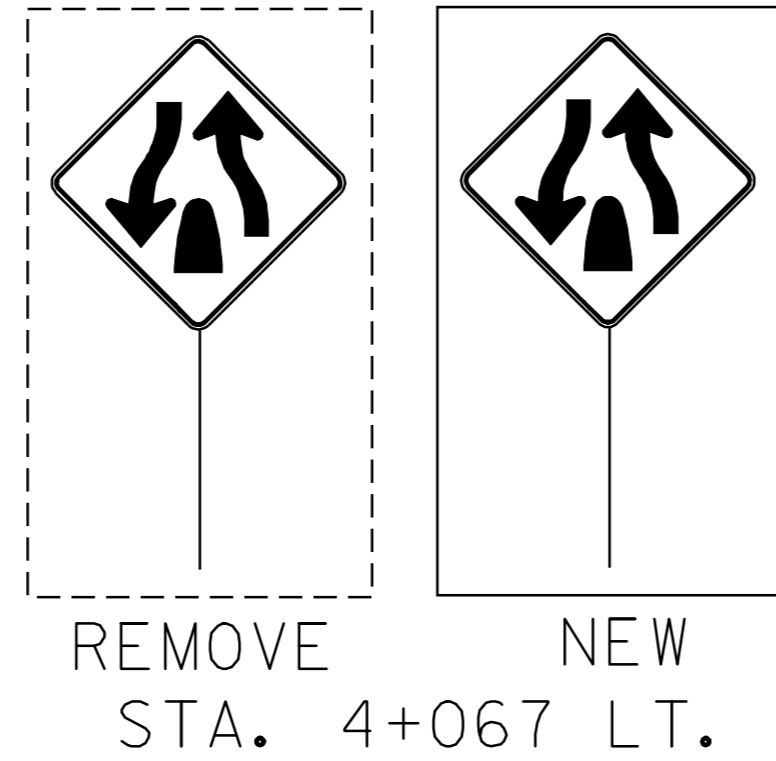


4+200 TO 4+020 LT
COLD PLANED 4/29/05
FULL WIDTH

MAINLINE RT (7.0m)
COLD PLANED 4/22/05

+3.7m COLD PLANED 4/25/05
TO COMPLETE RT LANE

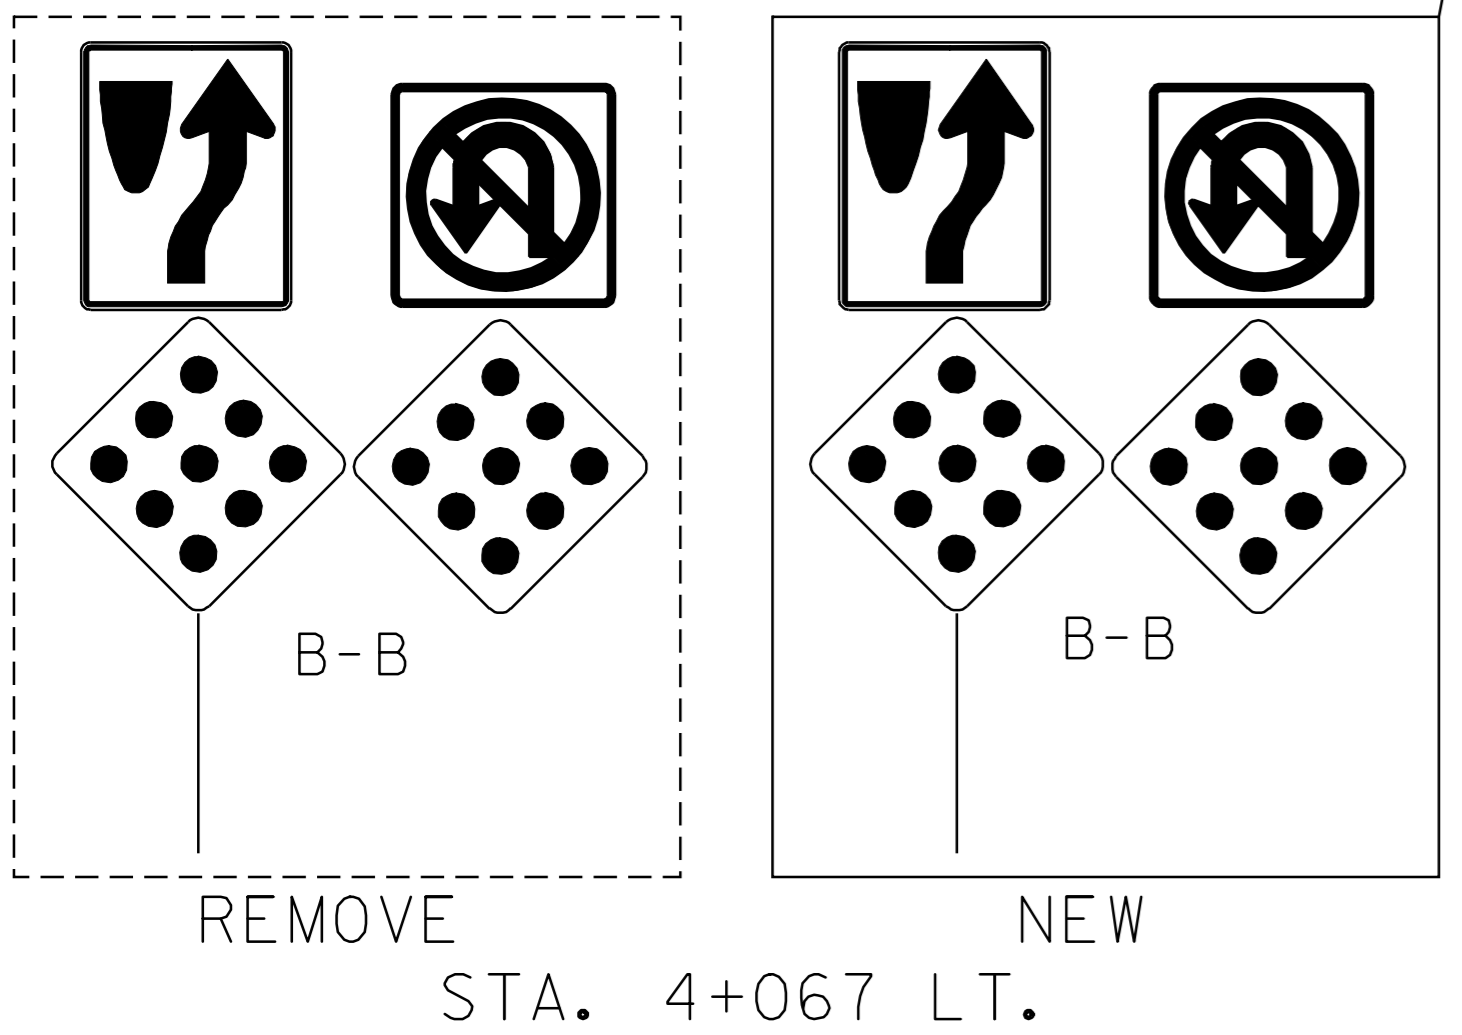

BRIDGE 7 4+066.64
1980 mm CGMPP


TEMPORARY AND DURABLE 150 mm WHITE LINE
 STA. 4+020 LT. - STA. 4+380 LT. (SOLID)
 STA. 4+020 LT. - STA. 4+380 LT. (DASHED)
 STA. 4+020 RT. - STA. 4+380 RT. (SOLID)
 STA. 4+020 RT. - STA. 4+380 RT. (DASHED)

TEMPORARY AND DURABLE 150 mm YELLOW LINE
 STA. 4+020 LT. & RT. - STA. 4+380 LT. & RT.
 (SOLID)

TEMPORARY AND DURABLE 300 mm YELLOW LINE
 STA. 4+037 - STA. 4+065 (DIAGONALS)

TREATED TIMBER CURB
 STA. 4+020 RT. - STA. 4+140 RT.
 STA. 4+361 LT. - STA. 4+380 LT.

STEEL BEAM GUARDRAIL
 STA. 4+020 LT. - STA. 4+380 LT.
 STA. 4+020 RT. - STA. 4+146 RT.

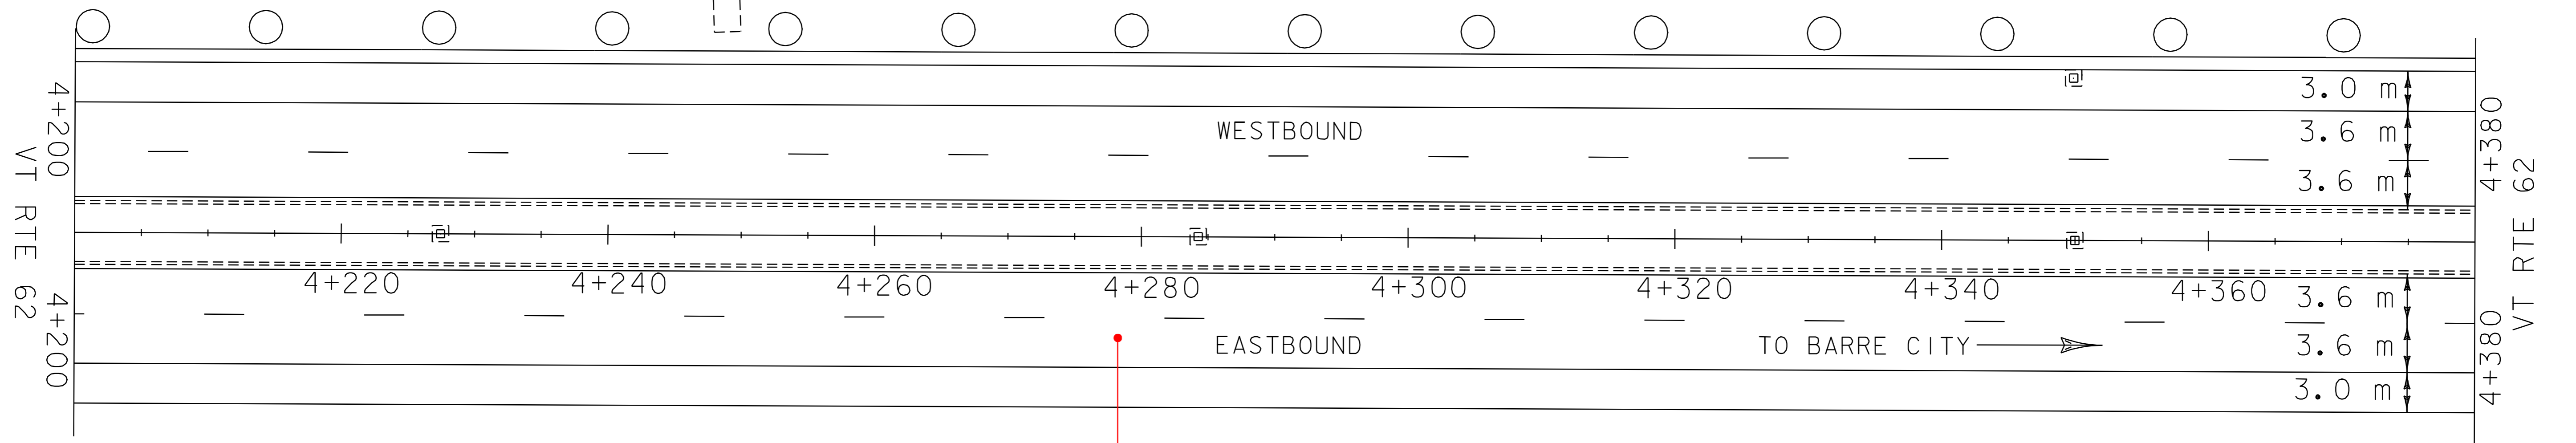

BITUMINOUS CONCRETE GUTTERS AND TRAFFIC ISLANDS

REHABILITATION OF DI'S, CB'S, OR MH'S - CLASS I
 STA. 4+070 MEDIAN
 STA. 4+070 RT.
 STA. 4+140 MEDIAN
 STA. 4+227 MEDIAN
 STA. 4+284 MEDIAN
 STA. 4+350 MEDIAN
 STA. 4+350 LT.

MAINLINE RT (7m)
COLD PLANED 4/22/05
 STA. 4+070 MEDIAN
 STA. 4+140 MEDIAN

ANCHOR FOR STEEL BEAM GUARDRAIL
 STA. 4+148 RT.
 +3.7m COLD PLANED 4/25/05
 TO COMPLETE RT LANE

PAVING PROJECT LAYOUT #7	PROJECT NAME: BERLIN-BARRE CITY	PLOT DATE: 12-MAR-2007 11:09
	PROJECT NUMBER: STP 232(I)S	DRAWN BY: LOCKE
	FILE NAME: /pave/01b022/pb022.dgn	CHECKED BY:
	DESIGNED BY: LOCKE	SHEET 19 OF 39