

- INDEX OF SHEETS**
1. TITLE SHEET
 - 2.-3. PROJECT TYPICAL SHEETS
 - 4.-6. QUANTITY SHEETS
 - 7.-11. ITEM DETAIL SUMMARY SHEETS
 12. DITCH CLEANING DETAIL SHEET
 - 13.-32. LAYOUT SHEETS
 - 33.-34. VEHICLE DETECTOR LOOP LAYOUT SHEETS
 - 35.-38. TRAFFIC SIGN SUMMARY SHEETS
 39. CONSTRUCTION APPROACH SIGNING SHEET

VAOT STANDARDS		
C-1M	CURBS, TREATED TIMBER CURB	01-03-00
D-3M	TREATED GUTTERS	06-13-97
D-9M	REINFORCED CONCRETE DROP INLET	06-13-97
D-16M	CAST IRON GRATE, TYPE B	06-13-97
E-100M	CONSTRUCTION APPROACH SIGNS	03-01-04
E-100AM	SIDE ROAD CONSTRUCTION-APPROACH SIGNS	03-01-04
E-101M	CONSTRUCTION SIGN DETAILS	05-30-03
E-102M	CONSTRUCTION SIGN DETAILS	06-30-03
E-102AM	CONSTRUCTION SIGN DETAILS	06-13-97
E-103M	MAINLINE TRAFFIC CONTROL	03-01-04
E-106M	TRAFFIC CONTROL-MISCELLANEOUS DETAILS	03-01-04
E-108M	CONSTRUCTION ZONE LONGITUDINAL DROP OFFS	06-13-97
E-110M	MAJOR MAINTENANCE OPERATION LANE CLOSURE	06-13-97
E-121M	STANDARD SIGN PLACEMENT-CONVENTIONAL ROAD	06-13-97
E-138M	MILEMARKER DETAILS-STATE & TOWN HIGHWAYS	05-30-03
E-143M	REGULATORY SIGN DETAILS	06-13-97
E-144M	REGULATORY SIGN DETAILS	03-29-99
E-145AM	REGULATORY SIGN DETAILS-LANE USE	06-13-97
E-145BM	REGULATORY SIGN DETAILS-LANE USE	06-13-97
E-146M	REGULATORY SIGN DETAILS	06-13-97
E-150M	WARNING SIGN DETAILS	06-13-97
E-151M	WARNING SIGN DETAILS	06-13-97
E-152M	WARNING SIGN DETAILS	06-13-97
E-160M	FLANGED CHANNEL STEEL SIGN POST	06-13-97
E-164M	SQUARE STEEL SIGN POST	06-13-97
E-172M	VEHICLE DETECTOR LOOP DETAILS	06-13-97
E-190M	RAILROAD XING SIGNS & MARKINGS	06-30-03
E-191M	PAVEMENT MARKING DETAILS	02-01-99
E-192M	PAVEMENT MARKING DETAILS	12-28-98
E-193M	PAVEMENT MARKING DETAILS	06-13-97
F-1M	DRIVE GATE FOR WOVEN WIRE FENCE	01-03-00
G-1M	STEEL BEAM GUARDRAIL (50 MPH & OVER)	01-03-00
G-10M	STEEL BEAM GUARDRAIL (40 MPH & LESS)	01-03-00
G-19M	GENERIC GRADING PLANS FOR GUARDRAIL END TERMINALS	11-15-02
PSF-1M	INSTALLATION OF PERMANENT SNOW FENCE - BRIDGES W/2 RAIL ALUMINUM BRIDGE RAIL	07-10-97
T-1M	TEMPORARY EROSION CONTROL DETAILS	06-13-97
T-2M	TEMPORARY EROSION CONTROL DETAILS	06-13-97

STATE OF VERMONT AGENCY OF TRANSPORTATION



PROPOSED IMPROVEMENT TOWNS OF BERLIN & BARRE CITY COUNTY OF WASHINGTON VT RTE 62

BEGINNING IN THE TOWN OF BERLIN ON VT RTE 62 AT STA. 2+244.000 (MM 1.394) AND EXTENDING EASTERLY FOR A DISTANCE OF 5,017.57 METERS (3.118 MILES) TO STA. 2+539.000 (MM 1.577) IN THE CITY OF BARRE. PROJECT ALSO INCLUDES WESTBOUND FROM MM 2.526 TO THE END OF PROJECT A DISTANCE OF 3196.57 METERS (1.986 MILES), AND RAMP A OF THE BERLIN STATE HIGHWAY FOR A DISTANCE OF 935 METERS (0.581 MILES).


PROJECT DATA

VT 62 STA. 2+244.000 (MM 1.394 BERLIN) TO STA. 4+065.000 (MM 2.526 BERLIN)
 VT 62 EB STA. 4+065.000 (MM 2.526 BERLIN) TO STA. 2+539.000 (MM 1.577 BARRE CITY)
 VT 62 WB STA. 4+065.000 (MM 2.526 BERLIN) TO STA. 2+539.000 (MM 1.577 BARRE CITY)
 BERLIN STATE HIGHWAY RAMP A STA. 0+000.000 TO STA. 0+935.000

LENGTH OF PROJECT = 9149.140 METERS 5.685 MILES
 LENGTH OF ROADWAY = 9149.140 METERS 5.685 MILES

WORK TO BE PERFORMED UNDER THIS PROJECT INCLUDES COLD PLANING, LEVELING AND RESURFACING OF THE EXISTING HIGHWAY, NEW PAVEMENT MARKINGS, GUARDRAIL AND INCIDENTAL ITEMS.

**PROJECT LOCATION
STP 2321(1)S**

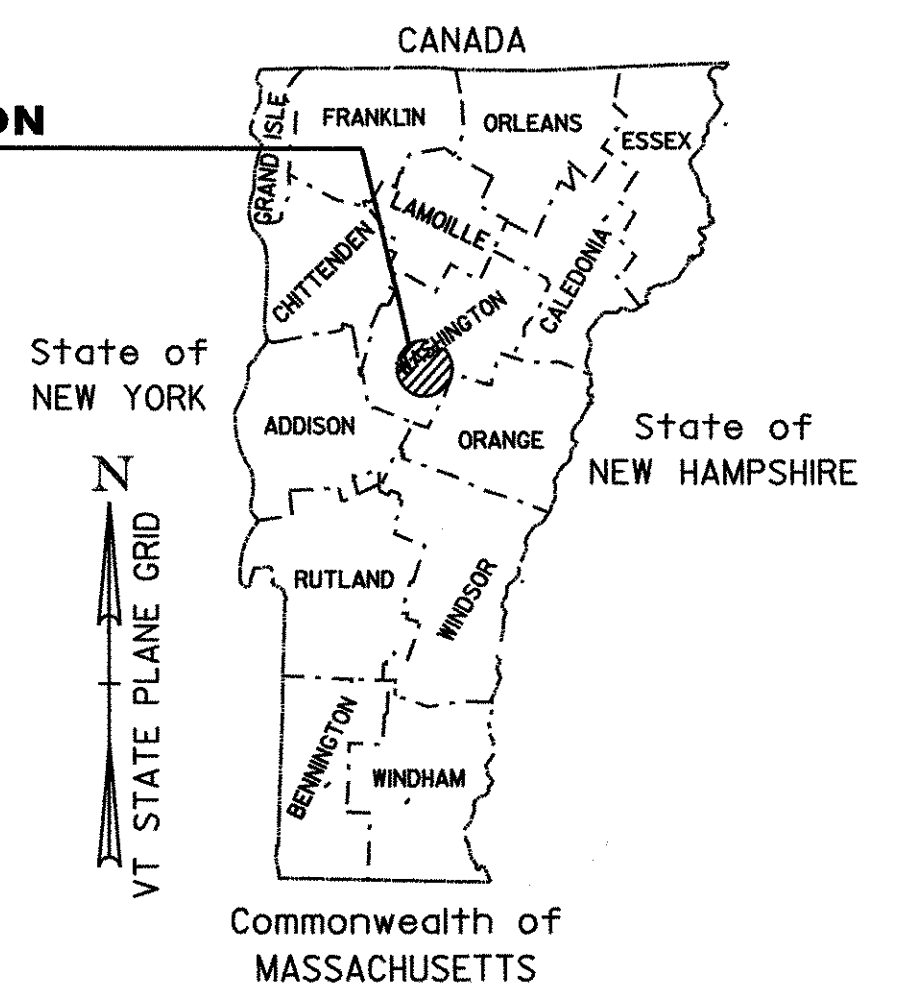

RECORD PLANS

CONTRACTOR: PIKE INDUSTRIES - BERLIN, VT

RESIDENT ENGINEER: C. FIELDER

CONSTRUCTION BEGAN: APRIL 20, 2005

CONSTRUCTION COMPLETE: AUGUST 5, 2005

RECORD PLANS BY: C. FIELDER & C. PIERCE

I HEREBY CERTIFY THAT ALL THE CONSTRUCTION REQUIRED BY THIS SET OF DRAWINGS HAS BEEN ACCOMPLISHED AS INDICATED HEREIN.

BY: *C. Fielder* RESIDENT ENGINEER

DATE: 3/1/07

NOTE: Any further information concerning final quantities, amounts or other details relative to this project may be found at Central Files in the electronic archives.

TRAFFIC DATA

LOCATION	ADT		DHV		ESALS	ESALS
	2003	2013	2003	2013	(2003-2013)	(2003-2013)
BEGIN PROJECT TO WB RAMP BERLIN S.H. (MM 1.394-MM 1.52)	19300	2300	20800	2400	2,679,000	5,714,000
WB RAMP BERLIN S.H. TO BERLIN ST. (MM 1.52-MM 1.20)	12100	1400	13100	1500	2,316,000	5,029,000
BERLIN ST. TO END OF PROJECT (MM 1.20-MM 1.577)	10000	1200	10800	1300	2,368,000	5,191,000

**BITUMINOUS CONCRETE PAVEMENT
SUPERPAVE MIXTURE DESIGN CRITERIA**



DESIGN LANE/DESIGN LIFE ESAL	2,857,000
DESIGN NUMBER OF GYRATIONS	75
PERFORMANCE GRADED ASPHALT BINDER	58-34

CONVENTIONAL SYMBOLS

COUNTY LINE	— — — — —
TOWN LINE	— — — — —
LIMITS OF ACCESS	— o — o — o — o —
POINT OF ACCESS	X
FENCE LINE	x — x — x — x —
STONE WALL	o — o — o — o — o — o —
TRAVELED WAY	— — — — —
GUARD RAIL	o — o — o — o — o — o —
RAILROAD	— — — — —
SURVEY LINE	— — — — —
CULVERT	— — — — —
POWER POLE	⊕
TELEPHONE POLE	⊕
TREES	⊕
CONTROL OF ACCESS	— // — // — // —
PROPERTY LINE	— — — — —
R.O.W. TAKING LINE	— SR — SR — SR —
SLOPE RIGHTS	— — — — —
TOP OF CUT	— — — — —
TOE OF SLOPE	— — — — —

SURVEYED BY : N/A
 SURVEYED DATE : N/A

DATUM
 VERTICAL N/A
 HORIZONTAL N/A

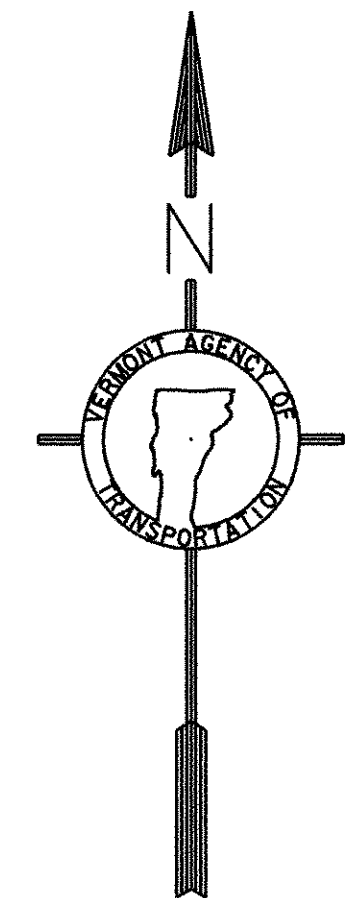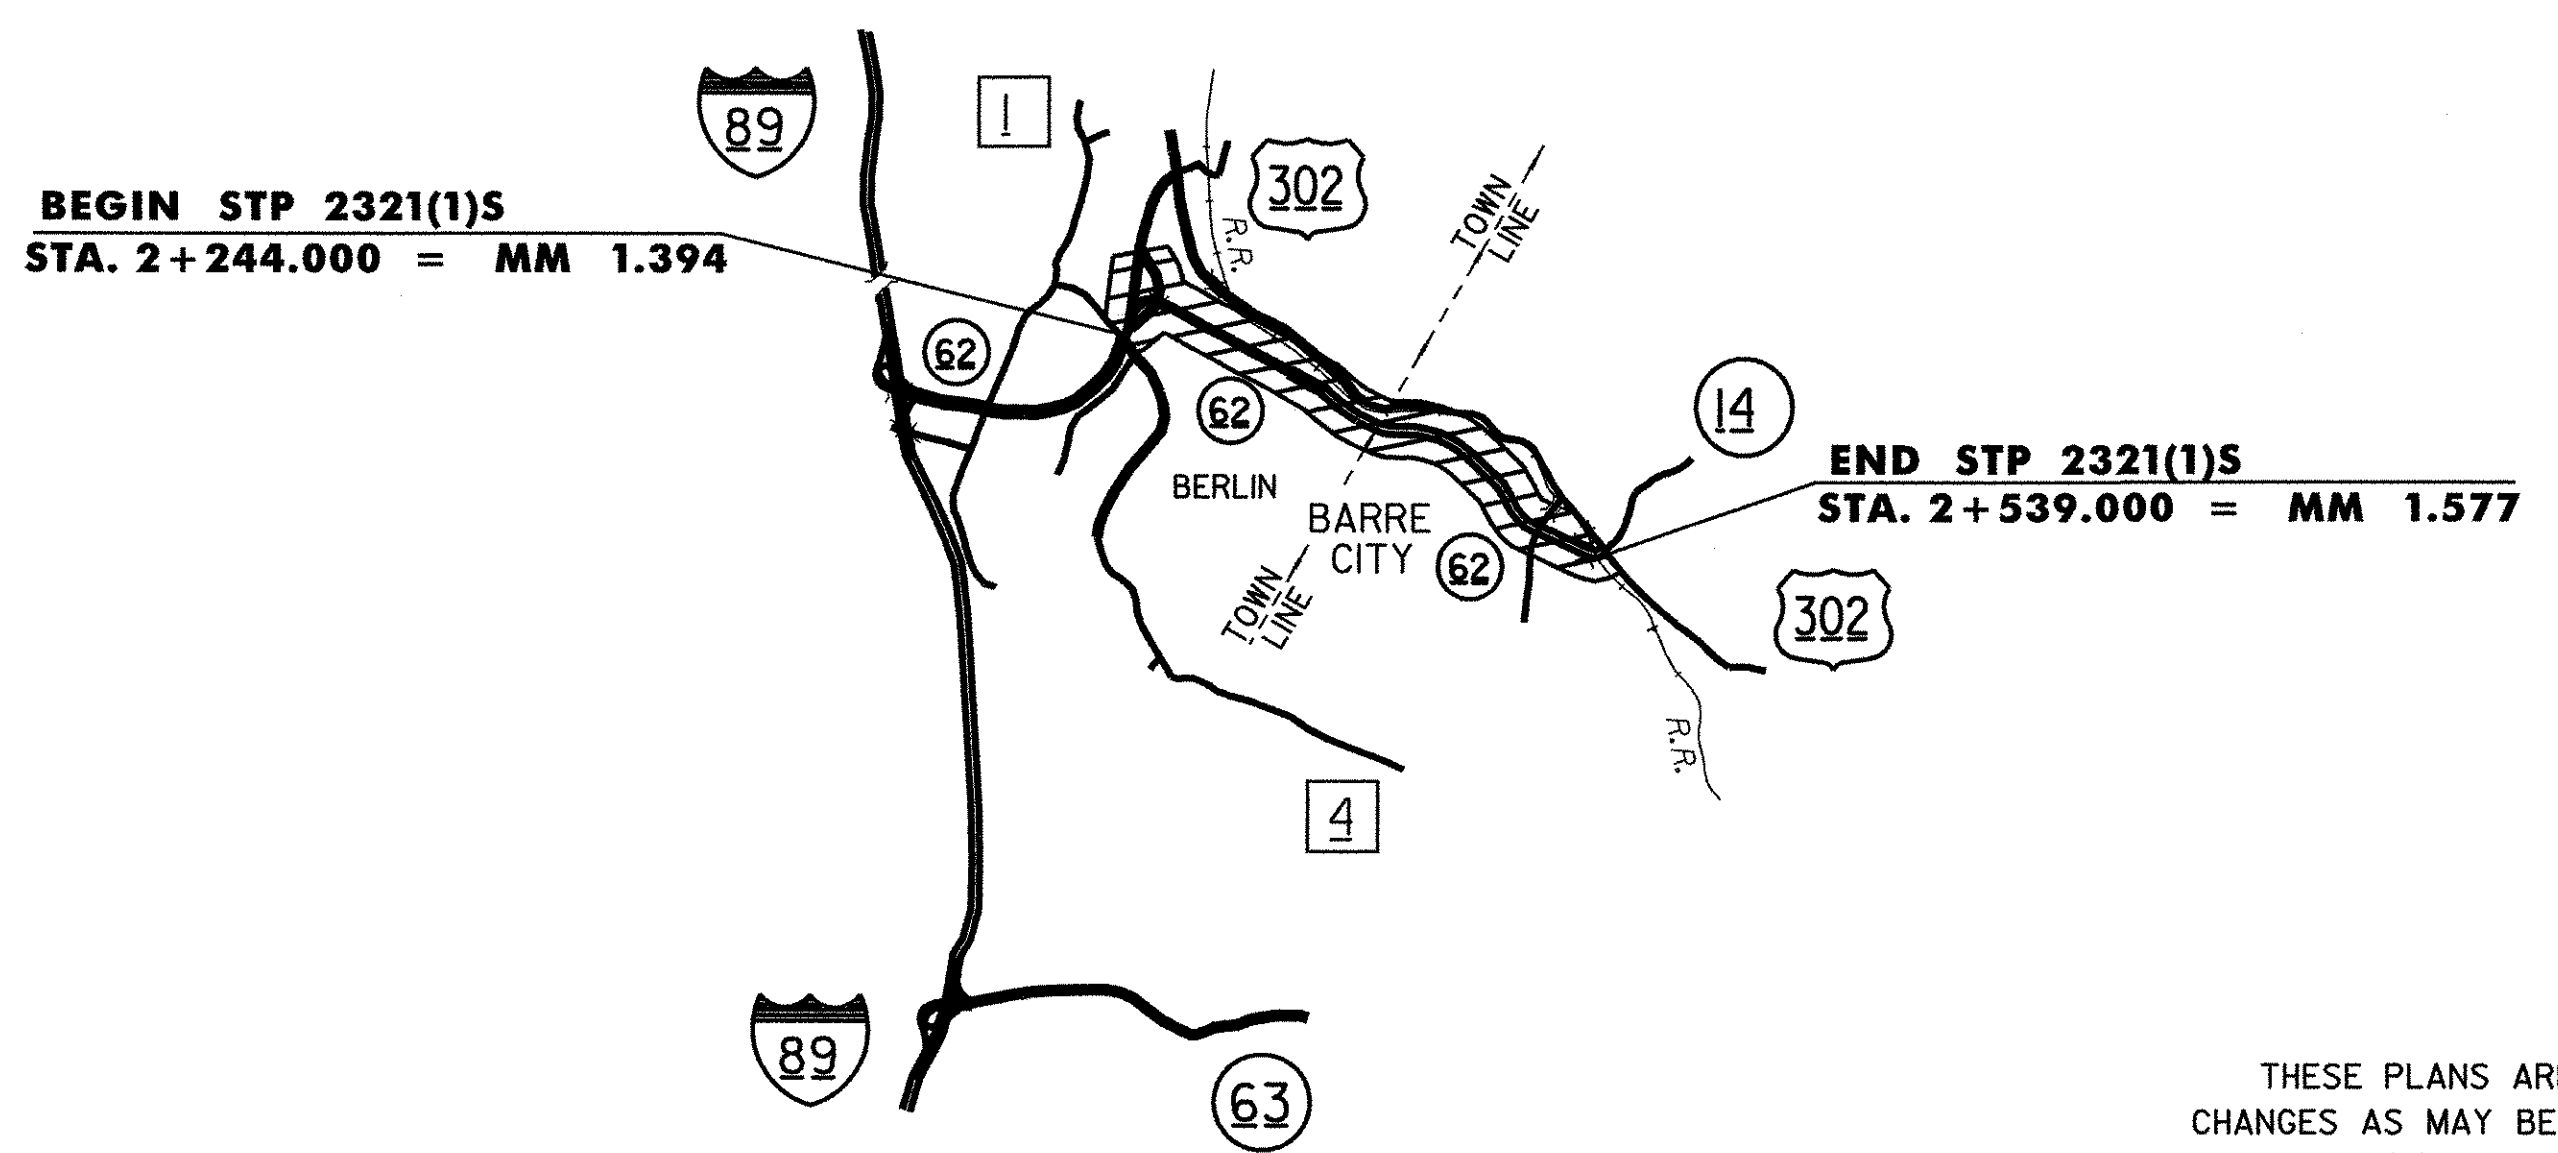

RIGHT-OF-WAY LIMITS, IF APPLICABLE, ARE PROVIDED SOLELY FOR THE CONVENIENCE OF THE STATE AND ITS CONTRACTOR DURING THE COURSE OF THIS PAVING PROJECT. ANY REFERENCES TO OFFSETS ON THESE PLANS ARE APPROXIMATE AND SHOULD NOT BE RELIED UPON FOR ANY OTHER PURPOSES.

UNLESS OTHERWISE NOTED, ALL DRAWINGS AND DETAILS ON THESE PLANS ARE DRAWN 'NOT TO SCALE'.



UNLESS NOTED OTHERWISE
 STATIONS ARE IN KILOMETERS
 ELEVATIONS ARE IN METERS
 DIMENSIONS ARE IN MILLIMETERS

THESE PLANS ARE SUBJECT TO SUCH ENGINEERING CHANGES AS MAY BE REQUIRED BY THE FEDERAL HIGHWAY ADMINISTRATION OR THE DIRECTOR OF PROJECT DEVELOPMENT.

CONSTRUCTION IS TO BE CARRIED ON IN ACCORDANCE WITH THESE PLANS AND THE STANDARD SPECIFICATIONS FOR CONSTRUCTION DATED 2001, AS APPROVED BY THE FEDERAL HIGHWAY ADMINISTRATION ON JANUARY 4, 2001 FOR USE ON THIS PROJECT, INCLUDING ALL SUBSEQUENT REVISIONS AND SUCH REVISED SPECIFICATIONS AND SPECIAL PROVISIONS AS ARE INCORPORATED IN THESE PLANS.

DEPARTMENT OF TRANSPORTATION
 FEDERAL HIGHWAY ADMINISTRATOR

APPROVED: _____ DATE: _____


DIRECTOR OF PROJECT DEVELOPMENT

APPROVED: *J. V. BA* DATE: 12-27-04

PROJECT MANAGER : WOOLAVER


PROJECT NAME : BERLIN - BARRE CITY
 PROJECT NUMBER : STP 2321(1)S

SHEET 1 OF 39 SHEETS

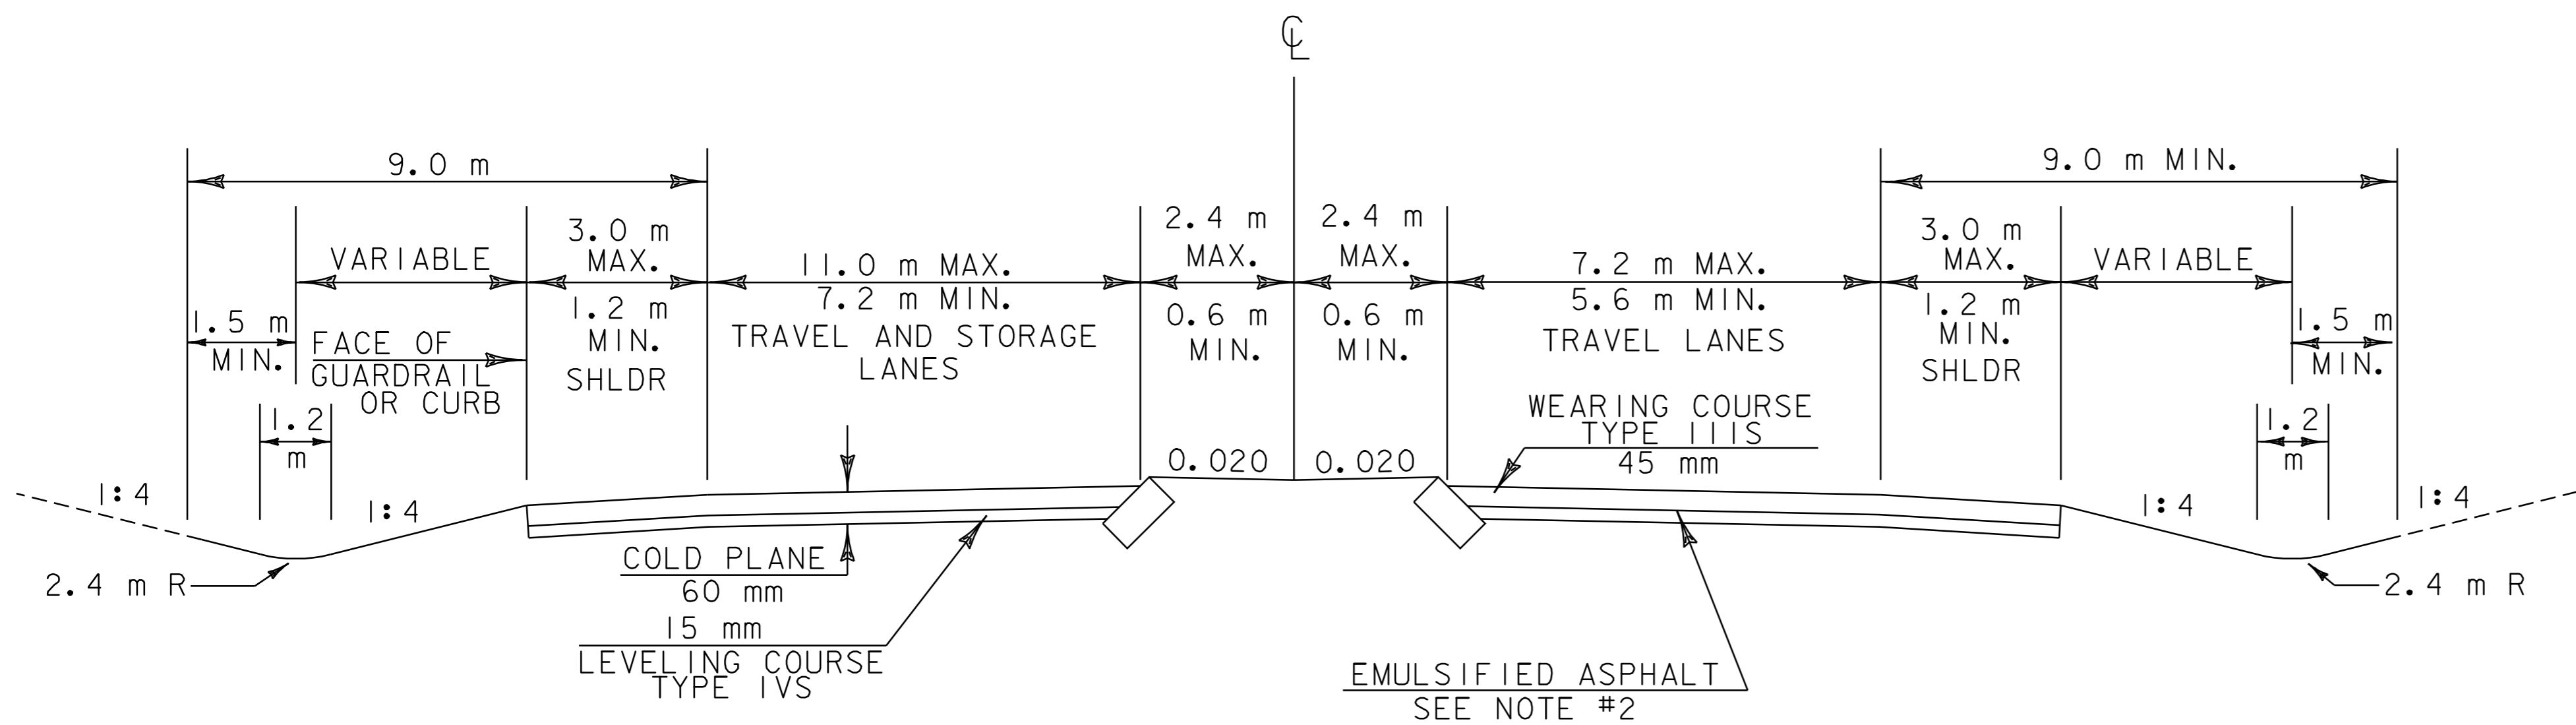

**NORMAL SECTION W/MEDIAN ISLAND
VT RTE 62**

BERLIN STA. 2+244.000 TO STA. 2+554.000
 BERLIN STA. 4+065.000 TO STA. 4+722.571
 BARRE CITY STA. 0+000.000 TO STA. 1+913.000
 BARRE CITY STA. 1+944.000 TO STA. 2+539.000

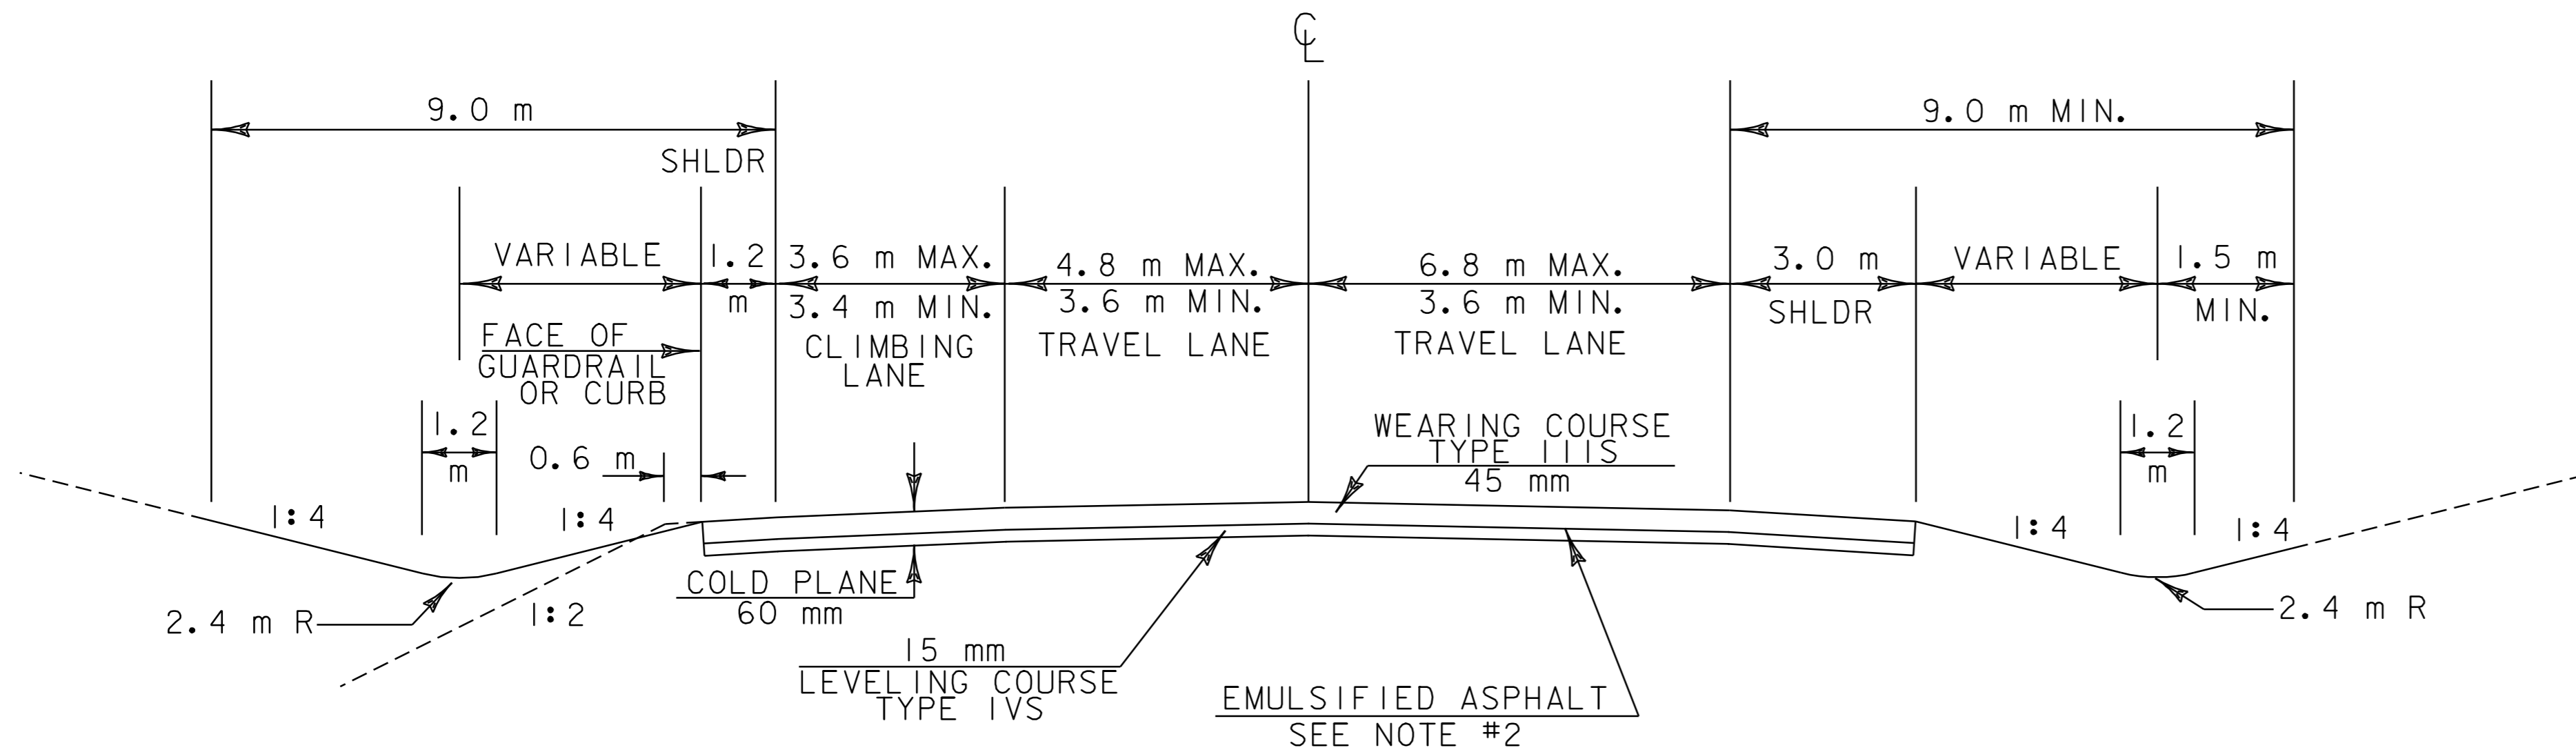


**NORMAL SECTION
VT RTE 62**


BERLIN STA. 2+554.000 TO STA. 4+065.000

NOTES:

1. THE PAVEMENT WEARING COURSE SHALL BE TYPE IIIS AND THE LEVELING COURSE SHALL BE TYPE IVS ITEM 490.30, AS SHOWN ON THE TYPICALS. ALL LIQUID ASPHALT USED IN SUPERPAVE BITUMINOUS CONCRETE PAVEMENT SHALL BE PG 58-34.
2. EMULSIFIED ASPHALT SHALL BE APPLIED ON ALL EXISTING PAVEMENT SURFACES, ON COLD PLANNED SURFACES, AND BETWEEN ALL COURSES OF PAVEMENT AT THE RATE OF 0.12 L/m² OR AS DIRECTED BY THE RESIDENT ENGINEER.
3. SUPERPAVE BITUMINOUS CONCRETE PAVEMENT TOLERANCE = 5 mm +/- (TOTAL THICKNESS EXCLUDING LEVELING COURSE).
4. COLD PLANING SHALL BE COMPLETED ACCORDING TO THE TYPICALS OR AS DENOTED OTHERWISE ON THE PLANS. A FULL DEPTH BUTT JOINT SHALL BE CONSTRUCTED AT THE PROJECT BEGIN/END AND AT ALL SIDE ROAD APPROACHES AS SHOWN ON THE PROJECT PLANS OR AS OTHERWISE DIRECTED BY THE RESIDENT ENGINEER. ALL BUTT JOINTS SHALL BE SAW CUT, SUBSIDIARY TO ITEM 490.30.
5. ONE METER OF BACKING IS REQUIRED BEHIND THE FACE OF GUARDRAIL WITH 1.8 m POSTS. IF THIS CANNOT BE OBTAINED THEN 2.4 m POSTS SHALL BE USED. **NO 2.4 m POSTS USED**
6. ESTIMATED QUANTITIES OF ITEM 608.25, EXCAVATOR RENTAL AND ITEM 608.37 TRUCK RENTAL HAVE BEEN INCLUDED FOR THE PROVISION OF CONSTRUCTING GUARDRAIL FLARES WITH EXCAVATED DITCHING MATERIAL. THE GUARDRAIL FLARES SHALL BE CAPPED WITH AN ESTIMATED 75 mm DEPTH OF ITEM 402.12 AGGREGATE SHOULDER MATERIAL (MOD.) UNLESS OTHERWISE DIRECTED BY THE RESIDENT ENGINEER. THE QUANTITIES INCLUDED REFLECT 5 TONS OF AGGREGATE SHOULDER MATERIAL (MOD.) FOR EACH GUARDRAIL TERMINAL. AN ESTIMATED QUANTITY OF EARTH BORROW HAS BEEN INCLUDED TO PROVIDE FOR ADDITIONAL MATERIAL, IF NEEDED.
7. ALL EDGES OF PAVEMENT AND TREATED TIMBER CURB SHALL BE BACKED UP FULL HEIGHT WITH COLD PLANE GRINDINGS AS DIRECTED BY THE RESIDENT ENGINEER AND WILL BE PAID FOR UNDER ITEM 402.12, AGGREGATE SHOULDER MATERIAL (MOD.)
8. GRASS GROWING ADJACENT TO PAVEMENT OR THROUGH CRACKS IN THE PAVEMENT, WHICH MAY HAMPER THE REPLACEMENT OF NEW BITUMINOUS CONCRETE, SHALL BE REMOVED BY THE CONTRACTOR AS DIRECTED BY THE ENGINEER. PAYMENT FOR THIS WORK WILL NOT BE MADE DIRECTLY, BUT WILL BE PAID SUBSIDIARY TO ITEM 490.30 SUPERPAVE BITUMINOUS CONCRETE PAVEMENT (PG 58-34).
9. COLD PLANE GRINDINGS TO BE USED ON THE PROJECT FOR SHOULDER BACKING, REPLACEMENT MATERIALS UNDER SHOULDERS, AND TO BACK UP GUARD RAIL IN ALL GUARD RAIL AREAS. THIS WILL BE PAID UNDER ITEM 402.12, AGGREGATE SHOULDER MATERIAL (MOD.)
10. PIPE INLET AND OUTLET AREAS, AND DITCH CLEANING THROUGH THE PROJECT, SHALL BE PERFORMED AT LOCATIONS AS DIRECTED ON THE DITCH CLEANING DETAIL SHEET AND AS DIRECTED BY THE RESIDENT ENGINEER. PAYMENT WILL BE UNDER THE APPLICABLE EQUIPMENT RENTAL ITEMS.
11. ITEM 616.47 BITUMINOUS CONCRETE GUTTERS AND TRAFFIC ISLANDS WILL BE PAID ONLY WHERE SPECIFIED IN THE PLANS. ALL OTHER BITUMINOUS CONCRETE PAVEMENT WORK, WHICH COULD INVOLVE SOME HAND WORK SHALL BE PAID FOR AT THE CONTRACT UNIT PRICE FOR ITEM 490.30, SUPERPAVE BITUMINOUS CONCRETE PAVEMENT.
12. ALL STEEL POSTS REMOVED WITH THE EXISTING 3 CABLE GUARDRAIL WHICH ARE DEEMED RE-USABLE BY THE RESIDENT ENGINEER, SHALL REMAIN THE PROPERTY OF THE STATE OF VERMONT. THE CONTRACTOR SHALL LOAD THESE MATERIALS ONTO SUITABLE TRANSPORT AND DELIVER THEM TO THE STATE OF VERMONT MAINTENANCE FACILITY IN MIDDLESEX. THE CONTRACTOR SHALL CONTACT DISTRICT #6 ADMINISTRATOR, ERNIE ENGLEHARDT AT (802) 828-2691 AT LEAST TWO WEEKS PRIOR TO DELIVERY TO COORDINATE ACCESS ETC. THE STATE OF VERMONT WILL PROVIDE THE LOCATION, EQUIPMENT, AND PERSONNEL TO STOCKPILE THESE MATERIALS. ALL COSTS WILL NOT BE PAID DIRECTLY, BUT WILL BE CONSIDERED SUBSIDIARY TO THE ITEM UNDER WHICH THEY WERE REMOVED.

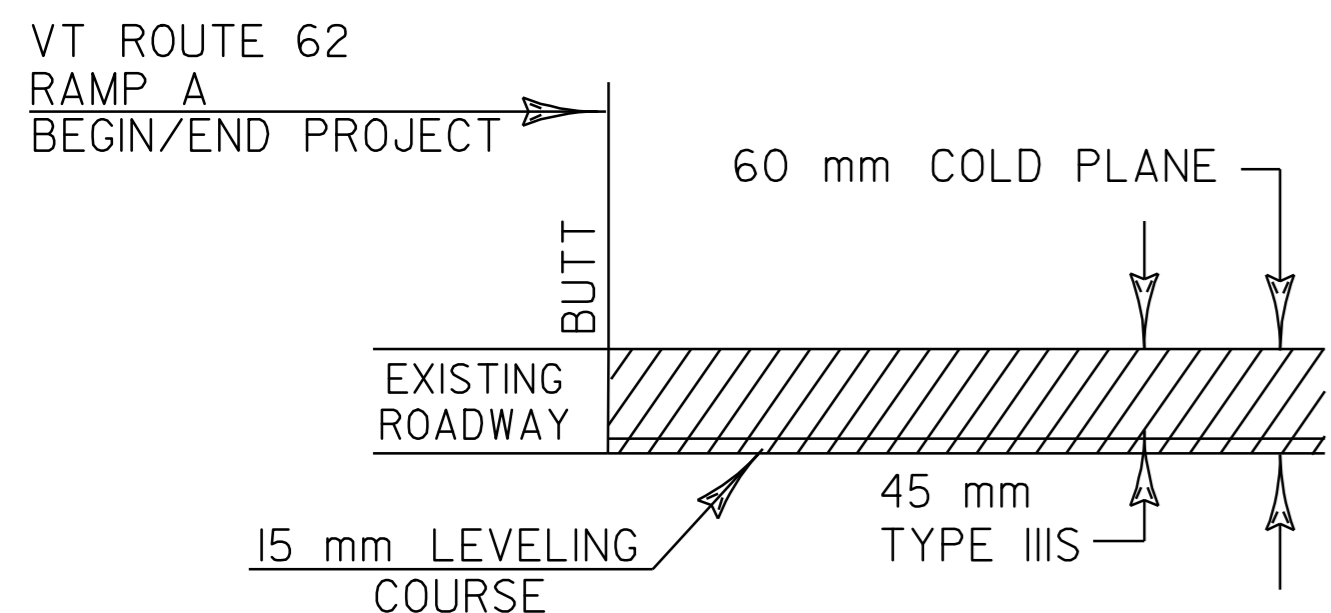

APPROACH AREA DETAIL

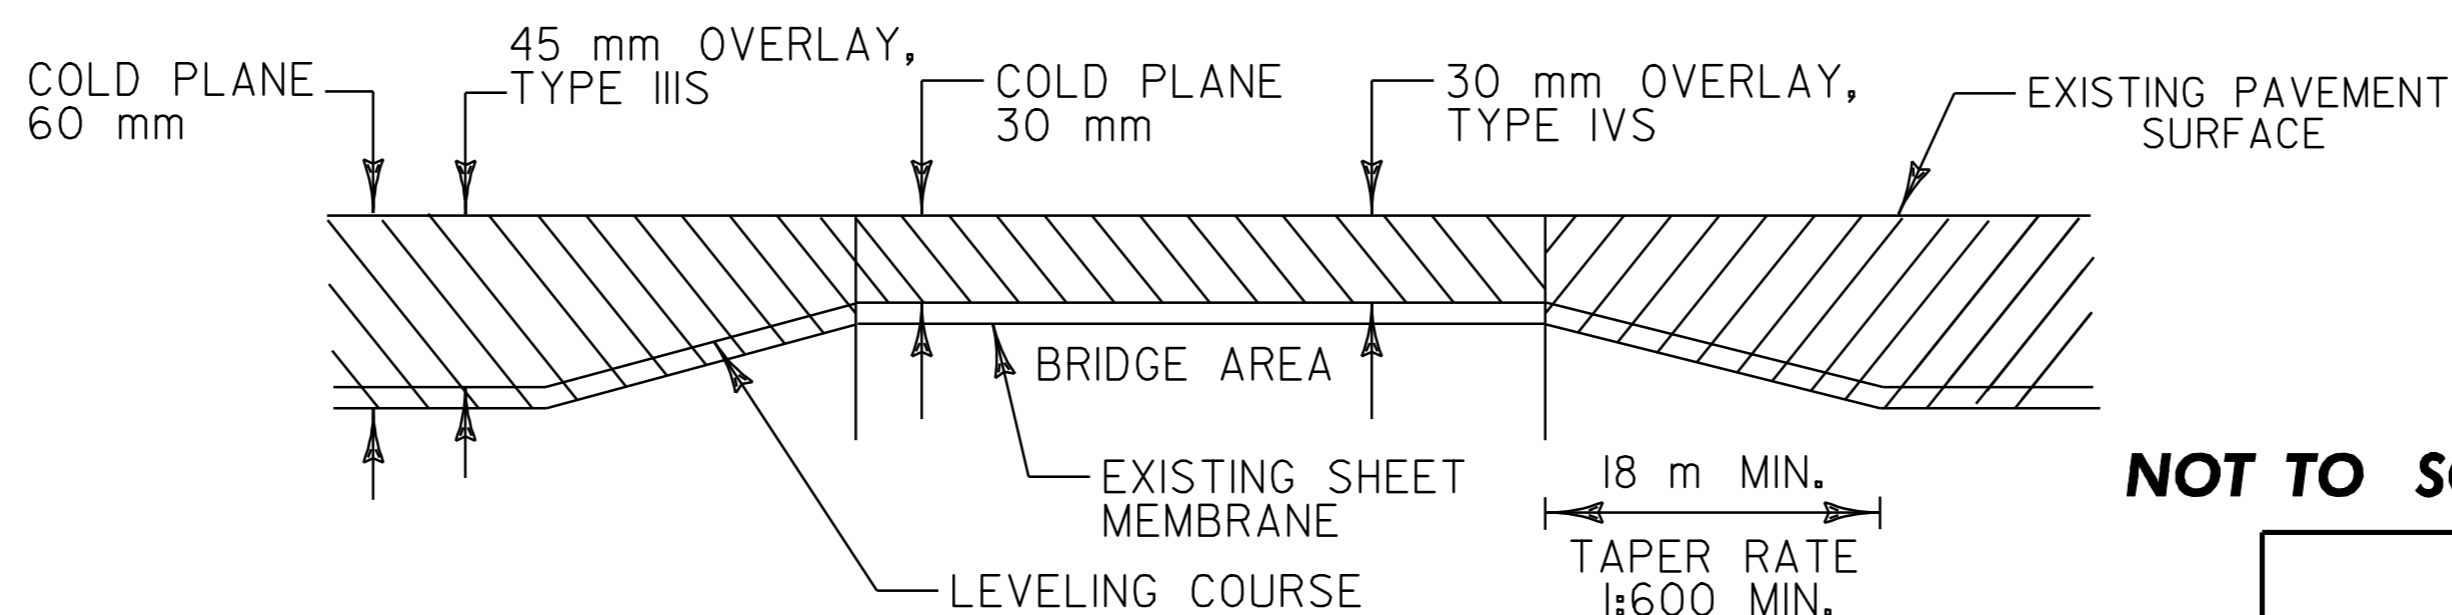

OVERLAY DETAIL @ BRIDGES 1 AND 11

BERLIN RAMP A BRIDGE #10 OVER VT 62 STA. 0+396.193
 BARRE CITY VT 62 BRIDGE #11 OVER BLACKWELL STREET STA. 2+250.640

NOT TO SCALE

**PROJECT TYPICAL
SHEET # 1**

PROJECT NAME:	BERLIN-BARRE CITY	FILE NAME:	/pave/01b022/pb022.dgn	PLOT DATE:	12-MAR-2007 11:08
PROJECT NUMBER:	STP 2321(1)S	PROJECT LEADER:	WOOLAVER	DRAWN BY:	LOCKE
		DESIGNED BY:	LOCKE	CHECKED BY:	
			pb022+yp.l		SHEET 2 OF 39

SEEDING FORMULA RURAL AREAS

% MASS	kg/ha	NAME	PUR %	GERM %
37.5	26.0	CREeping RED FESCUE	98	85
37.5	26.0	TALL FESCUE	95	90
5.0	4.0	RED TOP	95	90
15.0	10.0	BIRDSFOOT TREFOIL	98	85
5.0	4.0	ANNUAL RYE GRASS	95	85
100.0	70.0			

GENERAL NOTES

SEED MIXTURE: SHALL NOT HAVE A WEED CONTENT EXCEEDING 0.40% BY MASS AND SHALL BE FREE OF ALL NOXIOUS SEED.


SEED: TO BE APPLIED PER SEEDING FORMULAS OR AS DIRECTED BY THE ENGINEER.

FERTILIZER: FORMULA 10-20-10, TO BE USED WITH SEED, APPLIED AT THE RATE OF 560 kg/ha. (HYDRO SEEDERS MAY USE 19-19-19 FORMULA).

AGRICULTURAL LIMESTONE: TO BE APPLIED AT THE RATE OF 4500 kg/ha, OR AS DIRECTED BY THE ENGINEER.

HAY MULCH: TO BE PLACED ON EARTH SLOPES AT THE RATE OF 4500 kg/ha, OR AS DIRECTED BY THE ENGINEER.


TOPSOIL: TO BE USED WITH SEED AS INDICATED ON THE PLANS, OR AS DIRECTED BY THE ENGINEER.

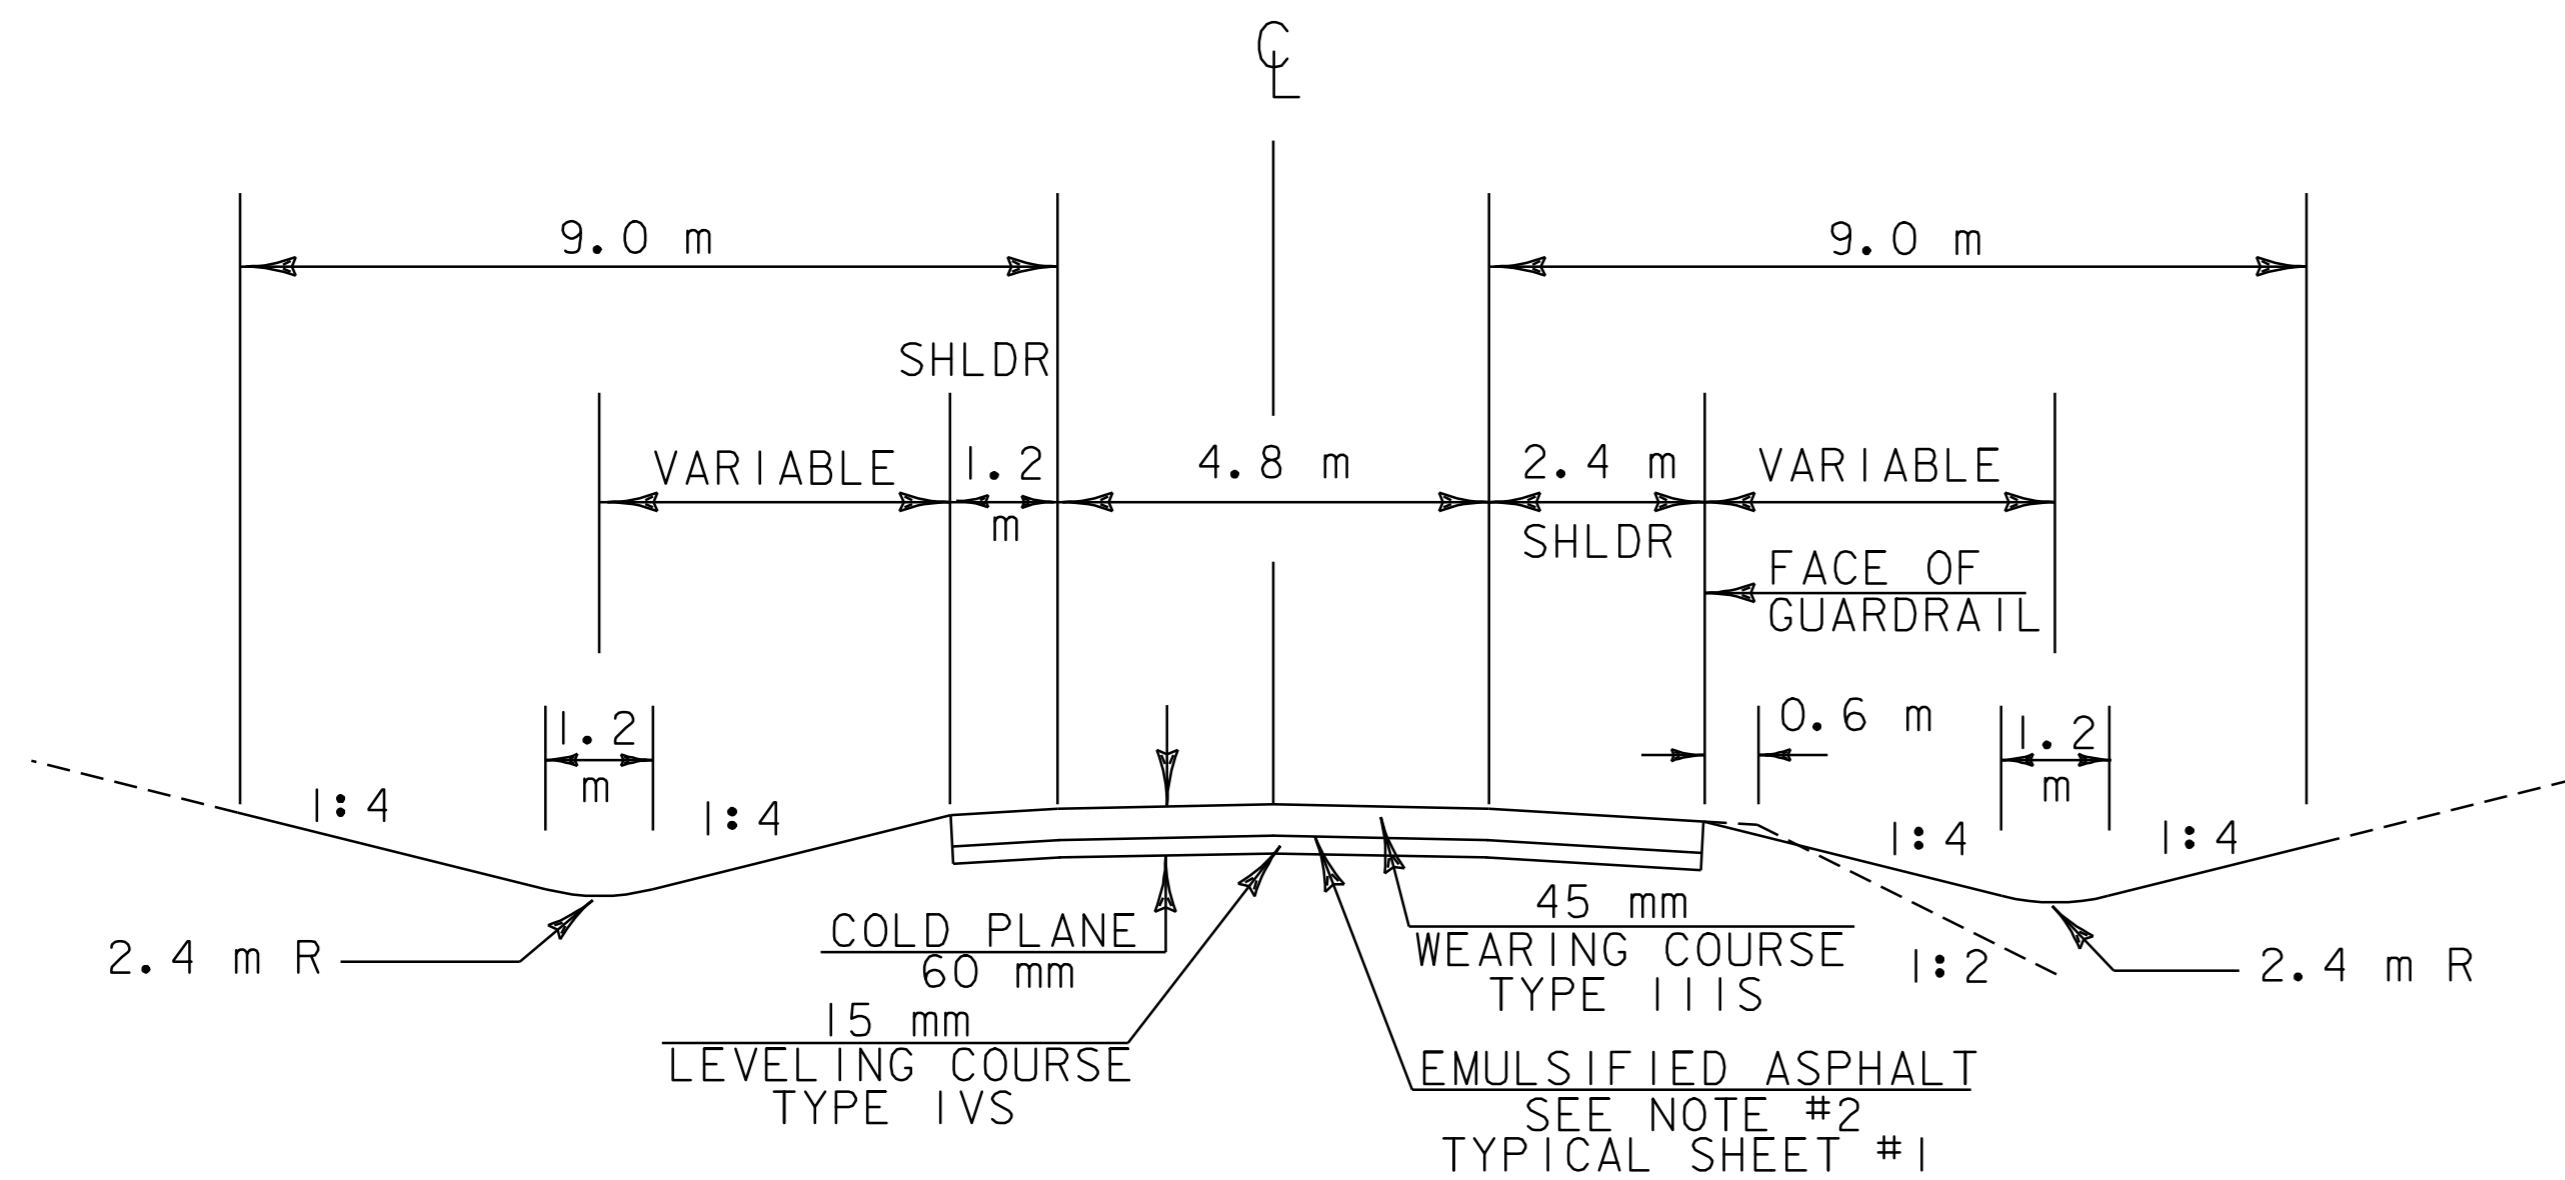

**NORMAL SECTION
RAMP A**

PROJECT PAVING LIMITS

TOWN & ROUTE	BEGIN STATION	END STATION	LANE TYPICAL	WEARING DEPTH	LEVELING	NOTES
					TONS	
BERLIN, VT RTE 62	2+244.000	2+554.000	VARIABLES - SEE LAYOUT SHEETS	45 mm	372	COLD PLANE 60 mm, LEVEL W/15 mm TYPE IVS, THEN OVERLAY W/45 mm TYPE IIIS.
BERLIN, VT RTE 62	2+554.000	4+065.000	VARIABLES - SEE LAYOUT SHEETS	45 mm	771	COLD PLANE 60 mm, LEVEL W/15 mm TYPE IVS, THEN OVERLAY W/45 mm TYPE IIIS.
BERLIN, VT RTE 62	4+065.000	4+722.571	VARIABLES - SEE LAYOUT SHEETS	45 mm	535	COLD PLANE 60 mm, LEVEL W/15 mm TYPE IVS, THEN OVERLAY W/45 mm TYPE IIIS.
BARRE CITY, VT RTE 62	0+000.000	2+238.140	VARIABLES - SEE LAYOUT SHEETS	45 mm	1565	COLD PLANE 60 mm, LEVEL W/15 mm TYPE IVS, THEN OVERLAY W/45 mm TYPE IIIS.
BARRE CITY, VT RTE 62	2+238.140	2+263.140	1.2 m - 7.2 m - 7.2 m - 1.2 m	30 mm	30	BRIDGE #1 - COLD PLANE 30 mm, THEN OVERLAY W/30 mm TYPE IVS.
BARRE CITY, VT RTE 62	2+263.140	2+539.000	VARIABLES - SEE LAYOUT SHEETS	45 mm	190	COLD PLANE 60 mm, LEVEL W/15 mm TYPE IVS, THEN OVERLAY W/45 mm TYPE IIIS.
BERLIN, RAMP A	0+000.000	0+070.000	VARIABLES - SEE LAYOUT SHEETS	45 mm	INCLUDED IN MAINLINE QUANTITY	COLD PLANE 60 mm, LEVEL W/15 mm TYPE IVS, THEN OVERLAY W/45 mm TYPE IIIS.
BERLIN, RAMP A	0+070.000	0+372.800	1.2 m - 4.8 m - 2.4 m	45 mm	83	COLD PLANE 60 mm, LEVEL W/15 mm TYPE IVS, THEN OVERLAY W/45 mm TYPE IIIS.
BERLIN, RAMP A	0+372.800	0+419.600	1.2 m - 4.8 m - 2.4 m	30 mm	28	BRIDGE #1 - COLD PLANE 30 mm, THEN OVERLAY W/30 mm TYPE IVS.
BERLIN, RAMP A	0+419.600	0+935.000	1.2 m - 4.8 m - 2.4 m	45 mm	156	COLD PLANE 60 mm, LEVEL W/15 mm TYPE IVS, THEN OVERLAY W/45 mm TYPE IIIS.

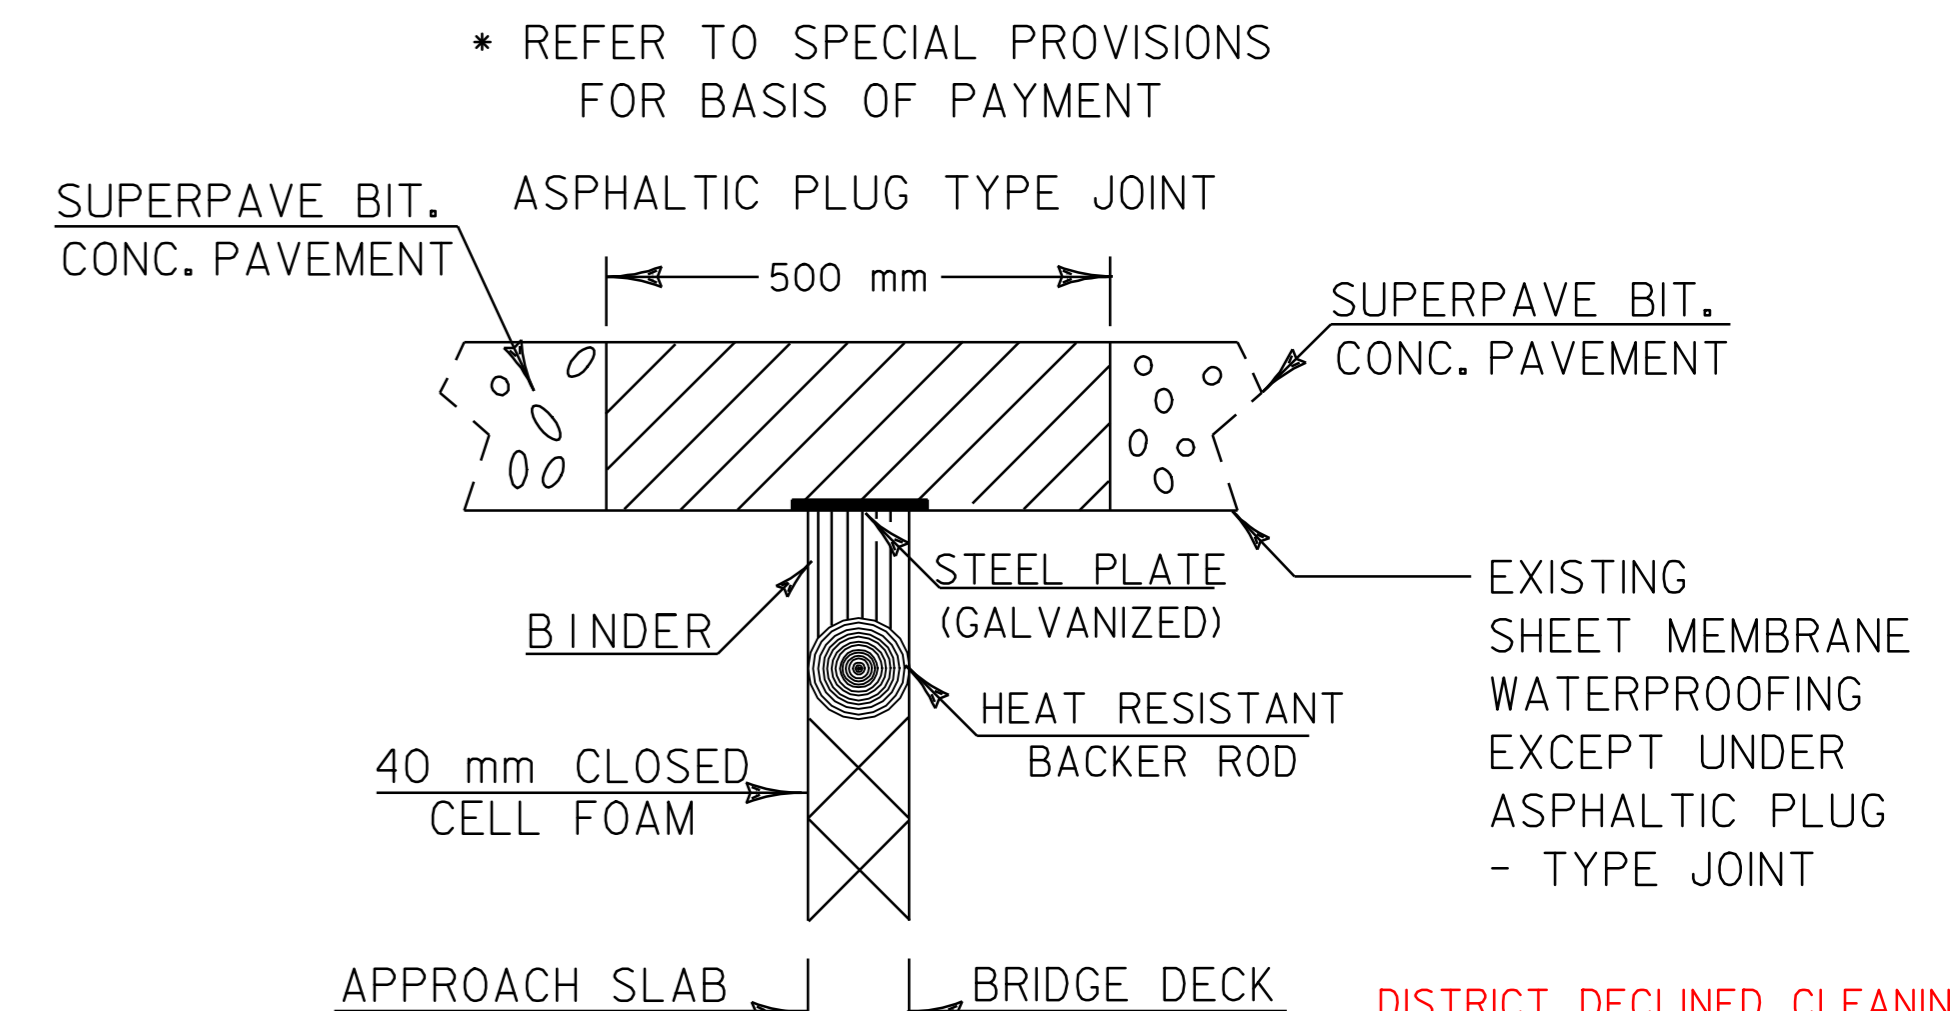

**ASPHALTIC PLUG-TYPE
JOINT DETAIL**

- * REFER TO SPECIAL PROVISIONS FOR BASIS OF PAYMENT
- 1.) BERLIN RAMP A BRIDGE #1 OVER VT 62 STA. 0+396.193, EACH PLUG JOINT REQUIRED. COLD PLANE UP TO AND BEYOND THE EXPERIMENTAL PLATE JOINT. PRIOR TO RESURFACING BRIDGE, DISTRICT #6 PERSONNEL SHOULD BE NOTIFIED WITH SUFFICIENT TIME TO ALLOW FOR THE PROPER CLEANING AND SEALING OF THE EXPERIMENTAL PLATE EXPANSION JOINT.
 - 2.) BARRE CITY VT 62 BRIDGE #11 OVER BLACKWELL STREET STA. 2+250.640, 2 EACH PLUG JOINTS REQUIRED, ONE AT EACH ABUTMENT.

DISTRICT DECLINED CLEANING & SEALING OF PLATE JOINT DUE TO PREDOMINANT FAILURE OF THAT JOINT.

NOT TO SCALE

**PROJECT TYPICAL
SHEET # 2**

PROJECT NAME: BERLIN-BARRE CITY	PLOT DATE: 12-MAR-2007 11:08
PROJECT NUMBER: STP 232(1)S	DRAWN BY: LOCKE
FILE NAME: /pave/01b022/pb022.dgn	CHECKED BY:
PROJECT LEADER: WOOLLAVER	SHEET 3 OF 39
DESIGNED BY: LOCKE	
pb022+yp2.1	

ITEM DETAIL SUMMARY SHEET



STATION		POS.	203.15	203.16	203.30	301.28	402.12 (MOD.)	NEW PIPE			GRATE TYPE	604.40	604.412	616.35	620.30	616.47	501.25	507.15	621.20	621.20	621.505	621.60	621.52	621.80	REMARKS	
BEGIN	END		COMMON EXCAV. m³	SOLID ROCK EXCAV. m³	EARTH BORROW m³	SUBBASE OF CR. GRAVEL T	AGGREGATE SHOULDERS T	D	L	TH/CL		EA	EA	REHAB DI CLASS I EA	TREATED TIMBER CURB M	DRIVE GATE FOR WW/FENCE EA	BIT. CONC. GUTTERS & TRAFFIC ISLANDS T	CONC. CLASS B m³	REINF. STEEL KG	STEEL BEAM G.R. M	STEEL BEAM G.R. (MOD) M	MANUFACT. TERMINAL SECTION EA	ANCHOR FOR STEEL BEAM RAIL EA	TRAILING END TERMINAL EA		REMOVAL AND DISPOSAL OF G.R. M
2+324	2+324	MED.										I			0.50									57	REHAB DI AND DISPOSAL OF EXISTING GUARDRAIL	
2+328	2+328	MED.			20							II			0.75					I	I	I			INSTALL NEW CONCRETE GUTTER	
2+329	2+329	MED.										II						42						215	REHAB DI AND DISPOSAL OF EXISTING GUARDRAIL	
2+363	2+363	MED.										I			3.50						I			54	REHAB DI AND DISPOSAL OF EXISTING GUARDRAIL	
2+390	2+390	MED.			20			450	15	CPEP(SL)	I-B	2					2.23	103	202				I		REHAB DI AND DISPOSAL OF EXISTING GUARDRAIL	
2+419	2+419	MED.										II			0.75							I			REHAB DI AND DISPOSAL OF EXISTING GUARDRAIL	
2+443	2+443	MED.										I	654		0.75				39						REHAB DI AND DISPOSAL OF EXISTING GUARDRAIL	
2+443	2+324	MED.			20							II			0.75								I	235	REHAB DI AND DISPOSAL OF EXISTING GUARDRAIL	
2+443	0+674	RT.										I							231						INSTALL NEW STEEL BEAM GUARDRAIL	
2+474	2+474	MED.			20							I									I			313	REHAB DI AND DISPOSAL OF EXISTING GUARDRAIL	
2+474	0+678	RT.			20							I											I		INSTALL NEW TRAILING END TERMINAL	
2+474	2+474	MED.			20							I			0.75						I			107	REHAB DI AND DISPOSAL OF EXISTING GUARDRAIL	
2+476	2+476	RT.										I			0.25						I				INSTALL NEW ANCHOR FOR STEEL BEAM GUARDRAIL	
2+476	4+503	LT.			20							I			0.25						I				REHAB DI AND DISPOSAL OF EXISTING GUARDRAIL	
2+476	0+945	LT.										I			26										CONSTRUCT NEW BITUMINOUS CONCRETE GUTTER	
2+476	2+476	MED.			20							I							908				I		INSTALL NEW STEEL BEAM GUARDRAIL	
2+476	2+476	LT.										I													REHAB DI	
2+476	2+476	RT.										I												428	REHAB DI AND DISPOSAL OF EXISTING GUARDRAIL	
2+476	PROJECT	LT.-RT.				I	7080					I													QUANTITIES SHOWN ARE TO BE USED AT LOCATIONS AS DIRECTED BY THE RESIDENT ENGINEER.	
2+476	3+149	MED.			20							I			0.75						I	I			INSTALL NEW CONCRETE GUTTER	
2+476	SUBTOTALS				20	I	7080	450	15	CPEP(SL)	I-B	I	6		26.75	2.23	103	231			I	I		235	INSTALL NEW STEEL BEAM GUARDRAIL	
2+476	4+503	RT.			20							I	364										I		INSTALL NEW STEEL BEAM GUARDRAIL	
2+476	PROJECT TOTALS	MED.			480	I	7080	450	15	CPEP(SL)	I-B	I	80	1204	I	50.50	2.23	103	3063		I3	II	II	3855	INSTALL NEW ANCHOR BEAM GUARDRAIL	
2+476		MED.										I			I										REHAB DI CONSTRUCT NEW BITUMINOUS CONCRETE GUTTER	
2+476		MED.										II			0.75										REHAB DI CONSTRUCT NEW BITUMINOUS CONCRETE GUTTER	
2+476		MED.										I			0.75										REHAB DI CONSTRUCT NEW BITUMINOUS CONCRETE GUTTER	
2+476		MED.										II			0.75										REHAB DI CONSTRUCT NEW BITUMINOUS CONCRETE GUTTER	
2+476	3+571	MED.			20							I			0.75						I				REHAB DI AND DISPOSAL OF EXISTING GUARDRAIL	
2+476	2+464	MED.										I		I	0.75									191	REHAB DI AND DISPOSAL OF EXISTING GUARDRAIL	
2+476	2+330	MED.			20							I			I				187					206	REHAB DI AND DISPOSAL OF EXISTING GUARDRAIL	
2+476	2+468	MED.			20							I			0.75						I				186	REHAB DI AND DISPOSAL OF EXISTING GUARDRAIL
2+476	2+445	MED.										I							175						1218	REHAB DI AND DISPOSAL OF EXISTING GUARDRAIL
2+476	3+958	MED.			20							I			0.25						I				REHAB DI AND DISPOSAL OF EXISTING GUARDRAIL	
2+476	0+620	RT.										I	186												739	REHAB DI AND DISPOSAL OF EXISTING GUARDRAIL
2+476	0+525	MED.			20							I			0.50				184				I			INSTALL NEW CONCRETE GUTTER
2+476	0+232	RT.										I							007				I			INSTALL NEW STEEL BEAM GUARDRAIL
2+476	0+822	MED.			20							I			I				124				I			REHAB DI AND DISPOSAL OF EXISTING GUARDRAIL
2+476		MED.										I														REHAB DI AND DISPOSAL OF EXISTING GUARDRAIL
2+476	2+462	MED.			20							I			0.75						I					REHAB DI AND DISPOSAL OF EXISTING GUARDRAIL
2+476	2+464	MED.			20							I			0.75								I			REHAB DI AND DISPOSAL OF EXISTING GUARDRAIL
2+476	4+150	MED.			20							I			0.25								I			INSTALL NEW CONCRETE GUTTER
2+476	0+643	MED.			20							I														INSTALL NEW MTS (FLARED)

SUBTOTALS					180								20	550	I	0.25			653		0	2	3	1608	
		PROJECT NAME : BERLIN-BARRE CITY										PROJECT NO. : STP 232(1)S													
		DESIGN FILE NAME: /pave/01b022/pb022.dgn										PLOT DATE: 12-MAR-2007 11:51													
		IPARM FILE NAME: pb022.dgn										SURVEY DATE: 06/02													
		SURVEYED BY: LOCKE/WHEELER										DRAWN BY: LOCKE													
		DESIGNED BY: LOCKE										SHEET: 1 OF 39													

ITEM DETAIL SUMMARY SHEET



STATION		POS.	203.15	203.16	203.30	301.28	402.12 (MOD.)	NEW PIPE			GRATE TYPE	604.40	604.412	616.35	620.30	616.47	501.25	507.15	621.20	621.20	621.505	621.60	621.52	621.80	REMARKS	
BEGIN	END		COMMON EXCAV. m³	SOLID ROCK EXCAV. m³	EARTH BORROW m³	SUBBASE OF CR. GRAVEL T	AGGREGATE SHOULDERS T	D	L	TH/CL		EA	EA	REHAB DI CLASS I EA	TREATED TIMBER CURB M	DRIVE GATE FOR WW/FENCE EA	BIT. CONC. GUTTERS & TRAFFIC ISLANDS T	CONC. CLASS B m³	REINF. STEEL KG	STEEL BEAM G.R. M	STEEL BEAM G.R. (MOD) M	MANUFACT. TERMINAL SECTION EA	ANCHOR FOR STEEL BEAM RAIL EA	TRAILING END TERMINAL EA		REMOVAL AND DISPOSAL OF G.R. M
2+324	2+324	MED.										I				0.50								57	REHAB DI AND DISPOSAL OF EXISTING GUARDRAIL	
2+328	2+328	MED.			20							II				0.75				I	I	I			INSTALL NEW CONCRETE GUTTER	
2+329	2+329	MED.										I							42				215	REHAB DI AND DISPOSAL OF EXISTING GUARDRAIL		
2+363	2+363	MED.										I				3.50					I			54	REHAB DI AND DISPOSAL OF EXISTING GUARDRAIL	
2+390	2+390	MED.			20			450	15	CPEP(SL)	I-B	2					2.23	103	202				I		REHAB DI AND DISPOSAL OF EXISTING GUARDRAIL	
2+419	2+419	MED.										II				0.75					I				REHAB DI AND DISPOSAL OF EXISTING GUARDRAIL	
2+443	2+443	MED.										I	654			0.75			39					235	REHAB DI AND DISPOSAL OF EXISTING GUARDRAIL	
2+443	2+443	MED.			20							II				0.75							I		REHAB DI AND DISPOSAL OF EXISTING GUARDRAIL	
2+474	2+474	MED.			20							I							231						INSTALL NEW STEEL BEAM GUARDRAIL	
2+474	2+474	MED.			20							I									I	I		313	REHAB DI AND DISPOSAL OF EXISTING GUARDRAIL	
2+474	2+474	MED.			20							I				0.75							I	107	REHAB DI AND DISPOSAL OF EXISTING GUARDRAIL	
2+474	2+474	MED.			20							I				0.25					I	I			REHAB DI AND DISPOSAL OF EXISTING GUARDRAIL	
2+474	2+474	MED.			20							I				26									REHAB DI AND DISPOSAL OF EXISTING GUARDRAIL	
2+474	2+474	MED.			20							I							908				I		REHAB DI AND DISPOSAL OF EXISTING GUARDRAIL	
2+474	2+474	MED.			20							I												428	REHAB DI AND DISPOSAL OF EXISTING GUARDRAIL	
2+474	2+474	MED.			20		7080					I				0.75					I	I			REHAB DI AND DISPOSAL OF EXISTING GUARDRAIL	
2+474	2+474	MED.			20		7080	450	15	CPEP(SL)	I-B	I	6			26.75	2.23	103	231			I	I	235	REHAB DI AND DISPOSAL OF EXISTING GUARDRAIL	
2+474	2+474	MED.			20		7080	450	15	CPEP(SL)	I-B	I	364						411				I		INSTALL NEW STEEL BEAM GUARDRAIL	
2+474	2+474	MED.			480		7080	450	15	CPEP(SL)	I-B	I	80	1204	I	50.50	2.23	103	3863		13	11	11	3855	REHAB DI AND DISPOSAL OF EXISTING GUARDRAIL	
2+474	2+474	MED.										I				I									REHAB DI AND DISPOSAL OF EXISTING GUARDRAIL	
2+474	2+474	MED.										II				0.75									REHAB DI AND DISPOSAL OF EXISTING GUARDRAIL	
2+474	2+474	MED.										I				0.75									REHAB DI AND DISPOSAL OF EXISTING GUARDRAIL	
2+474	2+474	MED.										II				0.75									REHAB DI AND DISPOSAL OF EXISTING GUARDRAIL	
2+474	2+474	MED.			20							I				0.75					I				REHAB DI AND DISPOSAL OF EXISTING GUARDRAIL	
2+464	2+464	MED.										I				0.75								191	REHAB DI AND DISPOSAL OF EXISTING GUARDRAIL	
2+464	2+464	MED.			20							I				I			187		I			206	REHAB DI AND DISPOSAL OF EXISTING GUARDRAIL	
2+464	2+464	MED.			20							I				0.75					I				186	REHAB DI AND DISPOSAL OF EXISTING GUARDRAIL
2+445	2+445	MED.										I							175					1218	REHAB DI AND DISPOSAL OF EXISTING GUARDRAIL	
2+458	2+458	MED.			20							I				0.25					I					REHAB DI AND DISPOSAL OF EXISTING GUARDRAIL
2+458	2+458	MED.										I	186											739	REHAB DI AND DISPOSAL OF EXISTING GUARDRAIL	
2+458	2+458	MED.			20							I				0.50			184		I		I			REHAB DI AND DISPOSAL OF EXISTING GUARDRAIL
2+458	2+458	MED.										I							887			I				REHAB DI AND DISPOSAL OF EXISTING GUARDRAIL
2+458	2+458	MED.			20							I				I			124				I			REHAB DI AND DISPOSAL OF EXISTING GUARDRAIL
2+458	2+458	MED.										I										I				REHAB DI AND DISPOSAL OF EXISTING GUARDRAIL
2+462	2+462	MED.			20							I				0.75					I					REHAB DI AND DISPOSAL OF EXISTING GUARDRAIL
2+464	2+464	MED.			20							I				0.75							I			REHAB DI AND DISPOSAL OF EXISTING GUARDRAIL
2+450	2+450	MED.			20							I				0.25							I			REHAB DI AND DISPOSAL OF EXISTING GUARDRAIL
2+450	2+450	MED.			20							I				0.25						I	I			REHAB DI AND DISPOSAL OF EXISTING GUARDRAIL
2+443	2+443	MED.			20							I									I					REHAB DI AND DISPOSAL OF EXISTING GUARDRAIL

SUBTOTALS				180									20	550	I	0.25			653		8	2	3	1688	
		PROJECT NAME : BERLIN-BARRE CITY												PROJECT NO. : STP 232(1)S											
		DESIGN FILE NAME: /pave/01b022/pb022.dgn												PLOT DATE: 12-MAR-2007 11:58											
		IPARM FILE NAME: pb0221d51												SURVEY DATE: 06/02											
		SURVEYED BY: LOCKE/WHEELER												DRAWN BY: LOCKE											
		DESIGNED BY: LOCKE												SHEET: 1 OF 39											

ITEM DETAIL SUMMARY SHEET



STATION		POS.	203.15	203.16	203.30	301.28	402.12 (MOD.)	NEW PIPE			GRATE TYPE	604.40	604.412	616.35	620.30	616.47	501.25	507.15	621.20	621.20	621.505	621.60	621.52	621.80	REMARKS
BEGIN	END		COMMON EXCAV. m³	SOLID ROCK EXCAV. m³	EARTH BORROW m³	SUBBASE OF CR. GRAVEL T	AGGREGATE SHOULDERS T	D	L	TH/CL		EA	EA	REHAB DI CLASS I EA	TREATED TIMBER CURB M	DRIVE GATE FOR WW/FENCE EA	BIT. CONC. GUTTERS & TRAFFIC ISLANDS T	CONC. CLASS B m³	REINF. STEEL KG	STEEL BEAM G.R. M	STEEL BEAM G.R. (MOD) M	MANUFACT. TERMINAL SECTION EA	ANCHOR FOR STEEL BEAM RAIL EA	TRAILING END TERMINAL EA	
2+324	2+324	MED.										I				0.50								57	REHAB DI AND DISPOSAL OF EXISTING GUARDRAIL
2+328	2+328	MED.			20							II				0.75				I	I	I			INSTALL NEW CONCRETE GUTTER
2+329	2+329	MED.										II							42					215	REHAB DI AND DISPOSAL OF EXISTING GUARDRAIL
2+363	2+363	MED.										I				3.50					I			54	REHAB DI AND DISPOSAL OF EXISTING GUARDRAIL
2+390	2+390	MED.			20			450	15	CPEP(SL)	I-B	2					2.23	103	202				I		REHAB DI AND DISPOSAL OF EXISTING GUARDRAIL
2+419	2+419	MED.										II				0.75						I			REHAB DI AND DISPOSAL OF EXISTING GUARDRAIL
2+443	2+443	MED.										I	654			0.75			39					235	REHAB DI AND DISPOSAL OF EXISTING GUARDRAIL
2+443	2+443	MED.			20							II				0.75							I		REHAB DI AND DISPOSAL OF EXISTING GUARDRAIL
2+474	2+474	MED.			20							I							231					313	REHAB DI AND DISPOSAL OF EXISTING GUARDRAIL
2+498	2+498	MED.			20							I				0.75					I		I	107	REHAB DI AND DISPOSAL OF EXISTING GUARDRAIL
2+503	2+503	MED.			20							I				0.25					I	I			REHAB DI AND DISPOSAL OF EXISTING GUARDRAIL
2+503	2+503	MED.			20							I				26									REHAB DI AND DISPOSAL OF EXISTING GUARDRAIL
2+530	2+530	MED.			20							I							908				I		REHAB DI AND DISPOSAL OF EXISTING GUARDRAIL
2+530	2+530	MED.			20							I												428	REHAB DI AND DISPOSAL OF EXISTING GUARDRAIL
2+530	2+530	MED.			20		7080					I				0.75					I	I			REHAB DI AND DISPOSAL OF EXISTING GUARDRAIL
2+530	2+530	MED.			20		7080	450	15	CPEP(SL)	I-B	I	6			26.75	2.23	103	231			I	I	235	REHAB DI AND DISPOSAL OF EXISTING GUARDRAIL
2+530	2+530	MED.			20		7080	450	15	CPEP(SL)	I-B	I	364						411				I		REHAB DI AND DISPOSAL OF EXISTING GUARDRAIL
2+530	2+530	MED.			480		7080	450	15	CPEP(SL)	I-B	I	80	1204	I	50.50	2.23	103	3863		13	11	11	3855	REHAB DI AND DISPOSAL OF EXISTING GUARDRAIL
2+530	2+530	MED.										I				I									REHAB DI AND DISPOSAL OF EXISTING GUARDRAIL
2+530	2+530	MED.										II				0.75									REHAB DI AND DISPOSAL OF EXISTING GUARDRAIL
2+530	2+530	MED.										I				0.75									REHAB DI AND DISPOSAL OF EXISTING GUARDRAIL
2+530	2+530	MED.										II				0.75									REHAB DI AND DISPOSAL OF EXISTING GUARDRAIL
2+530	2+530	MED.			20							I				0.75					I				REHAB DI AND DISPOSAL OF EXISTING GUARDRAIL
2+530	2+530	MED.										I				0.75								191	REHAB DI AND DISPOSAL OF EXISTING GUARDRAIL
2+530	2+530	MED.			20							I				I			187					206	REHAB DI AND DISPOSAL OF EXISTING GUARDRAIL
2+530	2+530	MED.			20							I				0.75								186	REHAB DI AND DISPOSAL OF EXISTING GUARDRAIL
2+530	2+530	MED.										I							175					1218	REHAB DI AND DISPOSAL OF EXISTING GUARDRAIL
2+530	2+530	MED.			20							I													REHAB DI AND DISPOSAL OF EXISTING GUARDRAIL
2+530	2+530	MED.			20							I													REHAB DI AND DISPOSAL OF EXISTING GUARDRAIL
ITEM DETAIL SUMMARY SHEET




STATION		POS.	203.15	203.16	203.30	301.28	402.12 (MOD.)	NEW PIPE			GRATE TYPE	604.40	604.412	616.35	620.30	616.47	501.25	507.15	621.20	621.20	621.505	621.60	621.52	621.80	REMARKS
BEGIN	END		COMMON EXCAV. m³	SOLID ROCK EXCAV. m³	EARTH BORROW m³	SUBBASE OF CR. GRAVEL T	AGGREGATE SHOULDERS T	D	L	TH/CL		EA	EA	REHAB DI CLASS I EA	TREATED TIMBER CURB M	DRIVE GATE FOR WW/FENCE EA	BIT. CONC. GUTTERS & TRAFFIC ISLANDS T	CONC. CLASS B m³	REINF. STEEL KG	STEEL BEAM G.R. M	STEEL BEAM G.R. (MOD) M	MANUFACT. TERMINAL SECTION EA	ANCHOR FOR STEEL BEAM RAIL EA	TRAILING END TERMINAL EA	
2+324	2+324	MED.										I			0.50									57	REHAB DI AND DISPOSAL OF EXISTING GUARDRAIL
2+328	2+328	MED.			20							II			0.75					I	I	I			INSTALL NEW CONCRETE GUTTER
2+329	2+329	MED.										II							42					215	REHAB DI AND DISPOSAL OF EXISTING GUARDRAIL
2+363	2+363	MED.										I			3.50						I			54	REHAB DI AND DISPOSAL OF EXISTING GUARDRAIL
2+390	2+390	MED.			20			450	15	CPEP(SL)	I-B	2				2.23	103	202					I		REHAB DI AND DISPOSAL OF EXISTING GUARDRAIL
2+419	2+419	MED.										II			0.75						I				REHAB DI AND DISPOSAL OF EXISTING GUARDRAIL
2+443	2+443	MED.										II	654		0.75				39					235	REHAB DI AND DISPOSAL OF EXISTING GUARDRAIL
2+443	2+443	MED.			20							II			0.75								I		REHAB DI AND DISPOSAL OF EXISTING GUARDRAIL
2+474	2+474	MED.			20							I							231					313	REHAB DI AND DISPOSAL OF EXISTING GUARDRAIL
2+498	2+498	MED.			20							I			0.75						I		I	107	REHAB DI AND DISPOSAL OF EXISTING GUARDRAIL
2+503	2+503	MED.			20							I			0.25						I	I			REHAB DI AND DISPOSAL OF EXISTING GUARDRAIL
2+503	2+503	MED.			20							I			26								I		REHAB DI AND DISPOSAL OF EXISTING GUARDRAIL
2+530	2+530	MED.										II												428	REHAB DI AND DISPOSAL OF EXISTING GUARDRAIL
2+530	2+530	MED.			20		7080					I			0.75						I	I			REHAB DI AND DISPOSAL OF EXISTING GUARDRAIL
2+530	2+530	MED.			20		7080	450	15	CPEP(SL)	I-B	I	6		26.75	2.23	103	231			I	I	I	235	REHAB DI AND DISPOSAL OF EXISTING GUARDRAIL
2+530	2+530	MED.			20		7080	450	15	CPEP(SL)	I-B	I	364						411				I		REHAB DI AND DISPOSAL OF EXISTING GUARDRAIL
2+530	2+530	MED.			480		7080	450	15	CPEP(SL)	I-B	I	80	1204	50.50	2.23	103	3863			I	II	II	3855	REHAB DI AND DISPOSAL OF EXISTING GUARDRAIL
2+530	2+530	MED.										I			1										REHAB DI AND DISPOSAL OF EXISTING GUARDRAIL
2+530	2+530	MED.										II			0.75										REHAB DI AND DISPOSAL OF EXISTING GUARDRAIL
2+530	2+530	MED.										I			0.75										REHAB DI AND DISPOSAL OF EXISTING GUARDRAIL
2+530	2+530	MED.										II			0.75										REHAB DI AND DISPOSAL OF EXISTING GUARDRAIL
2+530	2+530	MED.			20							I			0.75						I				REHAB DI AND DISPOSAL OF EXISTING GUARDRAIL
2+530	2+530	MED.										I			0.75									191	REHAB DI AND DISPOSAL OF EXISTING GUARDRAIL
2+530	2+530	MED.			20							I			1				187					206	REHAB DI AND DISPOSAL OF EXISTING GUARDRAIL
2+530	2+530	MED.			20							I			0.75									186	REHAB DI AND DISPOSAL OF EXISTING GUARDRAIL
2+530	2+530	MED.										I							175					1218	REHAB DI AND DISPOSAL OF EXISTING GUARDRAIL
2+530	2+530	MED.			20							I			0.25										REHAB DI AND DISPOSAL OF EXISTING GUARDRAIL
SUBTOTALS				180									20	550	1	0.25			653		8	2	3	1888	
		PROJECT NAME : BERLIN-BARRE CITY										PROJECT NO. : STP 232(1)S													
		DESIGN FILE NAME: /pave/01b022/pb022.dgn										PLOT DATE: 12-MAR-2007 11:58													
		IPARM FILE NAME: pb0221d51										SURVEY DATE: 06/02													
		SURVEYED BY: LOCKE/WHEELER										DRAWN BY: LOCKE													
		DESIGNED BY: LOCKE										SHEET: 1 OF 39													

LOCATION				METERS OF DITCHING			MISC. ITEMS			REMARKS
SITE	STATION	STATION	POS.	PERCENT GRADE			654.10	613.10	649.31	
				0-1	1-2.5	2.5-10	EROS. MATT.	STONE FILL TYP. 1	GEOT. UNDER STONE FILL	
							m2	m3	m2	
VT ROUTE 62 DISTRICT #6							m2	m3	m2	
1	2+242	2+300	RT.			58		17	58	
2	2+400	3+237	RT.			837		251	837	
3	3+282	3+990	RT.			708		212	708	
4	3+676	3+795	LT.		119		119			
5	4+150	4+535	RT.		385		385			
6	4+570	0+265	RT.		417		417			
7	0+271	1+768	RT.		1497		1497			
8	0+430	0+500	LT.		70		70			
9	0+749	0+904	LT.		155		155			
10	1+469	1+501	LT.		32		32			
RAMP A										
11	0+000	0+360	RT.		360		108	360		
TOTALS					2675	1963	2675	588	1963	
SUBTOTALS										

LOCATION				METERS OF DITCHING			MISC. ITEMS			REMARKS
SITE	STATION	STATION	POS.	PERCENT GRADE			654.10	613.10	649.31	
				0-1	1-2.5	2.5-10	EROS. MATT.	STONE FILL TYP. 1	GEOT. UNDER STONE FILL	
							m2	m3	m2	
							m2	m3	m2	

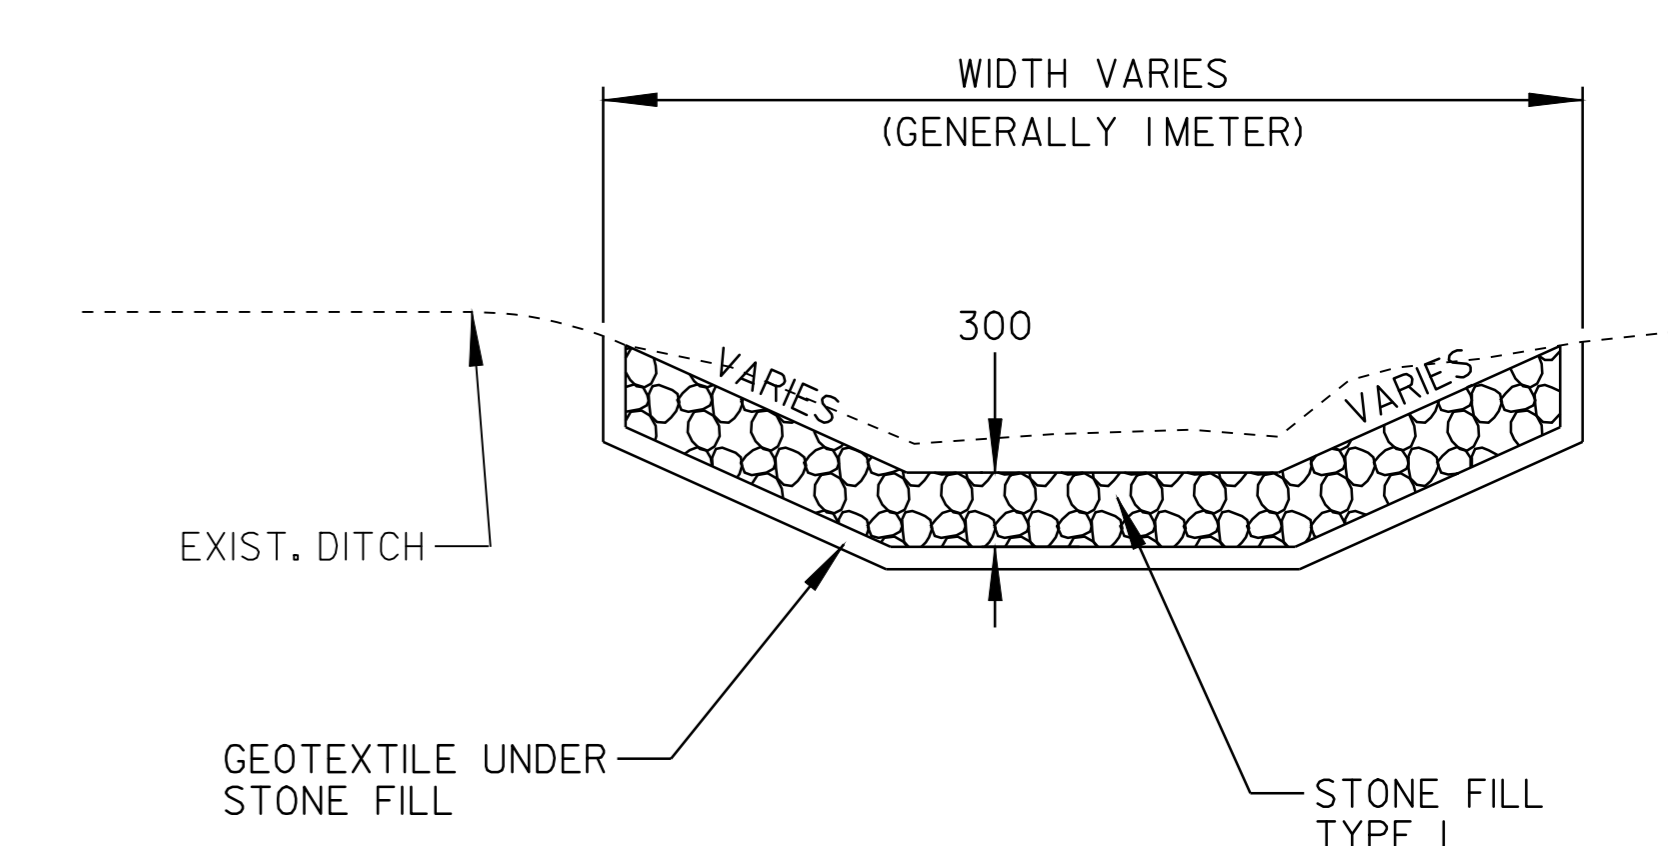

DITCH DETAIL

NOT TO SCALE

NOTES:

PIPE INLET AND OUTLET AREAS, AND DITCH CLEANING THROUGH PROJECT, SHALL BE PERFORMED AT LOCATIONS AND AS DIRECTED BY THE RESIDENT ENGINEER. PAYMENT WILL BE UNDER THE APPLICABLE EQUIPMENT RENTAL ITEM(S).

AN ESTIMATED QUANTITY OF EROSION MATTING AND STONE FILL TYPE 1 HAS BEEN INCLUDED. EROSION MATTING SHALL BE USED IN ALL DITCHES WITH A GRADE BETWEEN 0 AND 2.5 PERCENT AND STONE FILL TYPE 1 SHALL BE USED IN ALL DITCHES WITH A GRADE GREATER THAN 2.5 PERCENT OR AS DIRECTED BY THE RESIDENT ENGINEER.



DITCH CLEANING DETAIL SHEET	PROJECT :	BERLIN-BARRE CITY	PROJECT NO. :	STP 232(K)S
	DESIGN FILE NAME:	/pave/01b022/pb022.dgn	PLOT DATE:	12-MAR-2007
	IPARM FILE NAME:	pb022.d.d	SURVEYED BY:	LOCKE/WHEELER
	SURVEYED BY:	LOCKE/WHEELER	SURVEY DATE:	6/02
	SQUAD LEADER:	WOOLAYER	DRAWN BY:	LOCKE
			SHEET:	12 OF 39

REMOVING SIGNS

3 EACH

PAINTED CURB

STA. 2+544 - STA. 2+554 LT. & RT.

TEMPORARY AND DURABLE LETTERS OR SYMBOLS

STA. 2+495 LT. (YIELD)

BITUMINOUS CONCRETE GUTTERS AND TRAFFIC ISLANDS

STA. 2+540 LT. - RT.


REHABILITATION OF DI'S, CB'S, OR MH'S - CLASS I

STA. 2+545 MEDIAN


STA. 2+494 LT.

STA. 2+496 LT.

RETAIN

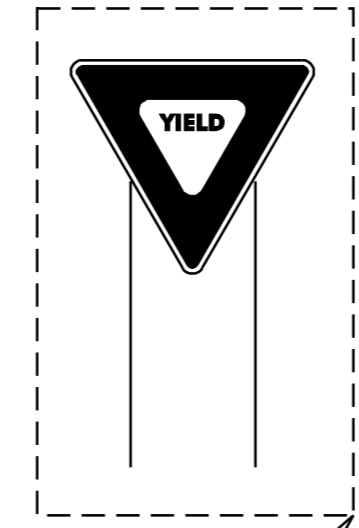

2+580 TO 2+400 LT & BERLIN STATE HIGHWAY APPROACH COLD PLANED 5/2/05

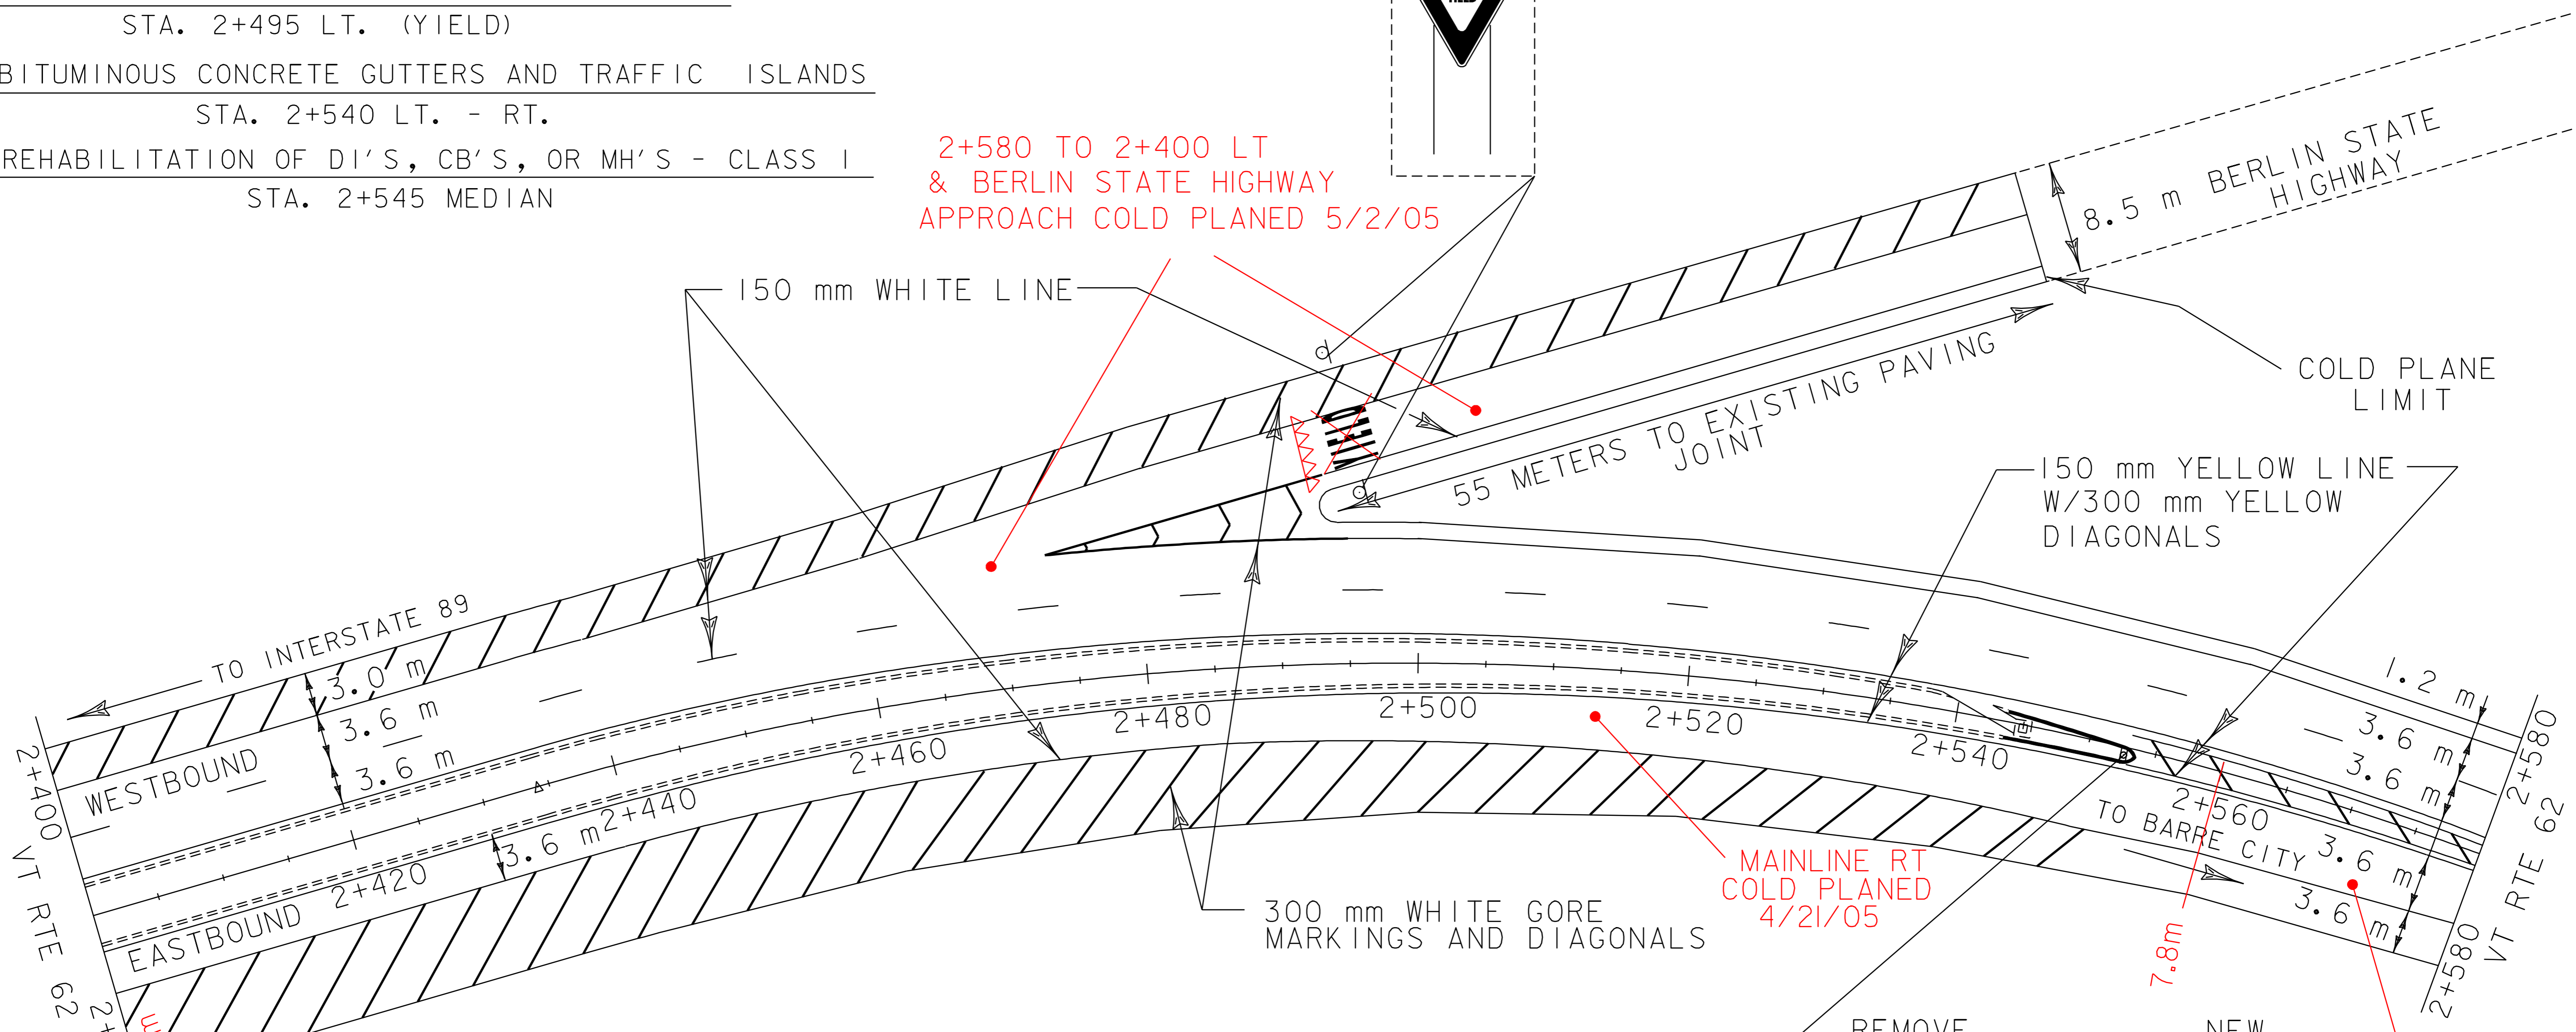

TEMPORARY AND DURABLE 150 mm WHITE LINE

- STA. 2+400 LT. (MAINLINE) - STA. 2+545 LT. (ALONG BERLIN STATE HIGHWAY) (SOLID)
- STA. 2+400 LT. - STA. 2+580 LT. (DASHED)
- STA. 2+495 LT. - STA. 2+545 LT. (ALONG BERLIN STATE HIGHWAY) (SOLID)
- STA. 2+495 LT. - STA. 2+580 LT. (SOLID)
- STA. 2+400 RT. - STA. 2+580 RT. (SOLID)

TEMPORARY AND DURABLE 150 mm YELLOW LINE



- STA. 2+400 LT. & RT. - STA. 2+580 LT. & RT. (SOLID)

TEMPORARY AND DURABLE 300 mm WHITE LINE

- STA. 2+400 RT. - STA. 2+551 RT. (DIAGONALS)
- STA. 2+474 LT. - STA. 2+495 LT. (GORE MARKINGS/DIAGONALS)
- STA. 2+400 LT. - STA. 2+541 LT. (DIAGONALS)

TEMPORARY AND DURABLE 300 mm YELLOW LINE


- STA. 2+555. LT. & RT. - STA. 2+580 LT. & RT. (DIAGONALS)

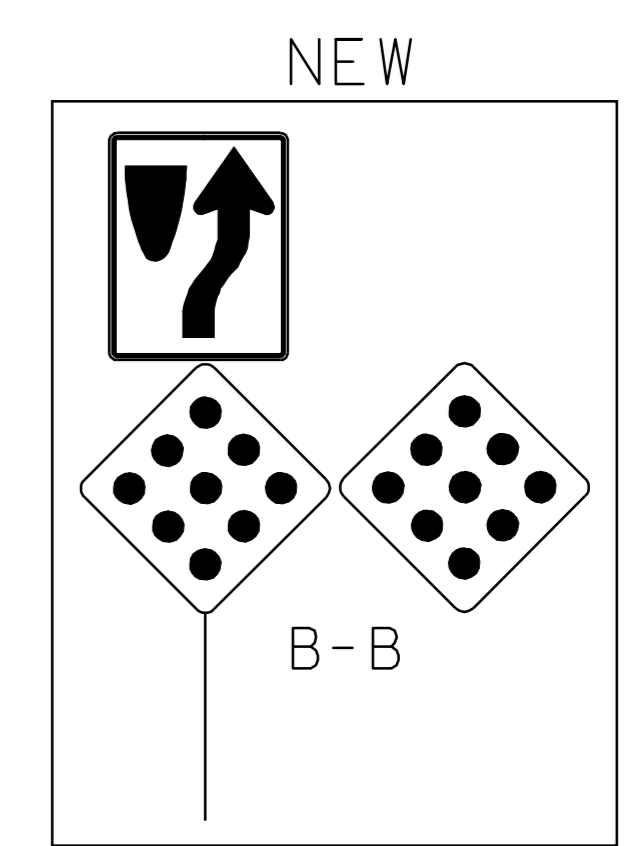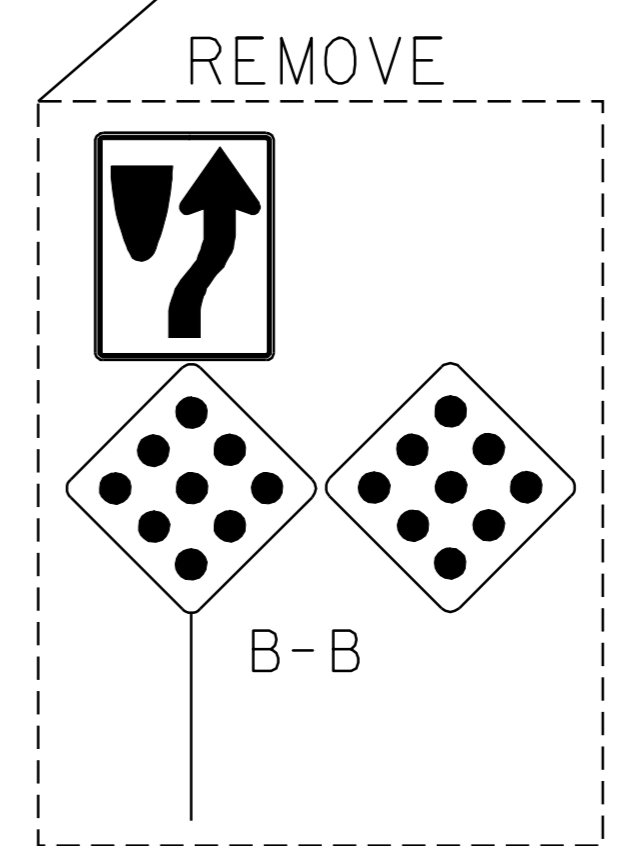

STA. 2+553 RT.

PAVING PROJECT LAYOUT #2


PROJECT NAME: BERLIN-BARRE CITY	PLOT DATE: 12-MAR-2007 11:09
PROJECT NUMBER: STP 232(I)S	DRAWN BY: LOCKE
FILE NAME: /pave/01b022/pb022.dgn	CHECKED BY:
PROJECT LEADER: WOOLLAVER	SHEET 14 OF 39
DESIGNED BY: LOCKE	
pb0221a2.i	

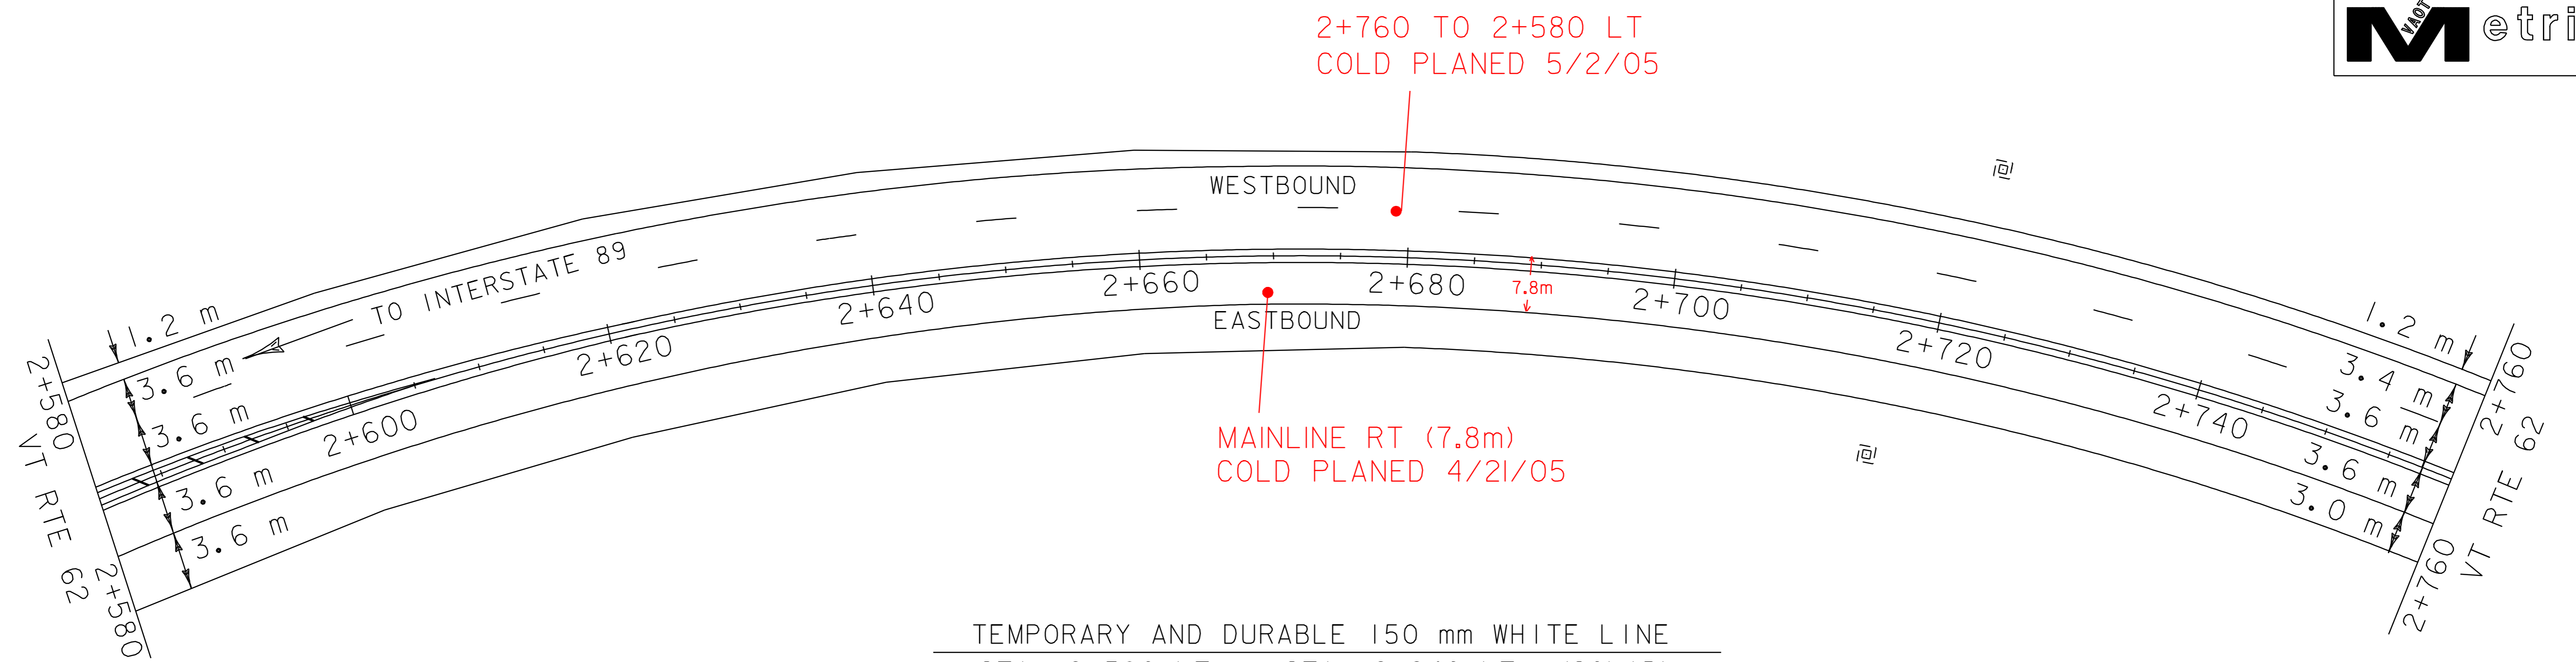


TEMPORARY AND DURABLE 150 mm WHITE LINE
 STA. 2+580 LT. - STA. 2+940 LT. (SOLID)
 STA. 2+580 LT. - STA. 2+940 LT. (DASHED)
 STA. 2+580 RT. - STA. 2+940 RT. (SOLID)

TEMPORARY AND DURABLE 150 mm YELLOW LINE
 STA. 2+580 LT. & RT. - STA. 2+940 LT. & RT. (SOLID)

TEMPORARY AND DURABLE 300 mm YELLOW LINE
 STA. 2+580 - STA. 2+597 (CENTERLINE/DIAGONALS)

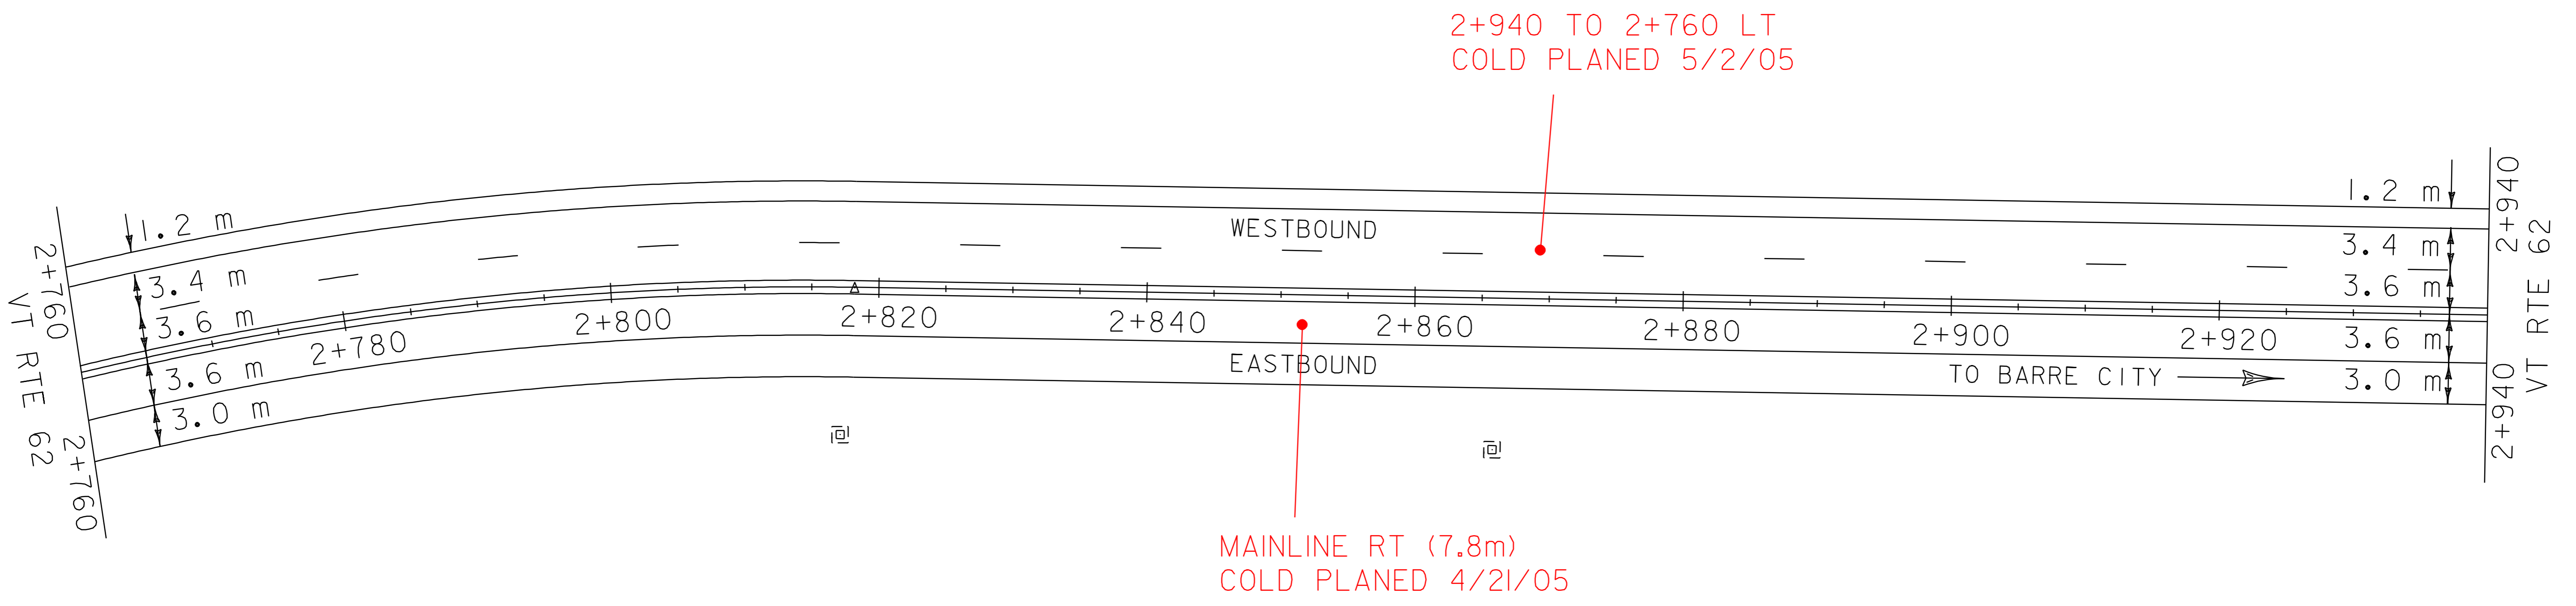


PAVING PROJECT LAYOUT #3	PROJECT NAME: BERLIN-BARRE CITY	PLOT DATE: 12-MAR-2007 11:09
	PROJECT NUMBER: STP 2321(1)S	DRAWN BY: LOCKE
	FILE NAME: /pave/01b022/pb022.dgn	CHECKED BY:
	DESIGNED BY: LOCKE	SHEET 15 OF 39

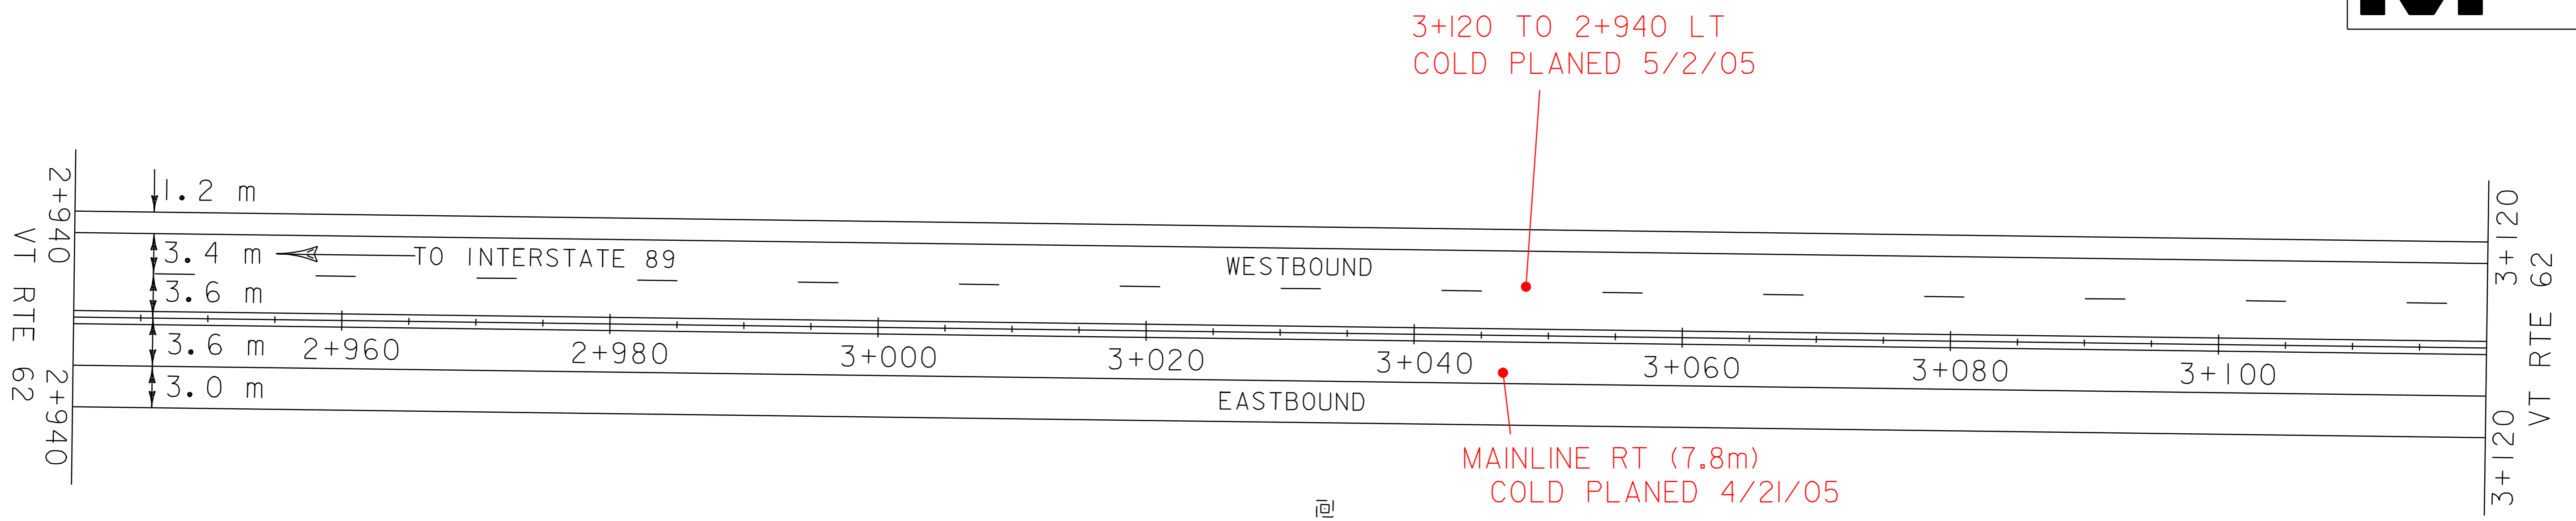

TEMPORARY AND DURABLE 150 mm WHITE LINE
 STA. 2+940 LT. - STA. 3+300 LT. (SOLID)
 STA. 2+940 LT. - STA. 3+300 LT. (DASHED)
 STA. 2+940 RT. - STA. 3+300 RT. (SOLID)
 TEMPORARY AND DURABLE 150 mm YELLOW LINE
 STA. 2+940 LT. & RT. - STA. 3+300 LT. & RT. (SOLID)

REMOVAL AND DISPOSAL OF GUARDRAIL
 STA. 3+138 LT. - 3+300 LT.
 MANUFACTURED TERMINAL SECTION (FLARED)
 STA. 3+138 LT. - STA. 3+149 LT.
 STEEL BEAM GUARDRAIL
 STA. 3+149 LT. - STA. 3+300 LT.
 TREATED TIMBER CURB
 STA. 3+146 LT. - STA. 3+300 LT.

REHABILITATION OF DI'S, CB'S, OR MH'S - CLASS I
 STA. 3+216 LT.

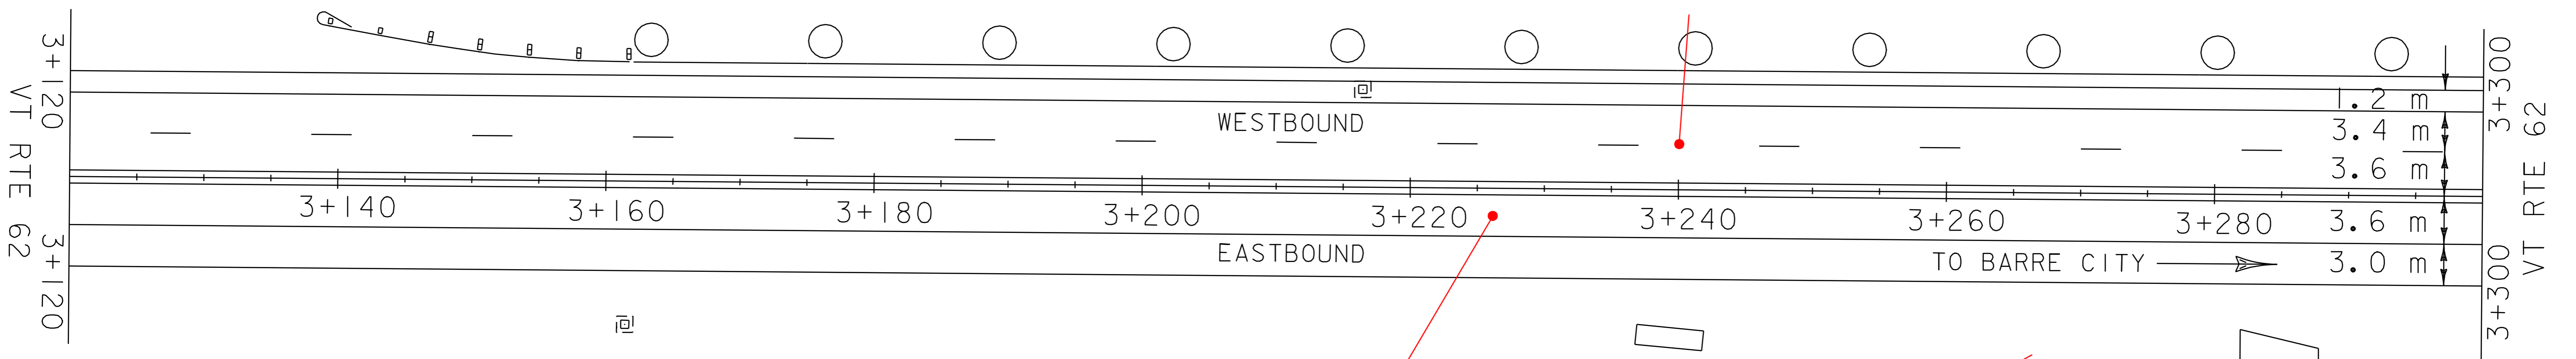


MAINLINE RT (7.8m)
 COLD PLANNED 4/21/05

~~STA. 3+237 - 3+242 RT.
 REMOVE
 EXISTING PAVED
 GUTTER
 (5 m X 1.5 m)
 REPLACE W/STONE FILL,
 TYPE I~~

~~STA. 3+282 - 3+287 RT.
 REMOVE
 EXISTING PAVED
 GUTTER
 (6 m X 3 m)
 REPLACE W/STONE FILL,
 TYPE I~~

REMOVAL OF PAVED GUTTERS
 NOT DONE, AS PER MEETING
 WITH CARL FIELDER, KEVIN LOCKE
 & CRAIG DIGIAMMARINO 4/8/05

PAVING PROJECT LAYOUT #4	PROJECT NAME: BERLIN-BARRE CITY	PLOT DATE: 12-MAR-2007 11:09
	PROJECT NUMBER: STP 2321(I)S	DRAWN BY: LOCKE
	FILE NAME: /pave/01b022/pb022.dgn	CHECKED BY:
	PROJECT LEADER: WOOLLAVER DESIGNED BY: LOCKE pb0221a4.i	SHEET 16 OF 39

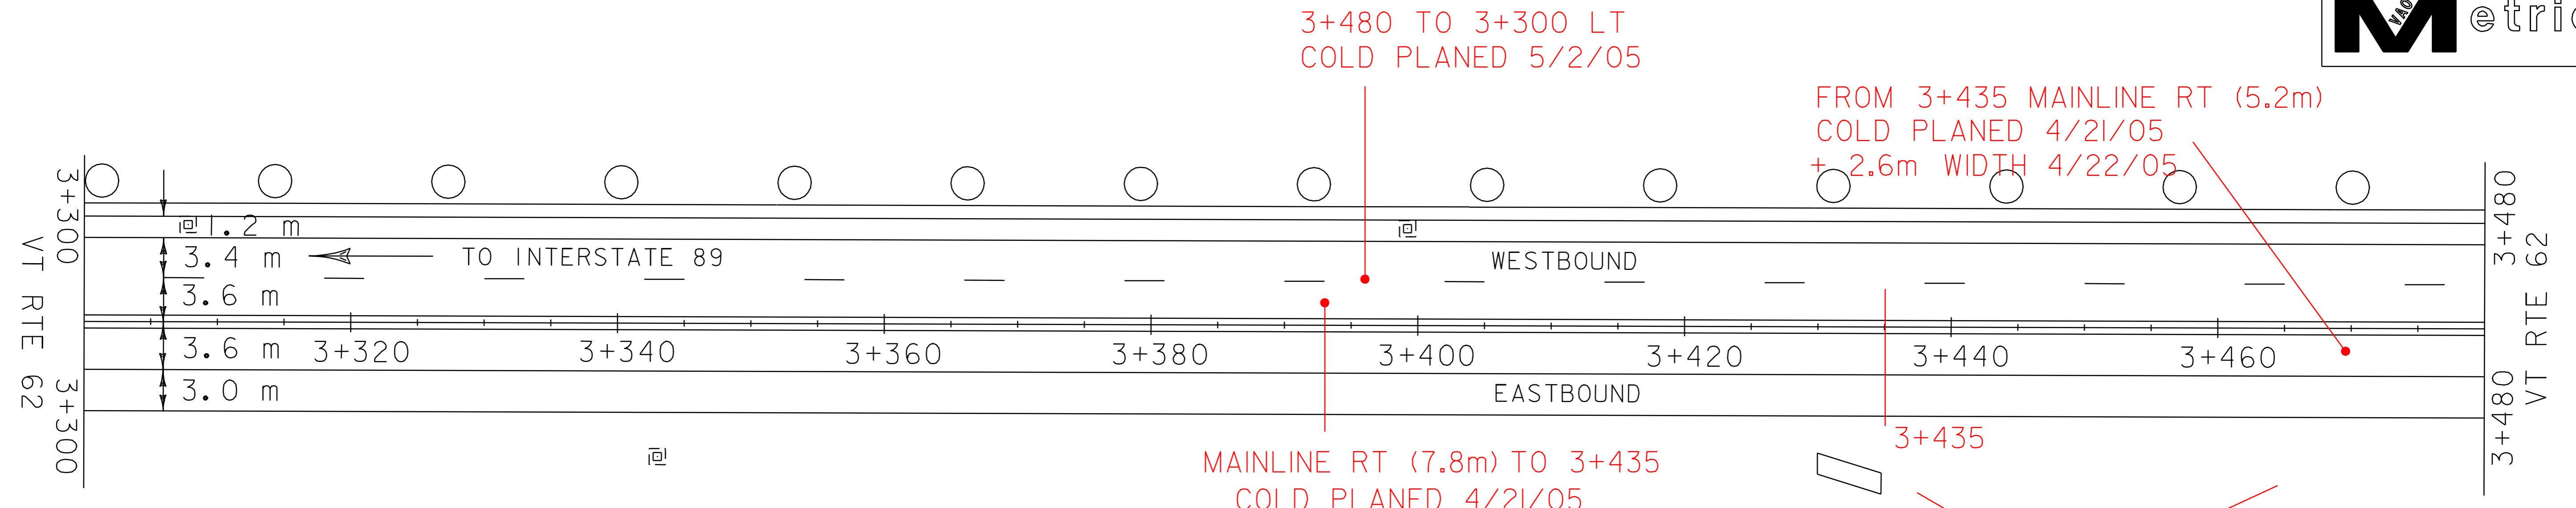

TEMPORARY AND DURABLE 150 mm WHITE LINE
 STA. 3+300 LT. - STA. 3+660 LT. (SOLID)
 STA. 3+300 LT. - STA. 3+660 LT. (DASHED)
 STA. 3+300 RT. - STA. 3+660 RT. (SOLID)

TEMPORARY AND DURABLE 150 mm YELLOW LINE
 STA. 3+300 LT. & RT. - STA. 3+660 LT. & RT. (SOLID)

BITUMINOUS CONCRETE GUTTERS AND TRAFFIC ISLANDS
 STA. 3+430 RT. - STA. 3+435 RT.

~~STA. 3+430 - 3+435 RT.
 REMOVE EXISTING PAVED GUTTER (5 m X 1.5 m)
 REPLACE W/STONE FILL TYPE I~~


NOT DONE
SEE NOTE ON SHEET 16

REMOVAL AND DISPOSAL OF GUARDRAIL
 STA. 3+300 LT. - STA. 3+571 LT.

MANUFACTURED TERMINAL SECTION (FLARED)
 STA. 3+560 LT. - STA. 3+571 LT.

STEEL BEAM GUARDRAIL
 STA. 3+300 LT. - STA. 3+560 LT.

TREATED TIMBER CURB
 STA. 3+300 LT. - STA. 3+510 LT.

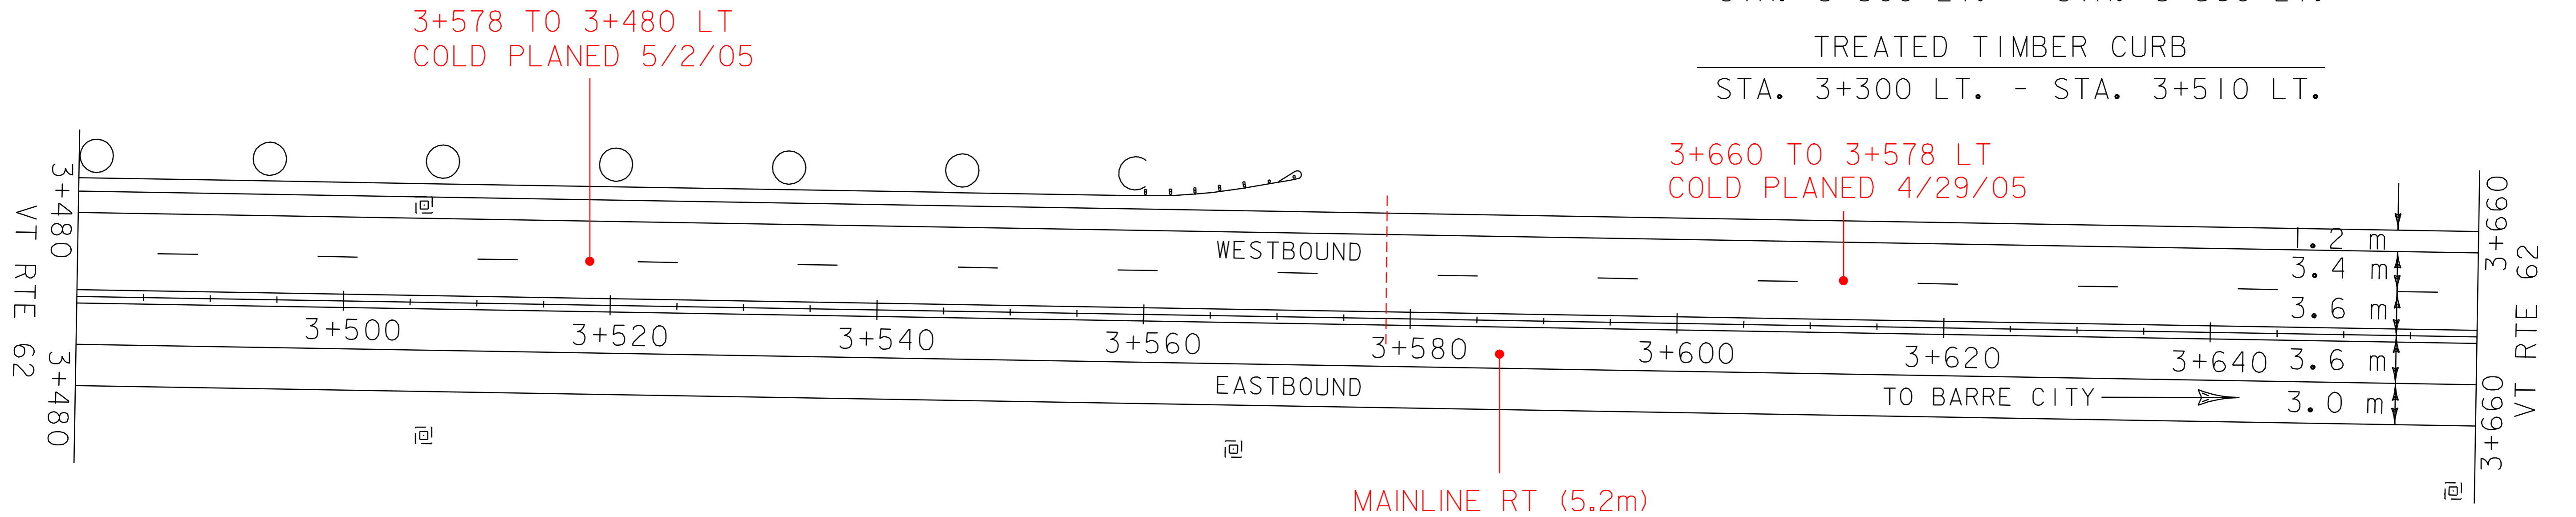

REHABILITATION OF DI'S, CB'S, OR MH'S - CLASS I
 STA. 3+308 LT.
 STA. 3+399 LT.
 STA. 3+506 LT.


MAINLINE RT (5.2m)
COLD PLANED 4/21/05
+ 2.6m WIDTH 4/22/05

PAVING PROJECT LAYOUT #5	PROJECT NAME: BERLIN-BARRE CITY	PLOT DATE: 12-MAR-2007 11:09
	PROJECT NUMBER: STP 2321(1)S	DRAWN BY: LOCKE
	FILE NAME: /pave/01b022/pb022.dgn	CHECKED BY:
	PROJECT LEADER: WOOLLAVER	SHEET 17 OF 39
	DESIGNED BY: LOCKE	
	pb022a5.i	

MAINLINE RT (5.2m)
COLD PLANED 4/21/05
+2.6m WIDTH 4/22/05

3+840 TO 3+660 LT
COLD PLANED 4/29/05

DITCH AROUND
EXISTING JCT. BOX

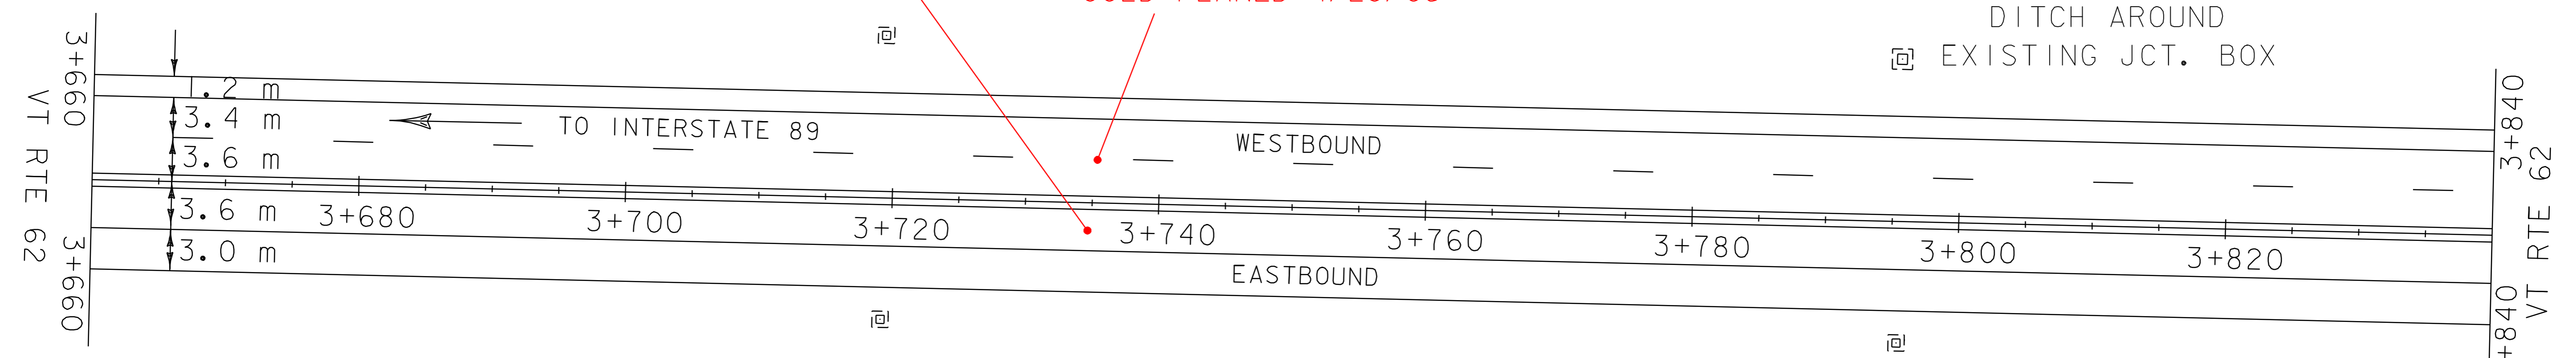

TEMPORARY AND DURABLE 150 mm WHITE LINE
STA. 3+660 LT. - STA. 4+020 LT. (SOLID)
STA. 3+660 LT. - STA. 4+020 LT. (DASHED)
STA. 3+660 RT. - STA. 4+020 RT. (SOLID)

TEMPORARY AND DURABLE 150 mm YELLOW LINE
STA. 3+660 LT. & RT. - STA. 4+020 LT. & RT. (SOLID)

REHABILITATION OF DI'S, CB'S, OR MH'S - CLASS I
STA. 3+994 RT.

GATE FOR WOVEN WIRE FENCE
STA. 3+932 RT. (AT R.O.W. FENCE)


REMOVAL AND DISPOSAL OF GUARDRAIL
STA. 3+947 LT. - STA. 4+020 LT.
STA. 3+994 RT. - STA. 4+020 RT.

MANUFACTURED TERMINAL SECTION (FLARED)
STA. 3+947 LT. - STA. 3+958 LT.
STA. 3+944 RT. - STA. 3+955 RT.

STEEL BEAM GUARDRAIL
STA. 3+958 LT. - STA. 4+020 LT.
STA. 3+955 RT. - STA. 4+020 RT.

TREATED TIMBER CURB
STA. 3+954 RT. - STA. 4+020 RT.

BRIDGE 6 4+013.61
1525 mm ACCGMP

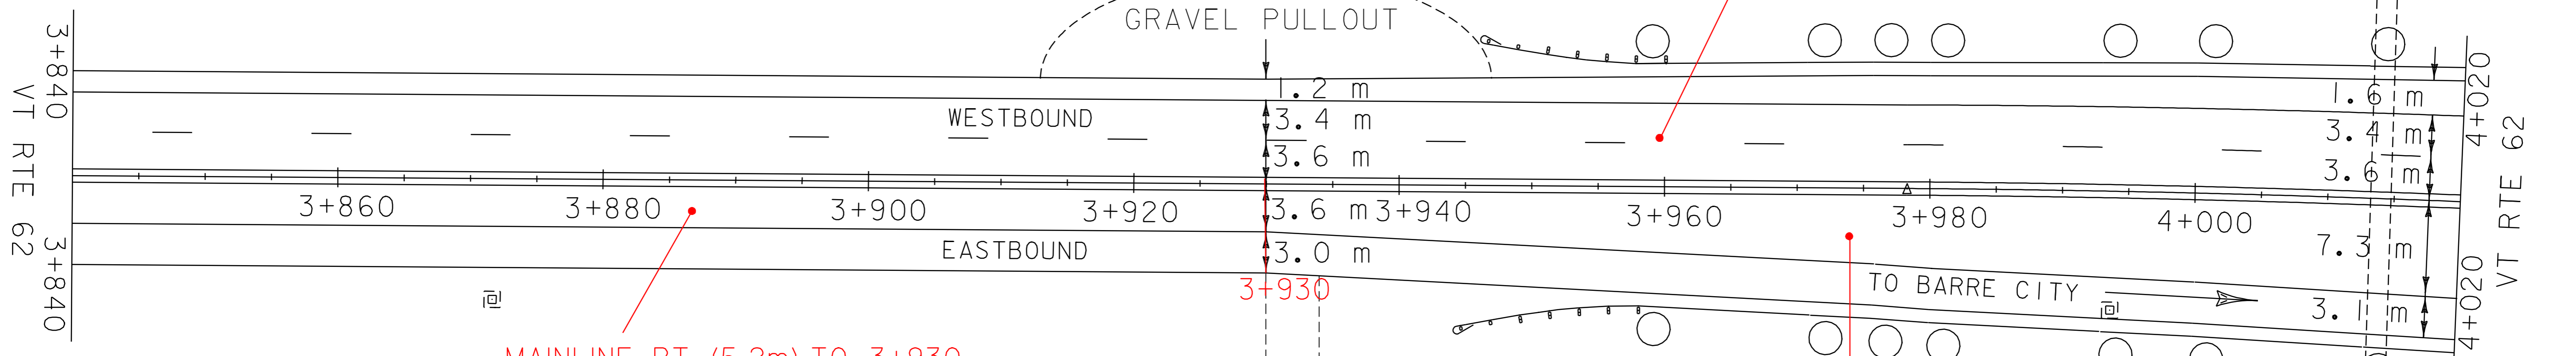

MAINLINE RT (5.2m) TO 3+930
COLD PLANED 4/21/05
+2.6m WIDTH 4/22/05


FIELD DRIVE
TO GATE IN
R.O.W. FENCE

4+020 TO 3+840 LT
COLD PLANED 4/29/05

MAINLINE RT (7m)
COLD PLANED 4/22/05
+3.7 COLD PLANED 4/25/05
TO COMPLETE RT LANE

**PAVING
PROJECT
LAYOUT
#6**


PROJECT NAME: BERLIN-BARRE CITY	FILE NAME: /pave/01b022/pb022.dgn	PLOT DATE: 12-MAR-2007 11:09
PROJECT NUMBER: STP 2321(I)S	PROJECT LEADER: WOOLLAVER	DRAWN BY: LOCKE
	DESIGNED BY: LOCKE	CHECKED BY:
	pb0221a6.1	SHEET 18 OF 39

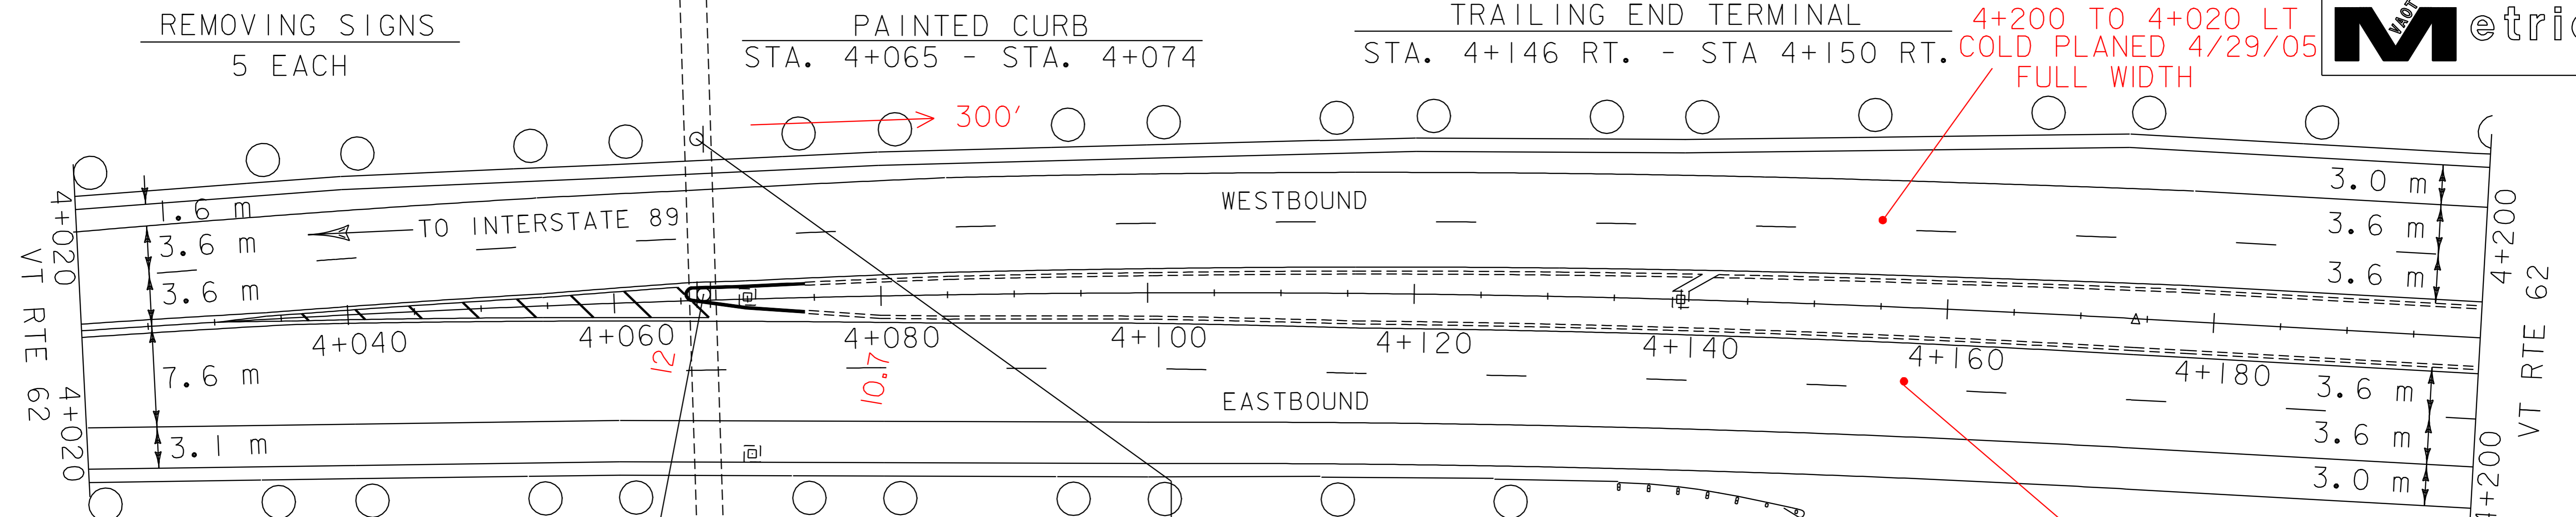

4+200 TO 4+020 LT
COLD PLANED 4/29/05
FULL WIDTH


MAINLINE RT (7.0m)
COLD PLANED 4/22/05

+3.7m COLD PLANED 4/25/05
TO COMPLETE RT LANE

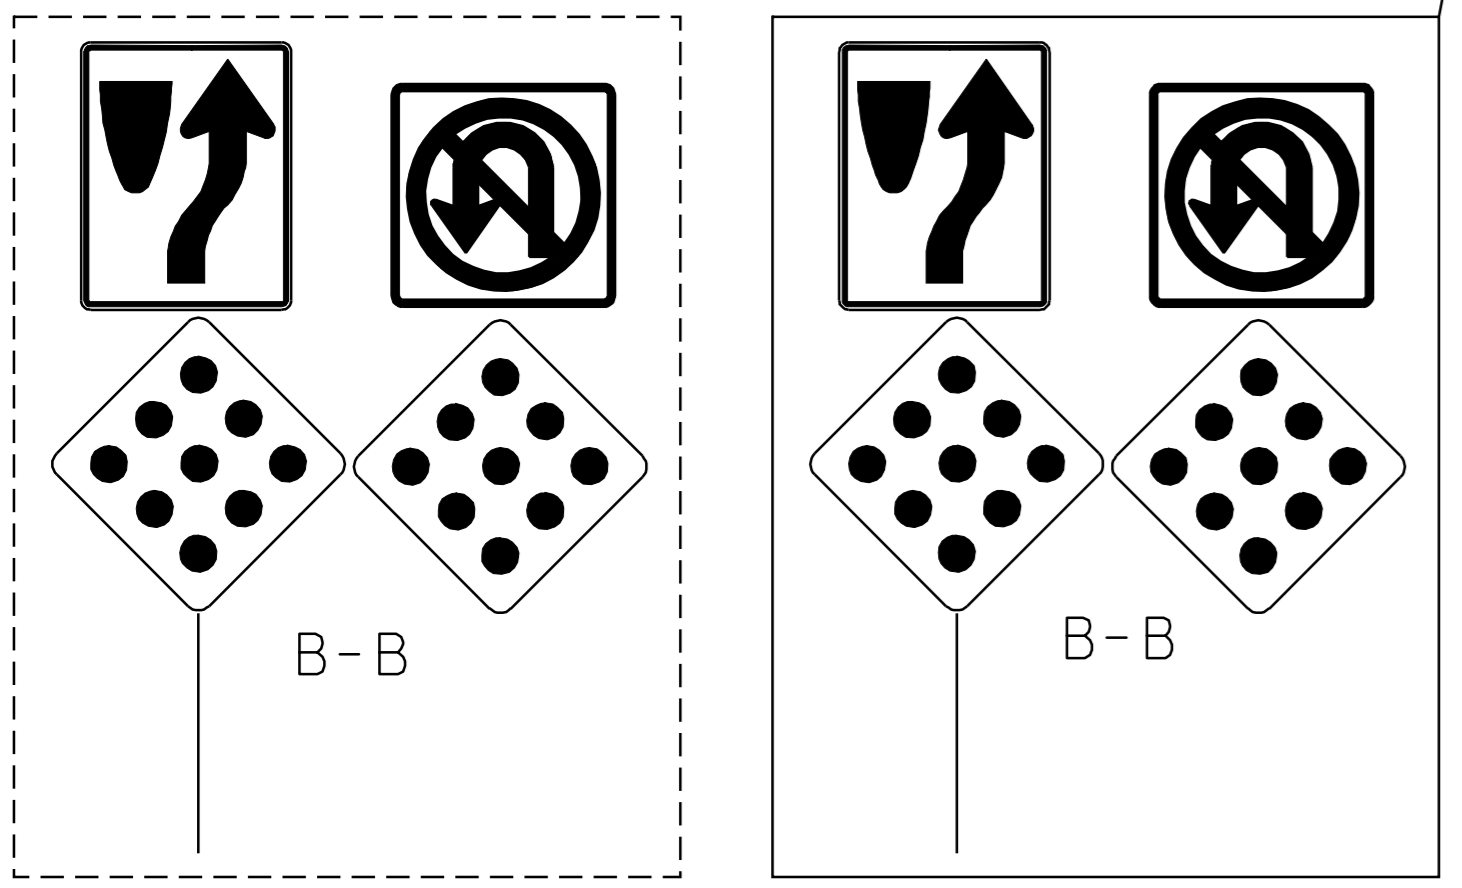

REMOVE
STA. 4+067 LT.

NEW

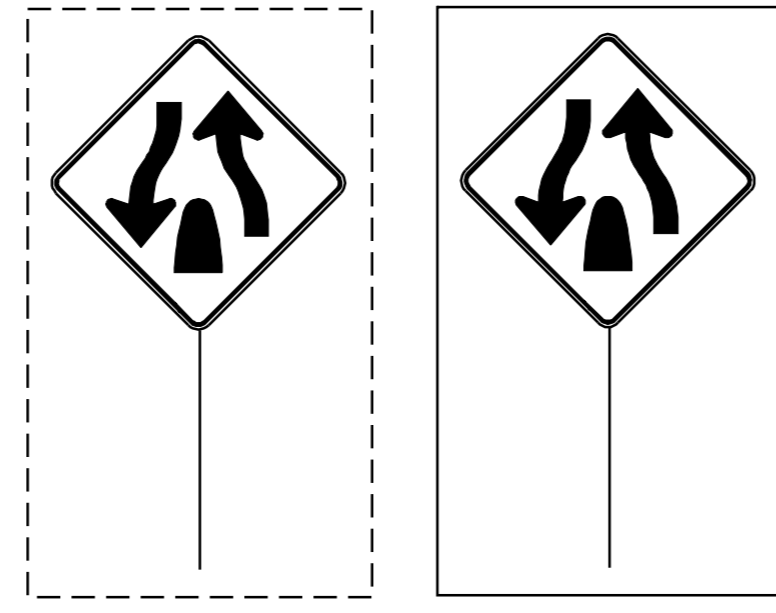

REMOVE
STA. 4+067 LT.

NEW

BRIDGE 7 4+066.64
1980 mm CGMPP

TEMPORARY AND DURABLE 150 mm WHITE LINE
STA. 4+020 LT. - STA. 4+380 LT. (SOLID)
STA. 4+020 LT. - STA. 4+380 LT. (DASHED)
STA. 4+020 RT. - STA. 4+380 RT. (SOLID)
STA. 4+020 RT. - STA. 4+380 RT. (DASHED)


TEMPORARY AND DURABLE 150 mm YELLOW LINE
STA. 4+020 LT. & RT. - STA. 4+380 LT. & RT.
(SOLID)

TEMPORARY AND DURABLE 300 mm YELLOW LINE
STA. 4+037 - STA. 4+065 (DIAGONALS)

REMOVAL AND DISPOSAL OF GUARDRAIL
STA. 4+020 LT. - STA. 4+380 LT.
STA. 4+020 RT. - STA. 4+150 RT.

TREATED TIMBER CURB
STA. 4+020 RT. - STA. 4+140 RT.
STA. 4+361 LT. - STA. 4+380 LT.

STEEL BEAM GUARDRAIL
STA. 4+020 LT. - STA. 4+380 LT.
STA. 4+020 RT. - STA. 4+146 RT.

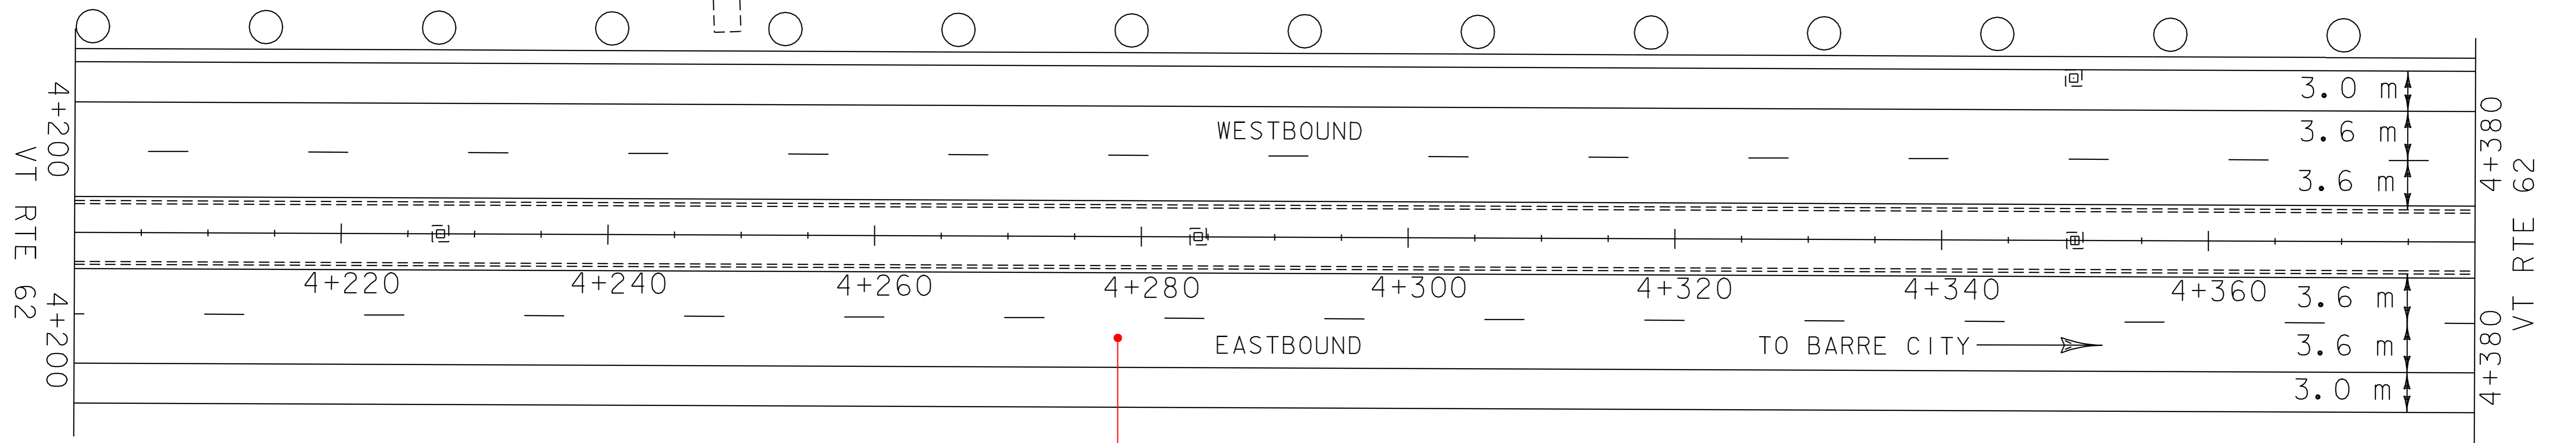

REHABILITATION OF DI'S, CB'S, OR MH'S - CLASS I

- STA. 4+070 MEDIAN
- STA. 4+070 RT.
- STA. 4+140 MEDIAN
- STA. 4+227 MEDIAN
- STA. 4+284 MEDIAN
- STA. 4+350 MEDIAN
- STA. 4+350 LT.

MAINLINE RT (7m)
COLD PLANED 4/22/05

STA. 4+070 MEDIAN
STA. 4+140 MEDIAN


ANCHOR FOR STEEL BEAM GUARDRAIL
STA. 4+148 RT.

+3.7m COLD PLANED 4/25/05
TO COMPLETE RT LANE

BITUMINOUS CONCRETE GUTTERS AND TRAFFIC ISLANDS

**PAVING
PROJECT
LAYOUT
#7**

PROJECT NAME: BERLIN-BARRE CITY	PLOT DATE: 12-MAR-2007 11:09
PROJECT NUMBER: STP 232(I)S	DRAWN BY: LOCKE
FILE NAME: /pave/01b022/pb022.dgn	CHECKED BY:
DESIGNED BY: LOCKE	SHEET 19 OF 39
DESIGNED BY: pb022lg7.i	

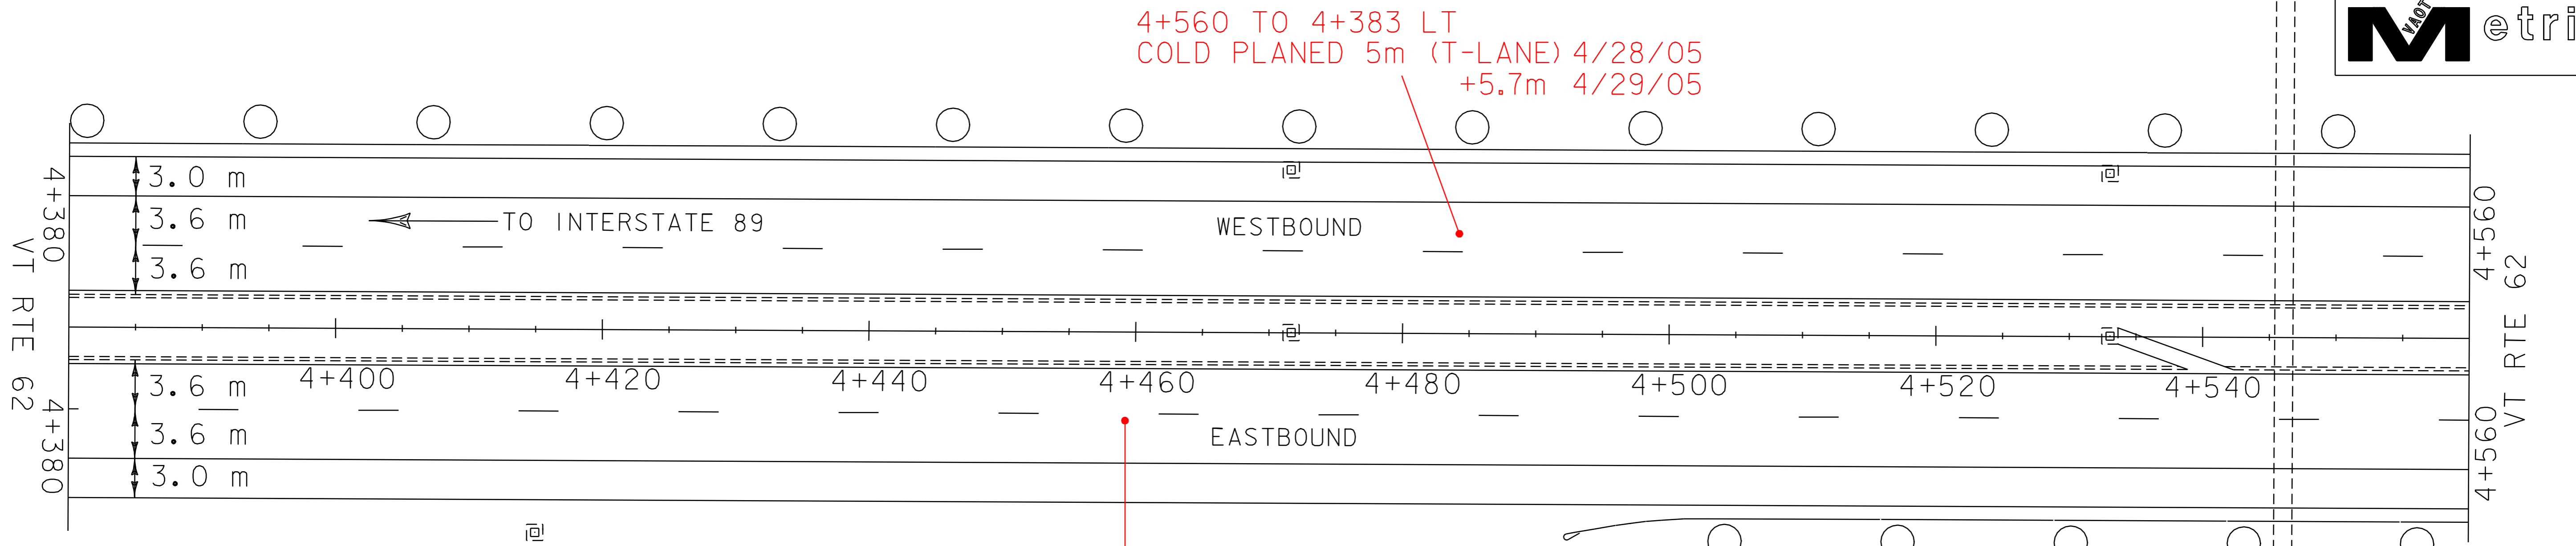

TEMPORARY AND DURABLE 150 mm WHITE LINE
 STA. 4+380 LT. - STA. 0+020 LT. (SOLID)
 STA. 4+380 LT. - STA. 0+020 LT. (DASHED)
 STA. 4+380 RT. - STA. 0+020 RT. (SOLID)
 STA. 4+380 RT. - STA. 0+020 RT. (DASHED)

TEMPORARY AND DURABLE 150 mm YELLOW LINE
 STA. 4+380 LT. - STA. 0+020 LT. (SOLID)
 STA. 4+380 RT. - STA. 0+020 RT. (SOLID)

STONE FILL, TYPE II FOR SLOPE STABILIZATION
 STA. 4+526 RT.
 20 m X 3.5 m GOUGE IN SIDE SLOPE

MAINLINE RT (7.0m)
 COLD PLANED 4/22/05
 +3.7m COLD PLANED 4/25/05
 TO COMPLETE RT LANE

REMOVAL AND DISPOSAL OF GUARDRAIL
 STA. 4+380 LT. - STA. 0+020 LT.
 STA. 4+492 RT. - STA. 4+599 RT.

STEEL BEAM GUARDRAIL
 STA. 4+380 LT. - STA. 0+020 LT.
 STA. 4+503 RT. - STA. 4+595 RT.

MANUFACTURED TERMINAL SECTION (FLARED)
 STA. 4+492 RT. - STA. 4+503 RT.


TRAILING END TERMINAL
 STA. 4+595 RT. - STA. 4+599 RT.

TREATED TIMBER CURB
 STA. 4+380 LT. STA. 0+020 LT.

ANCHOR FOR STEEL BEAM GUARDRAIL
 STA. 4+597 RT.

BARRE - 0+020 TO 4+560 - BERLIN
 COLD PLANED 5m (T-LANE) 4/28/05
 +5.7m 4/29/05

BRIDGE 8 4+546.09
 1375 mm ACCGMP

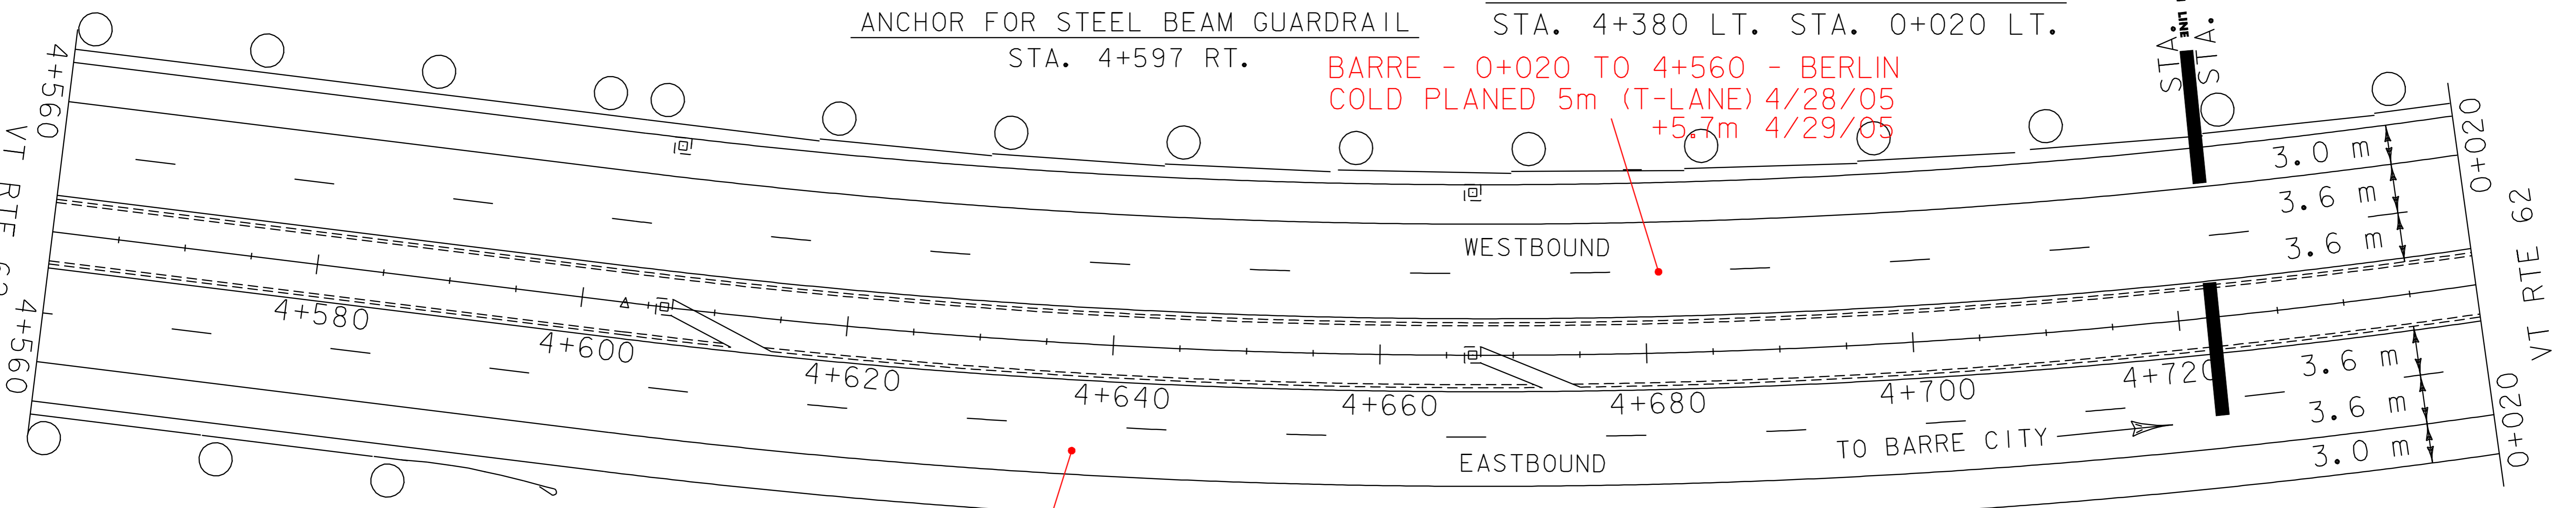

CHANGE ELEVATION OR
 REHABILITATION OF DI'S, CB'S, OR MH'S - CLASS I

STA. 4+472 LT.
 STA. 4+472 MEDIAN
 STA. 4+533 LT.
 STA. 4+533 MEDIAN CE 5/5/05
 STA. 4+606 LT.
 STA. 4+606 MEDIAN CE 5/5/05
 STA. 4+667 LT.
 STA. 4+667 MEDIAN CE 5/5/05


BITUMINOUS CONCRETE GUTTERS AND TRAFFIC ISLANDS
 STA. 4+533 MEDIAN
 STA. 4+606 MEDIAN
 STA. 4+667 MEDIAN

MAINLINE RT (7.0m)
 COLD PLANED 4/22/05
 +3.7m COLD PLANED 4/25/05
 TO COMPLETE RT LANE

BERLIN
 MM 2.934
 BARRE CITY
 MM 0.000

**PAVING
 PROJECT
 LAYOUT
 #8**

PROJECT NAME: BERLIN-BARRE CITY	PLOT DATE: 12-MAR-2007 11:09
PROJECT NUMBER: STP 232(I)S	DRAWN BY: LOCKE
FILE NAME: /pave/01b022/pb022.dgn	CHECKED BY:
PROJECT LEADER: WOOLAVER	SHEET 20 OF 39
DESIGNED BY: LOCKE	
pb022a8.i	

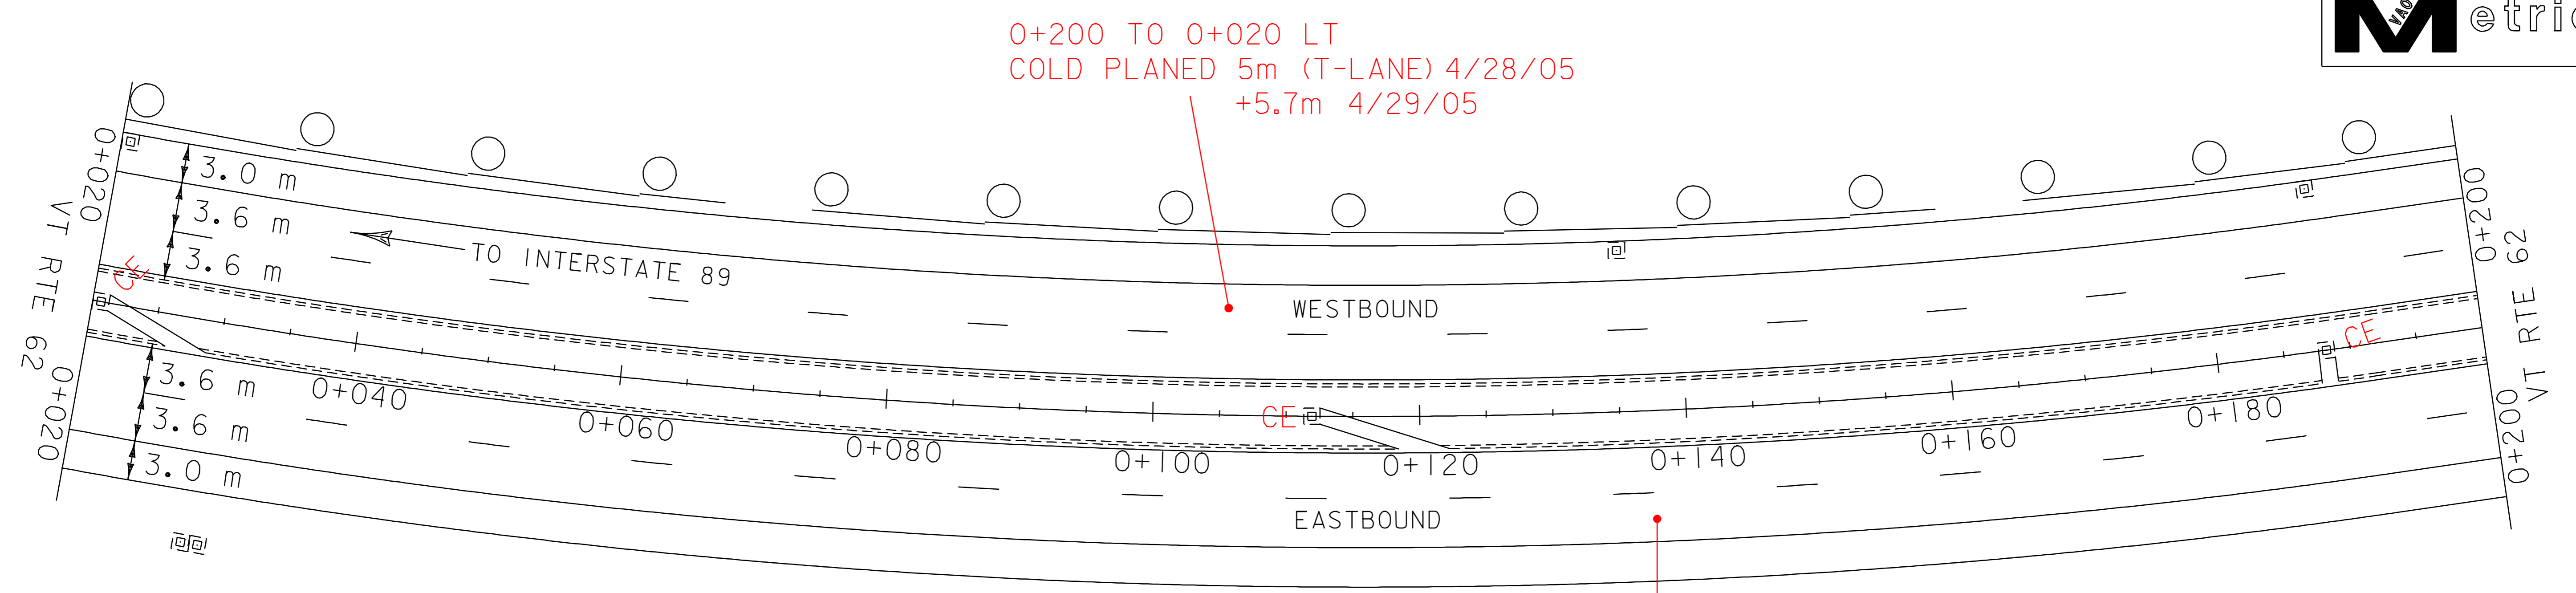

TEMPORARY AND DURABLE 150 mm WHITE LINE
 STA. 0+020 LT. - STA. 0+380 LT. (SOLID)
 STA. 0+020 LT. - STA. 0+380 LT. (DASHED)
 STA. 0+020 RT. - STA. 0+380 RT. (DASHED)
 STA. 0+020 RT. - STA. 0+380 RT. (SOLID)

TEMPORARY AND DURABLE 150 mm YELLOW LINE
 STA. 0+020 LT. - STA. 0+380 LT. (SOLID)
 STA. 0+020 RT. - STA. 0+380 RT. (SOLID)

REMOVAL AND DISPOSAL OF GUARDRAIL
 STA. 0+020 LT. - STA. 0+380 LT.
 STA. 0+217 RT. - STA. 0+292 RT.

ANCHOR FOR STEEL BEAM GUARDRAIL
 STA. 0+290 RT.

STEEL BEAM GUARDRAIL
 STA. 0+020 LT. - STA. 0+380 LT.
 STA. 0+228 RT. - STA. 0+288 RT.

MANUFACTURED TERMINAL SECTION (FLARED)
 STA. 0+217 RT. - STA. 0+228 RT.


TRAILING END TERMINAL
 STA. 0+288 RT. - STA. 0+292 RT.

TREATED TIMBER CURB
 STA. 0+020 LT. - STA. 0+292 LT.

0+351 TO 0+200 LT
COLD PLANNED 5m (T-LANE)
4/28/05 +5.7m 4/29/05

MAINLINE RT (7m)
COLD PLANNED 4/22/05
+3.7m COLD PLANNED 4/25/05 TO COMPLETE RT LANE

0+380 TO 0+351 LT
COLD PLANNED FULL WIDTH 4/28/05

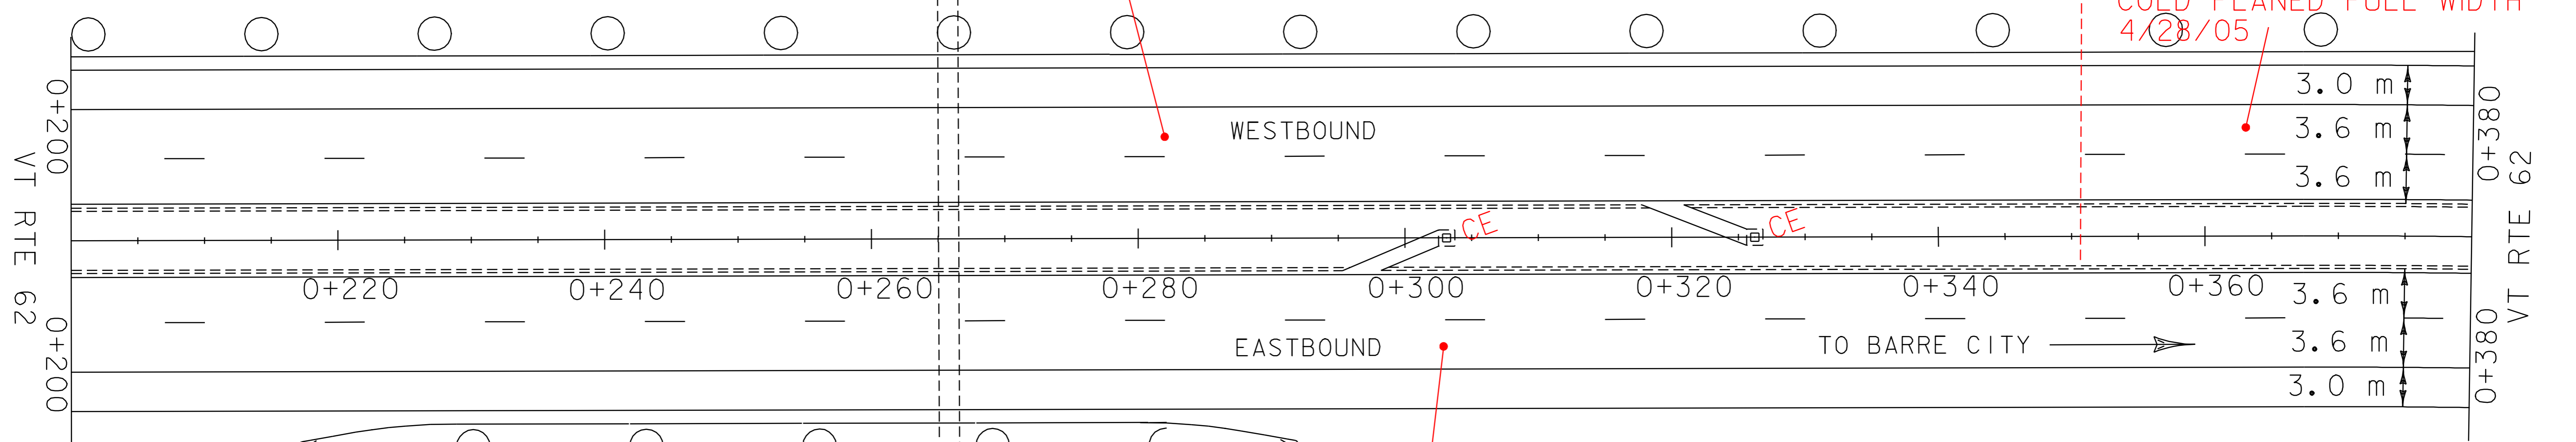

CHANGE ELEVATION OR REHABILITATION OF DI'S, CB'S, OR MH'S - CLASS I

STA. 0+021 LT.
 STA. 0+021 MEDIAN CE 5/5/05
 STA. 0+112 MEDIAN CE 5/5/05
 STA. 0+135 LT.
 STA. 0+188 LT.
 STA. 0+188 MEDIAN CE 5/5/05
 STA. 0+303 MEDIAN CE 5/5/05
 STA. 0+326 MEDIAN CE 5/5/05

0+030 RT (DITCH)
 0+120 RT (DITCH)

BRIDGE 9 0+265.79
 1525 mm ACCGMP


BITUMINOUS CONCRETE GUTTERS AND TRAFFIC ISLANDS

STA. 0+021 MEDIAN
 STA. 0+112 MEDIAN
 STA. 0+188 MEDIAN
 STA. 0+303 MEDIAN
 STA. 0+326 MEDIAN

MAINLINE RT (7m)
COLD PLANNED 4/22/05
+3.7m COLD PLANNED 4/25/05 TO COMPLETE RT LANE

PAVING PROJECT LAYOUT #9

PROJECT NAME: BERLIN-BARRE CITY	PLOT DATE: 12-MAR-2007 11:09
PROJECT NUMBER: STP 2321(I)S	DRAWN BY: LOCKE
FILE NAME: /pave/01b022/pb022.dgn	CHECKED BY:
PROJECT LEADER: WOOLLAVER	SHEET 21 OF 39
DESIGNED BY: LOCKE	
pb022a9.i	

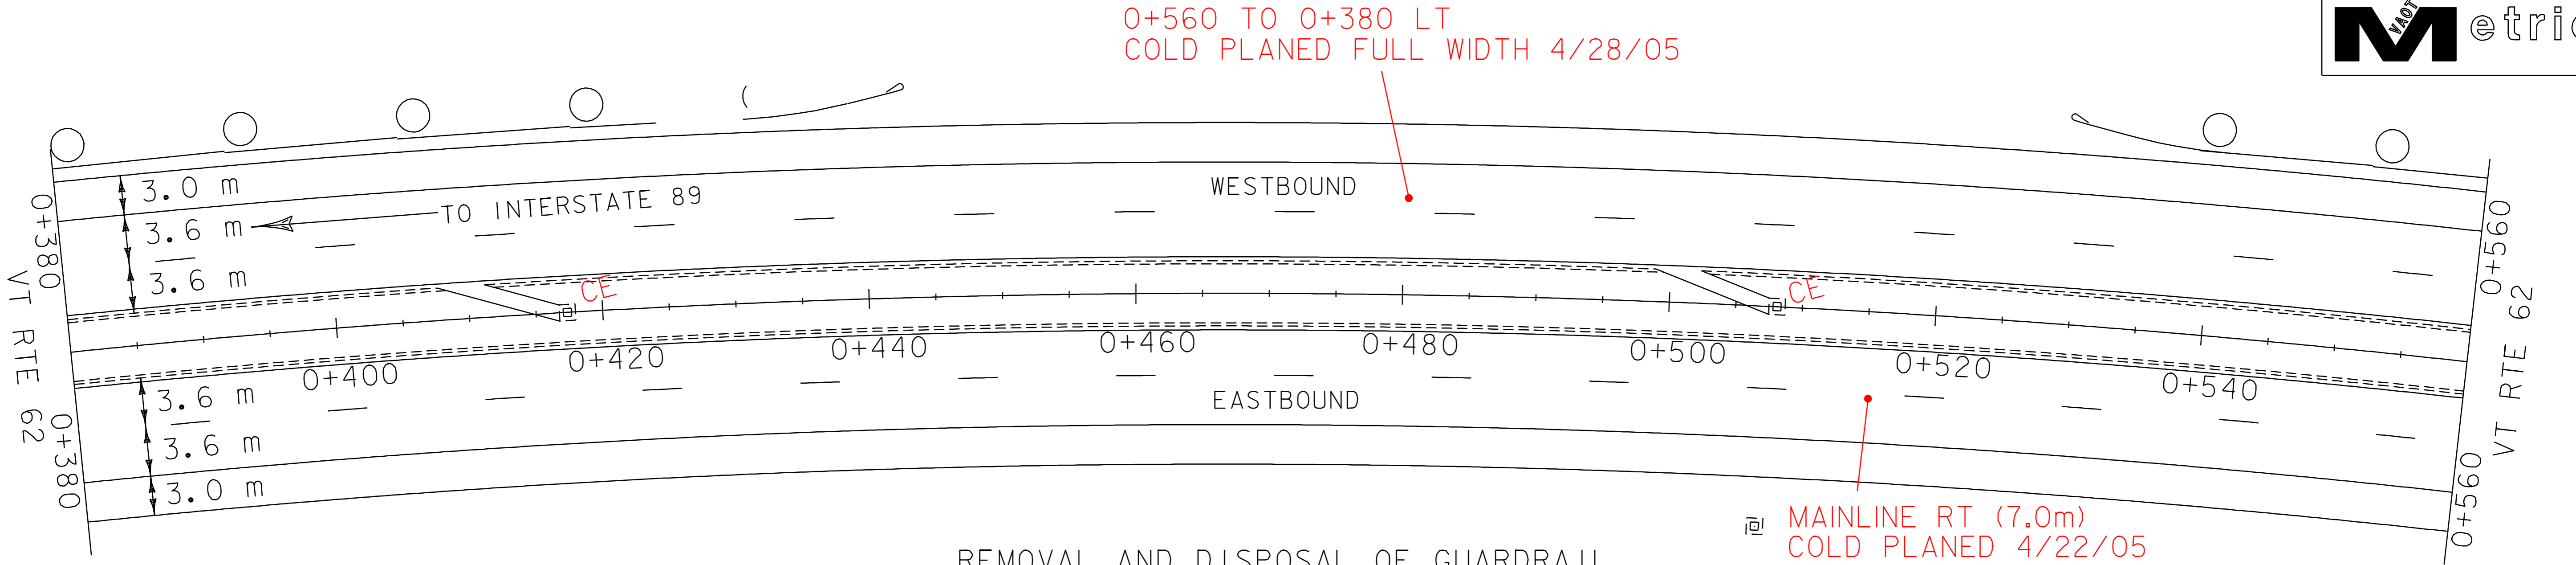

0+560 TO 0+380 LT
COLD PLANED FULL WIDTH 4/28/05

MAINLINE RT (7.0m)
COLD PLANED 4/22/05
+3.7m COLD PLANED 4/25/05
TO COMPLETE RT LANE

TEMPORARY AND DURABLE 150 mm WHITE LINE
 STA. 0+380 LT. - STA. 0+740 LT. (SOLID)
 STA. 0+380 LT. - STA. 0+740 LT. (DASHED)
 STA. 0+380 RT. - STA. 0+740 RT. (DASHED)
 STA. 0+380 RT. - STA. 0+740 RT. (SOLID)

TEMPORARY AND DURABLE 150 mm YELLOW LINE
 STA. 0+380 LT. - STA. 0+740 LT. (SOLID)
 STA. 0+380 RT. - STA. 0+740 RT. (SOLID)

REMOVAL AND DISPOSAL OF GUARDRAIL
 STA. 0+380 LT. - STA. 0+443 LT.
 STA. 0+534 LT. - STA. 0+740 LT.


STEEL BEAM GUARDRAIL
 STA. 0+380 LT. - STA. 0+432 LT.
 STA. 0+538 LT. - STA. 0+740 LT.

MANUFACTURED TERMINAL SECTION (FLARED)
 STA. 0+432 LT. - STA. 0+443 LT.

TRAILING END TERMINAL
 STA. 0+534 LT. - STA. 0+538 LT.

ANCHOR FOR STEEL BEAM GUARDRAIL
 STA. 0+536 LT.

REHABILITATION OF DI'S, CB'S, OR MH'S-CLASS 1
 STA. 0+417 MEDIAN
 STA. 0+508 MEDIAN
 STA. 0+569 MEDIAN
 STA. 0+631 MEDIAN
 STA. 0+705 MEDIAN

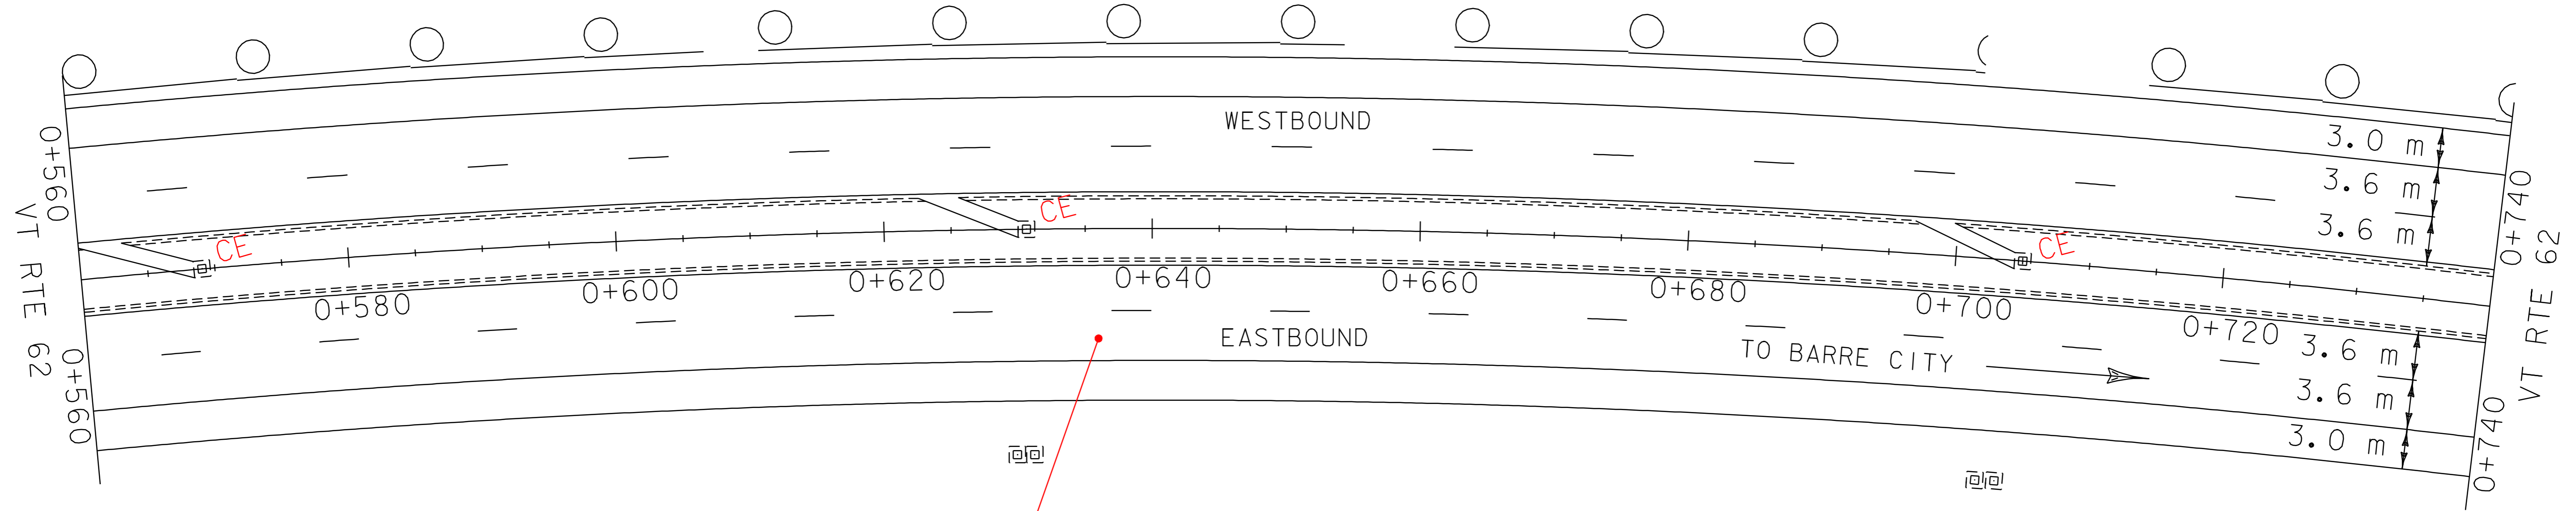


BITUMINOUS CONCRETE GUTTERS AND TRAFFIC ISLANDS
 STA. 0+417 MEDIAN CE 5/6/05
 STA. 0+508 MEDIAN CE 5/6/05
 STA. 0+569 MEDIAN CE 5/6/05
 STA. 0+631 MEDIAN CE 5/6/05
 STA. 0+705 MEDIAN CE 5/6/05

STONE FILL, TYPE II FOR SLOPE STABILIZATION
 STA. 0+666 RT.

MAINLINE RT (7.0m)
COLD PLANED 4/22/05
+3.7m COLD PLANED 4/25/05
TO COMPLETE RT LANE

**PAVING
PROJECT
LAYOUT
#10**

PROJECT NAME: BERLIN-BARRE CITY	PLOT DATE: 12-MAR-2007 11:09
PROJECT NUMBER: STP 2321(I)S	DRAWN BY: LOCKE
FILE NAME: /pave/01b022/pb022.dgn	CHECKED BY:
PROJECT LEADER: WOOLLAVER	SHEET 22 OF 39
DESIGNED BY: LOCKE	
pb022al0.i	

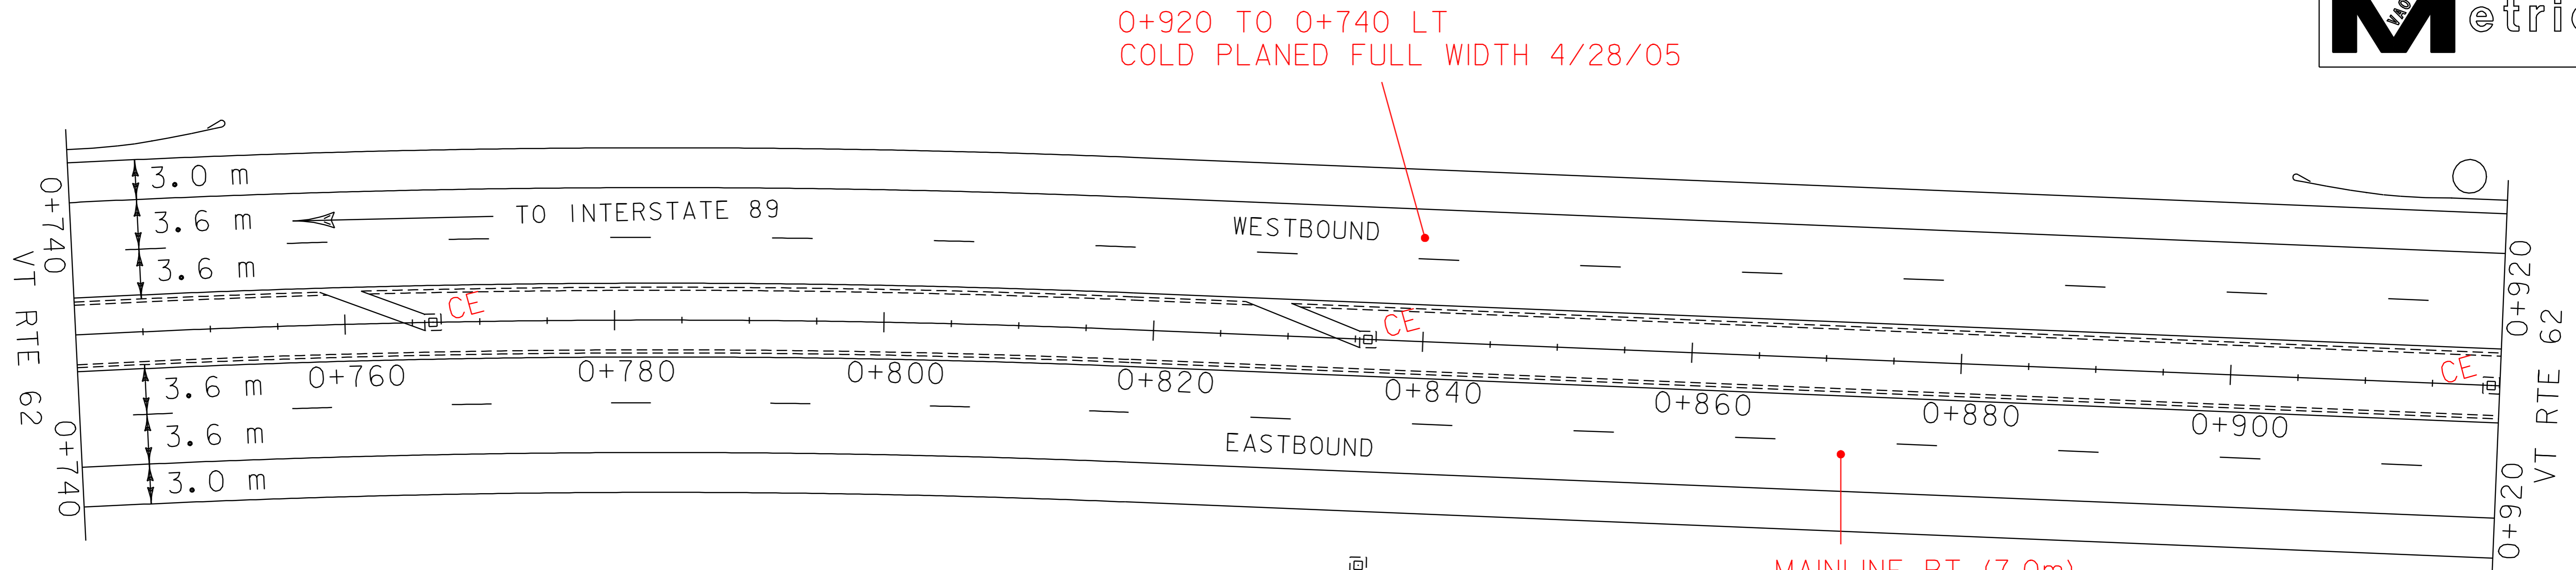

TEMPORARY AND DURABLE 150 mm WHITE LINE
 STA. 0+740 LT. - STA. 1+100 LT. (SOLID)
 STA. 0+740 LT. - STA. 1+100 LT. (DASHED)
 STA. 0+740 RT. - STA. 1+100 RT. (DASHED)
 STA. 0+740 RT. - STA. 1+100 RT. (SOLID)

TEMPORARY AND DURABLE 150 mm YELLOW LINE
 STA. 0+740 LT. - STA. 1+100 LT. (SOLID)
 STA. 0+740 RT. - STA. 1+100 RT. (SOLID)

ANCHOR FOR STEEL BEAM GUARDRAIL
 STA. 0+906 LT.

REMOVAL AND DISPOSAL OF GUARDRAIL
 STA. 0+740 LT. - STA. 0+749 LT.
 STA. 0+904 LT. - STA. 1+100 LT.


MANUFACTURED TERMINAL SECTION (FLARED)
 STA. 0+740 LT. - STA. 0+751 LT.

TRAILING END TERMINAL
 STA. 0+904 LT. STA. 0+908 LT.

STEEL BEAM GUARDRAIL
 STA. 0+908 LT. - STA. 1+100 LT.

REHABILITATION OF DI'S, CB'S, OR MH'S-CLASS I

STA. 0+766 MEDIAN
 STA. 0+836 MEDIAN
 STA. 0+919 MEDIAN
 STA. 0+994 MEDIAN
 STA. 1+047 MEDIAN

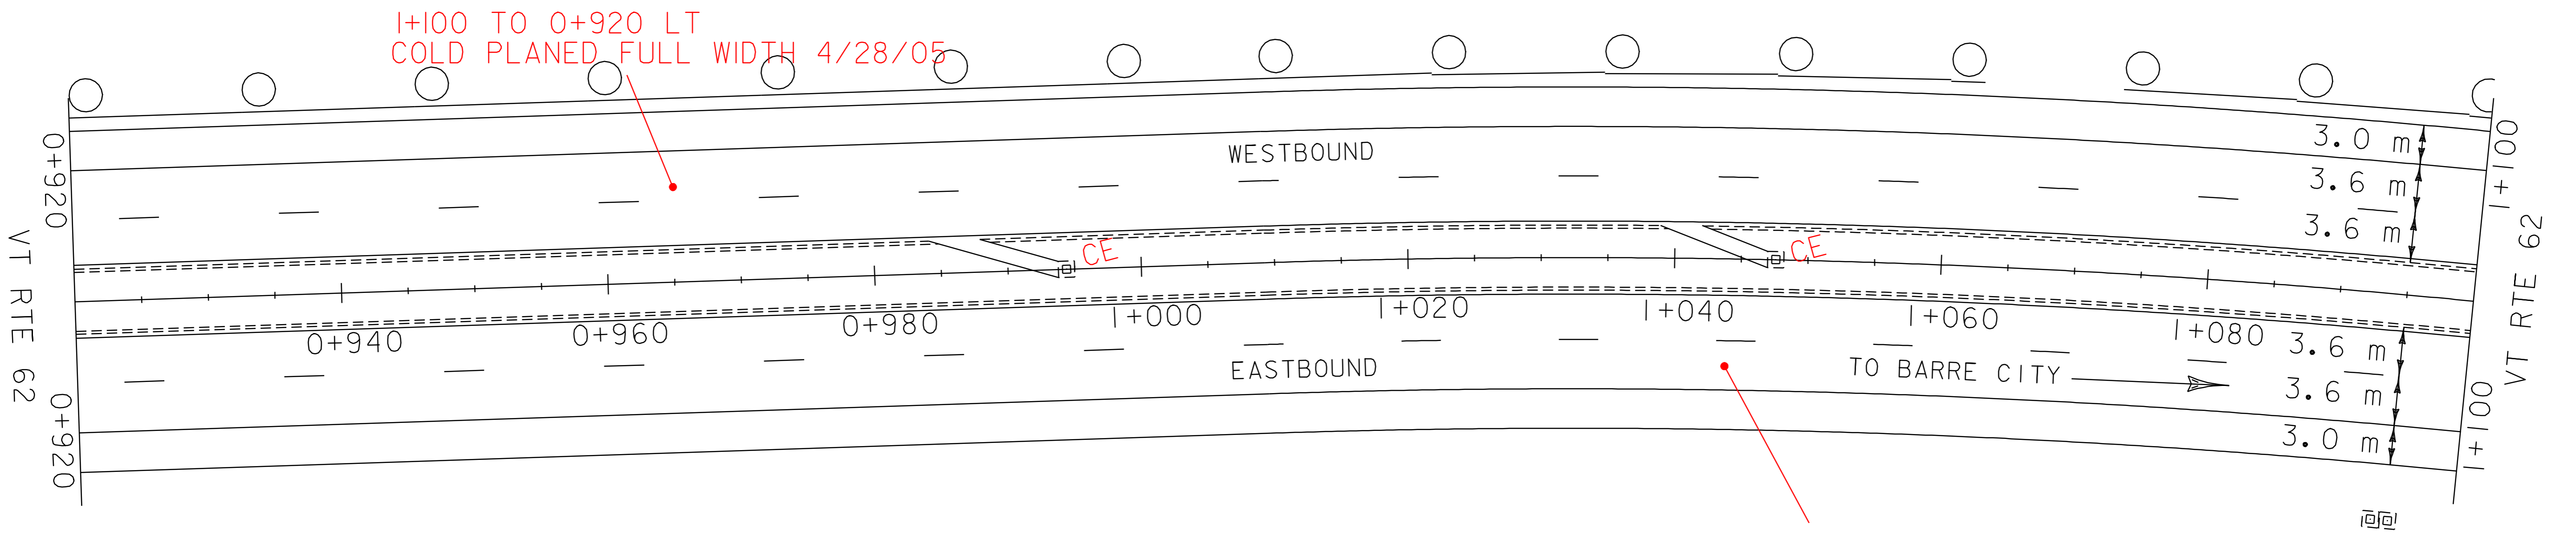


BITUMINOUS CONCRETE GUTTERS AND TRAFFIC ISLANDS

STA. 0+766 MEDIAN
 STA. 0+836 MEDIAN
 STA. 0+994 MEDIAN
 STA. 1+047 MEDIAN

MAINLINE RT (7.0m)
 COLD PLANED 4/22/05
 +3.7m COLD PLANED 4/25/05
 TO COMPLETE RT LANE

PAVING PROJECT LAYOUT #11	PROJECT NAME: BERLIN-BARRE CITY	PLOT DATE: 12-MAR-2007 11:09
	PROJECT NUMBER: STP 2321(1)S	DRAWN BY: LOCKE
	FILE NAME: /pave/01b022/pb022.dgn	CHECKED BY:
	DESIGNED BY: LOCKE	SHEET 23 OF 39

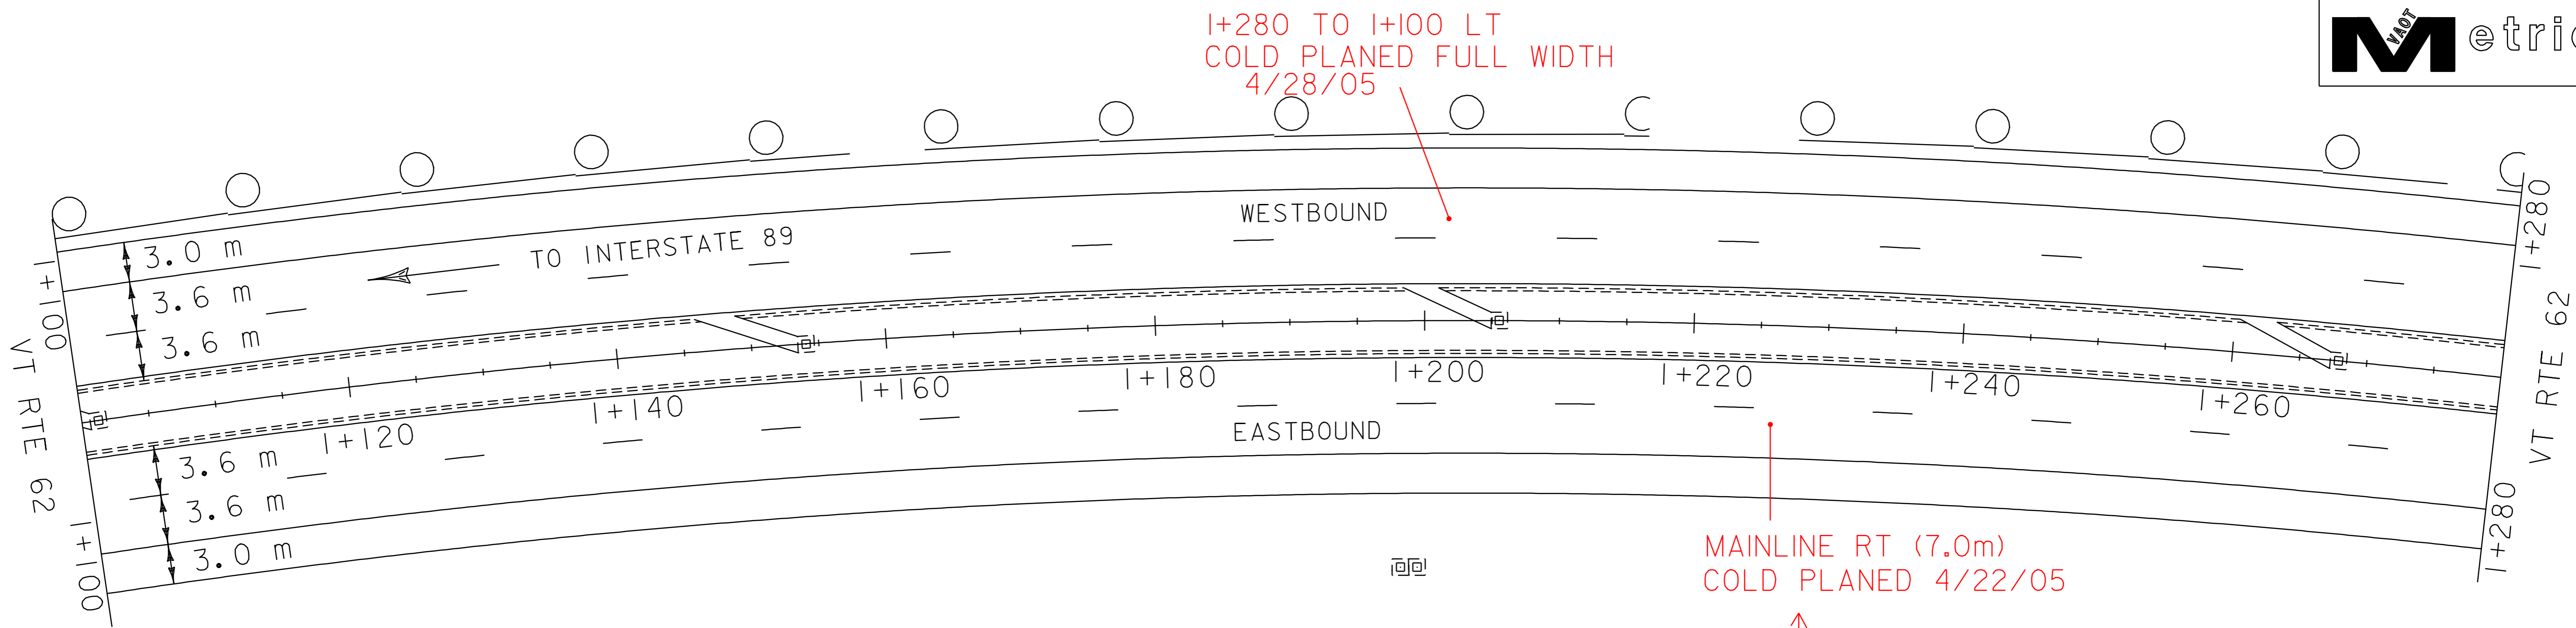

I+280 TO I+100 LT
COLD PLANED FULL WIDTH
4/28/05

MAINLINE RT (7.0m)
COLD PLANED 4/22/05

TEMPORARY AND DURABLE 150 mm WHITE LINE
 STA. 1+100 LT. - STA. 1+460 LT. (SOLID)
 STA. 1+100 LT. - STA. 1+460 LT. (DASHED)
 STA. 1+100 RT. - STA. 1+460 RT. (DASHED)
 STA. 1+100 RT. - STA. 1+460 RT. (SOLID)
 TEMPORARY AND DURABLE 150 mm YELLOW LINE
 STA. 1+100 LT. - STA. 1+460 LT. (SOLID)
 STA. 1+100 RT. - STA. 1+460 RT. (SOLID)

REMOVAL AND DISPOSAL OF GUARDRAIL
 STA. 1+100 LT. - STA. 1+330 LT.


STEEL BEAM GUARDRAIL
 STA. 1+100 LT. - STA. 1+319 LT.

MANUFACTURED TERMINAL SECTION (FLARED)
 STA. 1+319 LT. - STA. 1+330 LT.

BITUMINOUS CONCRETE GUTTERS AND TRAFFIC ISLANDS
 STA. 1+101 MEDIAN
 STA. 1+154 MEDIAN
 STA. 1+206 MEDIAN
 STA. 1+268 MEDIAN

REHABILITATION OF DI'S, CB'S, OR MH'S-CLASS I
 STA. 1+101 MEDIAN
 STA. 1+154 MEDIAN
 STA. 1+206 MEDIAN
 STA. 1+268 MEDIAN
 STA. 1+338 MEDIAN
 STA. 1+390 MEDIAN
 STA. 1+451 MEDIAN

+3.7m COLD PLANED 4/25/05
 TO COMPLETE RT LANE
 I+460 TO I+424 LT
 COLD PLANED FULL WIDTH
 4/27/05

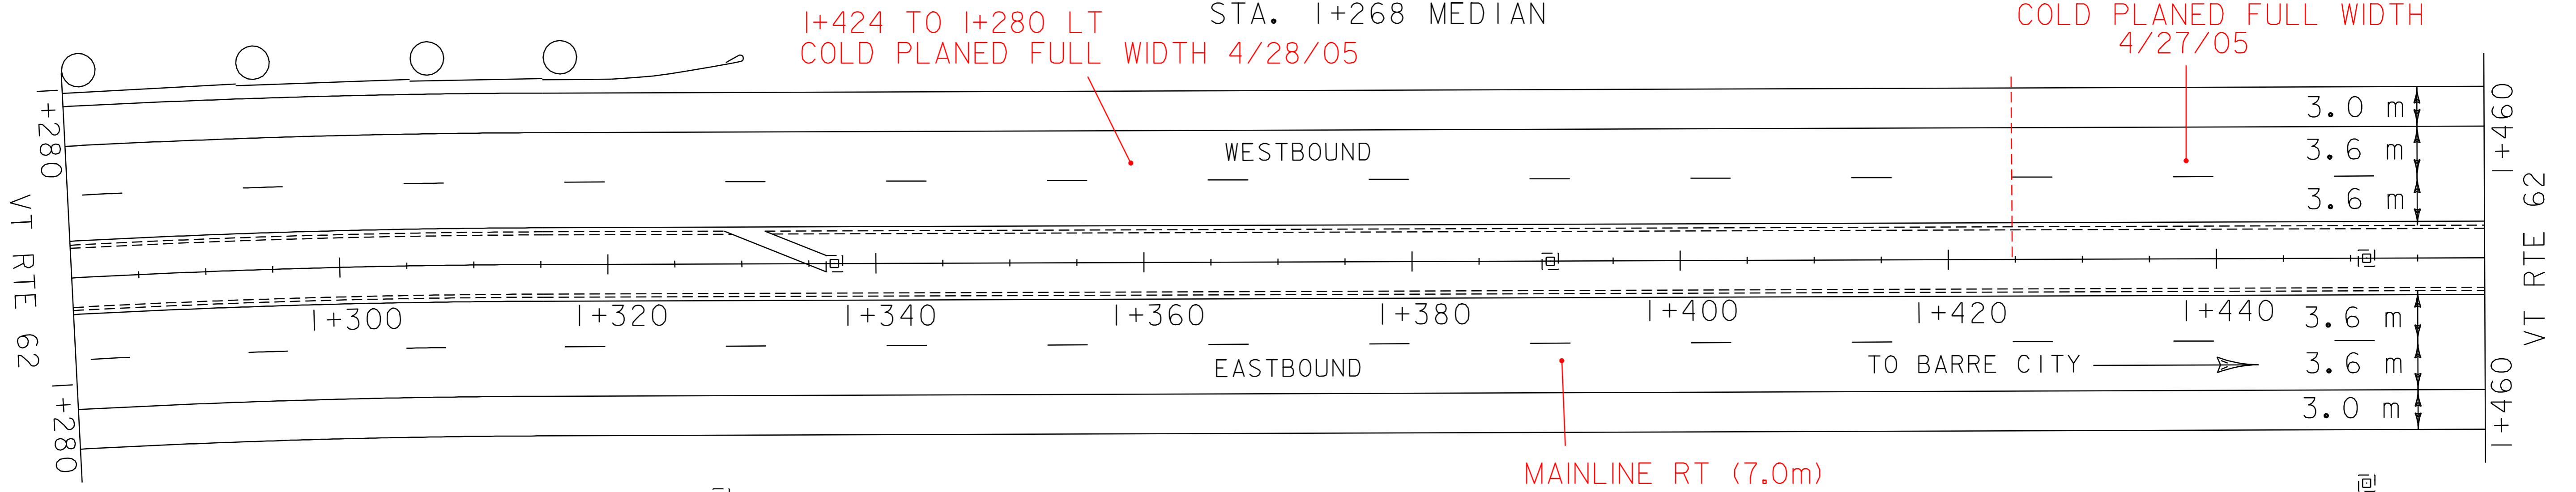

I+424 TO I+280 LT
COLD PLANED FULL WIDTH 4/28/05

MAINLINE RT (7.0m)
COLD PLANED 4/22/05
+3.7m COLD PLANED 4/25/05 TO COMPLETE RT LANE


PAVING PROJECT LAYOUT #12	PROJECT NAME: BERLIN-BARRE CITY	PLOT DATE: 12-MAR-2007 11:09
	PROJECT NUMBER: STP 232(I)S	DRAWN BY: LOCKE
	FILE NAME: /pave/01b022/pb022.dgn	CHECKED BY:
	PROJECT LEADER: WOOLAVER	SHEET 24 OF 39
DESIGNED BY: LOCKE		
pb022al2.1		

REMOVAL AND DISPOSAL OF GUARDRAIL
 STA. 1+501 LT. - STA. 1+640 LT.
 ANCHOR FOR STEEL BEAM GUARDRAIL
 STA. 1+503 LT.

MANUFACTURED TERMINAL SECTION (FLARED)
 STA. 1+629 LT. - STA. 1+640 LT.

TRAILING END TERMINAL
 STA. 1+501 LT. - STA. 1+505 LT.




STEEL BEAM GUARDRAIL
 STA. 1+505 LT. - STA. 1+629 LT.

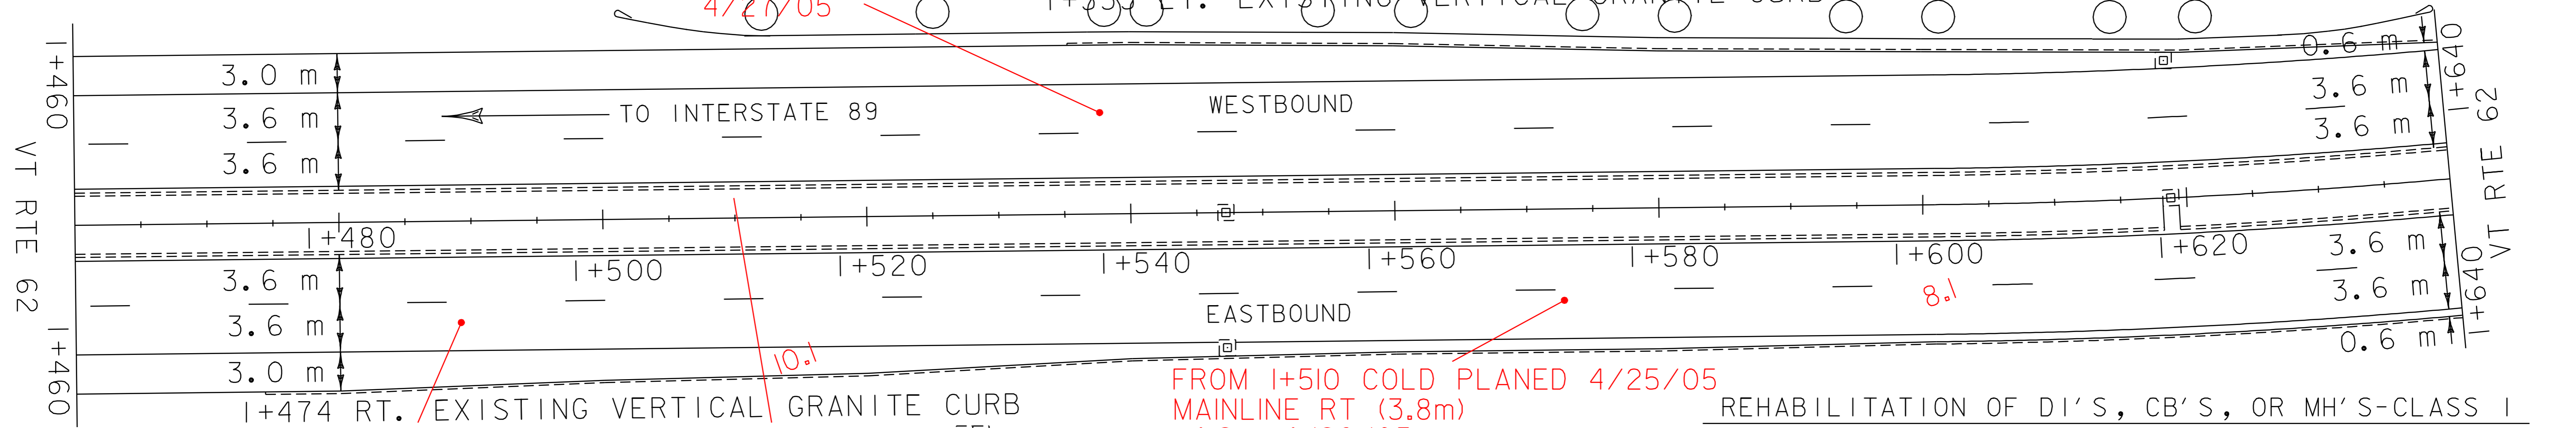




- TEMPORARY AND DURABLE 150 mm WHITE LINE
 STA. 1+460 LT. - STA. 1+820 LT. (SOLID)
 STA. 1+460 LT. - STA. 1+820 LT. (DASHED)
 STA. 1+460 RT. - STA. 1+820 RT. (DASHED)
 STA. 1+460 RT. - STA. 1+820 RT. (SOLID)
 STA. 1+765 RT. - STA. 1+820 RT. (DOTTED)
- TEMPORARY AND DURABLE 150 mm YELLOW LINE
 STA. 1+460 LT. - STA. 1+820 LT. (SOLID)
 STA. 1+460 RT. - STA. 1+780 RT. (SOLID)
 STA. 1+780 LT. - STA. 1+820 LT. (SOLID)

- TEMPORARY AND DURABLE LETTERS OR SYMBOLS
 STA. 1+711 RT. (SIGNAL - 2 EACH)
 STA. 1+723 RT. (AHEAD - 2 EACH)
- BITUMINOUS CONCRETE GUTTERS AND TRAFFIC ISLANDS
 STA. 1+619 MEDIAN
 STA. 1+695 MEDIAN
 STA. 1+756 MEDIAN (1 NEW, 1 EXISTING)
- REMOVAL OF EXISTING CURB
 STA. 1+756 MED. (FOR CONSTRUCTION OF NEW GUTTER)

NOTE: REMOVE SAND BUILD UP ON MEDIAN ISLAND
 STA. 1+780 - STA. 1+820. TO BE PAID FOR
 WITH APPLICABLE RENTAL ITEMS.

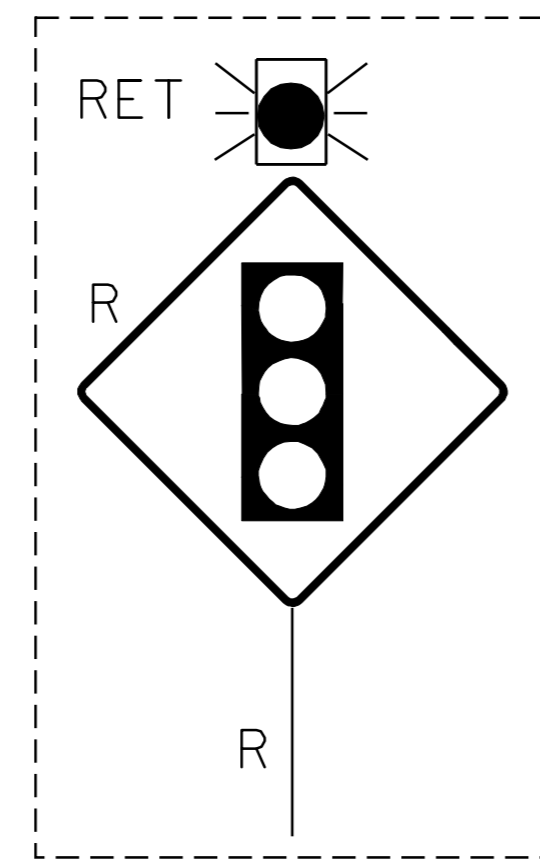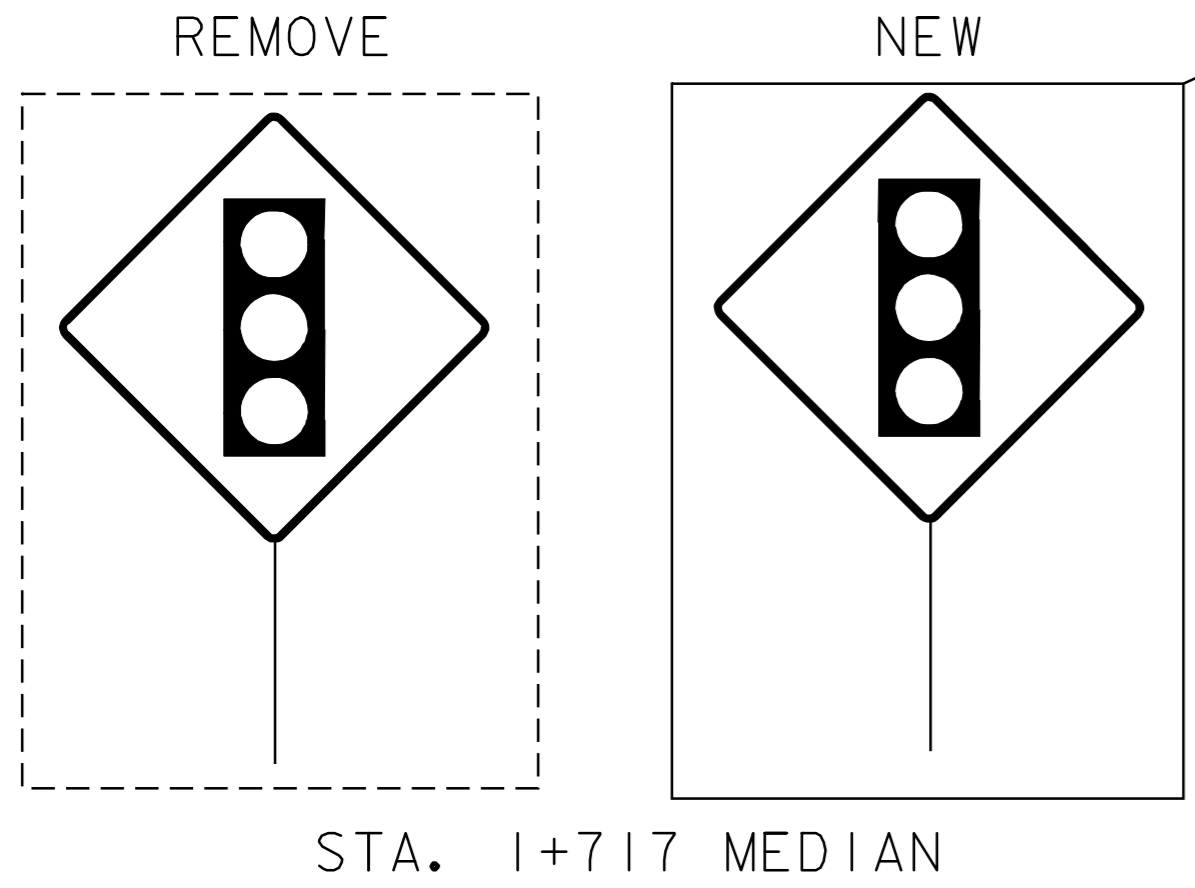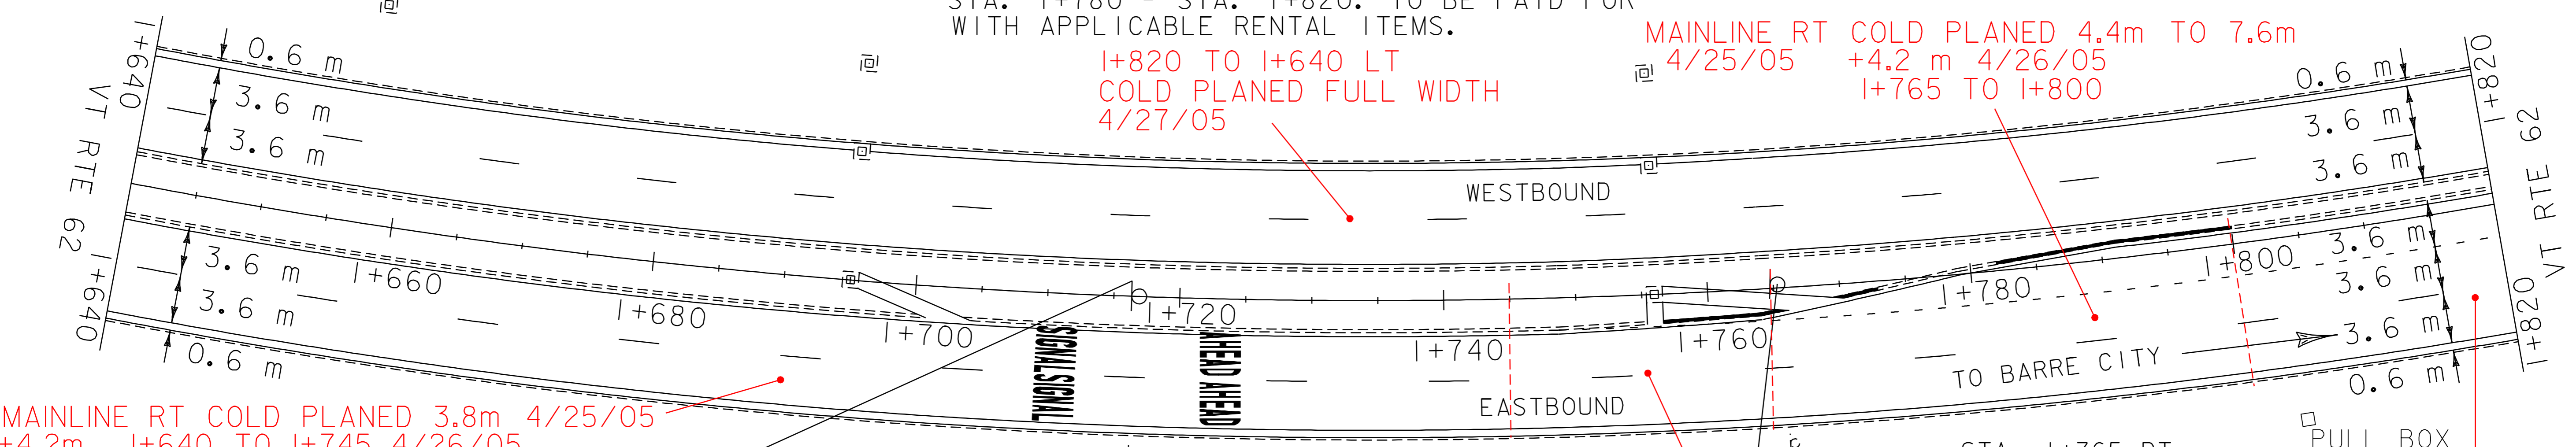

STA. 1+717 RT.
 REMOVE EXISTING
 SIGN AND POST.
 REPLACE W/NEW
 SIGN AND POST.
 RETAIN EXISTING
 FLASHING BEACON.

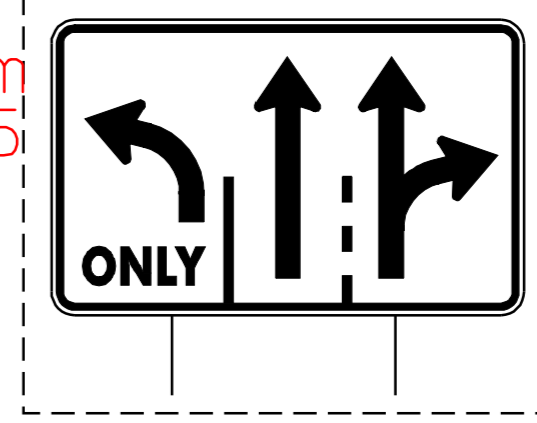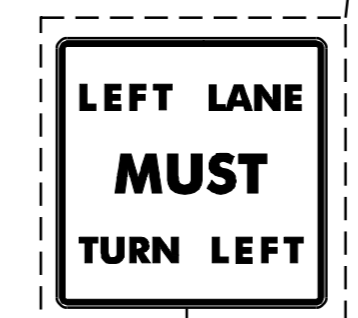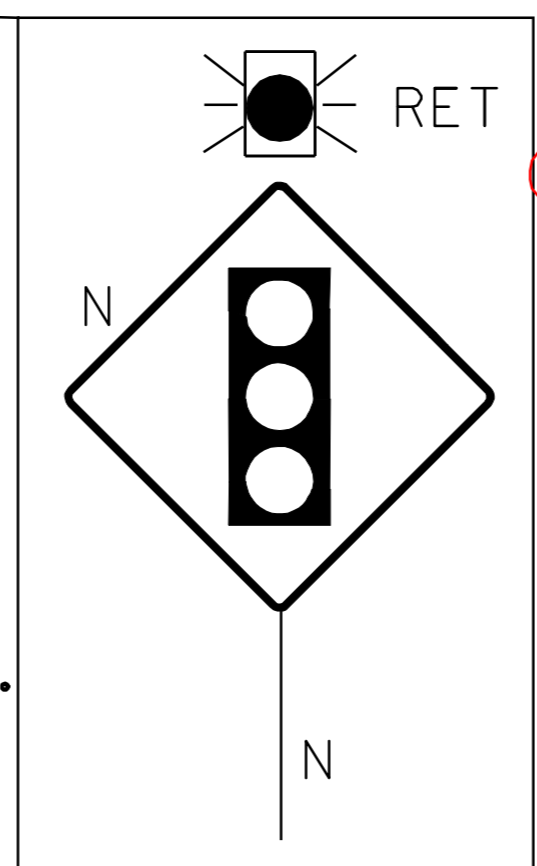

PAVING
 PROJECT
 LAYOUT
 #13

PROJECT NAME: BERLIN-BARRE CITY	PLOT DATE: 12-MAR-2007 11:09
PROJECT NUMBER: STP 232(I)S	DRAWN BY: LOCKE
FILE NAME: /pave/01b022/pb022.dgn	CHECKED BY:
PROJECT LEADER: WOOLAVER	SHEET 25 OF 39
DESIGNED BY: LOCKE	
pb0221a13.1	

TEMPORARY AND DURABLE 150 mm WHITE LINE
 STA. 1+820 LT. - STA. 1+919 LT. (SOLID)
 STA. 1+931 LT. - STA. 2+000 LT. (SOLID)
 STA. 1+820 LT. - STA. 1+905 LT. (DASHED)
 STA. 1+945 LT. - STA. 2+000 LT. (DASHED)
 STA. 1+820 RT. - STA. 1+822 RT. (DOTTED)
 STA. 1+822 RT. - STA. 1+905 RT. (SOLID)
 STA. 1+945 LT. - STA. 2+000 LT. (SOLID)
 STA. 1+820 RT. - STA. 1+905 RT. (DASHED)
 STA. 1+945 RT. - STA. 2+000 RT. (DASHED)
 STA. 1+820 RT. - STA. 1+919 RT. (SOLID)
 STA. 1+932 RT. - STA. 2+000 RT. (SOLID)



TEMPORARY AND DURABLE 600 mm STOP BAR
 STA. 1+905 LT. - RT.
 STA. 1+920 LT. (BERLIN STREET)
 STA. 1+930 RT. (BERLIN STREET)
 STA. 1+945 RT. - LT.

REMOVAL AND DISPOSAL OF GUARDRAIL
 STA. 1+933 LT. - STA. 2+000 LT.
TRAILING END TERMINAL
 STA. 1+933 LT. - STA. 1+935 LT.
ANCHOR FOR STEEL BEAM GUARDRAIL
 STA. 1+934 LT.
STEEL BEAM GUARDRAIL
 STA. 1+935 LT. - STA. 2+000 LT.


TEMPORARY AND DURABLE 150 mm YELLOW LINE
 STA. 1+820 LT. - STA. 1+907 LT. (SOLID - AROUND MEDIAN ISLAND)
 STA. 1+944 RT. - STA. 2+000 RT. (SOLID - AROUND MEDIAN ISLAND)
 STA. 1+925 LT (AROUND ISLAND-BERLIN STREET)
 STA. 1+926 RT (AROUND ISLAND-BERLIN STREET)

NOTE:
 REMOVE SAND BUILD UP ON MEDIAN ISLAND STA. 1+820 LT. - STA. 1+906 LT. TO BE PAID FOR WITH APPLICABLE RENTAL ITEMS.

PAINTED CURB
 STA. 1+897 LT. - STA. 1+906 LT. BERLIN STREET
 STA. 1+945 LT. - STA. 1+954 LT.

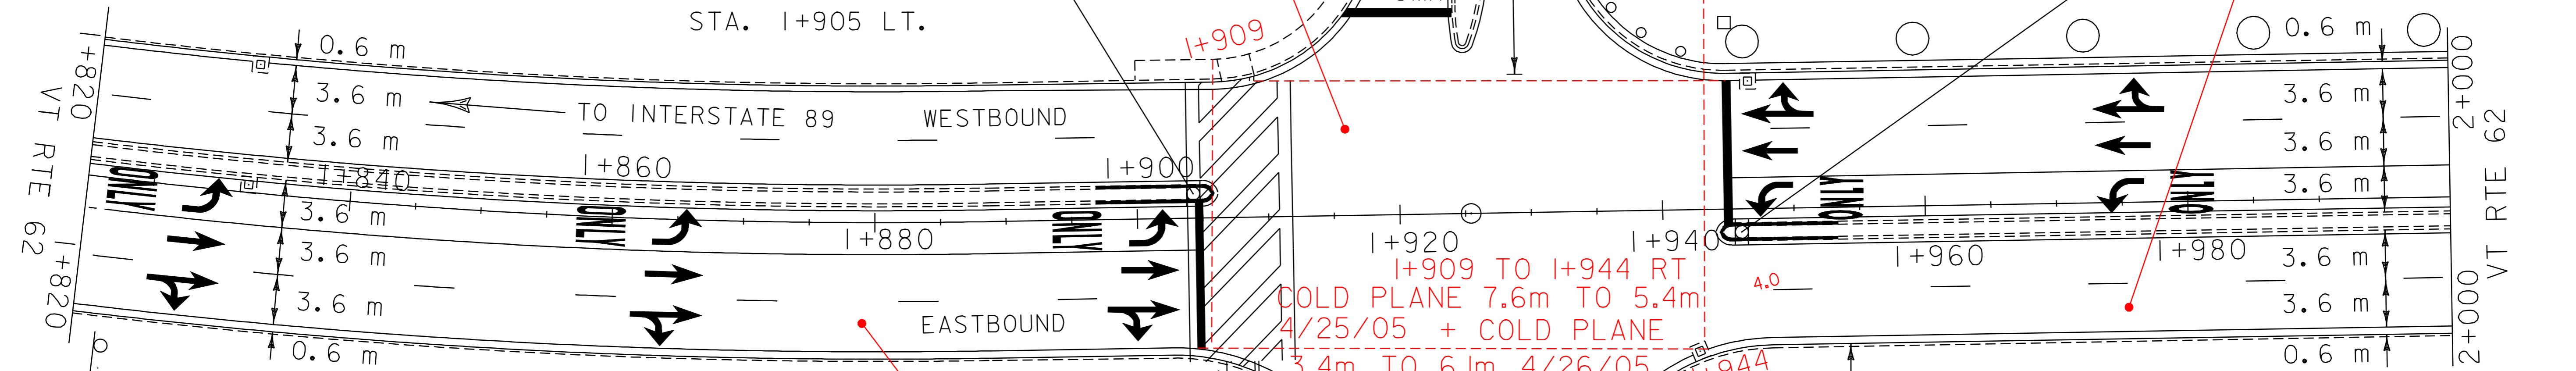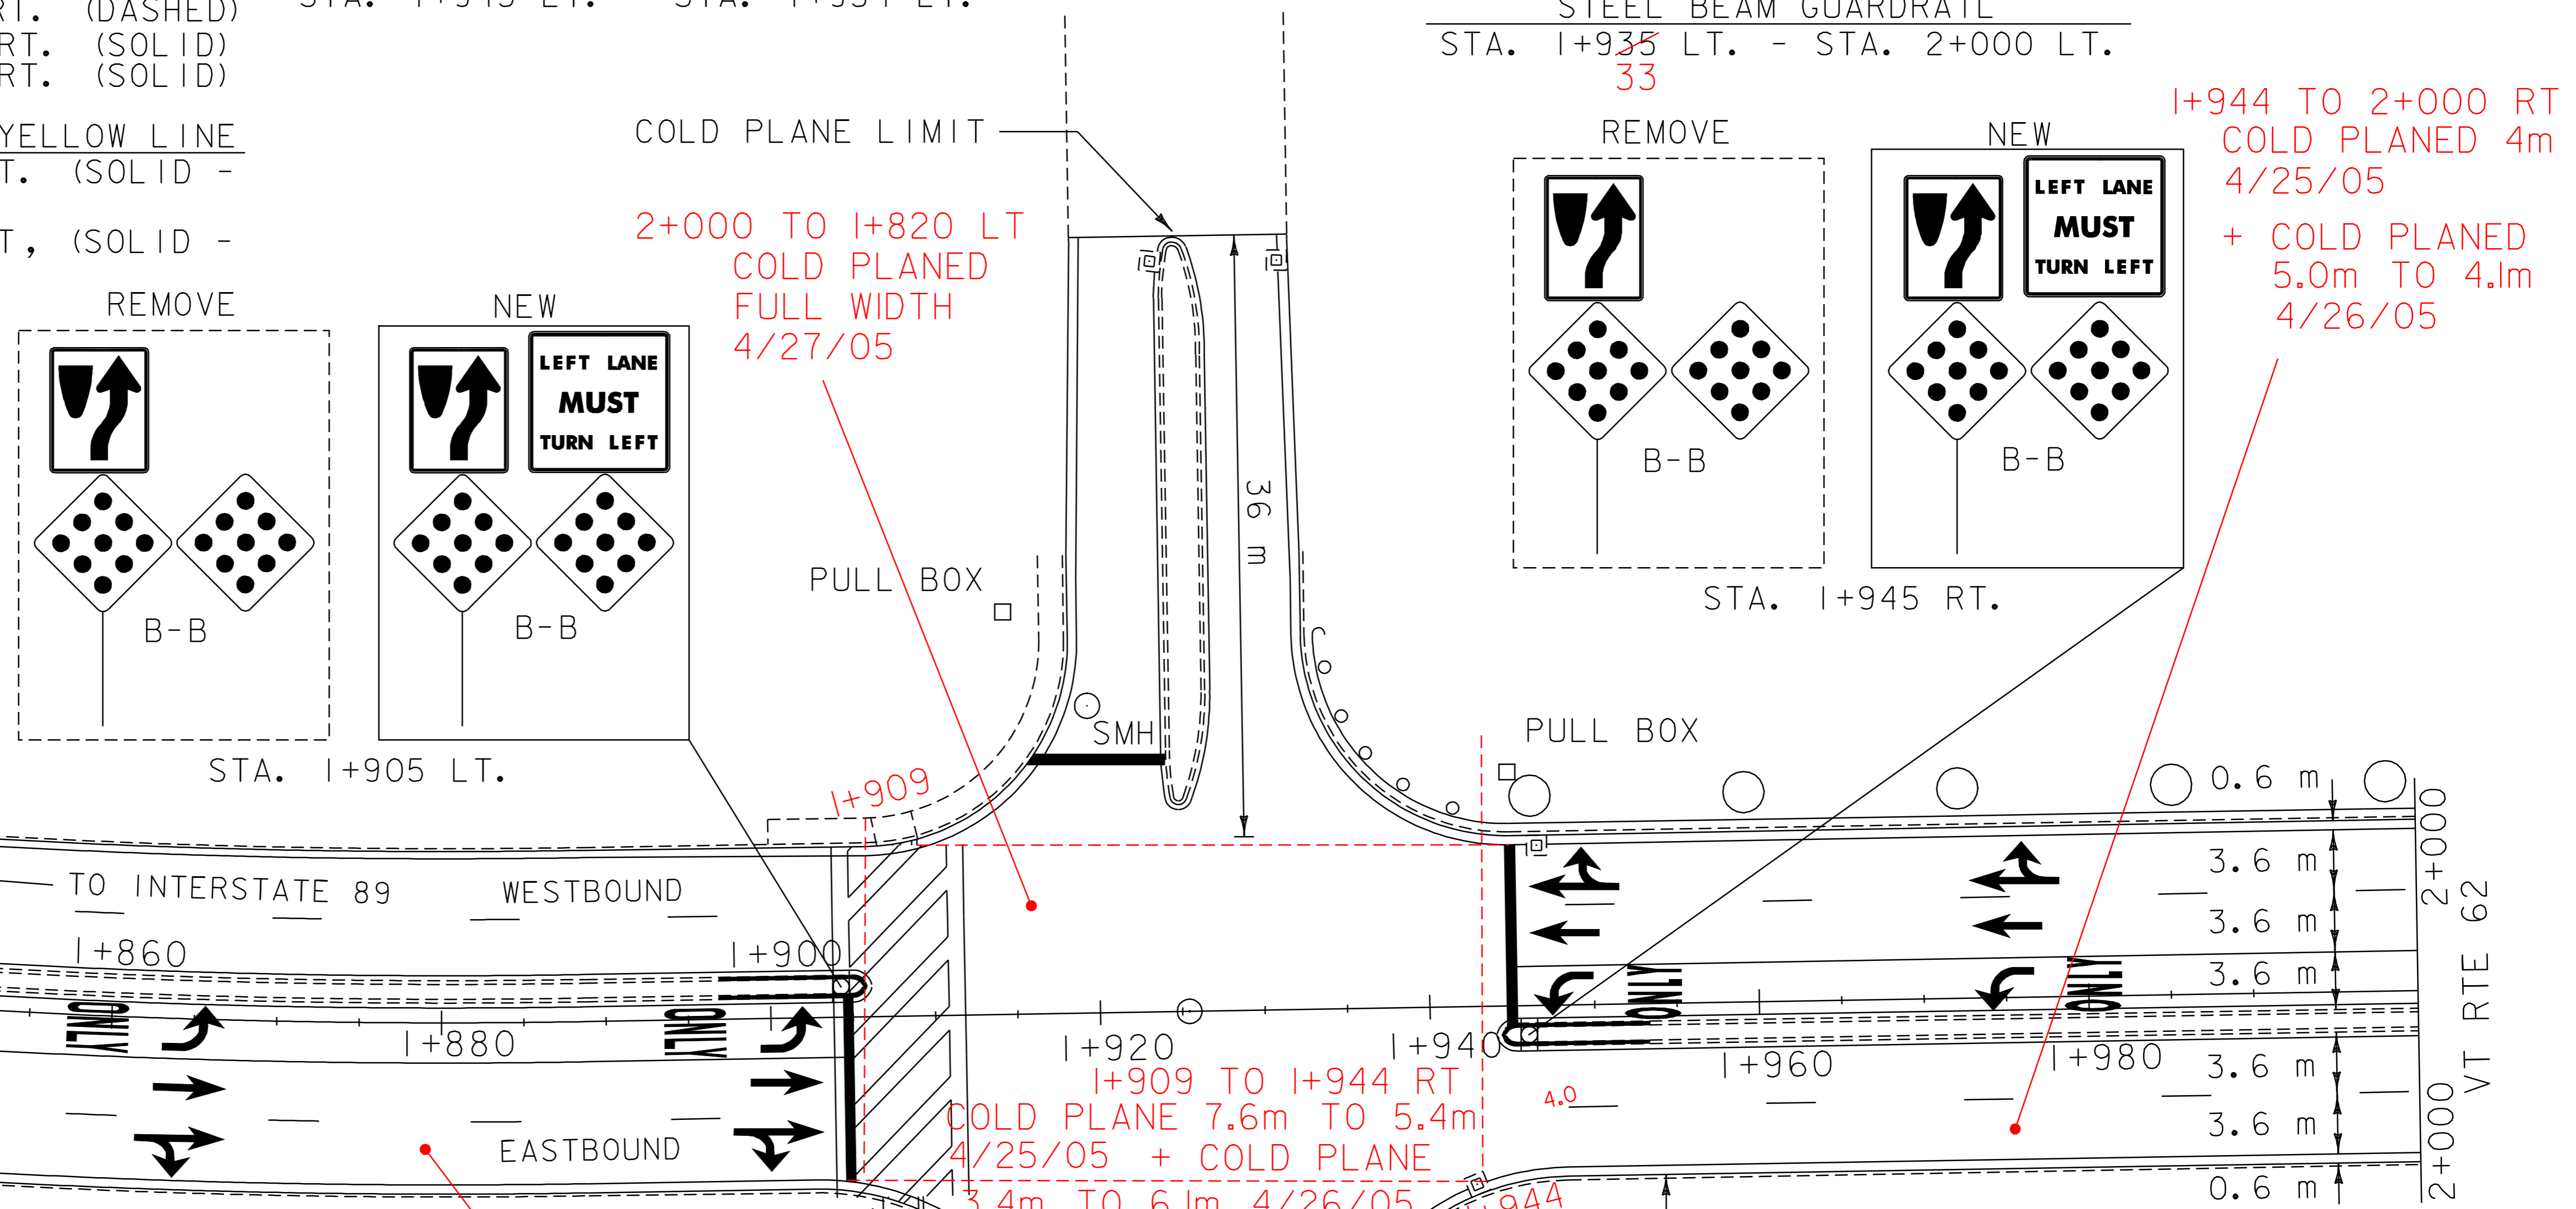

TEMPORARY AND DURABLE LETTERS OR SYMBOLS
 STA. 1+823 RT. (ONLY)
 STA. 1+828 RT. (LEFT TURN ARROW, THROUGH ARROW, THROUGH/RIGHT TURN ARROW)
 STA. 1+859 RT. (ONLY)
 STA. 1+864 RT. (LEFT TURN ARROW, THROUGH ARROW, THROUGH/RIGHT TURN ARROW)
 STA. 1+895 RT. (ONLY)
 STA. 1+900 RT. (LEFT TURN ARROW, THROUGH ARROW, THROUGH/RIGHT TURN ARROW)
 STA. 1+949 LT. (LEFT TURN ARROW, THROUGH ARROW, THROUGH/RIGHT TURN ARROW)
 STA. 1+954 LT. (ONLY)
 STA. 1+975 LT. (LEFT TURN ARROW, THROUGH ARROW, THROUGH/RIGHT TURN ARROW)
 STA. 1+980 LT. (ONLY)

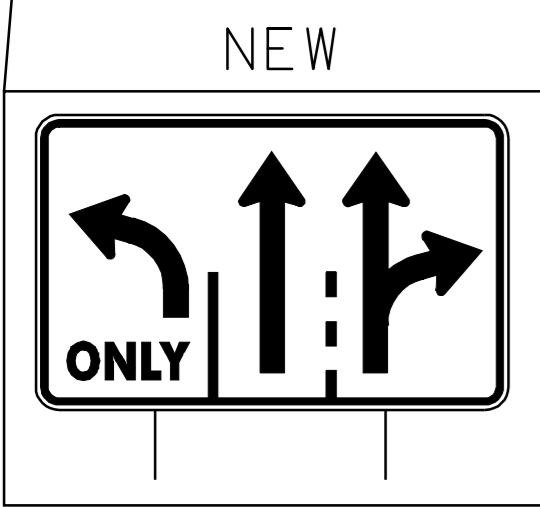


TEMPORARY AND DURABLE CROSSWALK W/DIAGONAL MARKINGS
 STA. 1+908 LT. - RT.


REHABILITATION OF DI'S, CB'S, OR MH'S - CLASS 1
 STA. 1+832 LT. (2 EACH)
 STA. 1+923 LT. } BERLIN STREET
 STA. 1+925 RT. }
 STA. 1+930 LT. }
 STA. 1+943 RT.
 STA. 1+947 LT.
CHANGING ELEVATION OF SEWER MANHOLE
 STA. 1+919 LT.
 STA. 1+923 RT.
REMOVING SIGNS
 6 EACH

I+820 TO I+909 MAINLINE RT COLD PLANE 7.6m 4/25/05 + COLD PLANE 4.1m 4/26/05

PAVING PROJECT LAYOUT #14	PROJECT NAME: BERLIN-BARRE CITY	FILE NAME: /pave/01b022/pb022.dgn	PLOT DATE: 12-MAR-2007 11:09
	PROJECT NUMBER: STP 232(I)S	PROJECT LEADER: WOOLAVER	DRAWN BY: LOCKE
	DESIGNED BY: LOCKE	CHECKED BY:	SHEET 26 OF 39
	pb022l4.1		

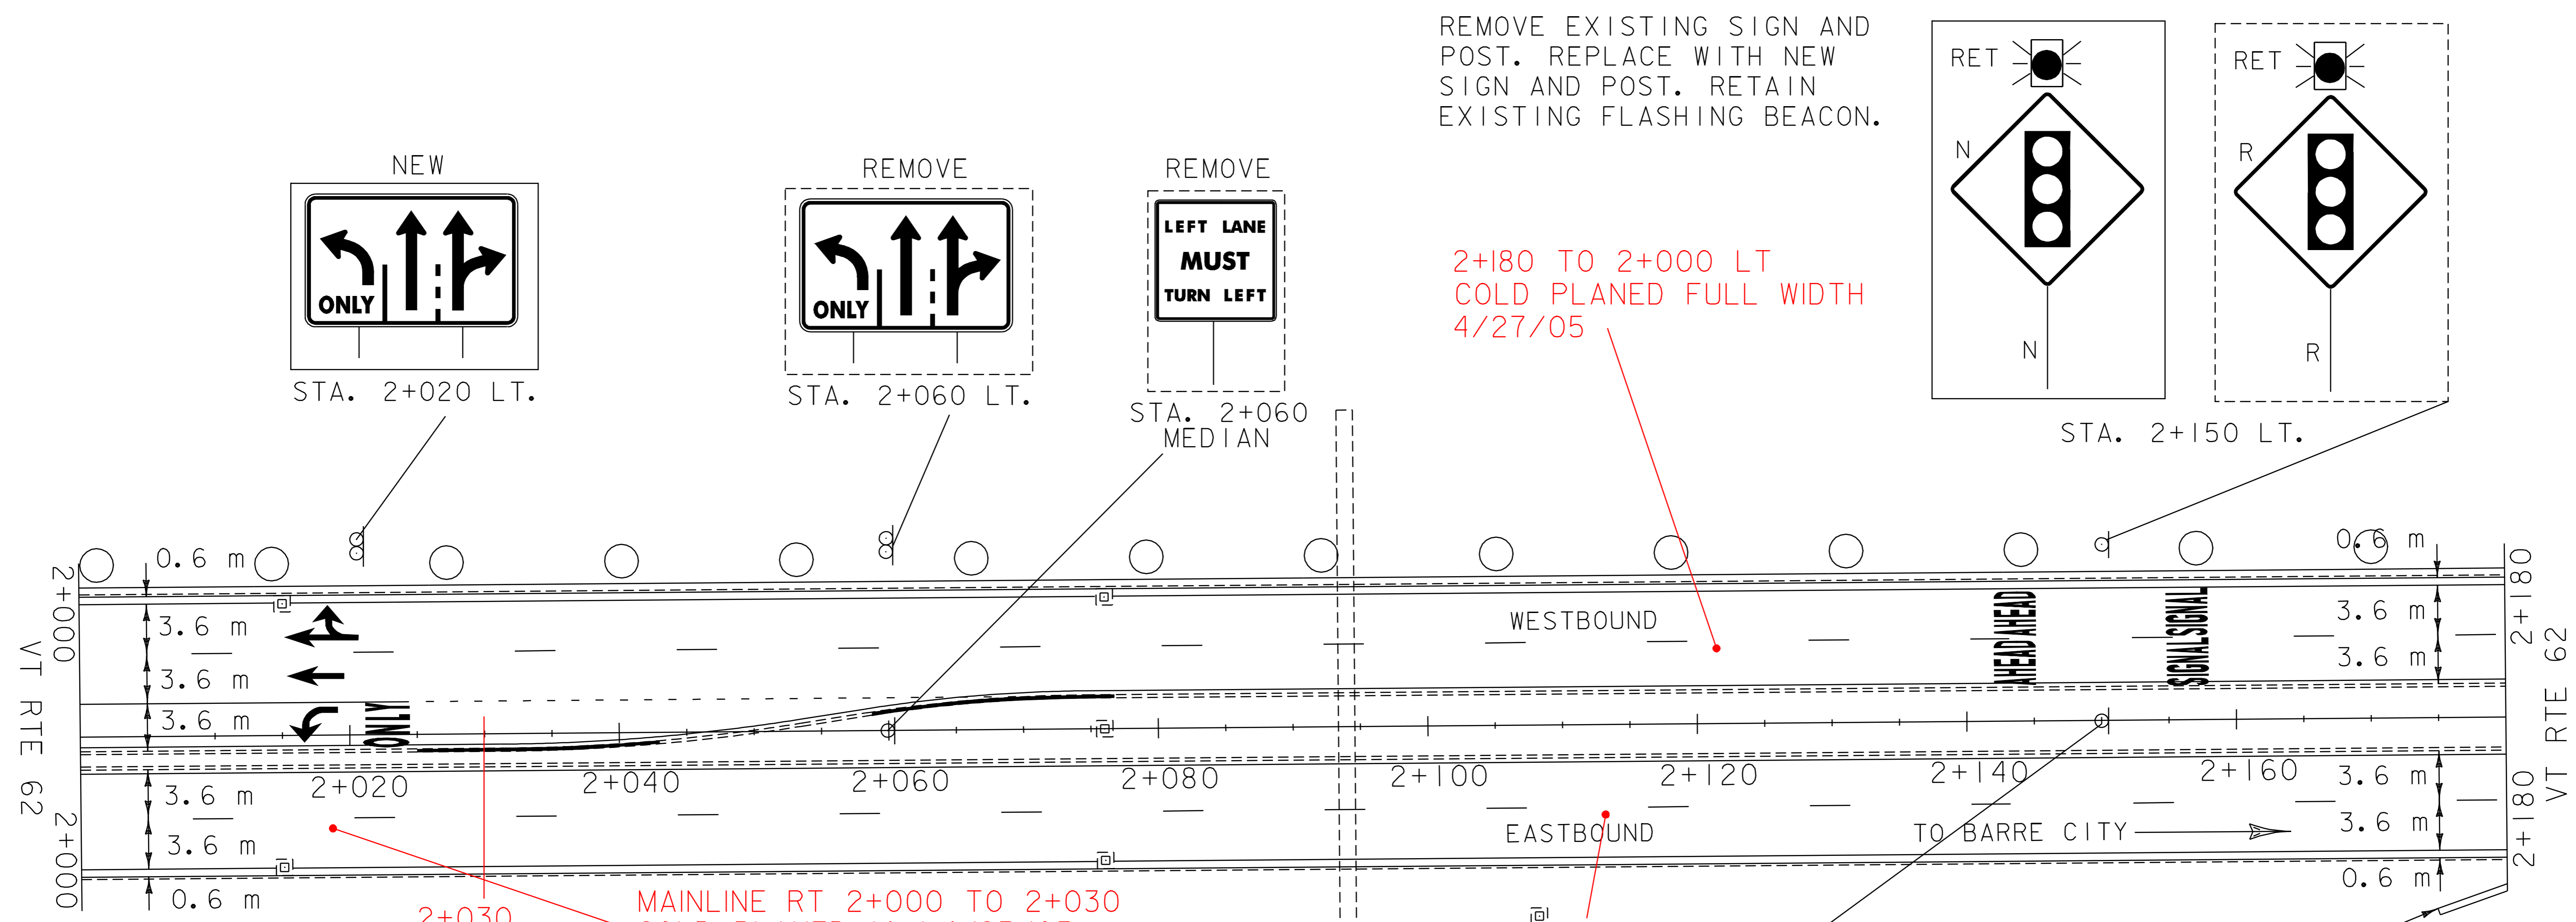

REMOVE EXISTING SIGN AND POST. REPLACE WITH NEW SIGN AND POST. RETAIN EXISTING FLASHING BEACON.

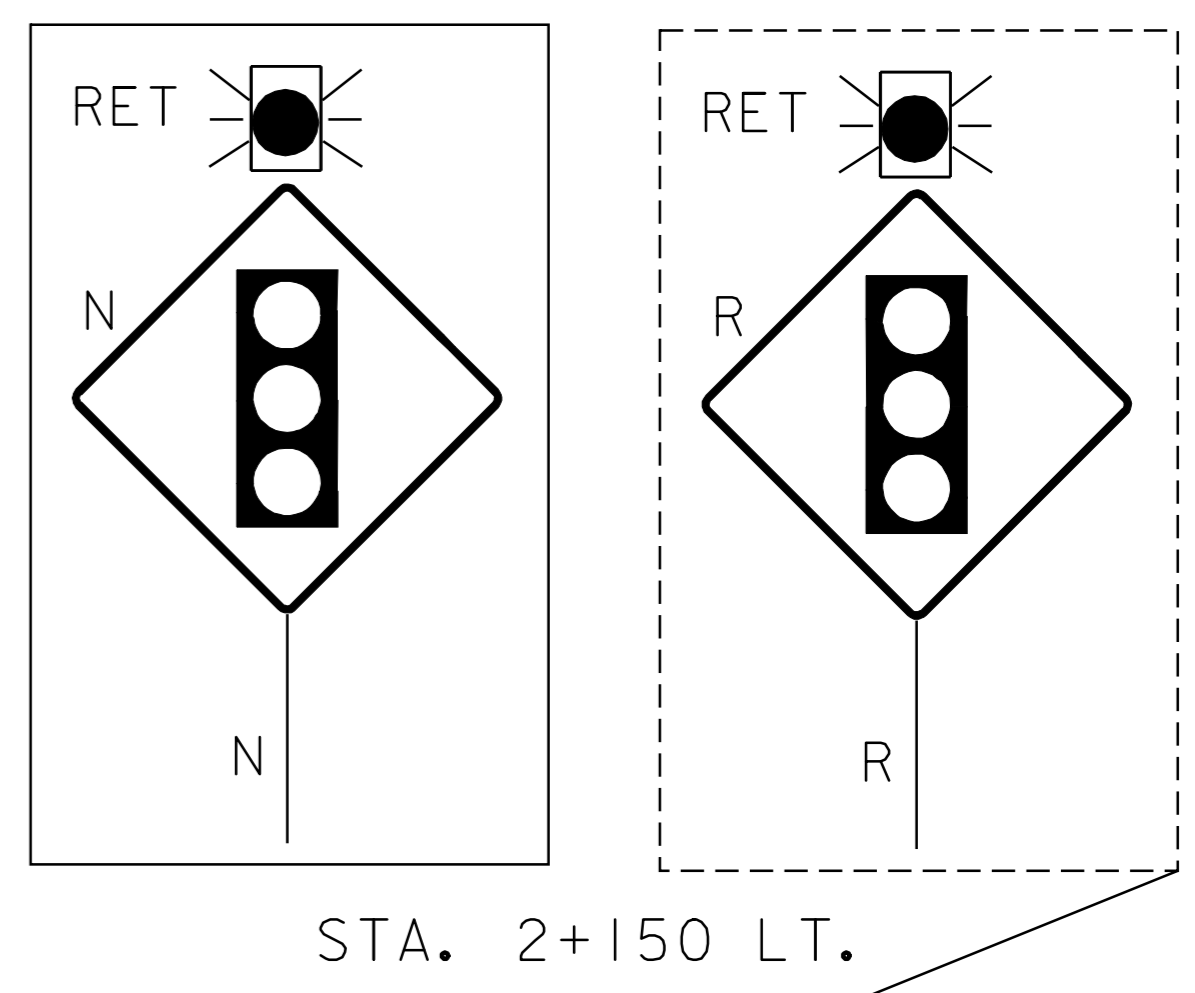

2+180 TO 2+000 LT
COLD PLANED FULL WIDTH
4/27/05

2+030
MAINLINE RT 2+000 TO 2+030
COLD PLANED (4m) 4/25/05
+ COLD PLANED (4.1m) 4/26/05

2+030 TO 2+180
COLD PLANED FULL WIDTH
4/26/05

TEMPORARY AND DURABLE 150 mm WHITE LINE
 STA. 2+000 LT. - STA. 2+180 LT. (SOLID)
 STA. 2+000 LT. - STA. 2+180 LT. (DASHED)
 STA. 2+000 LT. - STA. 2+024 LT. (SOLID)
 STA. 2+024 LT. - STA. 2+065 LT. (DOTTED)
 STA. 2+000 RT. - STA. 2+180 RT. (DASHED)
 STA. 2+000 RT. - STA. 2+180 RT. (SOLID)

TEMPORARY AND DURABLE 150 mm YELLOW LINE
 STA. 2+000 RT. - STA. 2+180 LT. (SOLID)
 STA. 2+000 RT. - STA. 2+180 RT. (SOLID)


TEMPORARY AND DURABLE LETTERS OR SYMBOLS
 STA. 2+018 LT. (LEFT TURN ARROW, THROUGH ARROW, THROUGH/RIGHT TURN ARROW)
 STA. 2+023 LT. (ONLY)
 STA. 2+144 LT. (AHEAD - 2 EACH)
 STA. 2+156 LT. (SIGNAL - 2 EACH)

PAINTED CURB
 STA. 2+025 RT. - STA. 2+043 RT.
 STA. 2+059 LT. - STA. 2+077 LT.

BRIDGE 10 2+093.98
1220 mm ACCGMP

REMOVAL AND DISPOSAL OF GUARDRAIL
 STA. 2+000 LT. - STA. 2+180 LT.
STEEL BEAM GUARDRAIL
 STA. 2+000 LT. - STA. 2+180 LT.

REHABILITATION OF DI'S, CB'S, OR MH'S-CLASS 1
 STA. 2+015 LT.
 STA. 2+015 RT.
 STA. 2+076 LT.
 STA. 2+076 MEDIAN CE
 2+076 RT
REMOVING SIGNS
 4 EACH

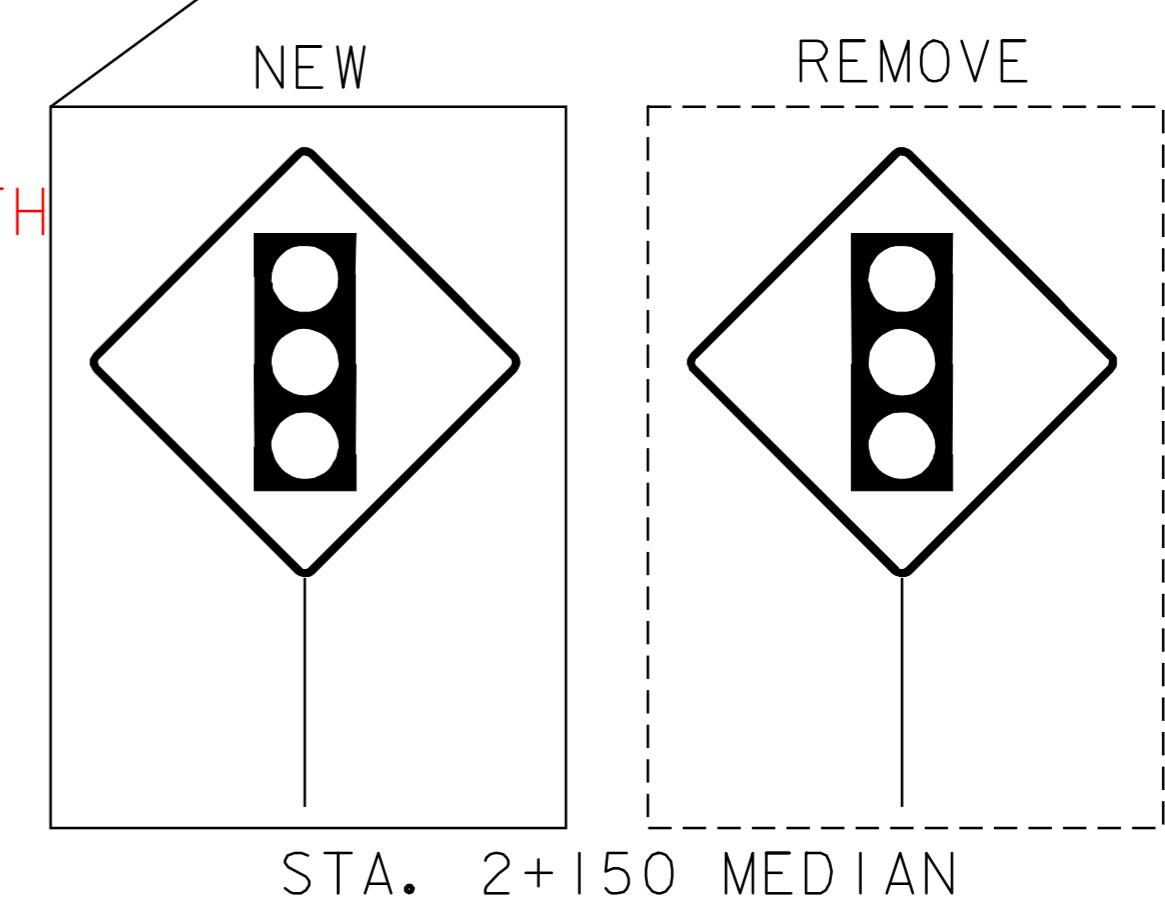

**PAVING
PROJECT
LAYOUT
#15**

PROJECT NAME: BERLIN-BARRE CITY
 PROJECT NUMBER: STP 232(I)S
 FILE NAME: /pave/01b022/pb022.dgn
 PROJECT LEADER: WOOLLAVER
 DESIGNED BY: LOCKE
 pb022al5.1
 PLOT DATE: 12-MAR-2007 11:0
 DRAWN BY: LOCKE
 CHECKED BY:
 SHEET 27 OF 39

TEMPORARY AND DURABLE 150 mm WHITE LINE
 STA. 2+180 LT. - STA. 2+360 LT. (SOLID)
 STA. 2+180 LT. - STA. 2+360 LT. (DASHED)
 STA. 2+180 RT. - STA. 2+360 RT. (DASHED)
 STA. 2+180 RT. - STA. 2+360 RT. (SOLID)

TEMPORARY AND DURABLE 150 mm YELLOW LINE
 STA. 2+180 LT. - STA. 2+360 LT. (SOLID)
 STA. 2+180 RT. - STA. 2+360 RT. (SOLID)

TEMPORARY AND DURABLE LETTERS OR SYMBOLS
 STA. 2+305 RT. (SIGNAL - 2 EACH)
 STA. 2+317 RT. (AHEAD - 2 EACH)

REMOVAL AND DISPOSAL OF GUARDRAIL
 STA. 2+180 LT. - STA. 2+220 LT.
 STA. 2+276 LT. - STA. 2+360 LT.
 STA. 2+273 RT. - STA. 2+360 RT.



STEEL BEAM GUARDRAIL
 STA. 2+180 LT. - STA. 2+220 LT.
 STA. 2+276 LT. - STA. 2+360 LT.
 STA. 2+273 RT. - STA. 2+360 RT.

REHABILITATION OF DI'S, CB'S, OR MH'S-CLASS I

STA. 2+221 LT.
 STA. 2+221 MEDIAN
 STA. 2+221 RT.
 STA. 2+312 LT.
 STA. 2+312 RT.

REMOVING SIGNS
 2 EACH

SNOW BARRIER-GALVANIZED
 STA. 2+220 LT. - STA. 2+276 LT.
 STA. 2+220 RT. - STA. 2+273 RT.

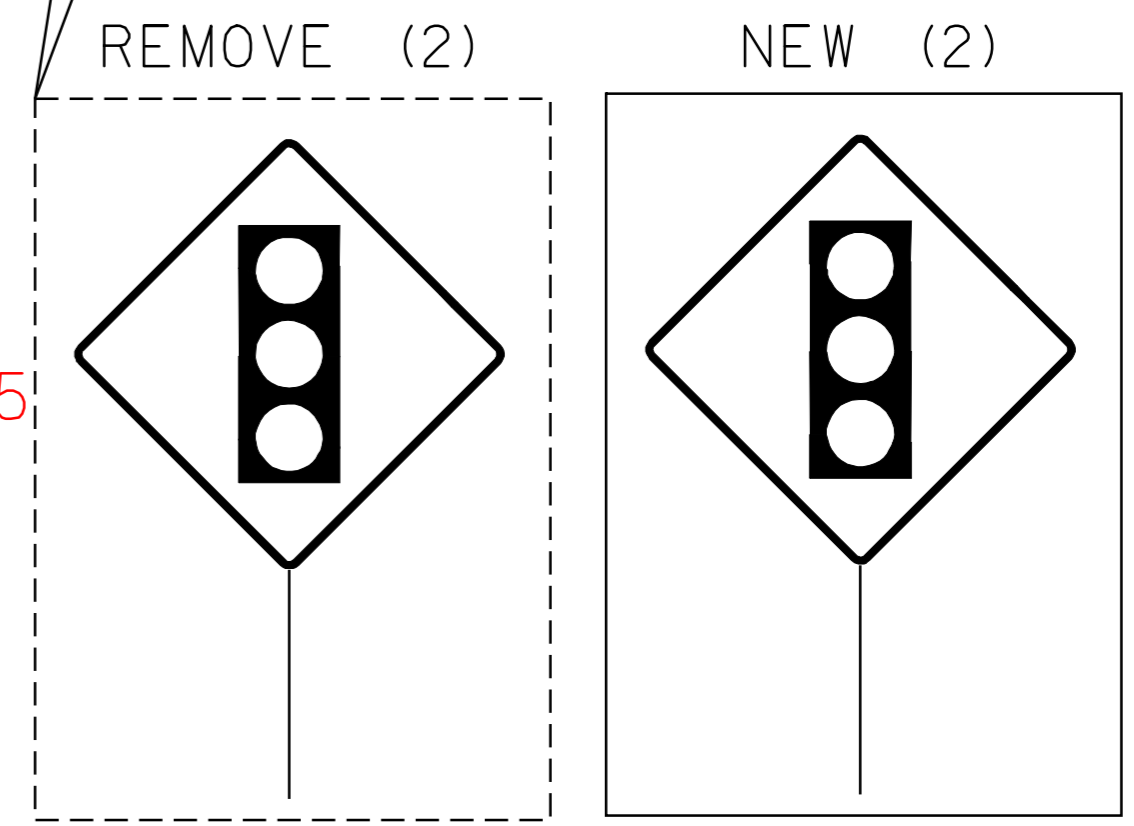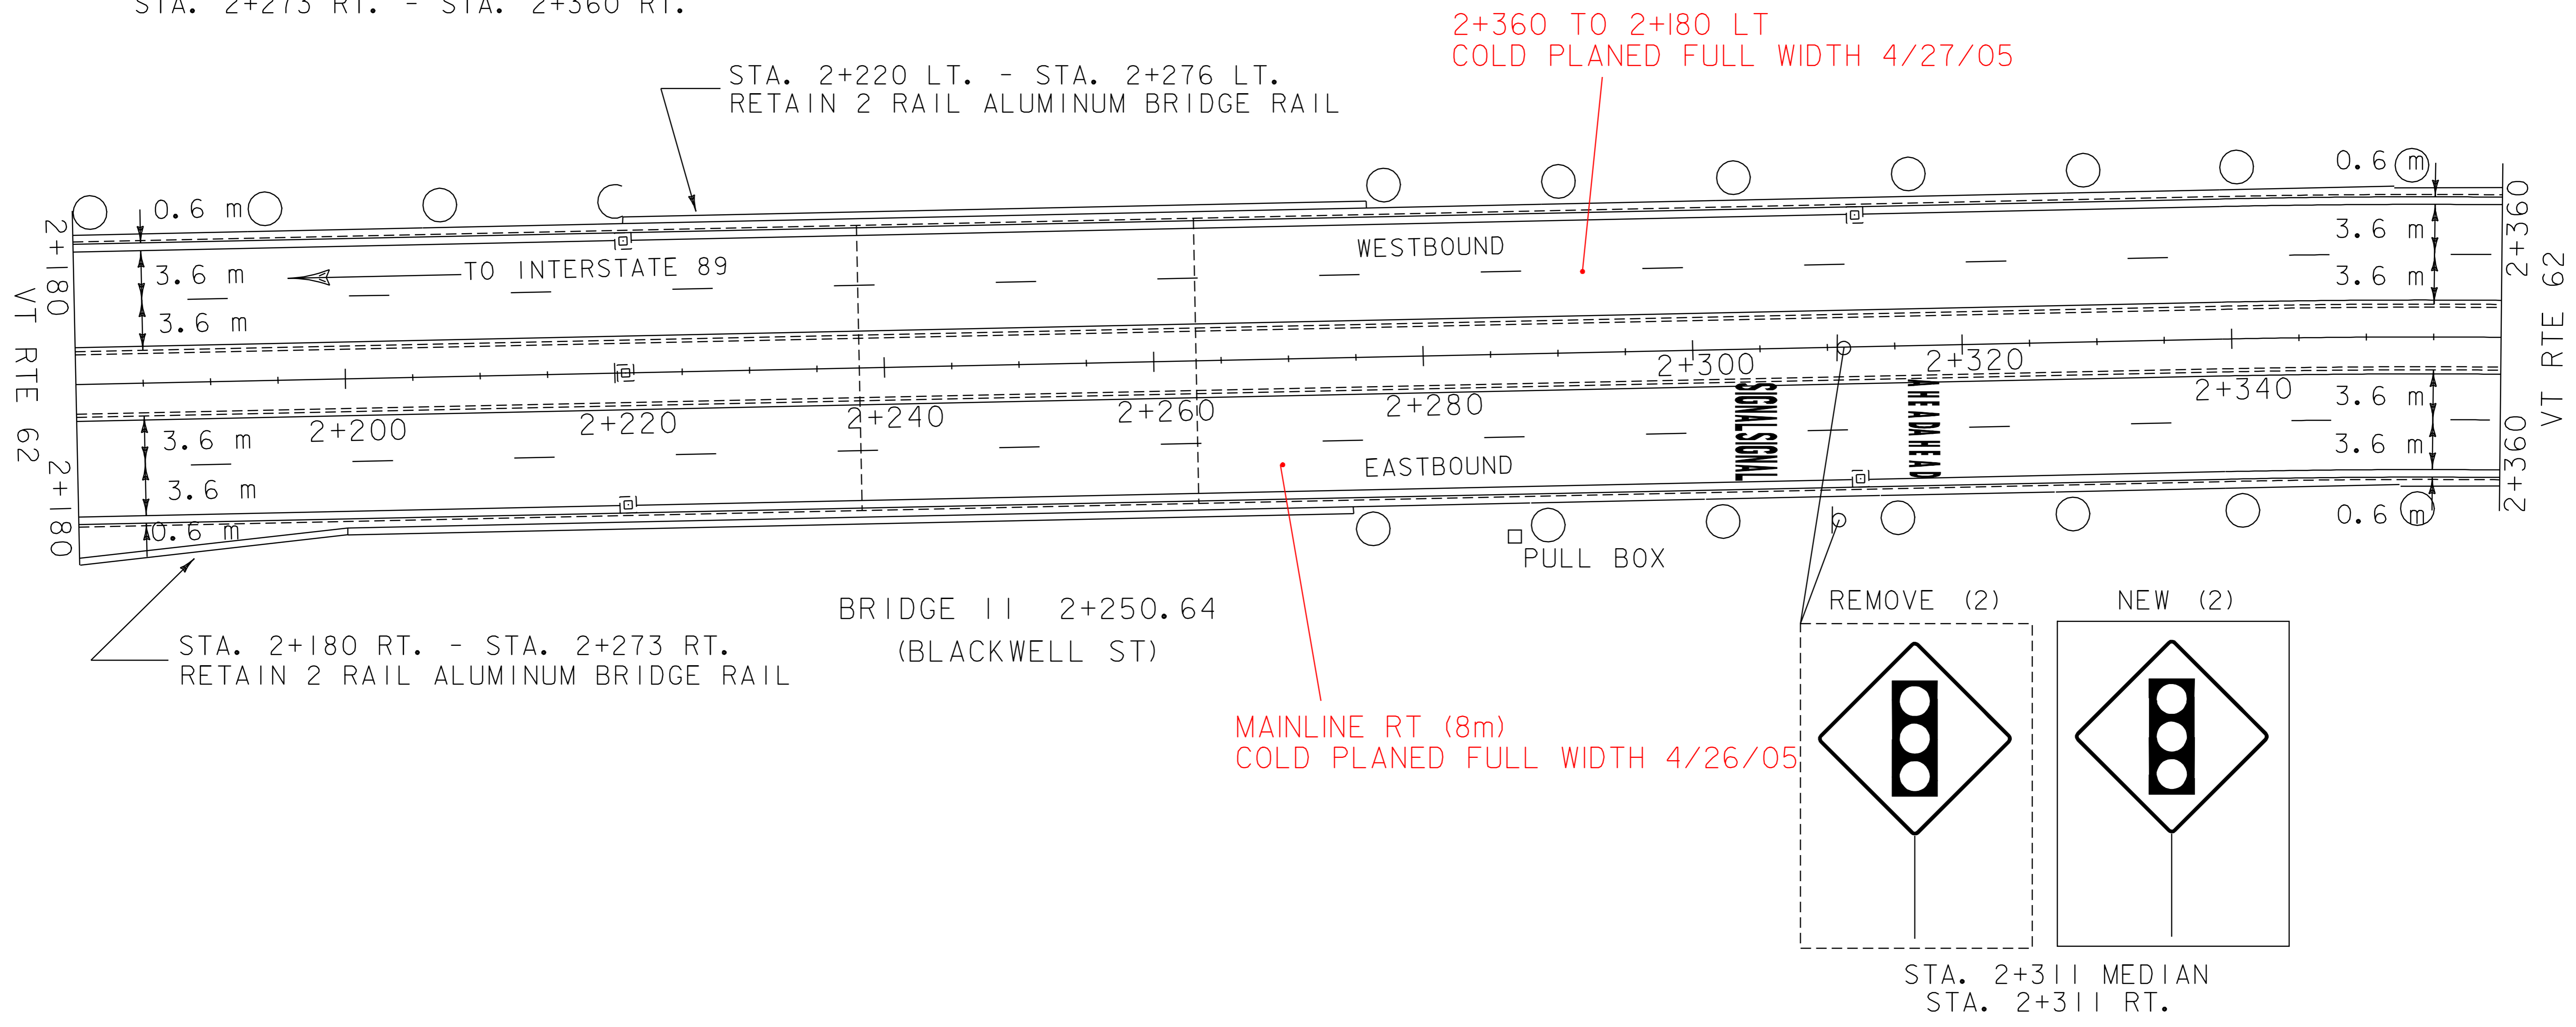

**PAVING
 PROJECT
 LAYOUT
 #16**

PROJECT NAME: BERLIN-BARRE CITY
 PROJECT NUMBER: STP 232(I)S
 FILE NAME: /pave/01b022/pb022.dgn
 PROJECT LEADER: WOOLLAVER
 DESIGNED BY: LOCKE
 PLOT DATE: 12-MAR-2007 11:0
 DRAWN BY: LOCKE
 CHECKED BY:
 SHEET 28 OF 39

REMOVAL AND DISPOSAL OF GUARDRAIL

STA. 2+360 LT. - STA. 2+462 LT.
 STA. 2+360 RT. - STA. 2+464 RT.

STEEL BEAM GUARDRAIL

STA. 2+360 LT. - STA. 2+451 LT.
 STA. 2+360 RT. - STA. 2+460 RT.

TRAILING END TERMINAL

STA. 2+460 RT. - STA. 2+464 RT.

MANUFACTURED TERMINAL SECTION (FLARED)

STA. 2+451 LT. - STA. 2+462 LT. - **Gld**
 ANCHOR FOR STEEL BEAM GUARDRAIL

STA. 2+462 RT.

TEMPORARY AND DURABLE 600 mm STOP BAR

STA. 2+467 RT. STA. 2+476 LT.
 STA. 2+539 RT.

TEMPORARY AND DURABLE 150 mm WHITE LINE

STA. 2+360 LT. - STA. 2+539 LT. (SOLID)
 STA. 2+360 LT. - STA. 2+539 LT. (DASHED)
 STA. 2+360 RT. - STA. 2+460 RT. (DASHED)
 STA. 2+460 RT. - STA. 2+539 RT. (SOLID)
 STA. 2+360 RT. - STA. 2+539 RT. (SOLID)

TEMPORARY AND DURABLE 150 mm YELLOW LINE

STA. 2+360 LT. - STA. 2+539 LT. (SOLID)
 STA. 2+360 RT. - STA. 2+539 RT. (SOLID)

TEMPORARY AND DURABLE LETTERS OR SYMBOLS

STA. 2+460 RT. (ONLY)
 STA. 2+464 RT. (LEFT TURN/THROUGH ARROW,
 RIGHT TURN ARROW)
 STA. 2+490 RT. (ONLY)
 STA. 2+494 RT. (LEFT TURN/THROUGH ARROW,
 RIGHT TURN ARROW)
 STA. 2+530 RT. (ONLY)
 STA. 2+534 RT. (LEFT TURN/THROUGH ARROW,
 RIGHT TURN ARROW)

BITUMINOUS CONCRETE GUTTERS AND TRAFFIC ISLANDS

STA. 2+361 MEDIAN STA. 2+414 MEDIAN
 STA. 2+464 MEDIAN


REHABILITATION OF DI'S, CB'S, OR MH'S-CLASS I

STA. 2+361 MEDIAN **CE** STA. 2+464 LT. **IN RR ROW**
 STA. 2+361 RT. STA. 2+464 MEDIAN **CE ELIMINATED**
 STA. 2+414 MEDIAN **CE** STA. 2+525 LT.
 STA. 2+416 RT. STA. 2+525 RT.




REMOVING SIGNS

12 EACH

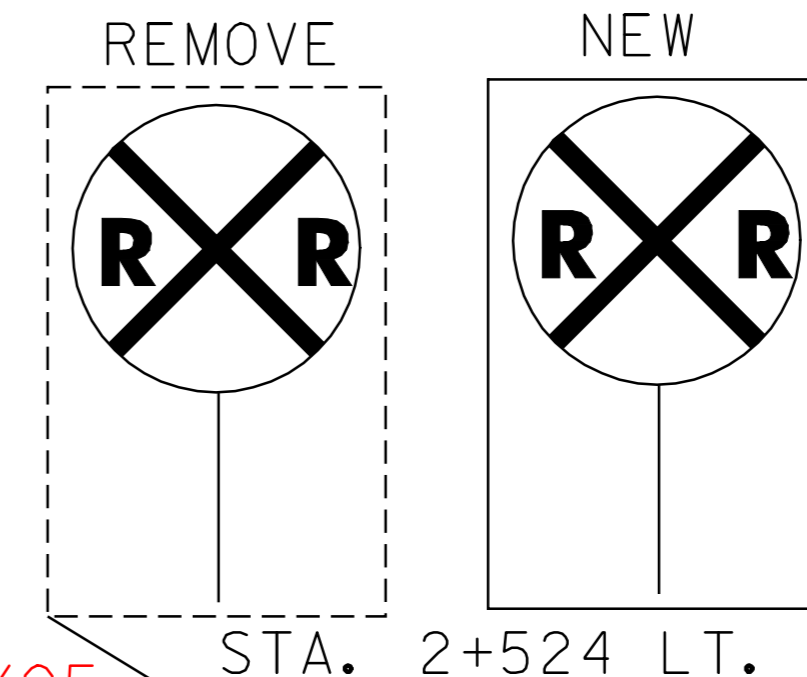


**2+539 TO 2+360 LT
 COLD PLANED FULL WIDTH 4/27/05**

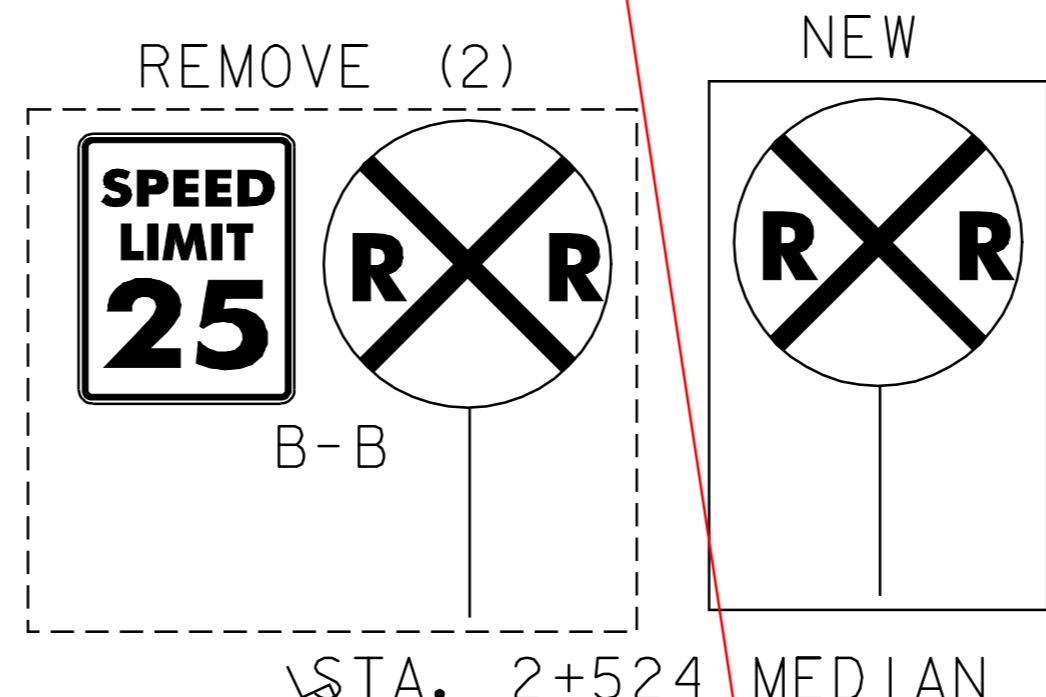

~~NOTE: CONSTRUCT NEW RCDI W/450 mm CPEP SL PIPE
 AT STA. 2+539 LT. OUTLET INTO EXISTING RCDI AT
 STA. 2+524 LT.~~

REMOVING & RESETTING CURB


STA. 2+539 LT.

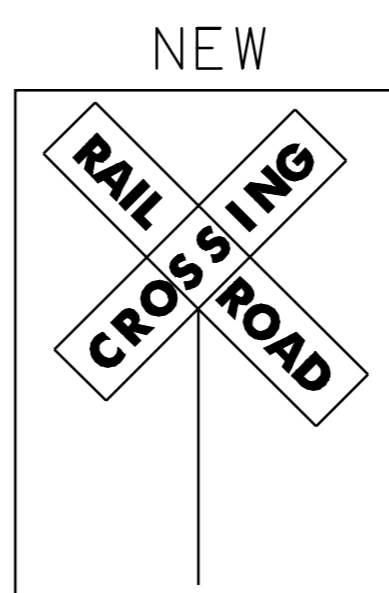

STA. 2+476 LT.


**END STP 2321(1)S
 VT RTE 62
 BARRE CITY
 STA. 2+539.00 = MM 1.577**

**MAINLINE RT (8m)
 COLD PLANED
 4/26/05
 2+746 TO 2+540
 FULL WIDTH**

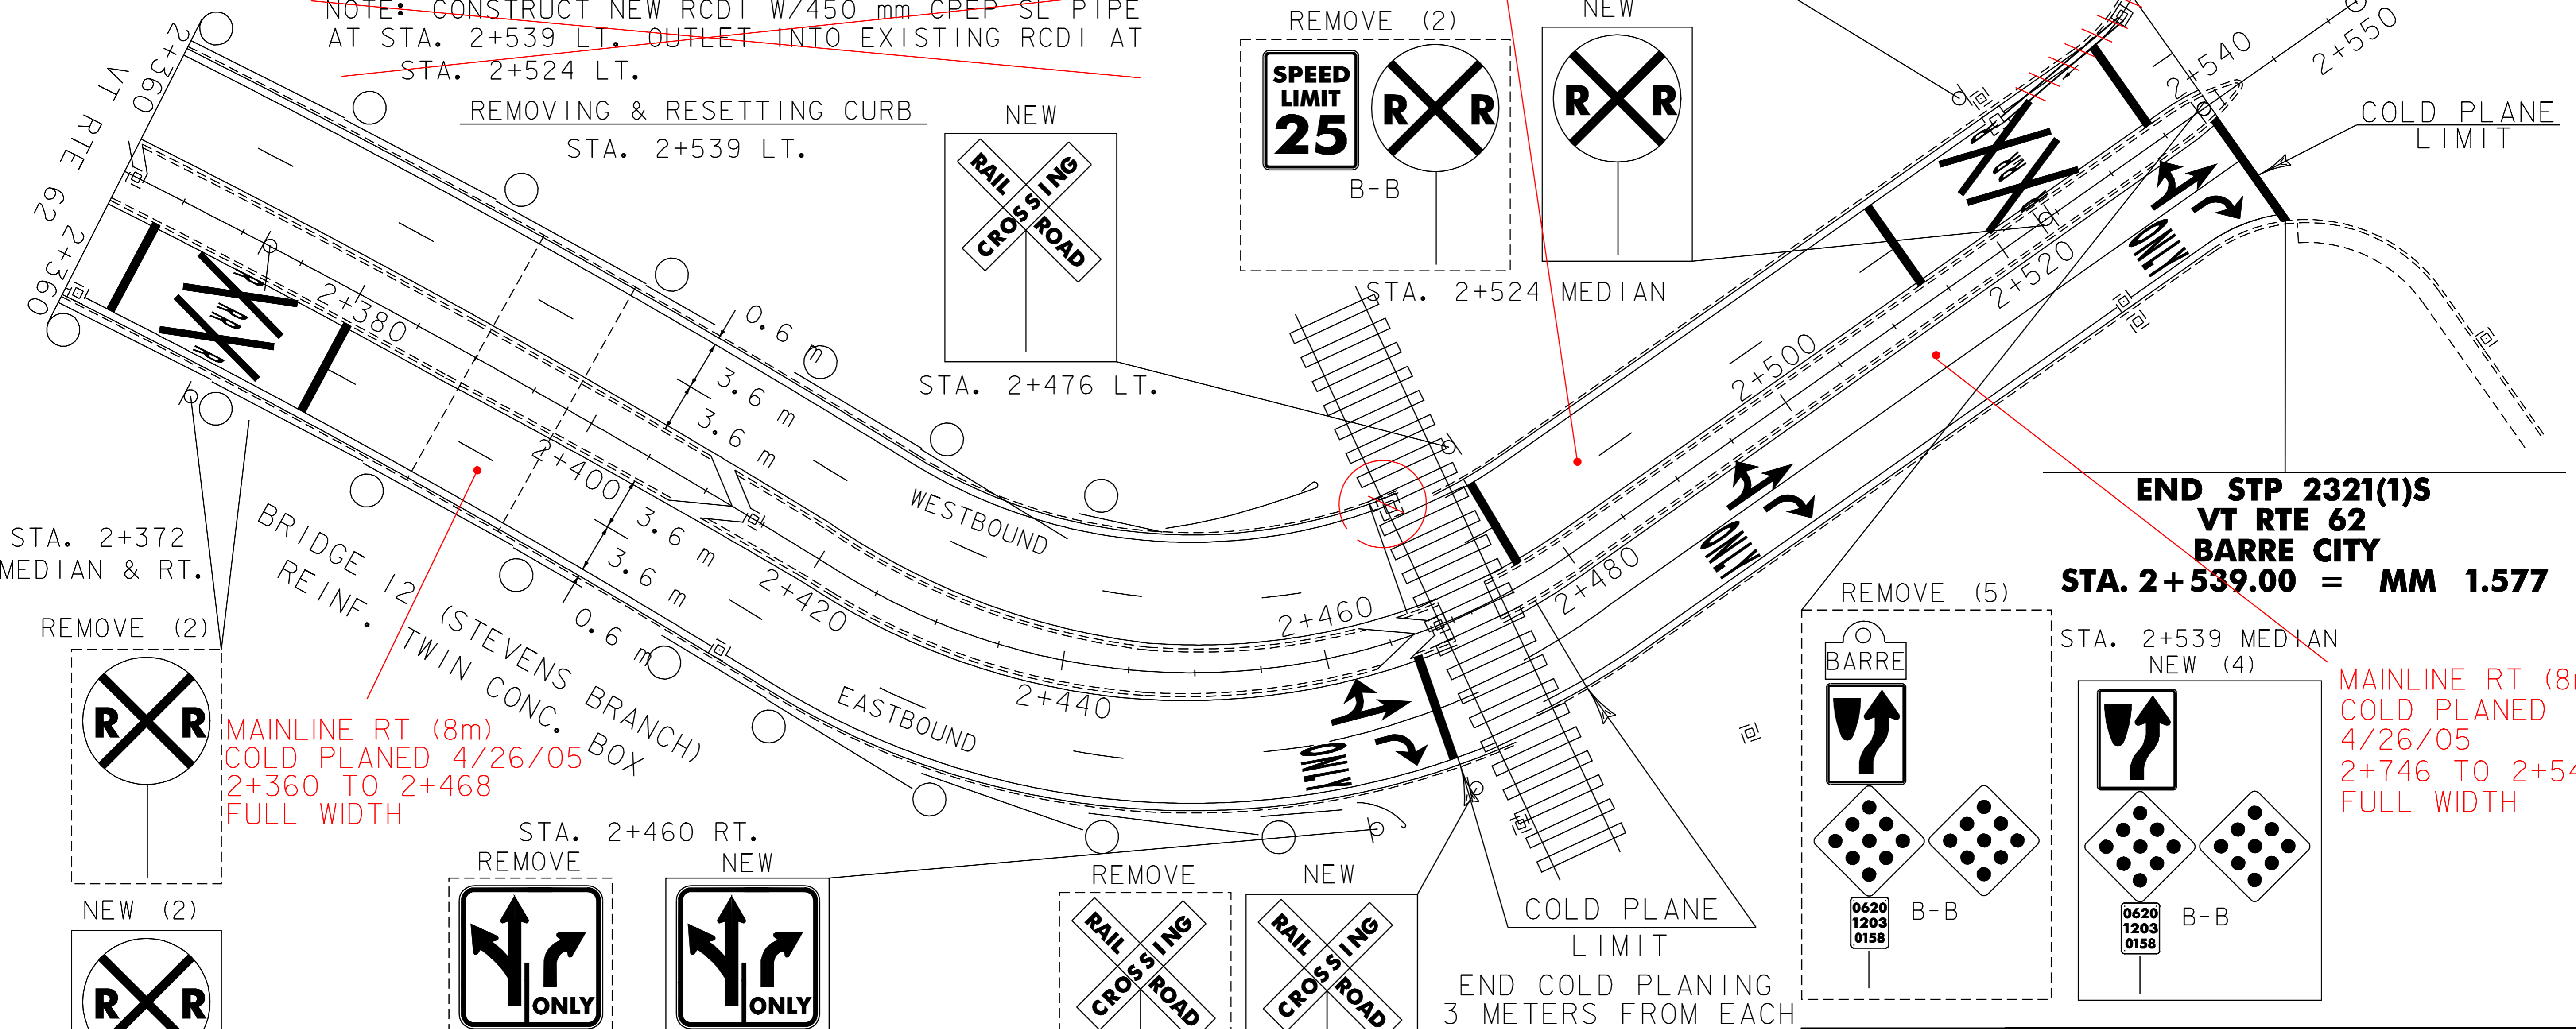


STA. 2+372
 MEDIAN & RT.

REMOVE (2)

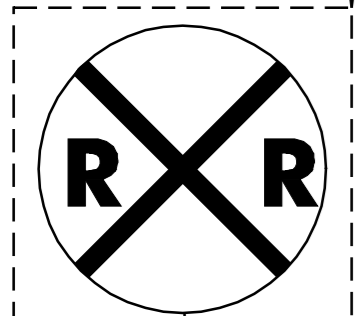

NEW (2)

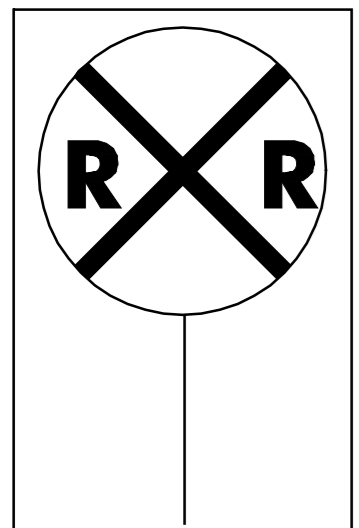

STA. 2+460 RT.


REMOVE




NEW



REMOVE

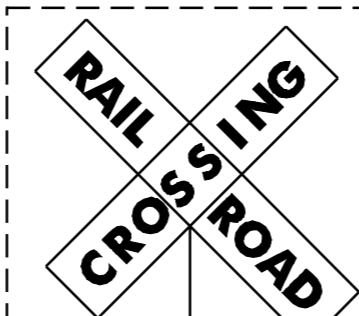


NEW

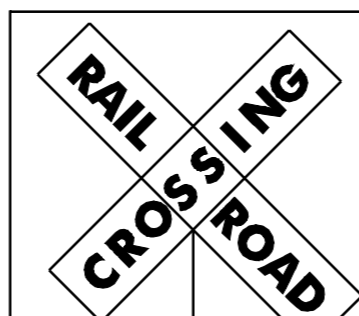


STA. 2+467 RT.

REMOVE (5)

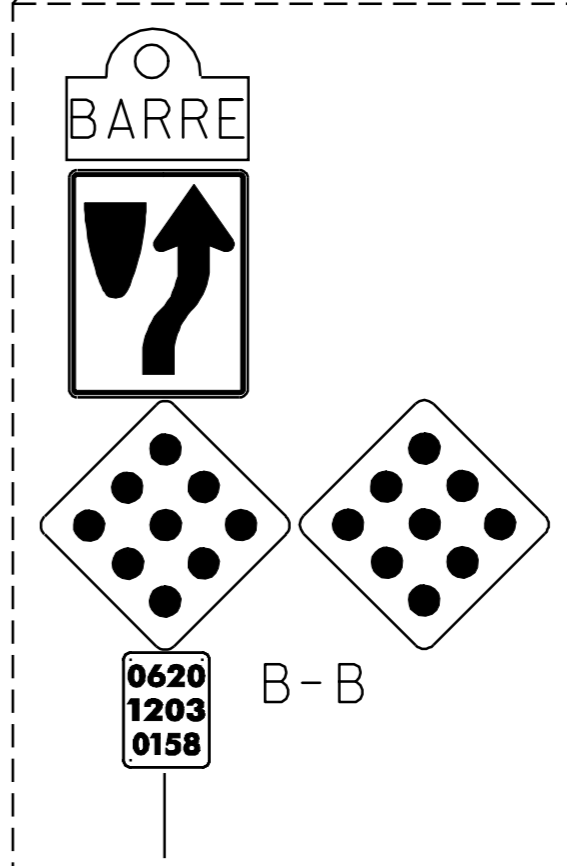

STA. 2+539 MEDIAN


NEW (4)

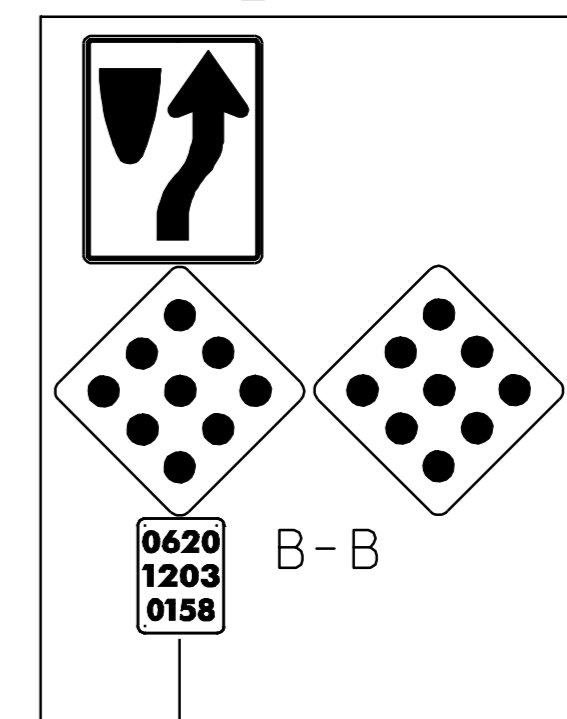

END COLD PLANING
 3 METERS FROM EACH
 APPROACH TO TRACKS.

**PAVING
 PROJECT
 LAYOUT
 #17**

PROJECT NAME: BERLIN-BARRE CITY	PLOT DATE: 12-MAR-2007 11:0
PROJECT NUMBER: STP 2321(1)S	DRAWN BY: LOCKE
FILE NAME: /pave/01b022/pb022.dgn	CHECKED BY:
DESIGNED BY: LOCKE	SHEET 29 OF 39
pb0221d17.1	

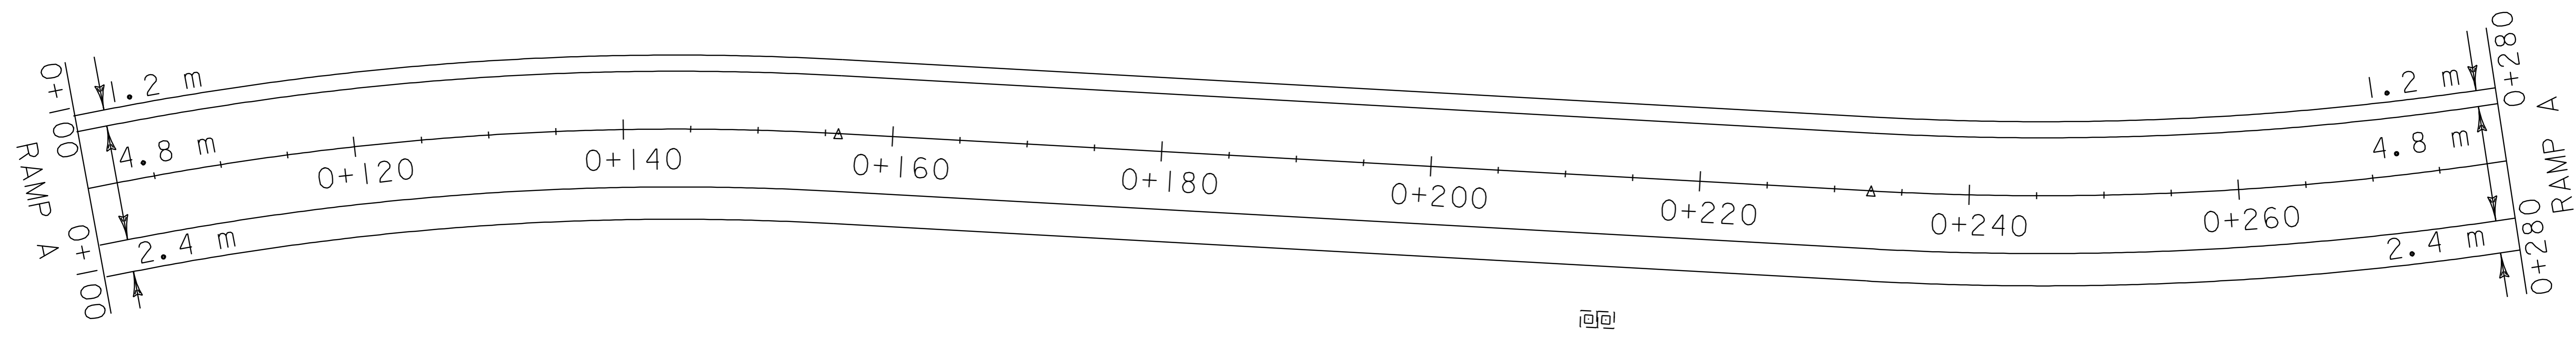


TEMPORARY AND DURABLE 150 mm WHITE LINE
 STA. 0+100 LT. - STA. 0+460 LT. (SOLID)
 STA. 0+100 RT. - STA. 0+460 RT. (SOLID)

REHABILITATION OF DI'S, CB'S, OR MH'S-CLASS 1
 STA. 0+419 LT.
 0+210 RT (2)

REMOVAL AND DISPOSAL OF STEEL BEAM GUARDRAIL
 STA. 0+443 RT. - STA. 0+460 RT.


STEEL BEAM GUARDRAIL
 STA. 0+443 RT. - STA. 0+460 RT.

SNOW BARRIER-GALVANIZED
 STA. 0+369 LT. - STA. 0+431 LT.
 STA. 0+369 RT. - STA. 0+431 RT.

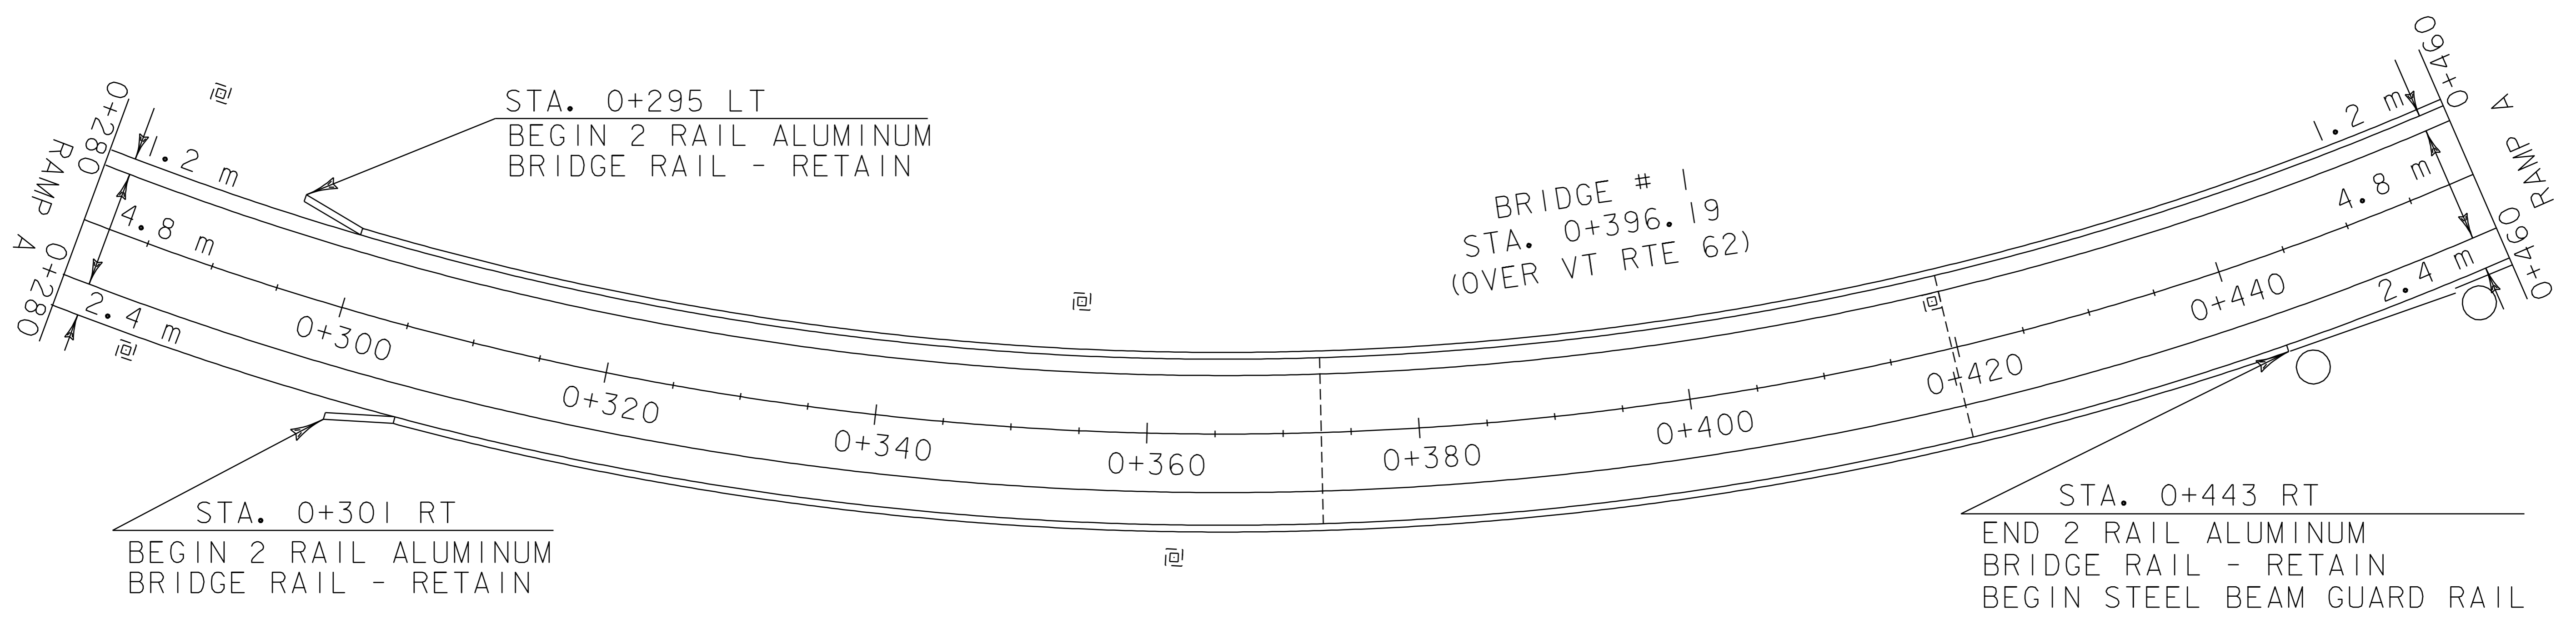

RAMP A

PAVING PROJECT LAYOUT #18	PROJECT NAME: BERLIN-BARRE CITY	FILE NAME: /pave/01b022/pb022.dgn	PLOT DATE: 12-MAR-2007 11:0
	PROJECT NUMBER: STP 2321(1)S	PROJECT LEADER: WOOLAVER	DRAWN BY: LOCKE
		DESIGNED BY: LOCKE	CHECKED BY:
		pb0221d18.1	SHEET 30 OF 39

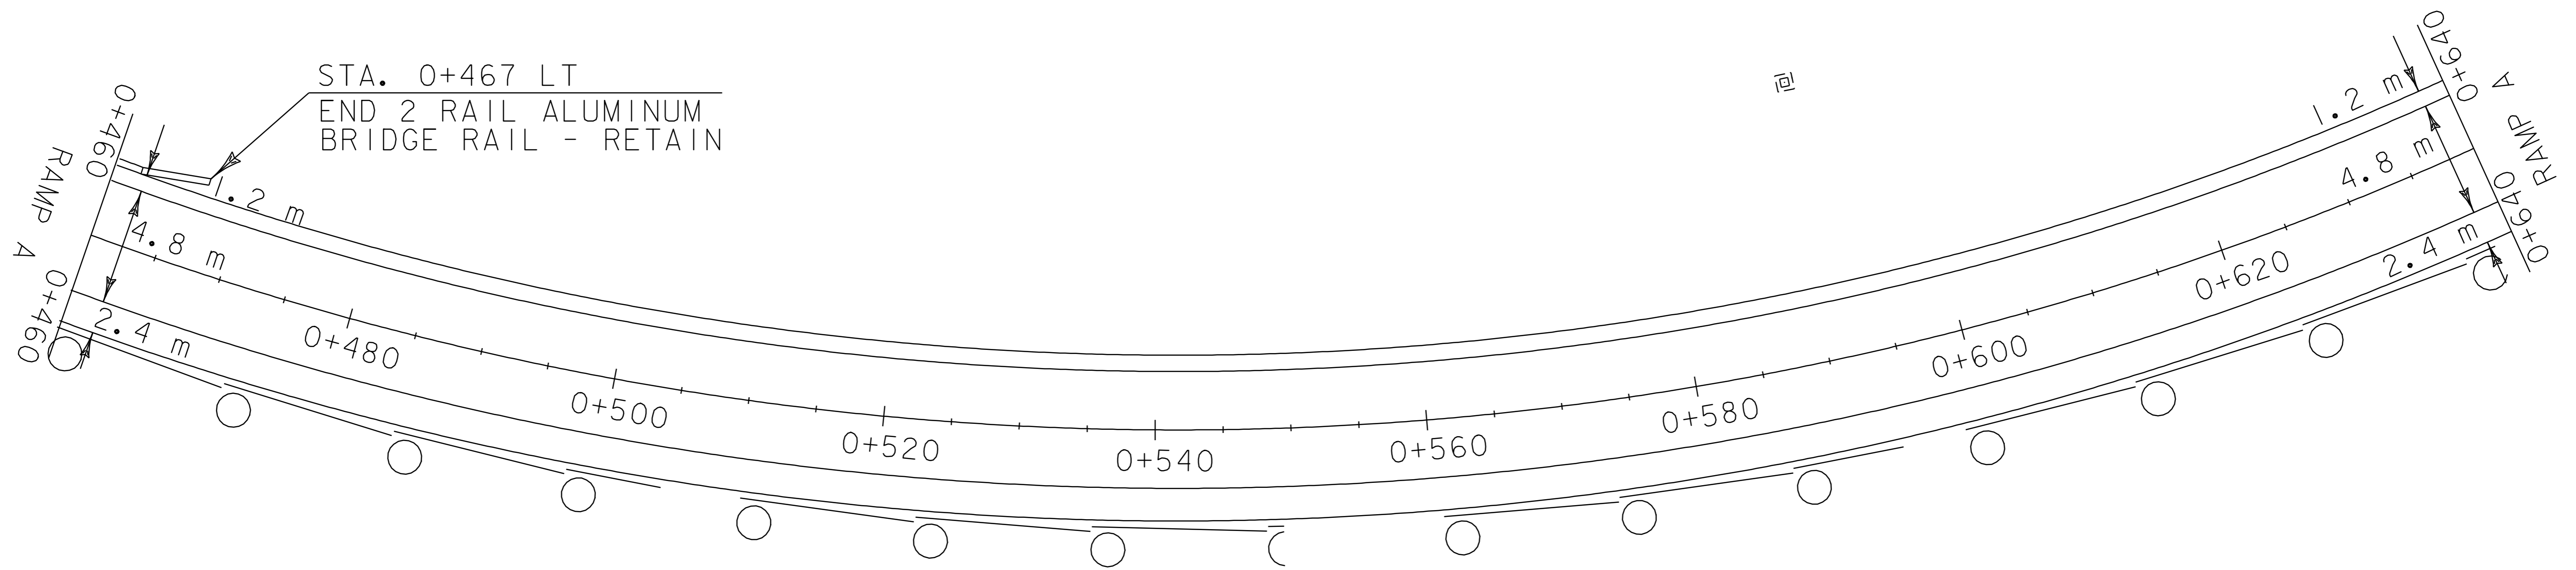

TEMPORARY AND DURABLE 150 mm WHITE LINE

STA. 0+460 LT. - STA. 0+820 LT. (SOLID)
 STA. 0+460 RT. - STA. 0+820 RT. (SOLID)

REMOVAL AND DISPOSAL OF GUARDRAIL

STA. 0+460 RT. - STA. 0+678 RT.

STEEL BEAM GUARDRAIL


STA. 0+460 RT. - STA. 0+674 RT.

TRAILING END TERMINAL

STA. 0+674 RT. - STA. 0+678 RT.

ANCHOR FOR STEEL BEAM GUARDRAIL

STA. 0+676 RT.

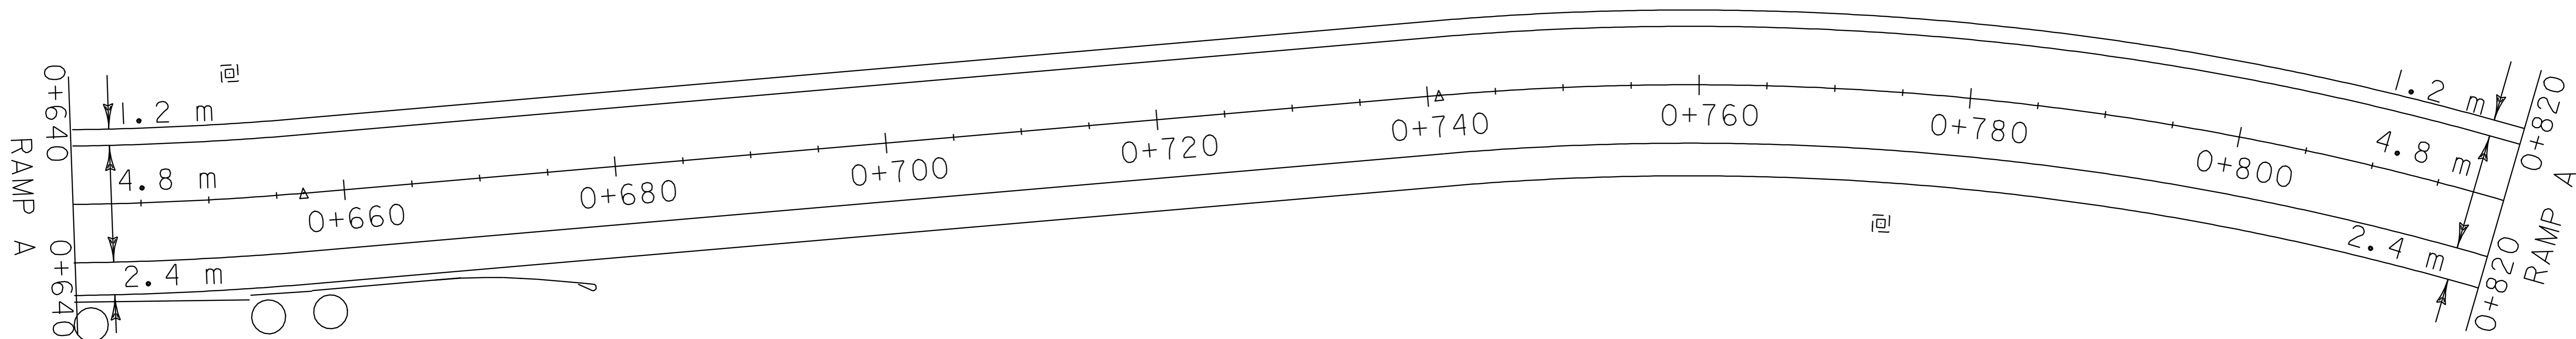


RAMP A

**PAVING
PROJECT
LAYOUT
#19**

PROJECT NAME: BERLIN-BARRE CITY
 PROJECT NUMBER: STP 2321(1)S

FILE NAME: /pave/01b022/pb022.dgn PLOT DATE: 12-MAR-2007 11:0
 PROJECT LEADER: WOOLAVER DRAWN BY: LOCKE
 DESIGNED BY: LOCKE CHECKED BY:
 pb022a19.1 SHEET 31 OF 39

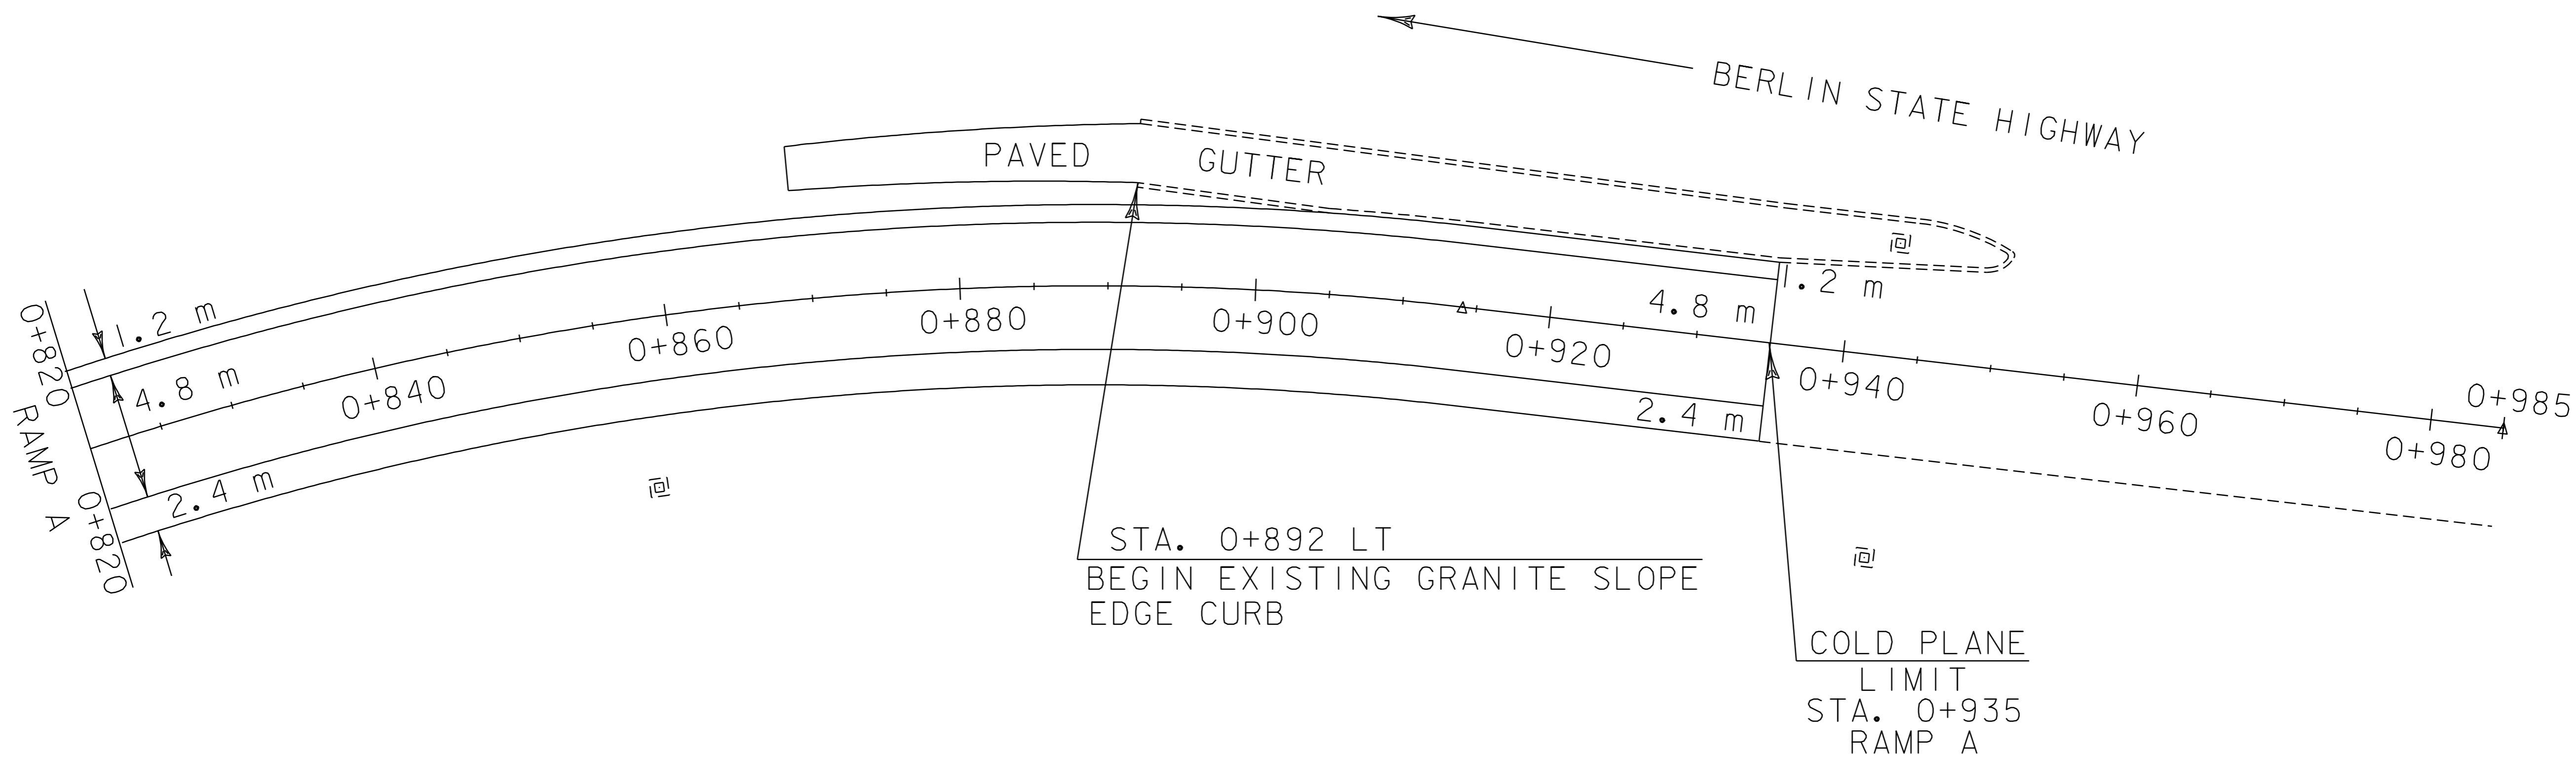

TEMPORARY AND DURABLE 150 mm WHITE LINE
 STA. 0+820 RT. - STA. 0+935 RT. (SOLID)
 STA. 0+820 LT. - STA. 0+935 LT. (SOLID)

BITUMINOUS CONCRETE GUTTERS AND TRAFFIC ISLANDS
 STA. 0+869 LT. - STA. 0+945 LT. 5/18/05

REHABILITATION OF DI'S, CB'S, OR MH'S-CLASS I
 STA. 0+943 LT. CE 5/26/05
 0+945 RT CE 5/26/05

RAMP A

PAVING PROJECT LAYOUT #20	PROJECT NAME: BERLIN-BARRE CITY	
	PROJECT NUMBER: STP 232(I)S	
	FILE NAME: /pave/01b022/pb022.dgn	PLOT DATE: 12-MAR-2007 11:0
PROJECT LEADER: WOOLAVER	DRAWN BY: LOCKE	
DESIGNED BY: LOCKE	CHECKED BY:	
pb0221a20.i	SHEET 32 OF 39	

VEHICLE DETECTOR LOOPS

LAYOUT SHEET	LOOP NO.	LANE	CALL Ø	SIZE (M)	TYPE & NO. TURNS	DELAY OR PRESENCE	INDUCTANCE (µH)		RESISTANCE (OHMS)		LEAKAGE TO GROUND (MEGOHMS)	LOCKING MEMORY
							CALC.	ACT.	CALC.	ACT.		
VT ROUTE 62 - 14	1	LEFT ONLY (VT 62 EAST)		1.8 X 12	QUAD - 2	PRESENCE	367		0.91			NO
VT ROUTE 62 - 14	5	LEFT ONLY (VT 62 WEST)		1.8 X 12	QUAD - 2	PRESENCE	367		0.91			NO
BERLIN STREET	3A	THRU AND LEFT (SOUTH)		1.8 X 12	QUAD - 2	PRESENCE	396		0.85			NO
BERLIN STREET	3B	RIGHT (SOUTH)		1.8 X 1.8	RECT. - 2	PRESENCE	N/A		N/A			NO
BERLIN STREET	3C	THRU AND LEFT (NORTH)		1.8 X 12	QUAD - 2	PRESENCE	448		1.53			NO
BERLIN STREET	3D	RIGHT (NORTH)		1.8 X 1.8	RECT. - 2	PRESENCE	N/A		N/A			NO

NOTES:

THIS PLAN SHEET SHALL ONLY BE USED AS A GUIDE FOR LOOP AND JUNCTION BOX PLACEMENT. THE CONTRACTOR SHALL CONFIRM ALL LOCATIONS IN THE FIELD WITH THE RESIDENT ENGINEER PRIOR TO INSTALLATION.

LOOPS ARE TO BE TERMINATED AT THE JUNCTION BOX WITH A 1M SLACK PER LOOP WIRE, COILED NEATLY WITHIN THE BOX. LOOPS WILL NOT BE CONNECTED TO THE CONTROLLER AT THIS TIME.

ALL BITUMINOUS AREAS TO RECEIVE NEW VEHICLE DETECTOR LOOPS SHALL BE LEVELED WITH TYPE IVS SUPERPAVE BITUMINOUS CONCRETE PAVEMENT AS DIRECTED BY THE RESIDENT ENGINEER PRIOR TO THE INSTALLATION OF THE NEW DETECTOR LOOPS. LOOPS SHALL BE INSTALLED PRIOR TO THE PLACEMENT OF THE WEARING COURSE.


IF WATER VALVES, DROP INLETS OR OTHER OBSTRUCTIONS ARE ENCOUNTERED WITHIN THE AREA OF A PROPOSED LOOP, THE CONTRACTOR SHALL TAKE SPECIAL CARE TO AVOID THE OBSTRUCTION DURING LOOP INSTALLATION. IF LOOP SIZES OR SHAPES ARE TO BE MODIFIED DUE TO OBSTRUCTIONS THE RESIDENT ENGINEER MUST APPROVE LAYOUT PRIOR TO INSTALLATION.

AFTER THE NEW LOOPS ARE INSTALLED, THE INDUCTANCE, RESISTANCE AND LEAKAGE TO GROUND SHALL BE TESTED USING PROPERLY CALIBRATED EQUIPMENT. THE TEST RESULTS SHALL BE COMPARED WITH THE CALCULATED VALUES AND RECORDED ON THE PLANS. ALL LOAD TESTING SHALL BE PERFORMED AS PER VAOT STANDARD E-I72M.

CALCULATED VALUES AT THE JUNCTION BOXES ARE BASED ON DIRECT CONDUIT ROUTING AS SHOWN ON THIS SHEET. ANY JUNCTION BOX MODIFICATION AND/OR RELOCATION PRIOR TO LOOP CONNECTION WILL REQUIRE RECALCULATION OF THESE VALUES.

ALL WORK NOT COVERED BY ITEMS, 678.23 & 678.26 SHALL BE INCIDENTAL TO ITEM 678.22, VEHICLE DETECTOR LOOP. FOR ADDITIONAL DETAILS SEE VAOT STANDARDS E-I72M & E-I73M.

ALL DIMENSIONS IN MILLIMETERS EXCEPT WHERE OTHERWISE INDICATED.

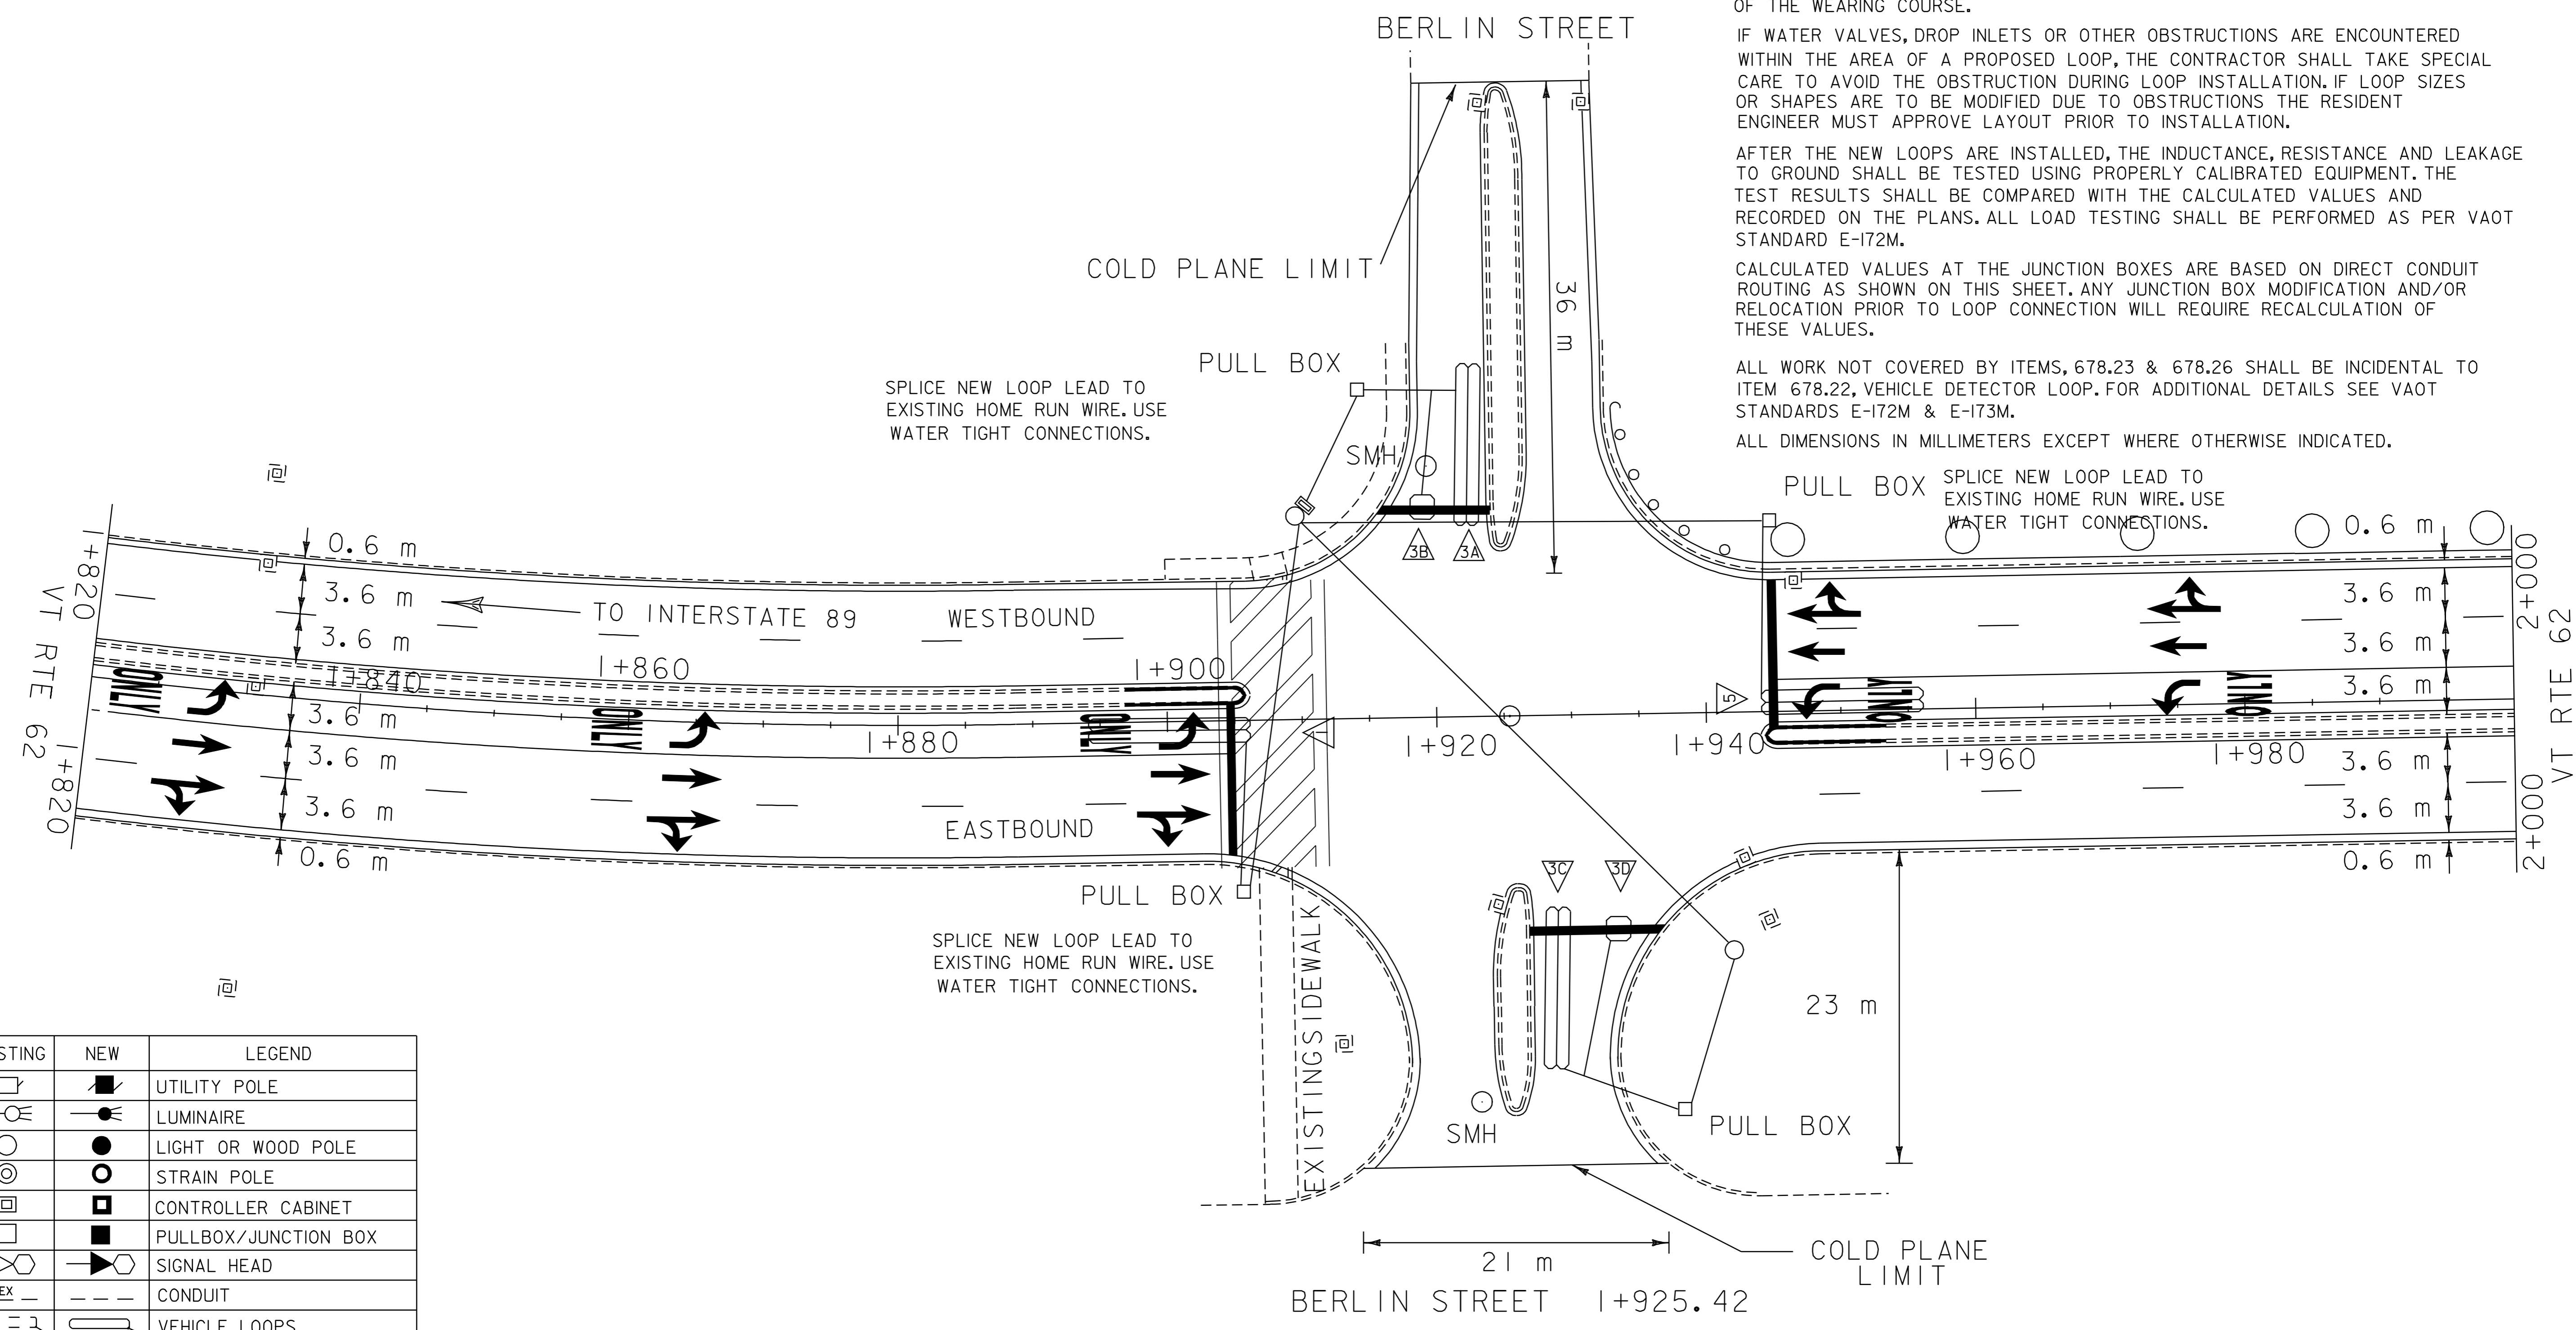



EXISTING	NEW	LEGEND
		UTILITY POLE
		LUMINAIRE
		LIGHT OR WOOD POLE
		STRAIN POLE
		CONTROLLER CABINET
		PULLBOX/JUNCTION BOX
		SIGNAL HEAD
		CONDUIT
		VEHICLE LOOPS
		PEDESTAL POST
		STANCHION
		SWEEP
		LOOP NUMBER

VEHICLE DETECTOR LOOP LAYOUT #2	PROJECT NAME: BERLIN-BARRE CITY	PLOT DATE: 12-MAR-2007 11:0	
	PROJECT NUMBER: STP 232(1)S	DRAWN BY: LOCKE	
	FILE NAME: /pave/01b022/pb022.dgn	DESIGNED BY: GRAY	CHECKED BY:
	DESIGNED BY: GRAY	pb022vdl2.1	SHEET 34 OF 39

KILOMETER MARKER, STATION, OR SIGN NUMBER	SIGN LEGEND	SIGN DIMENSIONS		NEW & SALVAGED SIGNS				EXIST POST RETAIN	SALVAGED	NO. OF POSTS	NEW SIGN POSTS																REQUIRE SIGN	REMARKS	SIGN DETAIL	
		EA	WIDTH (mm)	HEIGHT (mm)	"A"	"B"	SALV SIGN				SALV TIS	FLANGED CHANNEL		SQUARE STEEL (mm)			TUBULAR ALUMINUM Ø (mm)			TUBULAR STEEL Ø (mm)				W-SHAPE STEEL		DETAIL ON SHEET NUMBER			STD. SHEET NUMBER	
												1.7	3.0	4.5	44	50	63	75	100	100 MOD	FOUND-ATION	75	89	100	125					FTG. SIZE
2+505 MED.		1	600	750	0.45					1																	BACK TO BACK		E-144M E-150M E-143M	
		1	450	450	0.20																						BACK TO BACK		E-150M	
2+505 MED.		1	900	750	0.45					1																				E-152M
		1	450	450	0.20																						BACK TO BACK		E-150M	
2+704 RT.		1	900	900	0.68					1																	RETAIN EXISTING FLASHING BEACON		E-150M	
2+320 MED.		1	1200	750	0.50					2																				E-145M
2+395 RT.		1	600	750	0.45					1																				E-144M E-140M E-140M
		1	450	450	0.20																									E-150M
2+460 RT.		1	900	750	0.68					2																				E-145AM
1+945 RT.		1	600	750	0.45					1																				E-144M E-140M
		1	450	450	0.20																									E-150M
4+087 RT.		1	660	450	0.245					1																				E-144M E-150M E-143M
		1	450	450	0.20																									E-150M
2+026 LT.		1	1200	7805	0.56					2																				EE498M
2+504 MED.		1	900	900	0.68					1																				E-150M

FINAL POST LENGTHS ARE TO BE DETERMINED IN THE FIELD. POST SIZES ARE COMPUTED BASED ON INFORMATION FURNISHED ON THE STANDARD SHEETS AND THE TRAFFIC & SAFETY DIVISION'S "SIGN POST DESIGN GUIDELINE."										m		m		m		EA		kg			kg				EA.		kg	
PROJECT TOTALS										2064		m ²		EA.		m ²		EA.		kg			EA.				kg	

PROJECT NAME: BERLIN - BARRE CITY
 PROJECT NUMBER: STP 2321(1)S
 FILE NAME: pave/01b022/pb022.dgn PLOT DATE: 12-MAR-2007 11:0
 PROJECT LEADER: WOOLAVER DRAWN BY: LOCKE
 DESIGNED BY: LOCKE CHECKED BY:
 pb022r34.1 SHEET 38 OF 39

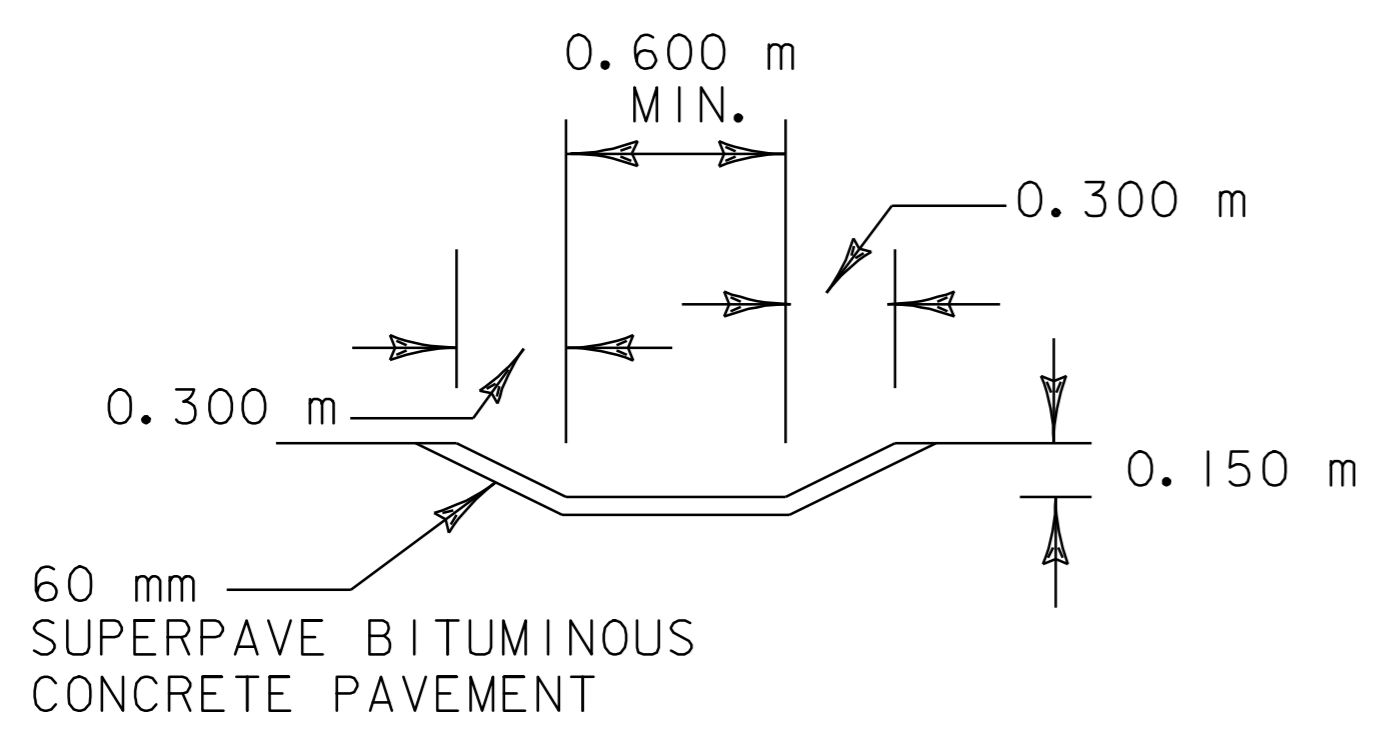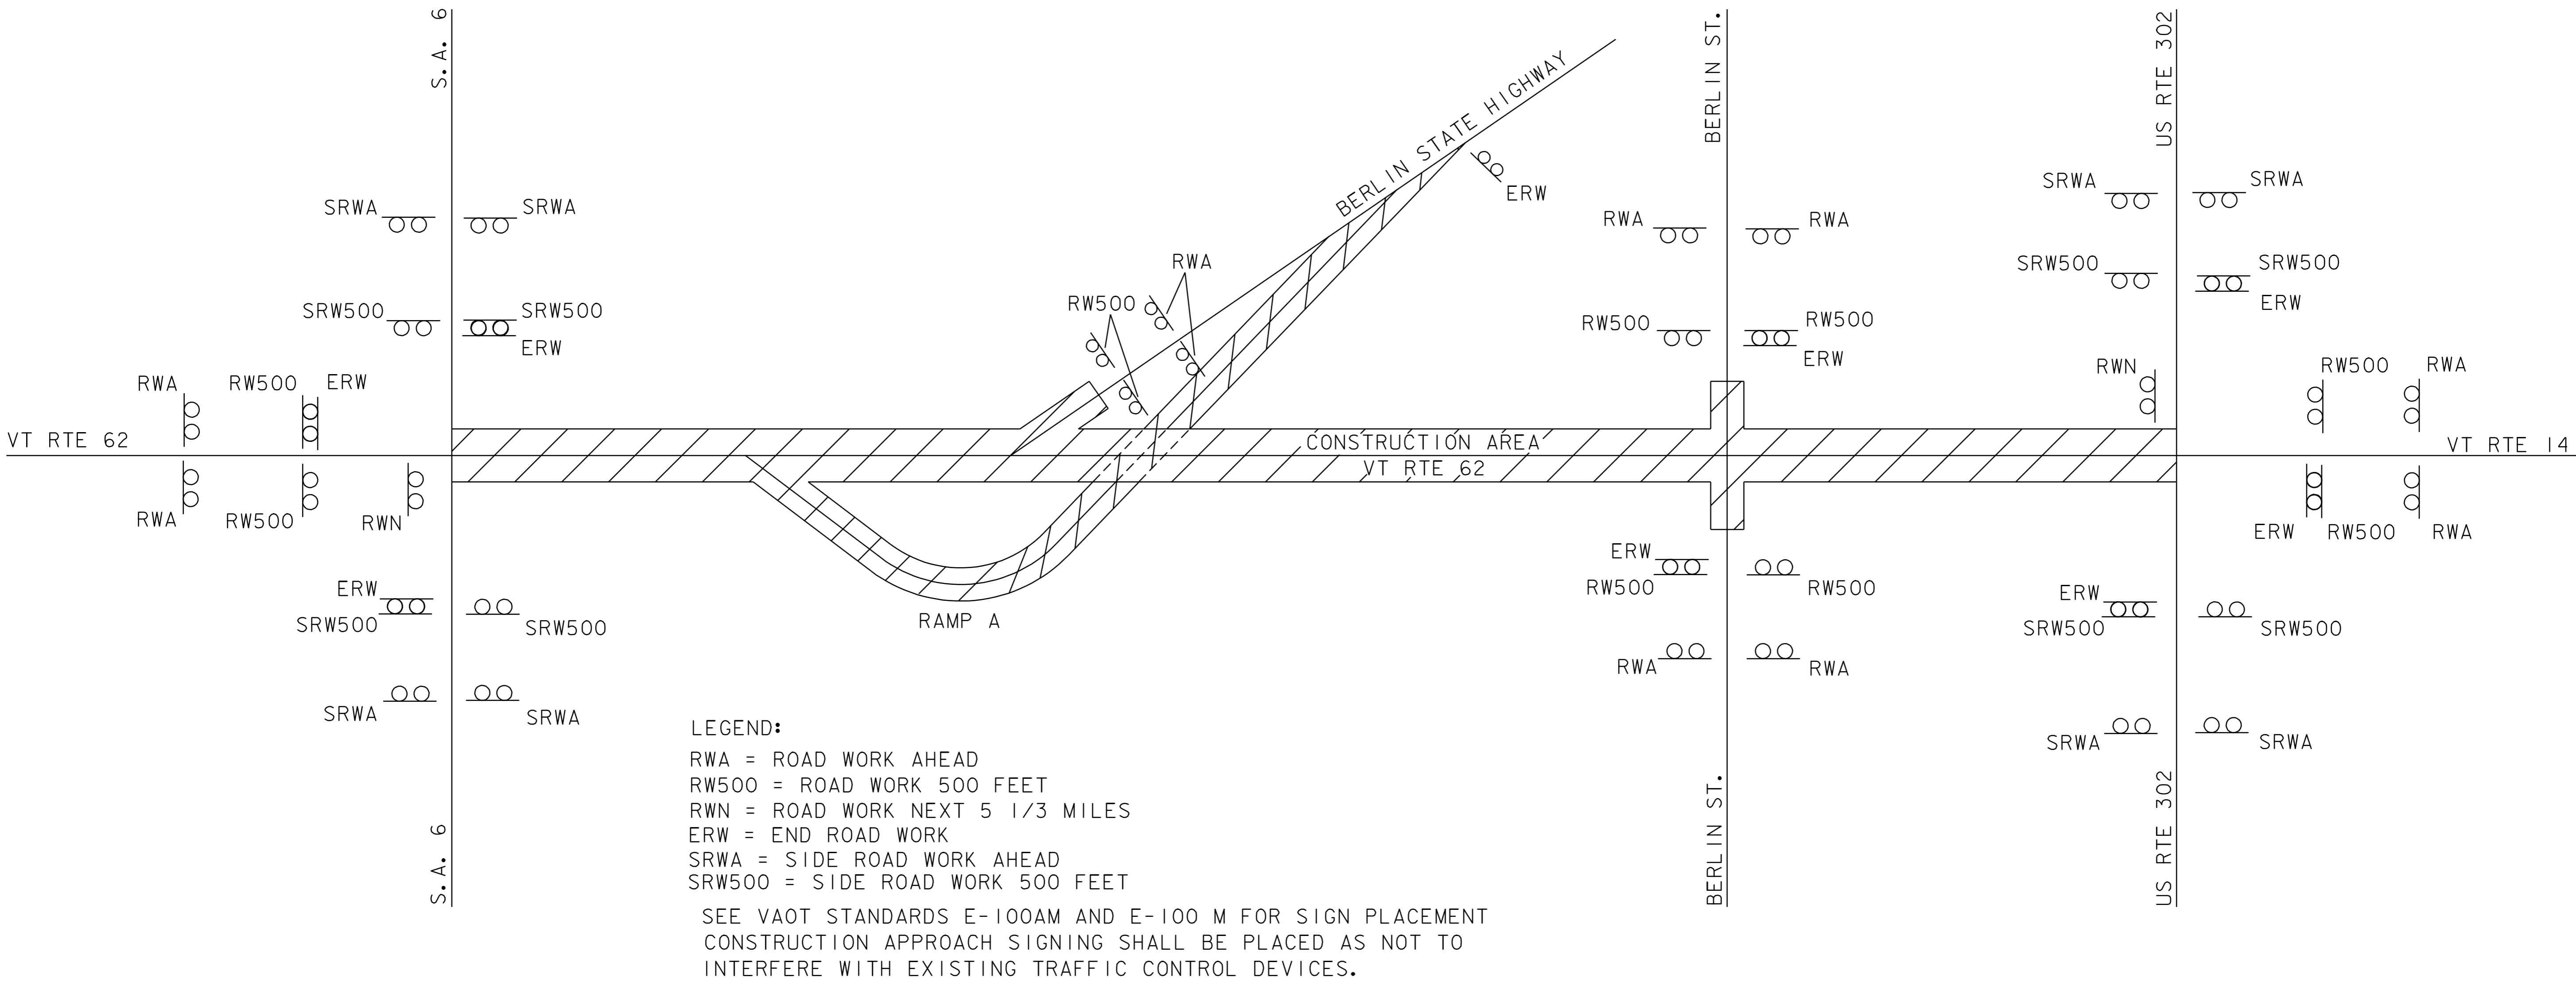

BITUMINOUS CONCRETE GUTTER DETAIL
(AT VARIOUS LOCATIONS PER THE PLANS)

NOT TO SCALE

**CONSTRUCTION
APPROACH SIGNING
&
MISCELLANEOUS DETAILS**

PROJECT NAME: BERLIN-BARRE CITY	PLOT DATE: 12-MAR-2007 11:0
PROJECT NUMBER: STP 232(1)S	DRAWN BY: LOCKE
FILE NAME: /pave/01b022/pb022.dgn	CHECKED BY:
PROJECT LEADER: WOOLLAVER	SHEET 39 OF 39
DESIGNED BY: LOCKE	
pb022cas.1	