

TEMPORARY AND DURABLE 150 mm WHITE LINE
 STA. 4+380 LT. - STA. 0+020 LT. (SOLID)
 STA. 4+380 LT. - STA. 0+020 LT. (DASHED)
 STA. 4+380 RT. - STA. 0+020 RT. (SOLID)
 STA. 4+380 RT. - STA. 0+020 RT. (DASHED)

TEMPORARY AND DURABLE 150 mm YELLOW LINE
 STA. 4+380 LT. - STA. 0+020 LT. (SOLID)
 STA. 4+380 RT. - STA. 0+020 RT. (SOLID)

STONE FILL, TYPE II FOR SLOPE STABILIZATION
 STA. 4+526 RT.
 20 m X 3.5 m GOUGE IN SIDE SLOPE

MAINLINE RT (7.0m)
 COLD PLANED 4/22/05
 +3.7m COLD PLANED 4/25/05
 TO COMPLETE RT LANE

REMOVAL AND DISPOSAL OF GUARDRAIL
 STA. 4+380 LT. - STA. 0+020 LT.
 STA. 4+492 RT. - STA. 4+599 RT.

STEEL BEAM GUARDRAIL
 STA. 4+380 LT. - STA. 0+020 LT.
 STA. 4+503 RT. - STA. 4+595 RT.

MANUFACTURED TERMINAL SECTION (FLARED)
 STA. 4+492 RT. - STA. 4+503 RT.


TRAILING END TERMINAL
 STA. 4+595 RT. - STA. 4+599 RT.

TREATED TIMBER CURB
 STA. 4+380 LT. STA. 0+020 LT.

ANCHOR FOR STEEL BEAM GUARDRAIL
 STA. 4+597 RT.

BARRE - 0+020 TO 4+560 - BERLIN
 COLD PLANED 5m (T-LANE) 4/28/05
 +5.7m 4/29/05

BRIDGE 8 4+546.09
 1375 mm ACCGMP

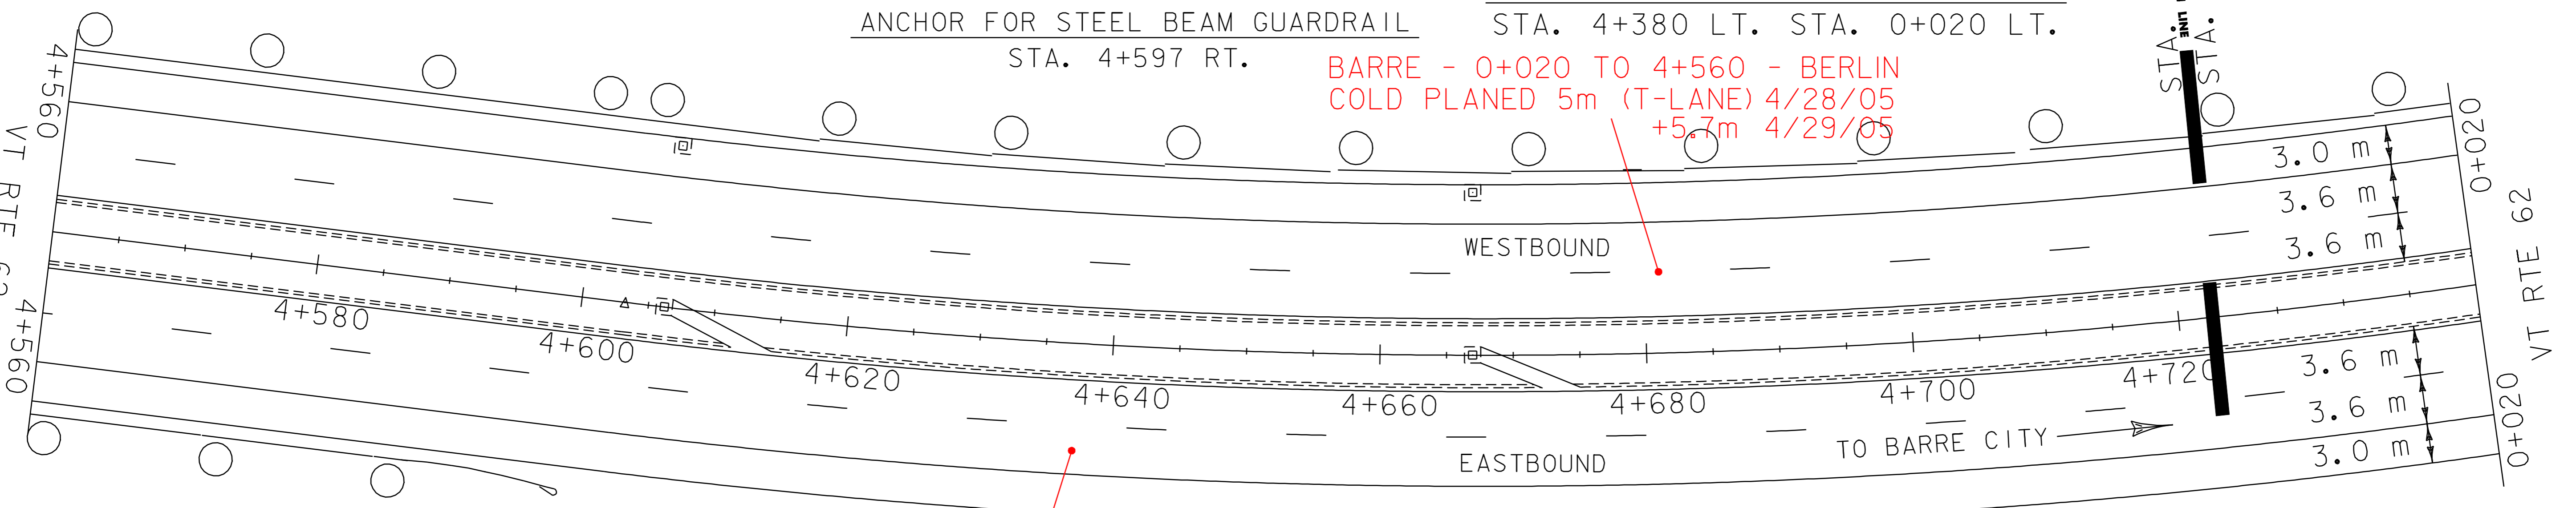

CHANGE ELEVATION OR
 REHABILITATION OF DI'S, CB'S, OR MH'S - CLASS I

STA. 4+472 LT.
 STA. 4+472 MEDIAN
 STA. 4+533 LT.
 STA. 4+533 MEDIAN CE 5/5/05
 STA. 4+606 LT.
 STA. 4+606 MEDIAN CE 5/5/05
 STA. 4+667 LT.
 STA. 4+667 MEDIAN CE 5/5/05

MAINLINE RT (7.0m)
 COLD PLANED 4/22/05
 +3.7m COLD PLANED 4/25/05
 TO COMPLETE RT LANE

BITUMINOUS CONCRETE GUTTERS AND TRAFFIC ISLANDS

STA. 4+533 MEDIAN
 STA. 4+606 MEDIAN
 STA. 4+667 MEDIAN

BERLIN
 MM 2.934
 BARRE CITY
 MM 0.000

**PAVING
 PROJECT
 LAYOUT
 #8**

PROJECT NAME: BERLIN-BARRE CITY	PLOT DATE: 12-MAR-2007 11:09
PROJECT NUMBER: STP 232(I)S	DRAWN BY: LOCKE
FILE NAME: /pave/01b022/pb022.dgn	CHECKED BY:
PROJECT LEADER: WOOLAVER	SHEET 20 OF 39
DESIGNED BY: LOCKE	
pb022a8.i	