

TEMPORARY AND DURABLE 150 mm WHITE LINE
 STA. 0+020 LT. - STA. 0+380 LT. (SOLID)
 STA. 0+020 LT. - STA. 0+380 LT. (DASHED)
 STA. 0+020 RT. - STA. 0+380 RT. (DASHED)
 STA. 0+020 RT. - STA. 0+380 RT. (SOLID)

TEMPORARY AND DURABLE 150 mm YELLOW LINE
 STA. 0+020 LT. - STA. 0+380 LT. (SOLID)
 STA. 0+020 RT. - STA. 0+380 RT. (SOLID)

REMOVAL AND DISPOSAL OF GUARDRAIL
 STA. 0+020 LT. - STA. 0+380 LT.
 STA. 0+217 RT. - STA. 0+292 RT.

ANCHOR FOR STEEL BEAM GUARDRAIL
 STA. 0+290 RT.

STEEL BEAM GUARDRAIL
 STA. 0+020 LT. - STA. 0+380 LT.
 STA. 0+228 RT. - STA. 0+288 RT.

MANUFACTURED TERMINAL SECTION (FLARED)
 STA. 0+217 RT. - STA. 0+228 RT.

TRAILING END TERMINAL
 STA. 0+288 RT. - STA. 0+292 RT.


TREATED TIMBER CURB
 STA. 0+020 LT. - STA. 0+292 LT.

0+351 TO 0+200 LT
 COLD PLANED 5m (T-LANE)
 4/28/05 +5.7m 4/29/05

0+351 TO 0+200 LT
 COLD PLANED 5m (T-LANE)
 4/28/05 +5.7m 4/29/05

MAINLINE RT (7m)
 COLD PLANED 4/22/05 +3.7m COLD PLANED 4/25/05 TO COMPLETE RT LANE

0+380 TO 0+351 LT
 COLD PLANED FULL WIDTH 4/28/05

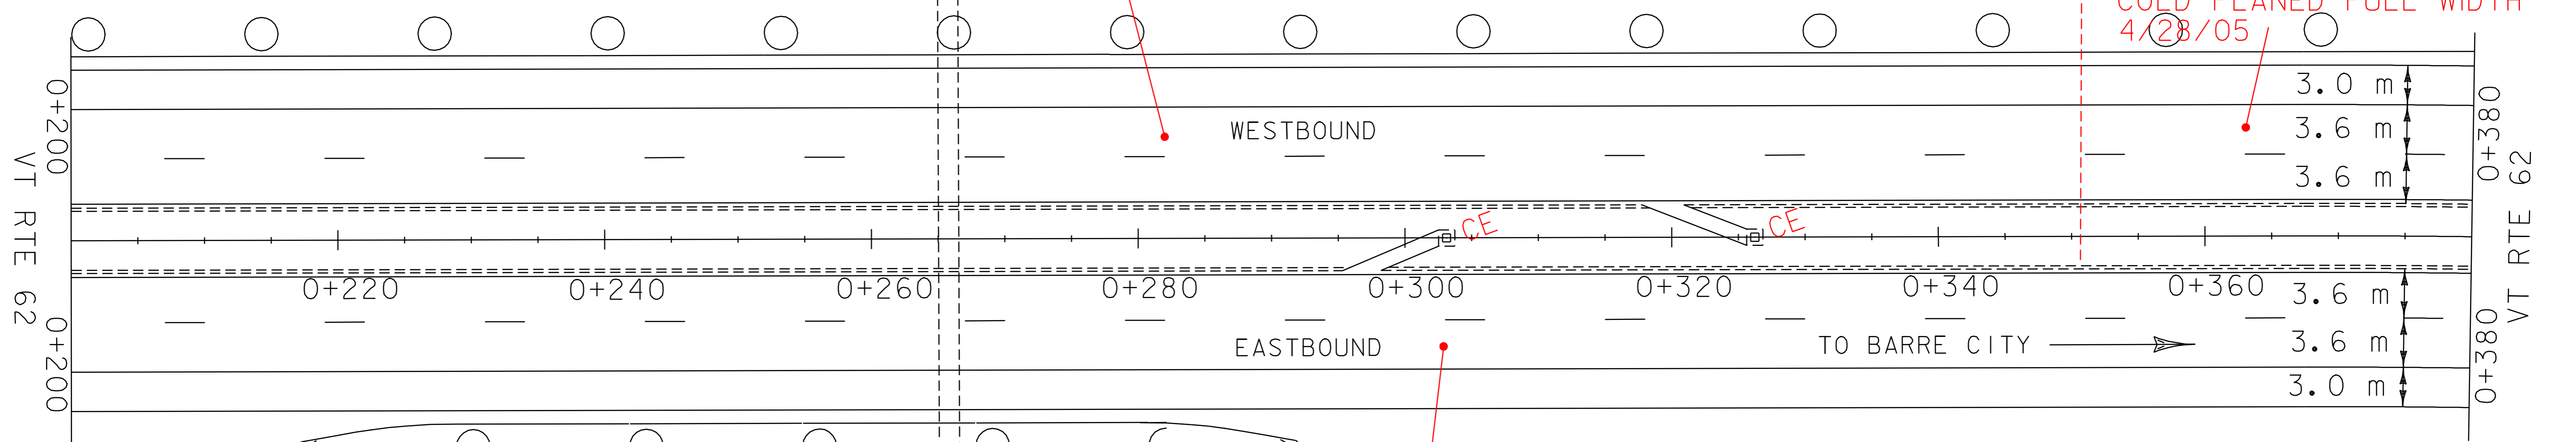

CHANGE ELEVATION OR REHABILITATION OF DI'S, CB'S, OR MH'S - CLASS I

STA. 0+021 LT.
 STA. 0+021 MEDIAN CE 5/5/05
 STA. 0+112 MEDIAN CE 5/5/05
 STA. 0+135 LT.
 STA. 0+188 LT.
 STA. 0+188 MEDIAN CE 5/5/05
 STA. 0+303 MEDIAN CE 5/5/05
 STA. 0+326 MEDIAN CE 5/5/05

BRIDGE 9 0+265.79
 1525 mm ACCGMP

BITUMINOUS CONCRETE GUTTERS AND TRAFFIC ISLANDS

STA. 0+021 MEDIAN
 STA. 0+112 MEDIAN
 STA. 0+188 MEDIAN
 STA. 0+303 MEDIAN
 STA. 0+326 MEDIAN

0+030 RT (DITCH)
 0+120 RT (DITCH)

MAINLINE RT (7m)
 COLD PLANED 4/22/05 +3.7m COLD PLANED 4/25/05 TO COMPLETE RT LANE

PAVING PROJECT LAYOUT #9

PROJECT NAME: BERLIN-BARRE CITY	PLOT DATE: 12-MAR-2007 11:09
PROJECT NUMBER: STP 2321(I)S	DRAWN BY: LOCKE
FILE NAME: /pave/01b022/pb022.dgn	CHECKED BY:
PROJECT LEADER: WOOLLAVER	SHEET 21 OF 39
DESIGNED BY: LOCKE	
pb022a9.i	