

TEMPORARY AND DURABLE 150 mm WHITE LINE  
 STA. 0+380 LT. - STA. 0+740 LT. (SOLID)  
 STA. 0+380 LT. - STA. 0+740 LT. (DASHED)  
 STA. 0+380 RT. - STA. 0+740 RT. (DASHED)  
 STA. 0+380 RT. - STA. 0+740 RT. (SOLID)

TEMPORARY AND DURABLE 150 mm YELLOW LINE  
 STA. 0+380 LT. - STA. 0+740 LT. (SOLID)  
 STA. 0+380 RT. - STA. 0+740 RT. (SOLID)

REMOVAL AND DISPOSAL OF GUARDRAIL

STA. 0+380 LT. - STA. 0+443 LT.  
 STA. 0+534 LT. - STA. 0+740 LT.

STEEL BEAM GUARDRAIL

STA. 0+380 LT. - STA. 0+432 LT.  
 STA. 0+538 LT. - STA. 0+740 LT.

MANUFACTURED TERMINAL SECTION (FLARED)

STA. 0+432 LT. - STA. 0+443 LT.

TRAILING END TERMINAL


STA. 0+534 LT. - STA. 0+538 LT.

ANCHOR FOR STEEL BEAM GUARDRAIL

STA. 0+536 LT.

REHABILITATION OF DI'S, CB'S, OR MH'S-CLASS 1

STA. 0+417 MEDIAN  
 STA. 0+508 MEDIAN  
 STA. 0+569 MEDIAN  
 STA. 0+631 MEDIAN  
 STA. 0+705 MEDIAN

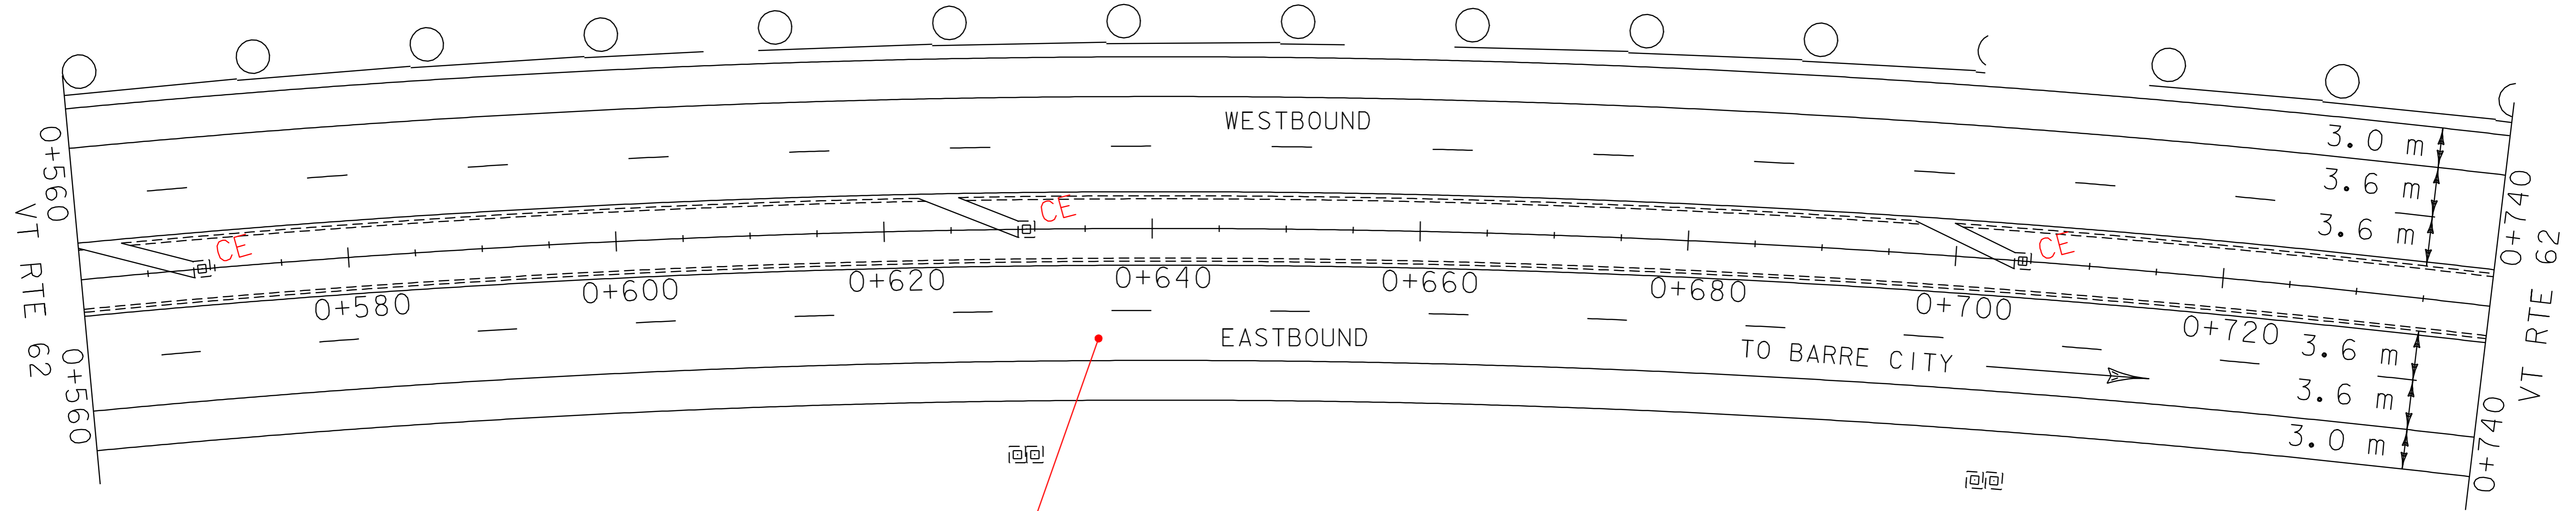

BITUMINOUS CONCRETE GUTTERS AND TRAFFIC ISLANDS

STA. 0+417 MEDIAN CE 5/6/05  
 STA. 0+508 MEDIAN CE 5/6/05  
 STA. 0+569 MEDIAN CE 5/6/05  
 STA. 0+631 MEDIAN CE 5/6/05  
 STA. 0+705 MEDIAN CE 5/6/05

STONE FILL, TYPE II FOR SLOPE STABILIZATION

STA. 0+666 RT.

MAINLINE RT (7.0m)  
 COLD PLANED 4/22/05  
 +3.7m COLD PLANED 4/25/05  
 TO COMPLETE RT LANE

**PAVING  
 PROJECT  
 LAYOUT  
 #10**

PROJECT NAME: BERLIN-BARRE CITY	PLOT DATE: 12-MAR-2007 11:09
PROJECT NUMBER: STP 2321(I)S	DRAWN BY: LOCKE
FILE NAME: /pave/01b022/pb022.dgn	CHECKED BY:
PROJECT LEADER: WOOLLAVER	SHEET 22 OF 39
DESIGNED BY: LOCKE	
pb022al0.i	