

TEMPORARY AND DURABLE 150 mm WHITE LINE  
 STA. 0+740 LT. - STA. 1+100 LT. (SOLID)  
 STA. 0+740 LT. - STA. 1+100 LT. (DASHED)  
 STA. 0+740 RT. - STA. 1+100 RT. (DASHED)  
 STA. 0+740 RT. - STA. 1+100 RT. (SOLID)

TEMPORARY AND DURABLE 150 mm YELLOW LINE  
 STA. 0+740 LT. - STA. 1+100 LT. (SOLID)  
 STA. 0+740 RT. - STA. 1+100 RT. (SOLID)

ANCHOR FOR STEEL BEAM GUARDRAIL  
 STA. 0+906 LT.

REMOVAL AND DISPOSAL OF GUARDRAIL  
 STA. 0+740 LT. - STA. 0+749 LT.  
 STA. 0+904 LT. - STA. 1+100 LT.


MANUFACTURED TERMINAL SECTION (FLARED)  
 STA. 0+740 LT. - STA. 0+751 LT.

TRAILING END TERMINAL  
 STA. 0+904 LT. STA. 0+908 LT.

STEEL BEAM GUARDRAIL  
 STA. 0+908 LT. - STA. 1+100 LT.

REHABILITATION OF DI'S, CB'S, OR MH'S-CLASS I

STA. 0+766 MEDIAN  
 STA. 0+836 MEDIAN  
 STA. 0+919 MEDIAN  
 STA. 0+994 MEDIAN  
 STA. 1+047 MEDIAN

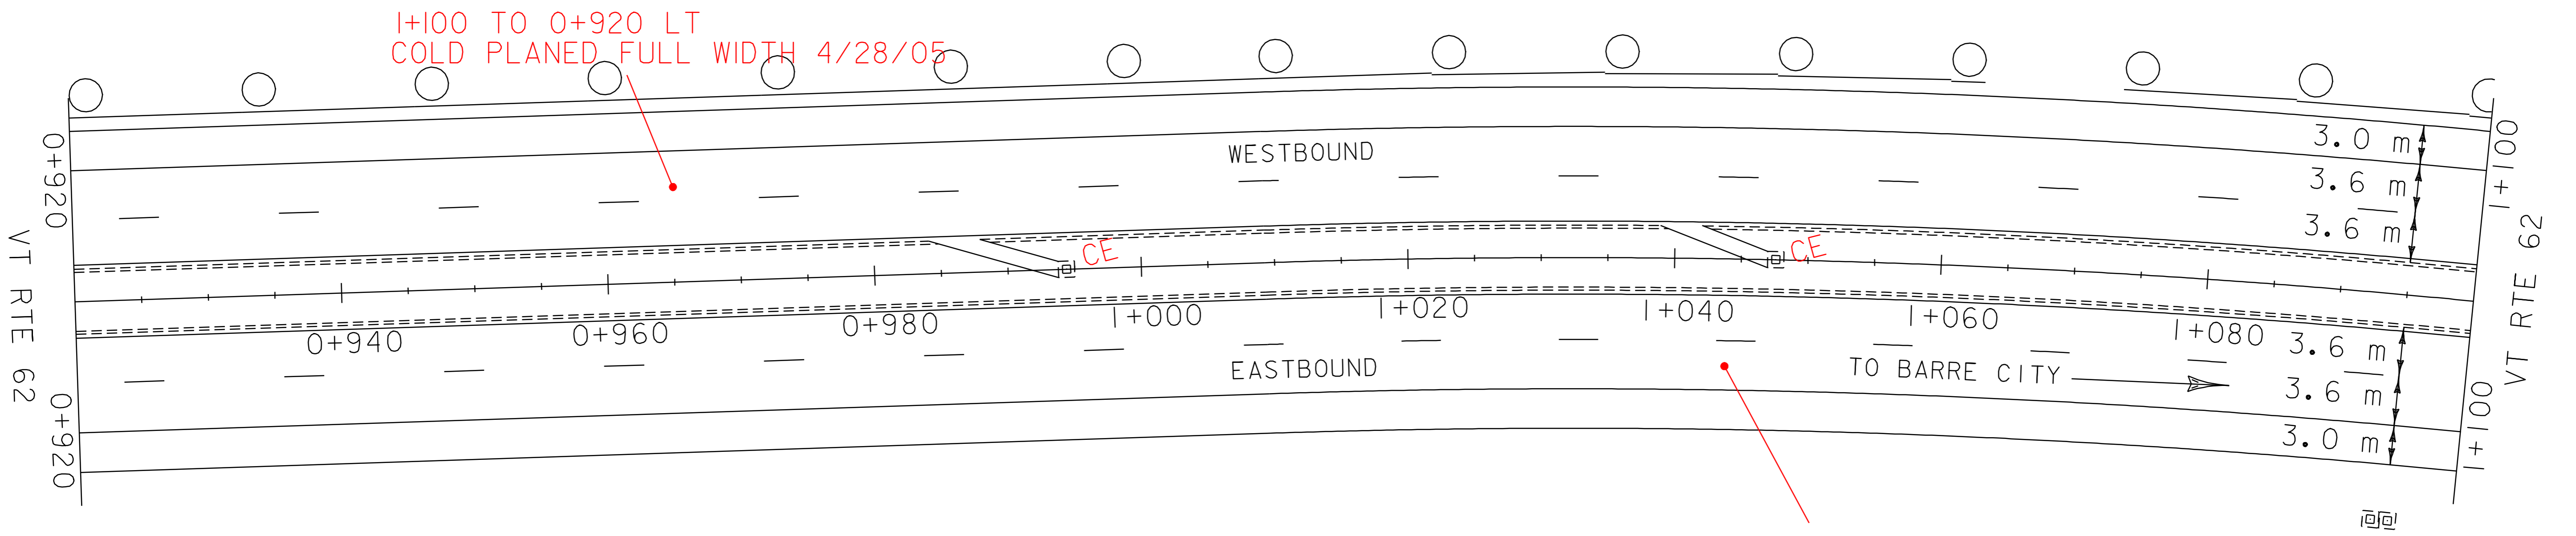

BITUMINOUS CONCRETE GUTTERS AND TRAFFIC ISLANDS

STA. 0+766 MEDIAN  
 STA. 0+836 MEDIAN  
 STA. 0+994 MEDIAN  
 STA. 1+047 MEDIAN

**MAINLINE RT (7.0m)**  
**COLD PLANED 4/22/05**  
**+3.7m COLD PLANED 4/25/05**  
**TO COMPLETE RT LANE**

<b>PAVING PROJECT LAYOUT #11</b>	PROJECT NAME: BERLIN-BARRE CITY	PLOT DATE: 12-MAR-2007 11:09
	PROJECT NUMBER: STP 2321(1)S	DRAWN BY: LOCKE
	FILE NAME: /pave/01b022/pb022.dgn	CHECKED BY:
	DESIGNED BY: LOCKE	SHEET 23 OF 39