

1+280 TO 1+100 LT
COLD PLANED FULL WIDTH
4/28/05

MAINLINE RT (7.0m)
COLD PLANED 4/22/05

TEMPORARY AND DURABLE 150 mm WHITE LINE
 STA. 1+100 LT. - STA. 1+460 LT. (SOLID)
 STA. 1+100 LT. - STA. 1+460 LT. (DASHED)
 STA. 1+100 RT. - STA. 1+460 RT. (DASHED)
 STA. 1+100 RT. - STA. 1+460 RT. (SOLID)
 TEMPORARY AND DURABLE 150 mm YELLOW LINE
 STA. 1+100 LT. - STA. 1+460 LT. (SOLID)
 STA. 1+100 RT. - STA. 1+460 RT. (SOLID)

REMOVAL AND DISPOSAL OF GUARDRAIL
 STA. 1+100 LT. - STA. 1+330 LT.


STEEL BEAM GUARDRAIL
 STA. 1+100 LT. - STA. 1+319 LT.

MANUFACTURED TERMINAL SECTION (FLARED)
 STA. 1+319 LT. - STA. 1+330 LT.

BITUMINOUS CONCRETE GUTTERS AND TRAFFIC ISLANDS
 STA. 1+101 MEDIAN
 STA. 1+154 MEDIAN
 STA. 1+206 MEDIAN
 STA. 1+268 MEDIAN

REHABILITATION OF DI'S, CB'S, OR MH'S-CLASS I
 STA. 1+101 MEDIAN
 STA. 1+154 MEDIAN
 STA. 1+206 MEDIAN
 STA. 1+268 MEDIAN
 STA. 1+338 MEDIAN
 STA. 1+390 MEDIAN
 STA. 1+451 MEDIAN

+3.7m COLD PLANED 4/25/05
 TO COMPLETE RT LANE
 1+460 TO 1+424 LT
 COLD PLANED FULL WIDTH
 4/27/05

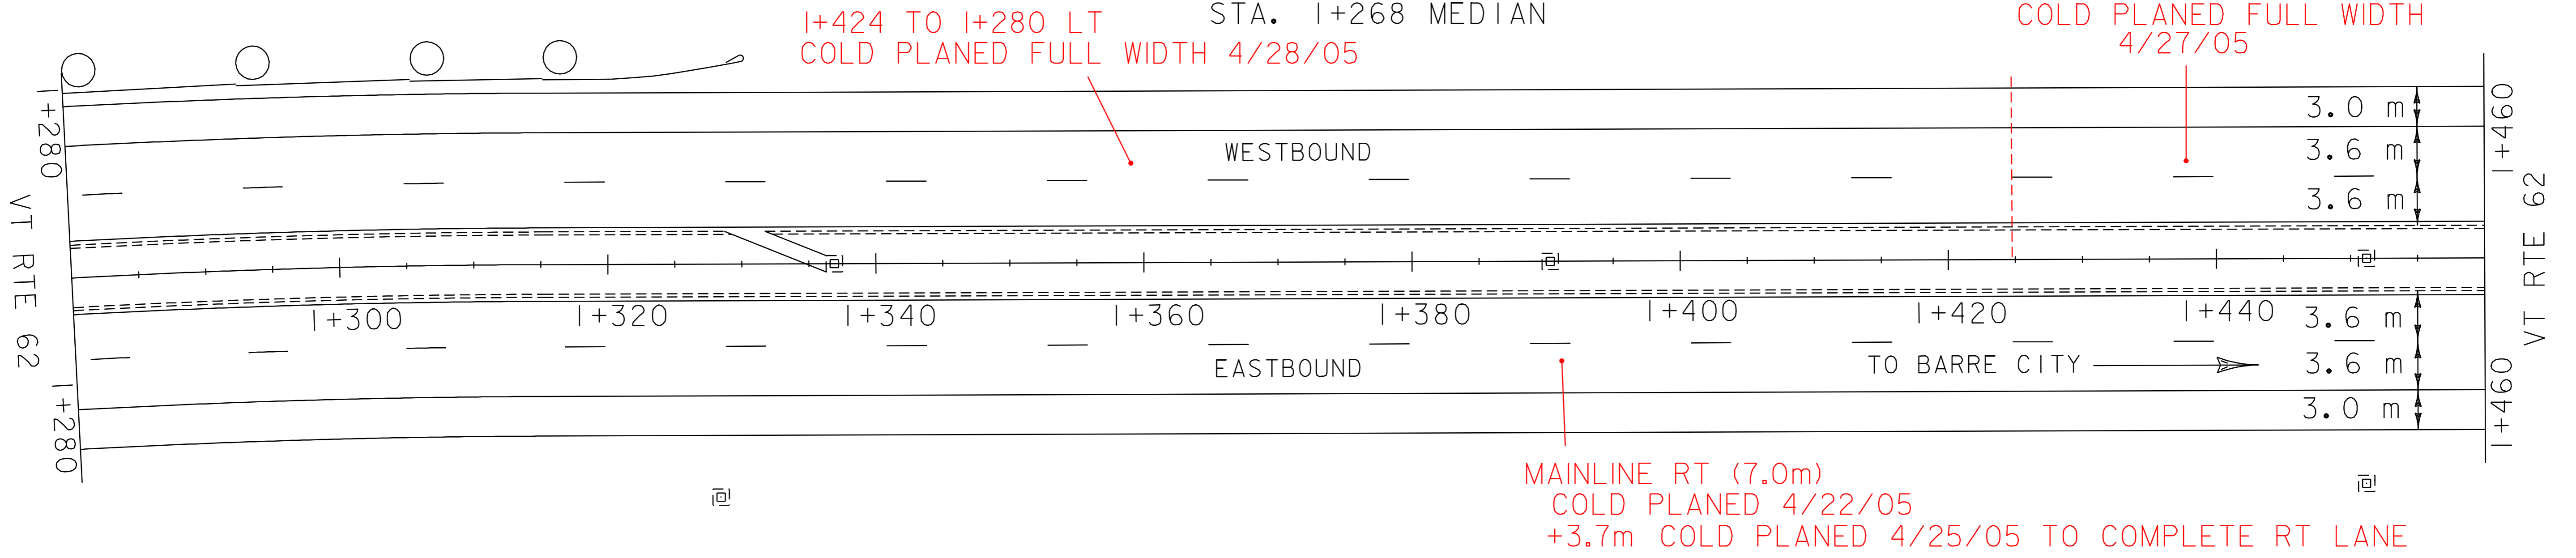

1+424 TO 1+280 LT
COLD PLANED FULL WIDTH 4/28/05

MAINLINE RT (7.0m)
COLD PLANED 4/22/05
+3.7m COLD PLANED 4/25/05 TO COMPLETE RT LANE

**PAVING
PROJECT
LAYOUT
#12**

PROJECT NAME: BERLIN-BARRE CITY	PLOT DATE: 12-MAR-2007 11:09
PROJECT NUMBER: STP 232(I)S	DRAWN BY: LOCKE
FILE NAME: /pave/01b022/pb022.dgn	CHECKED BY:
PROJECT LEADER: WOOLLAVER	SHEET 24 OF 39
DESIGNED BY: LOCKE	
pb022al2.1	