


REMOVAL AND DISPOSAL OF GUARDRAIL
 STA. 1+501 LT. - STA. 1+640 LT.
 ANCHOR FOR STEEL BEAM GUARDRAIL
 STA. 1+503 LT.

MANUFACTURED TERMINAL SECTION (FLARED)
 STA. 1+629 LT. - STA. 1+640 LT.

TRAILING END TERMINAL
 STA. 1+501 LT. - STA. 1+505 LT.




STEEL BEAM GUARDRAIL
 STA. 1+505 LT. - STA. 1+629 LT.

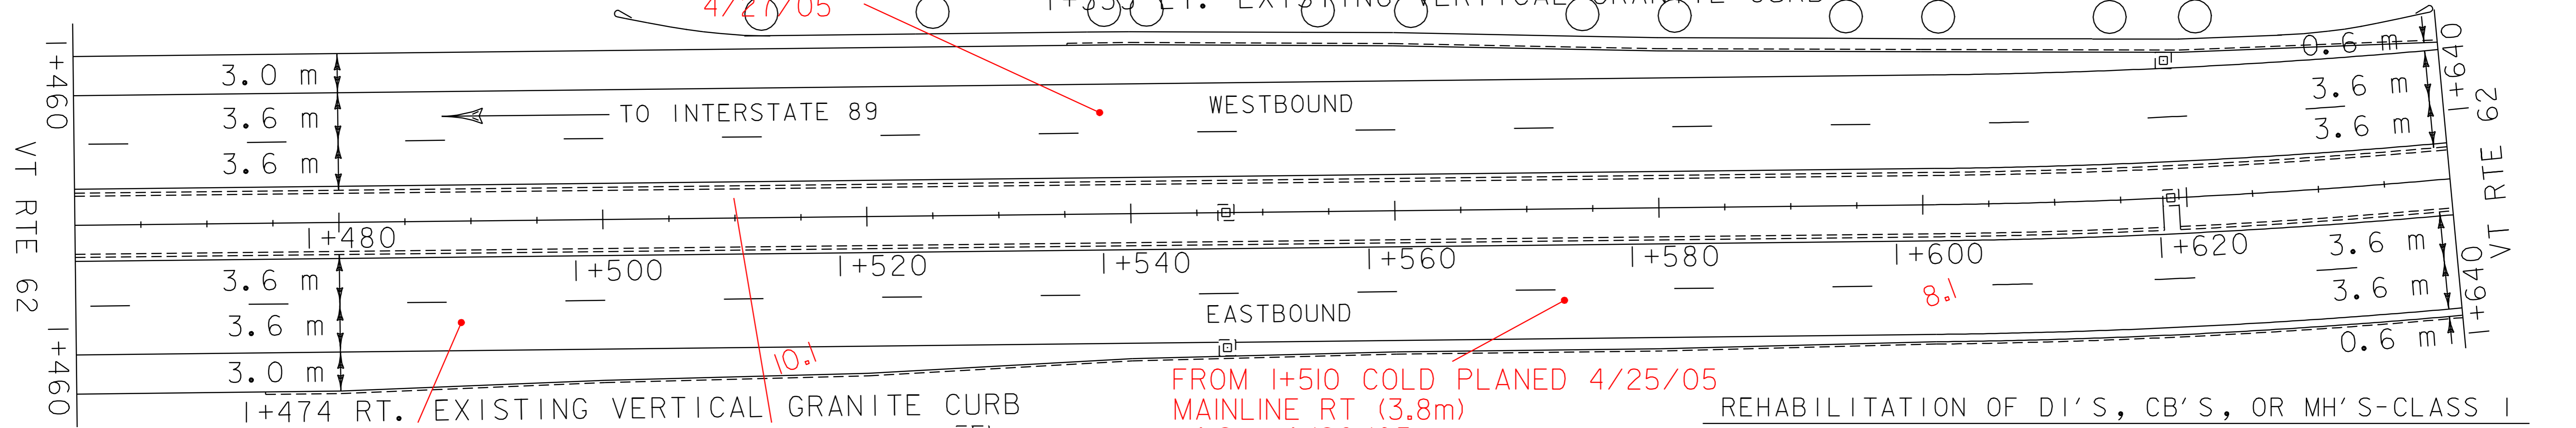




- TEMPORARY AND DURABLE 150 mm WHITE LINE
 STA. 1+460 LT. - STA. 1+820 LT. (SOLID)
 STA. 1+460 LT. - STA. 1+820 LT. (DASHED)
 STA. 1+460 RT. - STA. 1+820 RT. (DASHED)
 STA. 1+460 RT. - STA. 1+820 RT. (SOLID)
 STA. 1+765 RT. - STA. 1+820 RT. (DOTTED)
- TEMPORARY AND DURABLE 150 mm YELLOW LINE
 STA. 1+460 LT. - STA. 1+820 LT. (SOLID)
 STA. 1+460 RT. - STA. 1+780 RT. (SOLID)
 STA. 1+780 LT. - STA. 1+820 LT. (SOLID)

- TEMPORARY AND DURABLE LETTERS OR SYMBOLS
 STA. 1+711 RT. (SIGNAL - 2 EACH)
 STA. 1+723 RT. (AHEAD - 2 EACH)
- BITUMINOUS CONCRETE GUTTERS AND TRAFFIC ISLANDS
 STA. 1+619 MEDIAN
 STA. 1+695 MEDIAN
 STA. 1+756 MEDIAN (1 NEW, 1 EXISTING)
- REMOVAL OF EXISTING CURB
 STA. 1+756 MED. (FOR CONSTRUCTION OF NEW GUTTER)

NOTE: REMOVE SAND BUILD UP ON MEDIAN ISLAND
 STA. 1+780 - STA. 1+820. TO BE PAID FOR
 WITH APPLICABLE RENTAL ITEMS.

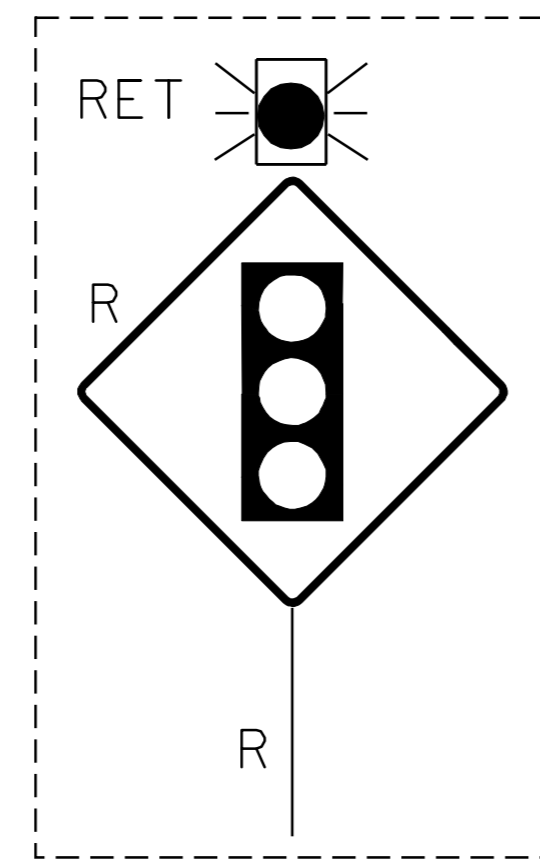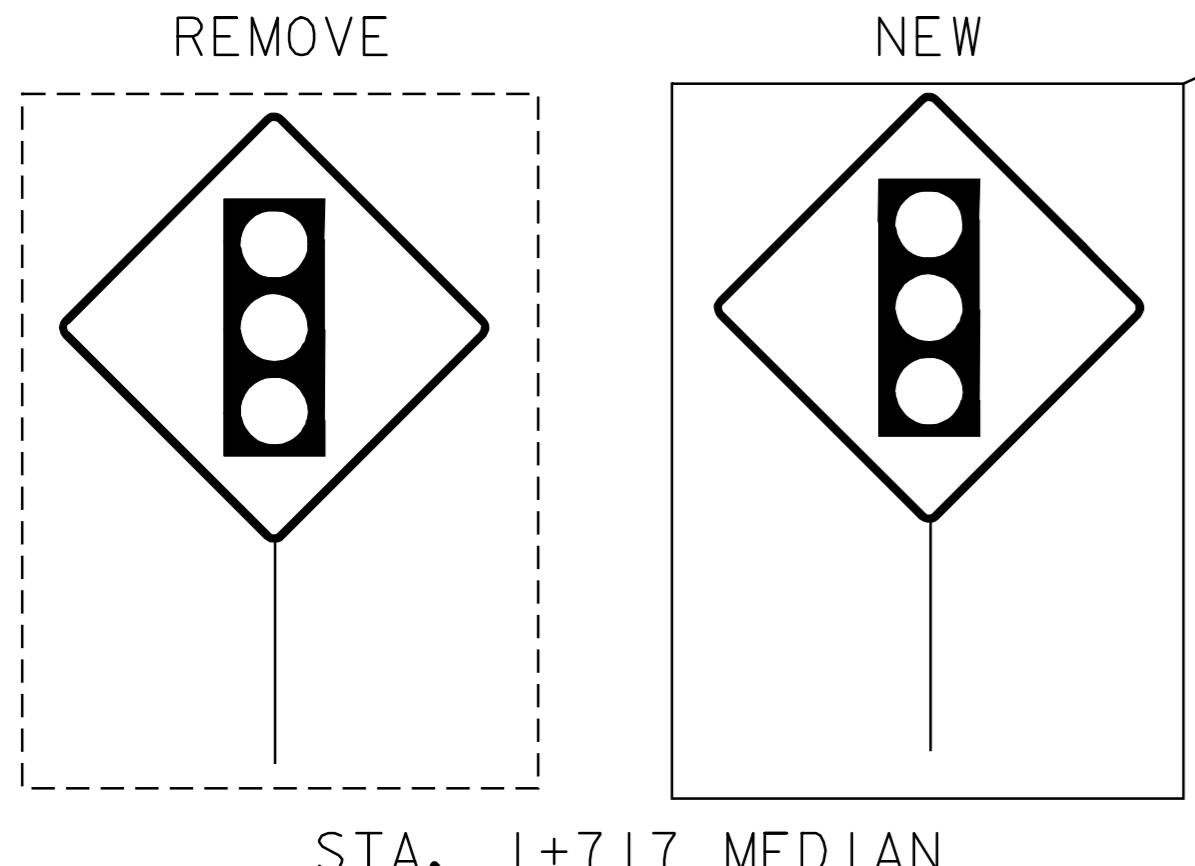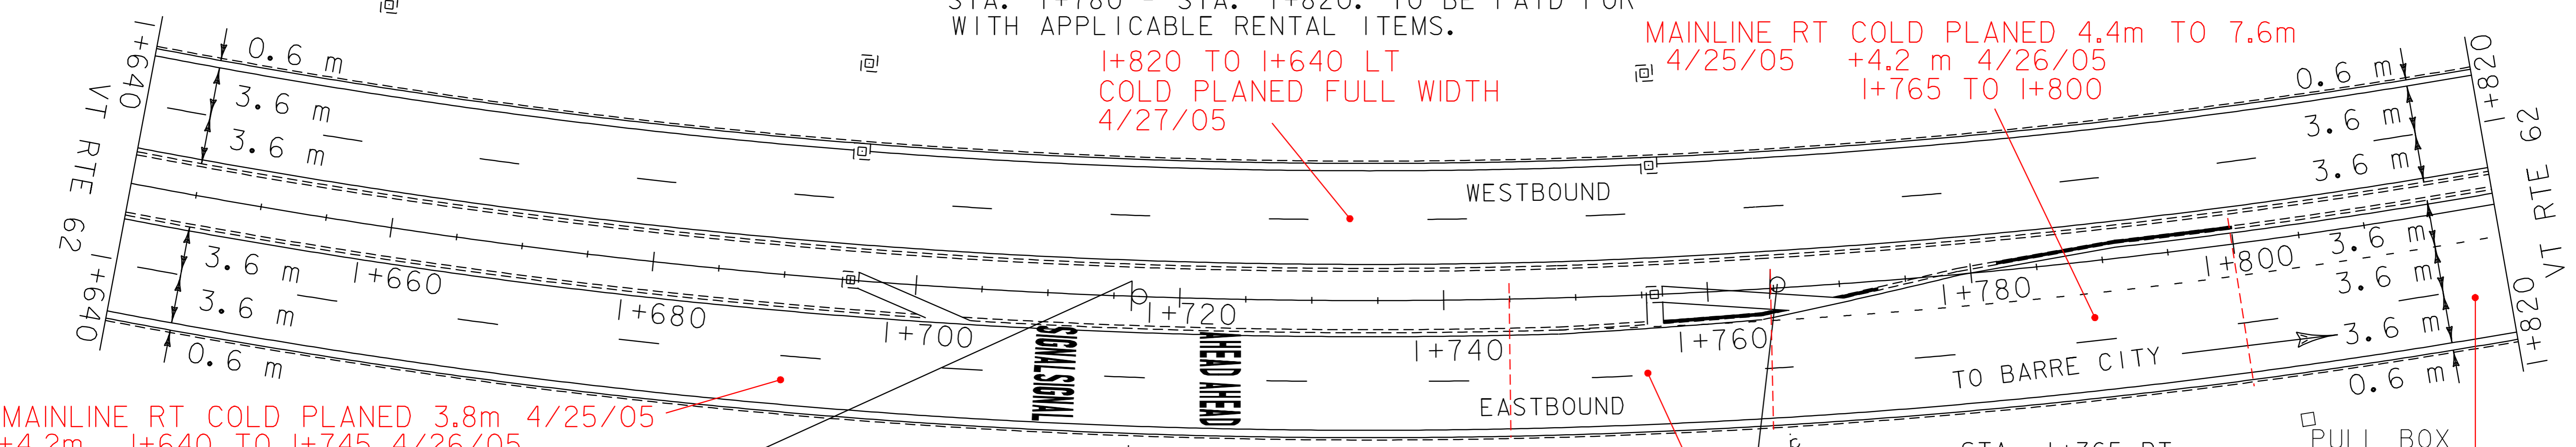

STA. 1+717 RT.
 REMOVE EXISTING
 SIGN AND POST.
 REPLACE W/NEW
 SIGN AND POST.
 RETAIN EXISTING
 FLASHING BEACON.

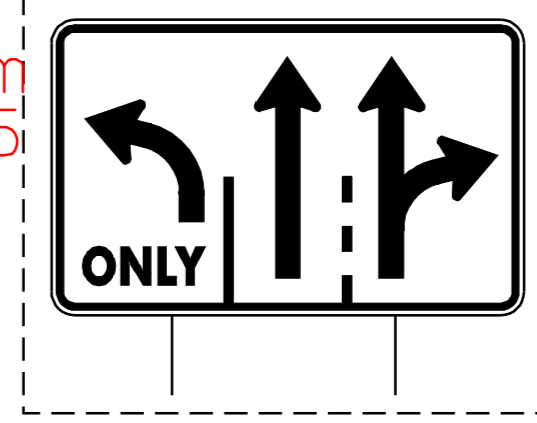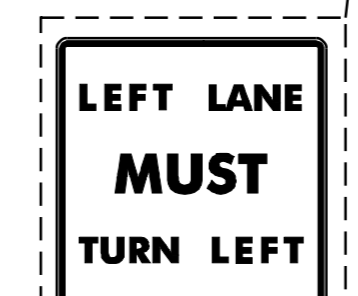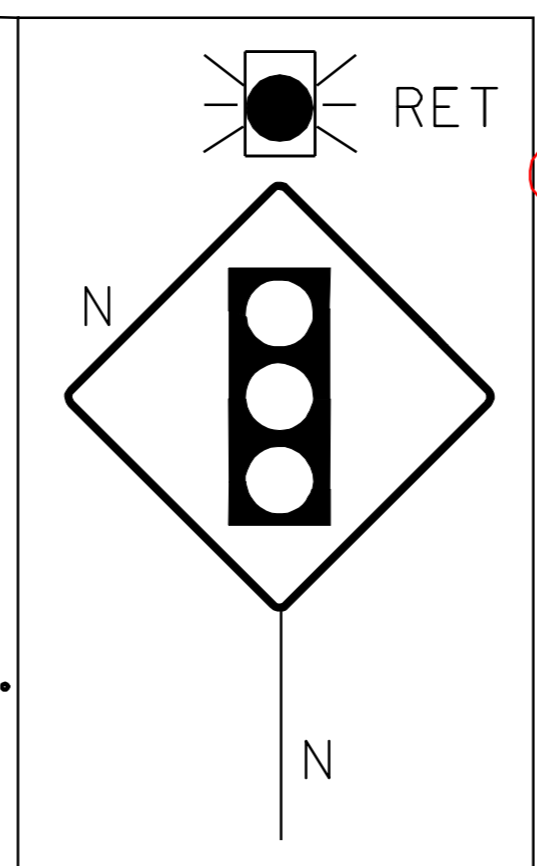

PAVING
 PROJECT
 LAYOUT
 #13

PROJECT NAME: BERLIN-BARRE CITY	PLOT DATE: 12-MAR-2007 11:09
PROJECT NUMBER: STP 232(I)S	DRAWN BY: LOCKE
FILE NAME: /pave/01b022/pb022.dgn	CHECKED BY:
PROJECT LEADER: WOOLAVER	SHEET 25 OF 39
DESIGNED BY: LOCKE	
pb0221a13.1	