

TEMPORARY AND DURABLE 150 mm WHITE LINE
 STA. 1+820 LT. - STA. 1+919 LT. (SOLID)
 STA. 1+931 LT. - STA. 2+000 LT. (SOLID)
 STA. 1+820 LT. - STA. 1+905 LT. (DASHED)
 STA. 1+945 LT. - STA. 2+000 LT. (DASHED)
 STA. 1+820 RT. - STA. 1+822 RT. (DOTTED)
 STA. 1+822 RT. - STA. 1+905 RT. (SOLID)
 STA. 1+945 LT. - STA. 2+000 LT. (SOLID)
 STA. 1+820 RT. - STA. 1+905 RT. (DASHED)
 STA. 1+945 RT. - STA. 2+000 RT. (DASHED)
 STA. 1+820 RT. - STA. 1+919 RT. (SOLID)
 STA. 1+932 RT. - STA. 2+000 RT. (SOLID)






TEMPORARY AND DURABLE 600 mm STOP BAR
 STA. 1+905 LT. - RT.
 STA. 1+920 LT. (BERLIN STREET)
 STA. 1+930 RT. (BERLIN STREET)
 STA. 1+945 RT. - LT.

REMOVAL AND DISPOSAL OF GUARDRAIL
 STA. 1+933 LT. - STA. 2+000 LT.
TRAILING END TERMINAL
 STA. 1+933 LT. - STA. 1+935 LT.
ANCHOR FOR STEEL BEAM GUARDRAIL
 STA. 1+934 LT.
STEEL BEAM GUARDRAIL
 STA. 1+935 LT. - STA. 2+000 LT.

TEMPORARY AND DURABLE 150 mm YELLOW LINE
 STA. 1+820 LT. - STA. 1+907 LT. (SOLID - AROUND MEDIAN ISLAND)
 STA. 1+944 RT. - STA. 2+000 RT. (SOLID - AROUND MEDIAN ISLAND)
 STA. 1+925 LT (AROUND ISLAND-BERLIN STREET)
 STA. 1+926 RT (AROUND ISLAND-BERLIN STREET)

PAINTED CURB
 STA. 1+897 LT. - STA. 1+906 LT. BERLIN STREET
 STA. 1+945 LT. - STA. 1+954 LT.


NOTE:
 REMOVE SAND BUILD UP ON MEDIAN ISLAND STA. 1+820 LT. - STA. 1+906 LT. TO BE PAID FOR WITH APPLICABLE RENTAL ITEMS.

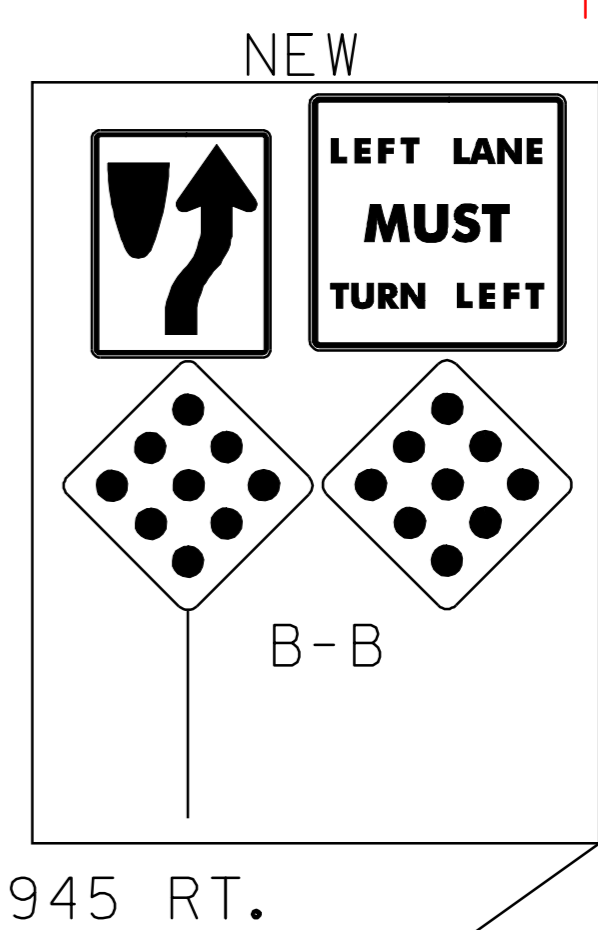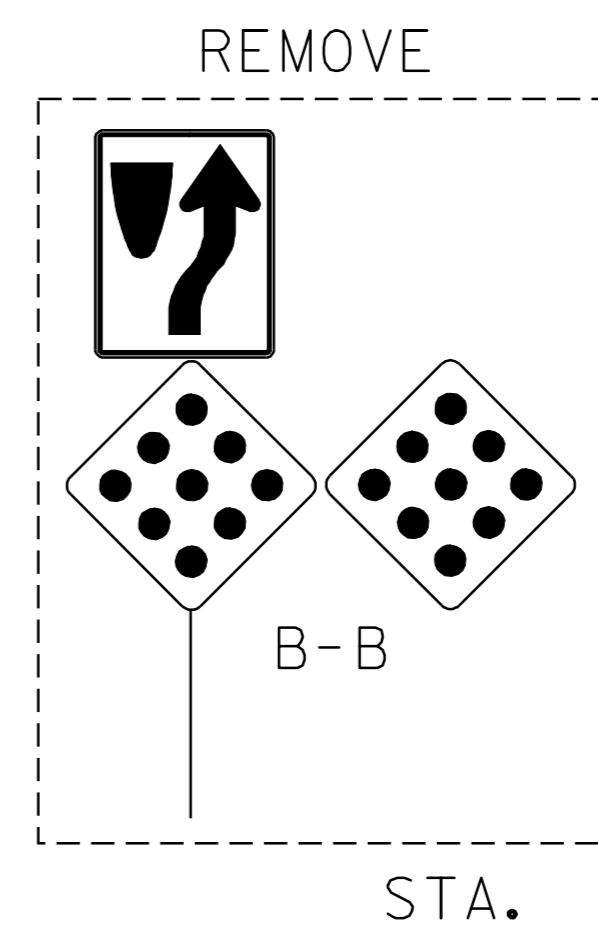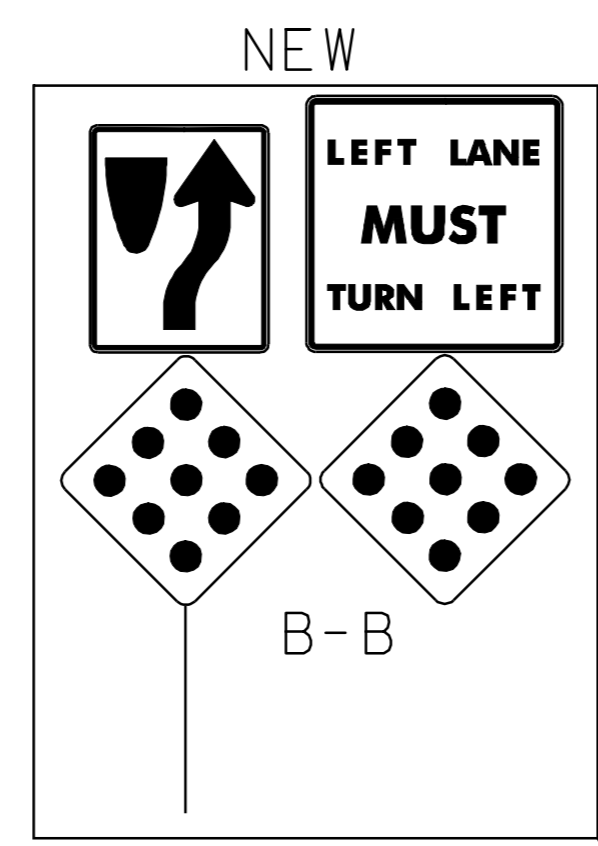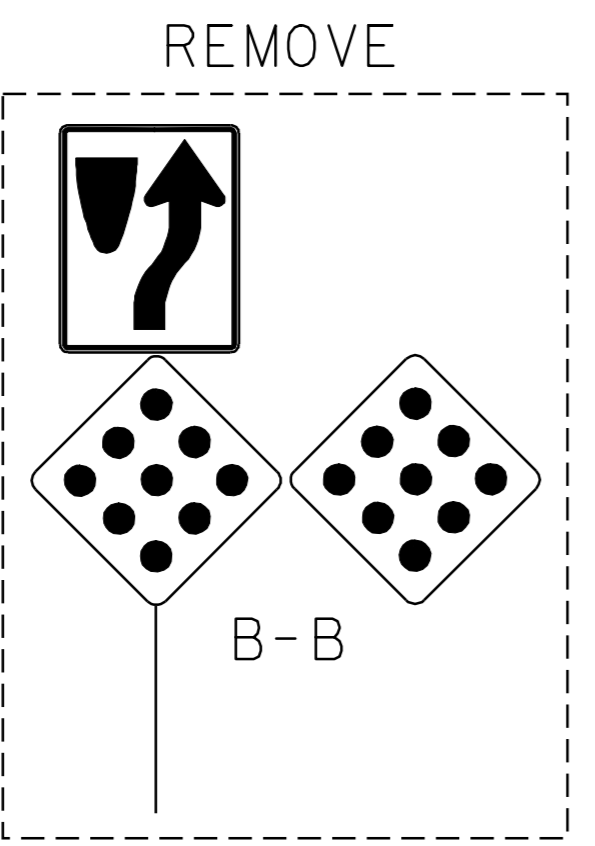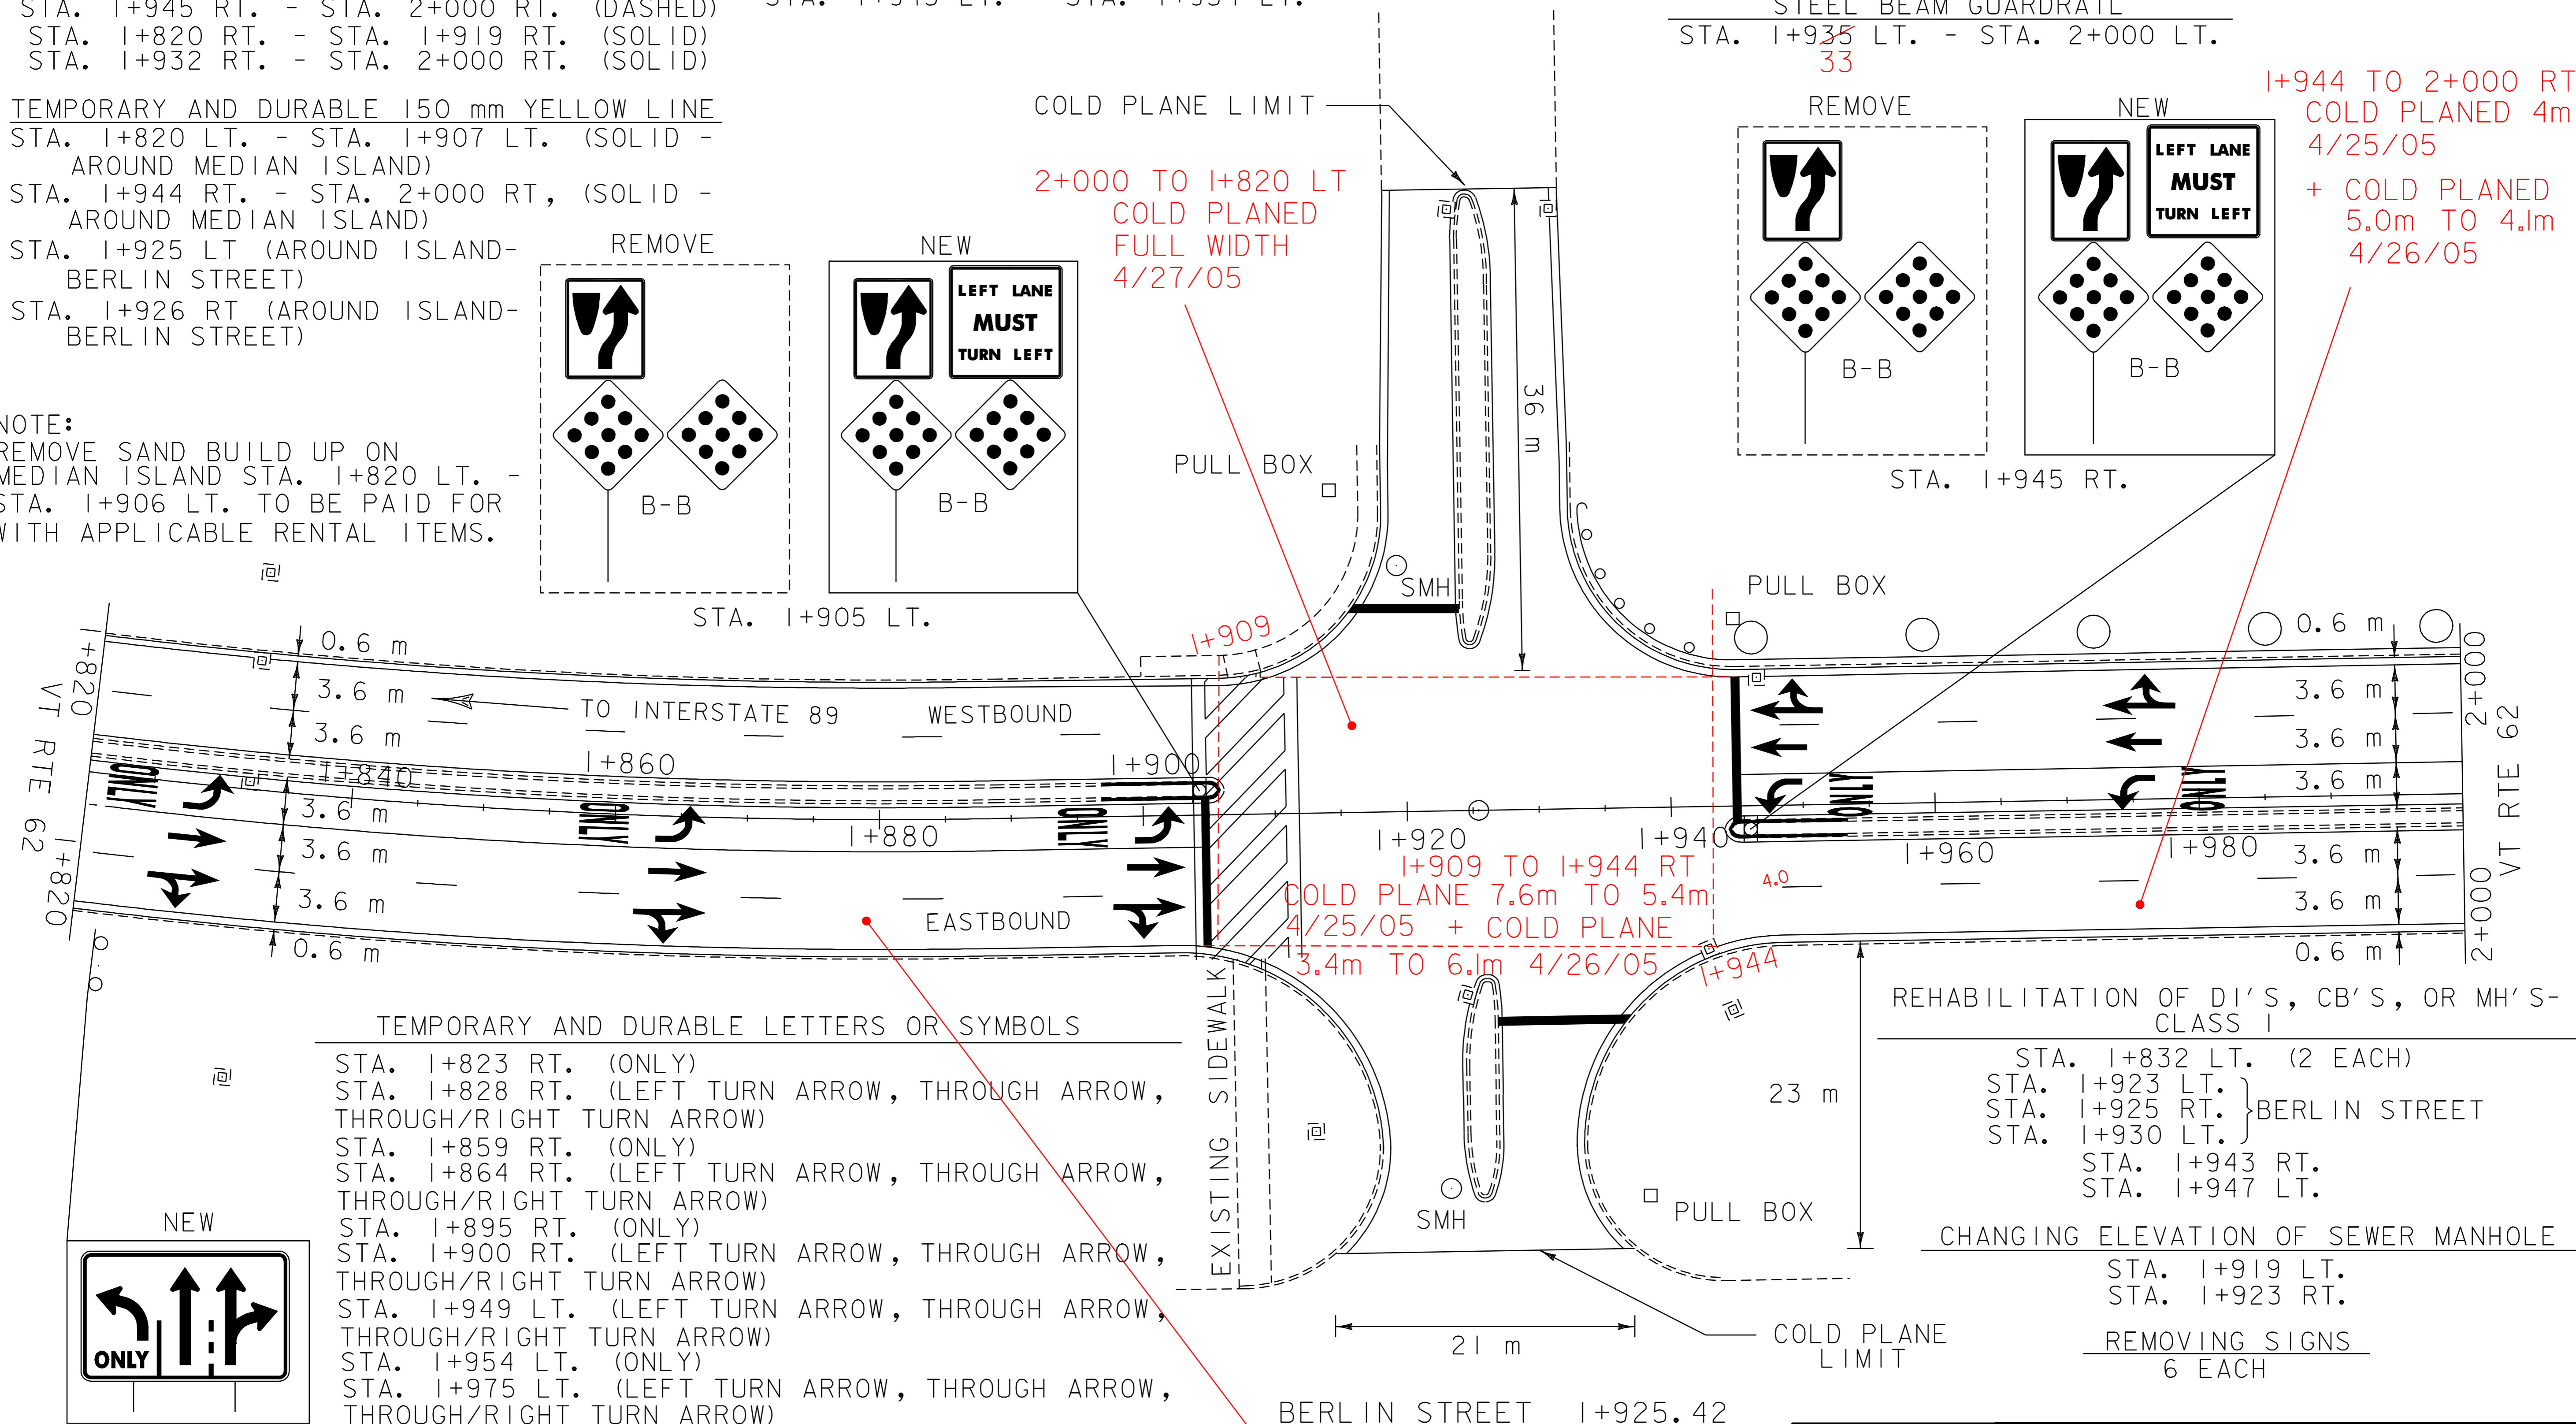

I+944 TO 2+000 RT
 COLD PLANED 4m
 4/25/05
 + COLD PLANED
 5.0m TO 4.1m
 4/26/05

I+909 TO I+944 RT
 COLD PLANE 7.6m TO 5.4m
 4/25/05 + COLD PLANE
 3.4m TO 6.1m 4/26/05

TEMPORARY AND DURABLE LETTERS OR SYMBOLS
 STA. 1+823 RT. (ONLY)
 STA. 1+828 RT. (LEFT TURN ARROW, THROUGH ARROW, THROUGH/RIGHT TURN ARROW)
 STA. 1+859 RT. (ONLY)
 STA. 1+864 RT. (LEFT TURN ARROW, THROUGH ARROW, THROUGH/RIGHT TURN ARROW)
 STA. 1+895 RT. (ONLY)
 STA. 1+900 RT. (LEFT TURN ARROW, THROUGH ARROW, THROUGH/RIGHT TURN ARROW)
 STA. 1+949 LT. (LEFT TURN ARROW, THROUGH ARROW, THROUGH/RIGHT TURN ARROW)
 STA. 1+954 LT. (ONLY)
 STA. 1+975 LT. (LEFT TURN ARROW, THROUGH ARROW, THROUGH/RIGHT TURN ARROW)
 STA. 1+980 LT. (ONLY)

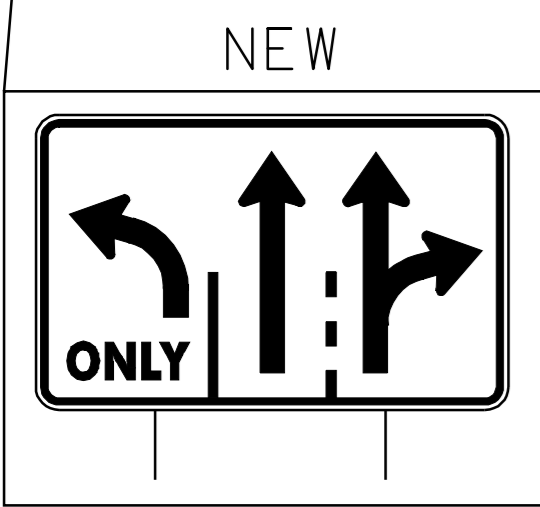

TEMPORARY AND DURABLE CROSSWALK W/DIAGONAL MARKINGS
 STA. 1+908 LT. - RT.

REHABILITATION OF DI'S, CB'S, OR MH'S - CLASS 1

STA. 1+832 LT. (2 EACH)
 STA. 1+923 LT. } BERLIN STREET
 STA. 1+925 RT. }
 STA. 1+930 LT. }
 STA. 1+943 RT.
 STA. 1+947 LT.

CHANGING ELEVATION OF SEWER MANHOLE

STA. 1+919 LT.
 STA. 1+923 RT.

REMOVING SIGNS
 6 EACH

PAVING PROJECT LAYOUT #14

| | | |
|---------------------------------|-----------------------------------|------------------------------|
| PROJECT NAME: BERLIN-BARRE CITY | FILE NAME: /pave/01b022/pb022.dgn | PLOT DATE: 12-MAR-2007 11:09 |
| PROJECT NUMBER: STP 232(I)S | PROJECT LEADER: WOOLAVER | DRAWN BY: LOCKE |
| | DESIGNED BY: LOCKE | CHECKED BY: |
| | pb0221d14.1 | SHEET 26 OF 39 |

I+820 TO I+909 MAINLINE RT COLD PLANE 7.6m 4/25/05 + COLD PLANE 4.1m 4/26/05