
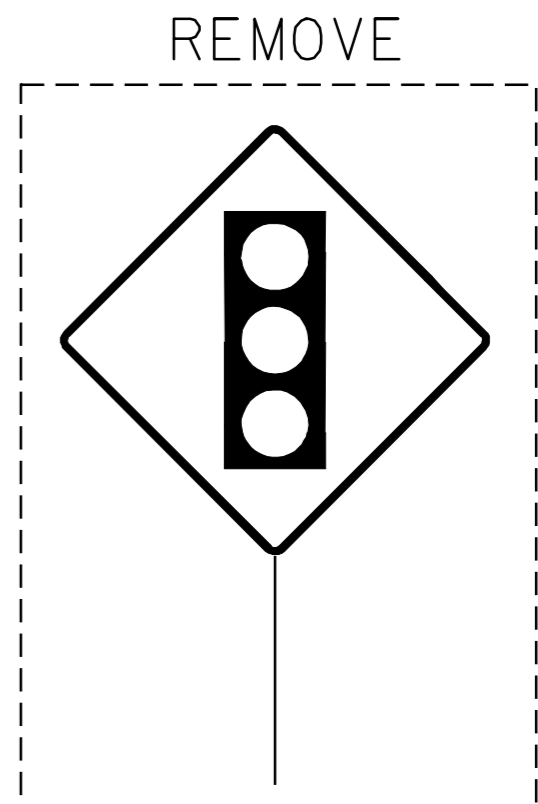
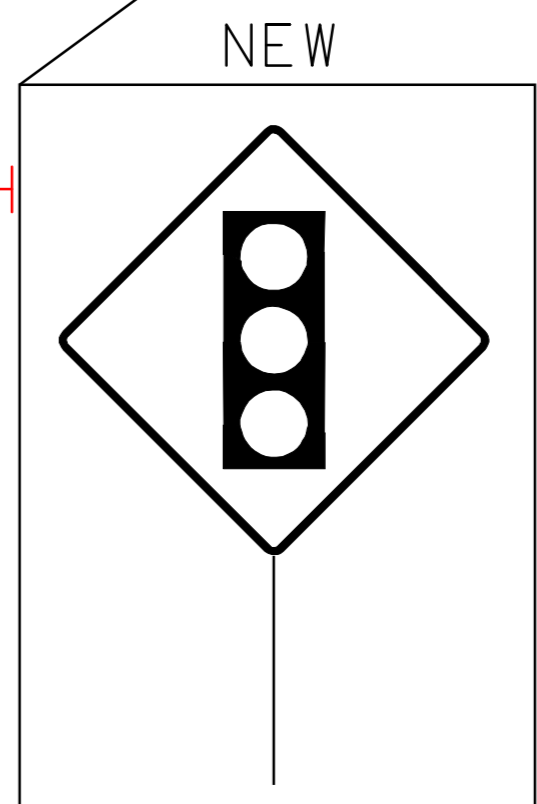
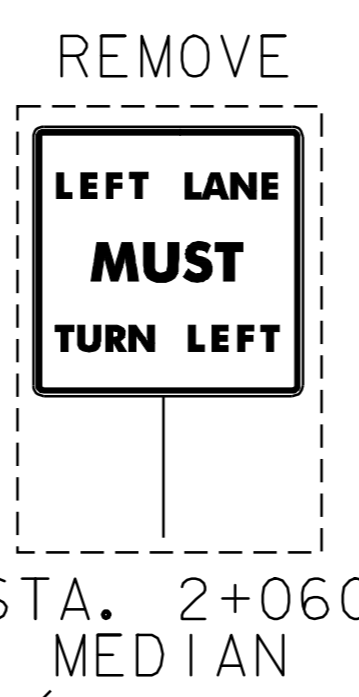
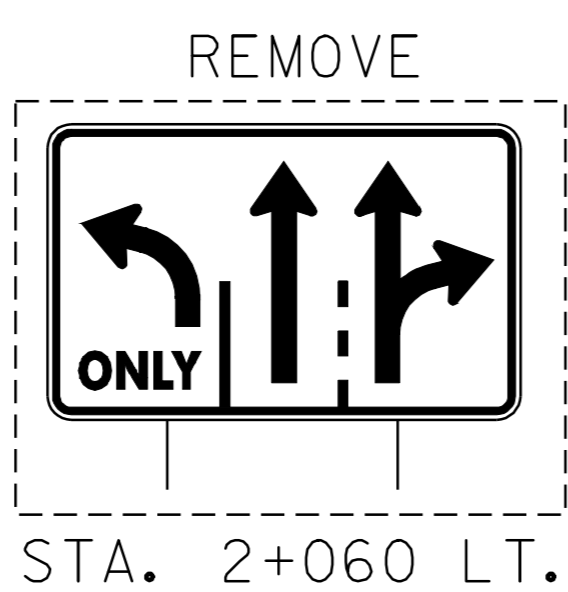
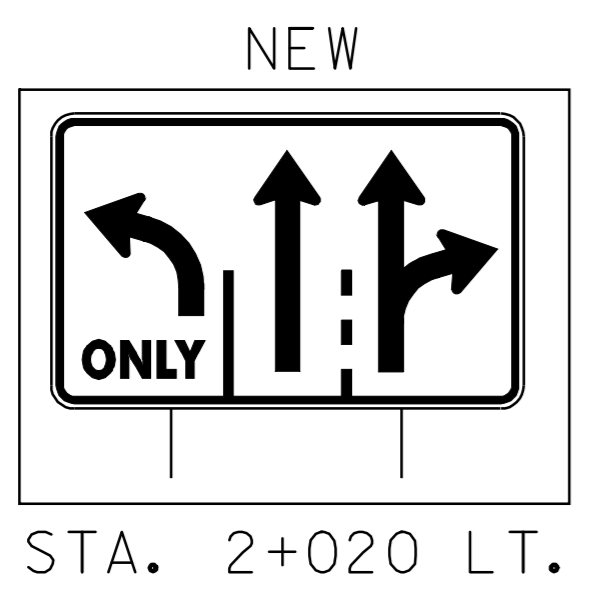


REMOVE EXISTING SIGN AND POST. REPLACE WITH NEW SIGN AND POST. RETAIN EXISTING FLASHING BEACON.

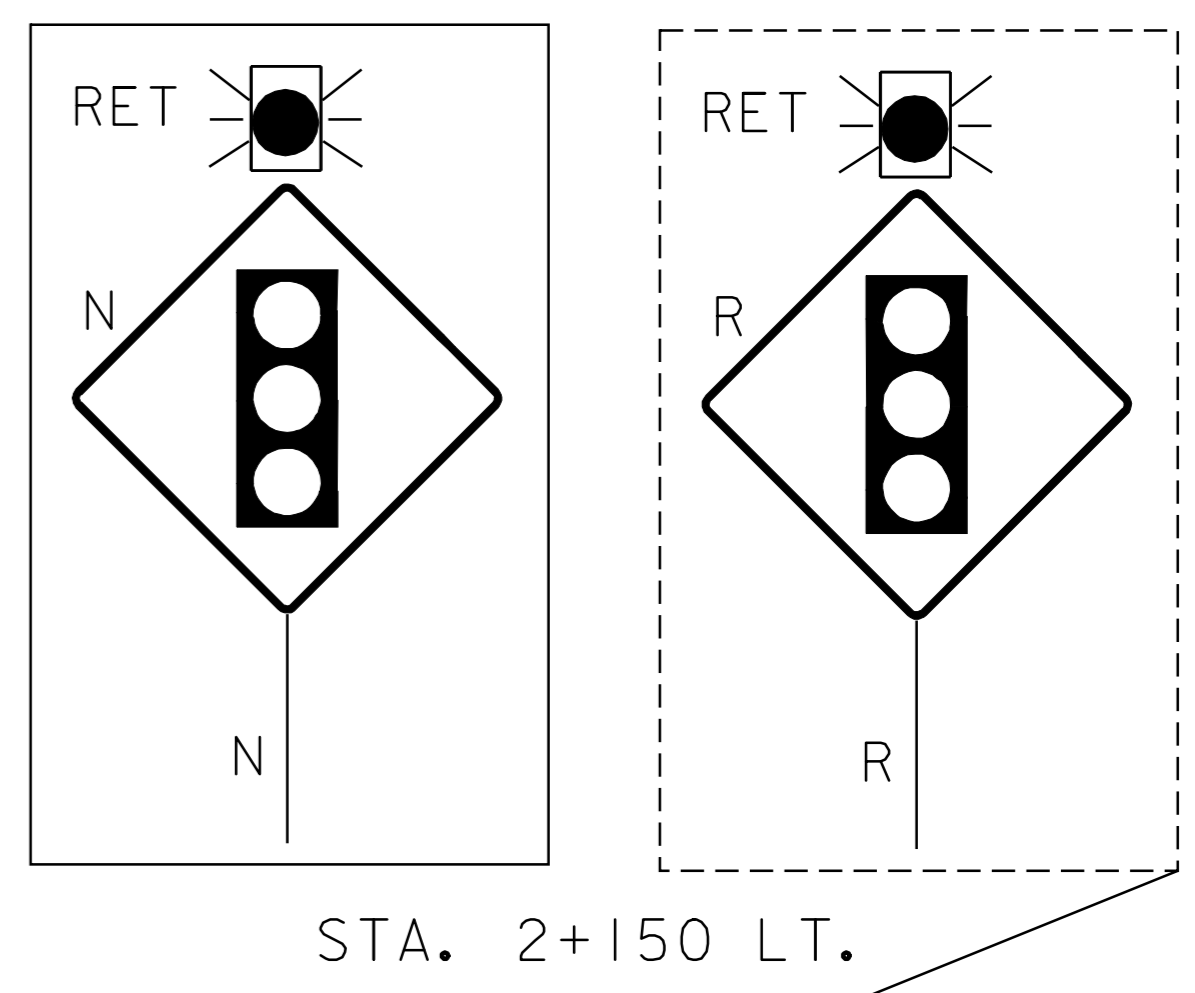

TEMPORARY AND DURABLE 150 mm WHITE LINE
 STA. 2+000 LT. - STA. 2+180 LT. (SOLID)
 STA. 2+000 LT. - STA. 2+180 LT. (DASHED)
 STA. 2+000 LT. - STA. 2+024 LT. (SOLID)
 STA. 2+024 LT. - STA. 2+065 LT. (DOTTED)
 STA. 2+000 RT. - STA. 2+180 RT. (DASHED)
 STA. 2+000 RT. - STA. 2+180 RT. (SOLID)

TEMPORARY AND DURABLE 150 mm YELLOW LINE
 STA. 2+000 RT. - STA. 2+180 LT. (SOLID)
 STA. 2+000 RT. - STA. 2+180 RT. (SOLID)

TEMPORARY AND DURABLE LETTERS OR SYMBOLS
 STA. 2+018 LT. (LEFT TURN ARROW, THROUGH ARROW, THROUGH/RIGHT TURN ARROW)
 STA. 2+023 LT. (ONLY)
 STA. 2+144 LT. (AHEAD - 2 EACH)
 STA. 2+156 LT. (SIGNAL - 2 EACH)

PAINTED CURB
 STA. 2+025 RT. - STA. 2+043 RT.
 STA. 2+059 LT. - STA. 2+077 LT.

BRIDGE 10 2+093.98
 1220 mm ACCGMP

REMOVAL AND DISPOSAL OF GUARDRAIL
 STA. 2+000 LT. - STA. 2+180 LT.

STEEL BEAM GUARDRAIL
 STA. 2+000 LT. - STA. 2+180 LT.

REHABILITATION OF DI'S, CB'S, OR MH'S-CLASS 1
 STA. 2+015 LT.
 STA. 2+015 RT.
 STA. 2+076 LT.
 STA. 2+076 MEDIAN CE
 2+076 RT
 REMOVING SIGNS
 4 EACH

MAINLINE RT (8m)
 2+030 TO 2+180
 COLD PLANED FULL WIDTH
 4/26/05

2+030
 MAINLINE RT 2+000 TO 2+030
 COLD PLANED (4m) 4/25/05
 + COLD PLANED (4.1m) 4/26/05

STA. 2+175 RT.
 BEGIN 2 RAIL
 ALUMINUM BRIDGE
 RAIL - RETAIN

PAVING PROJECT LAYOUT #15	PROJECT NAME: BERLIN-BARRE CITY	PLOT DATE: 12-MAR-2007 11:00
	PROJECT NUMBER: STP 2321(I)S	DRAWN BY: LOCKE
	FILE NAME: /pave/01b022/pb022.dgn	CHECKED BY:
	PROJECT LEADER: WOOLLAVER	SHEET 27 OF 39