

TEMPORARY AND DURABLE 150 mm WHITE LINE  
 STA. 2+180 LT. - STA. 2+360 LT. (SOLID)  
 STA. 2+180 LT. - STA. 2+360 LT. (DASHED)  
 STA. 2+180 RT. - STA. 2+360 RT. (DASHED)  
 STA. 2+180 RT. - STA. 2+360 RT. (SOLID)

TEMPORARY AND DURABLE 150 mm YELLOW LINE  
 STA. 2+180 LT. - STA. 2+360 LT. (SOLID)  
 STA. 2+180 RT. - STA. 2+360 RT. (SOLID)

TEMPORARY AND DURABLE LETTERS OR SYMBOLS  
 STA. 2+305 RT. (SIGNAL - 2 EACH)  
 STA. 2+317 RT. (AHEAD - 2 EACH)

REMOVAL AND DISPOSAL OF GUARDRAIL  
 STA. 2+180 LT. - STA. 2+220 LT.  
 STA. 2+276 LT. - STA. 2+360 LT.  
 STA. 2+273 RT. - STA. 2+360 RT.


STEEL BEAM GUARDRAIL  
 STA. 2+180 LT. - STA. 2+220 LT.  
 STA. 2+276 LT. - STA. 2+360 LT.  
 STA. 2+273 RT. - STA. 2+360 RT.

REHABILITATION OF DI'S, CB'S, OR MH'S-CLASS 1

STA. 2+221 LT.  
 STA. 2+221 MEDIAN  
 STA. 2+221 RT.  
 STA. 2+312 LT.  
 STA. 2+312 RT.

REMOVING SIGNS  
 2 EACH

SNOW BARRIER-GALVANIZED  
 STA. 2+220 LT. - STA. 2+276 LT.  
 STA. 2+220 RT. - STA. 2+273 RT.

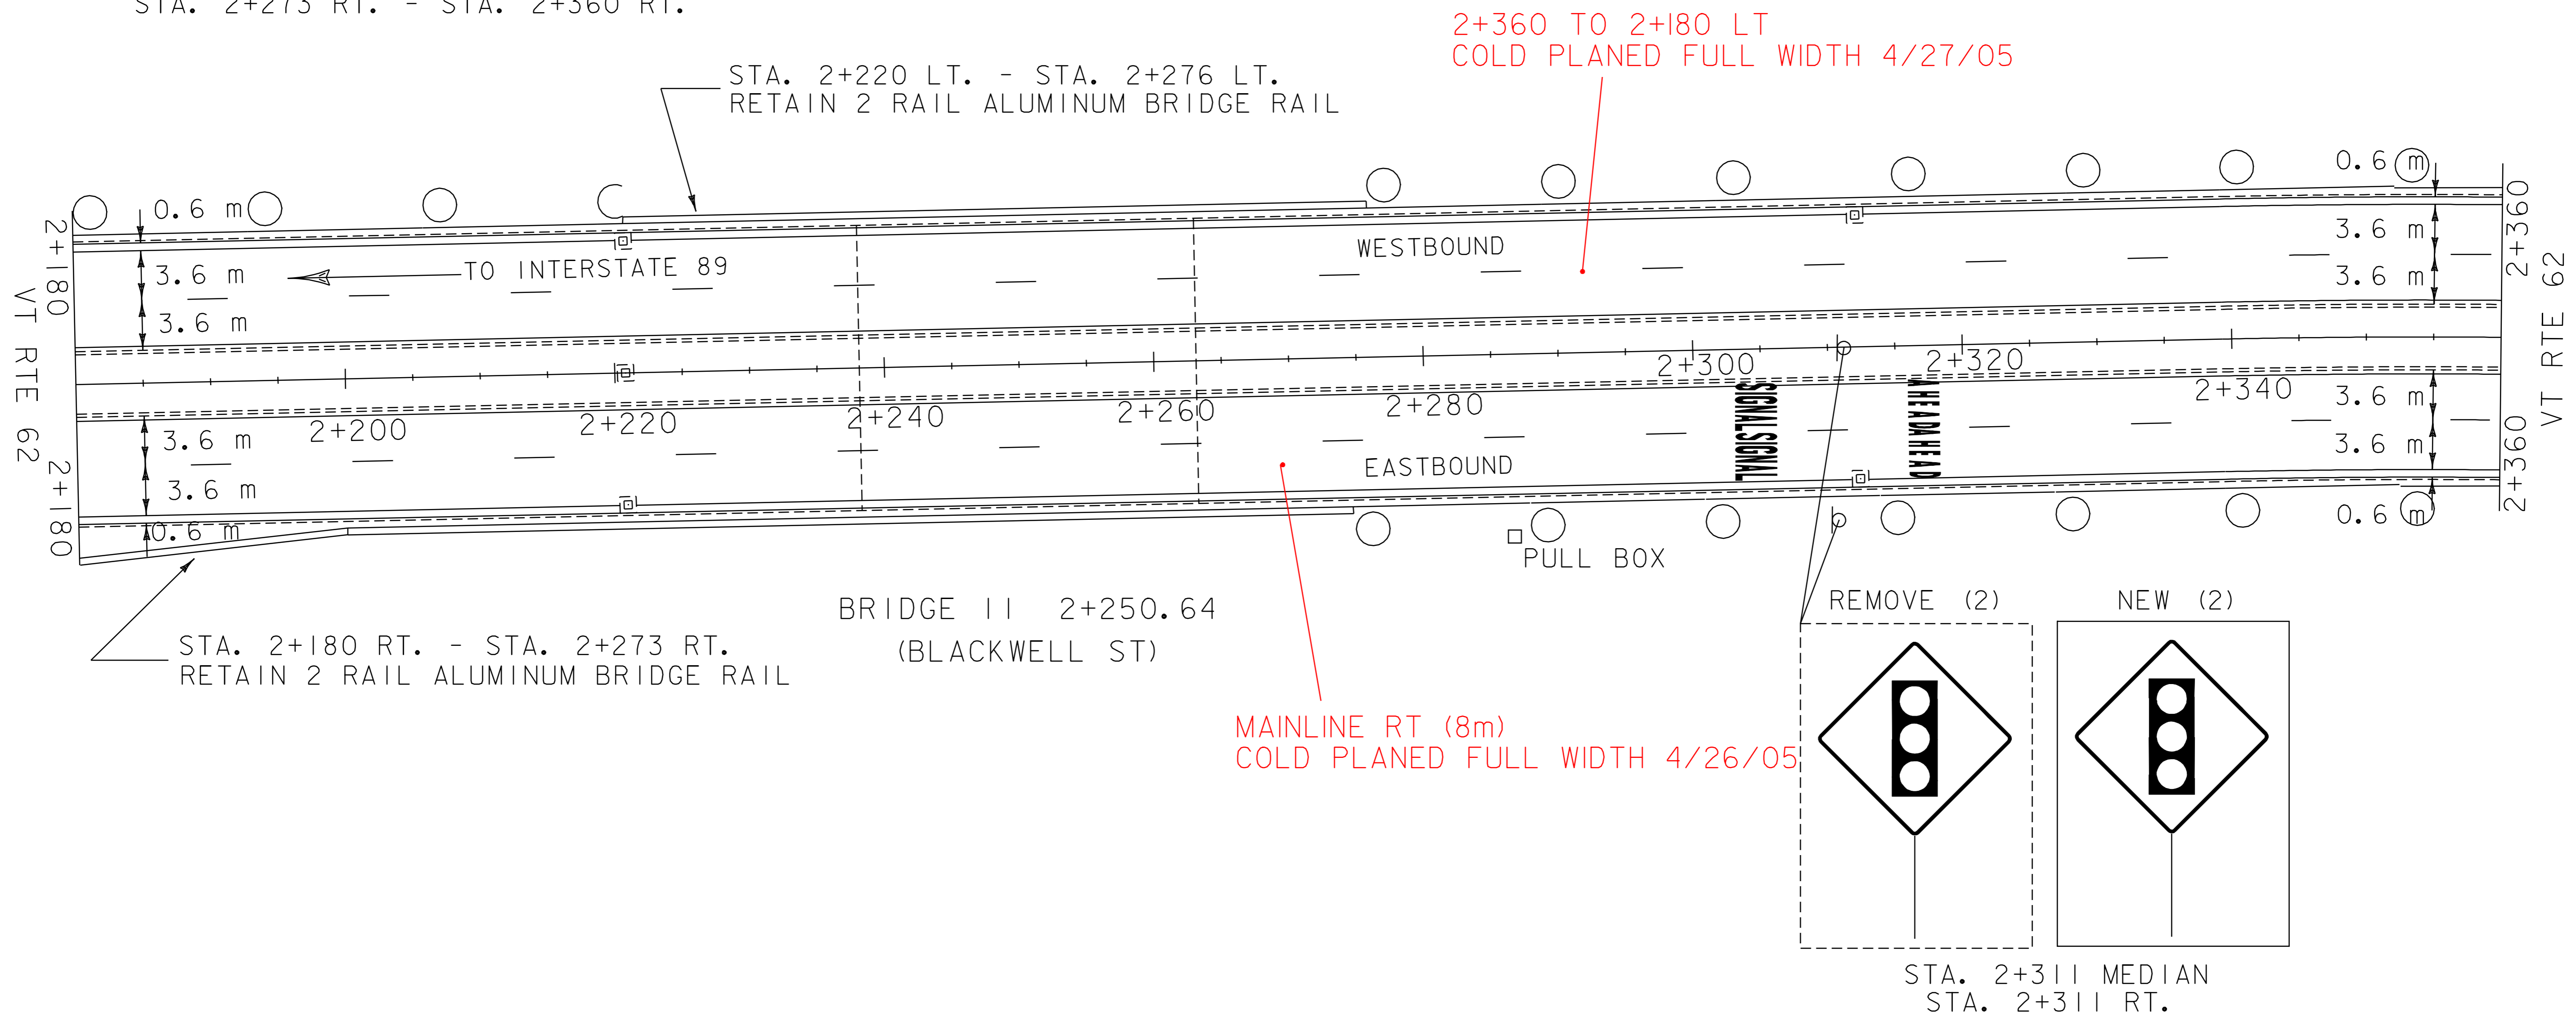

**PAVING  
 PROJECT  
 LAYOUT  
 #16**

PROJECT NAME: BERLIN-BARRE CITY	FILE NAME: /pave/01b022/pb022.dgn	PLOT DATE: 12-MAR-2007 11:00
PROJECT NUMBER: STP 232(1)S	PROJECT LEADER: WOOLLAVER	DRAWN BY: LOCKE
	DESIGNED BY: LOCKE	CHECKED BY:
	pb022al6.i	SHEET 28 OF 39