

646.40 DURABLE 100 mm WHITE LINE
(ALL LINES WILL INCLUDE EDGE LINE BREAKS AND RADIUS FOR TOWN HIGHWAYS)
LUDLOW:
STA. 4+557.662 - STA. 5+000.0, LT & RT

646.60 TEMPORARY 100 mm WHITE LINE
(ALL LINES WILL INCLUDE EDGE LINE BREAKS AND RADIUS FOR TOWN HIGHWAYS)
LUDLOW:
STA. 4+557.662 - STA. 5+000.0, LT & RT

646.41 DURABLE 100 mm YELLOW LINE
(ALL LINES WILL INCLUDE C/L BREAKS FOR TOWN HIGHWAYS) S=SOLID, D=DASHED
LUDLOW:
STA. 4+557.662 - STA. 5+000.0 LT S ☐ RT S
STA. 4+937.467 DOUBLE SOLID RT, T-3

646.61 TEMPORARY 100 mm YELLOW LINE
(ALL LINES WILL INCLUDE C/L BREAKS FOR TOWN HIGHWAYS) S=SOLID, D=DASHED
LUDLOW:
STA. 4+557.662 - STA. 5+000.0 LT S ☐ RT S
STA. 4+937.467 DOUBLE SOLID RT, T-3

646.46 DURABLE 600 mm STOP BAR

LUDLOW:
STA. 4+937.467 RT, T-3

646.66 TEMPORARY 600 mm STOP BAR

LUDLOW:
STA. 4+937.467 RT, T-3

646.50 DURABLE LETTER OR SYMBOL


LUDLOW:
STA. 4+937.467 RT, T-3, "S,T,O,P" (4 EA)

646.70 TEMPORARY LETTER OR SYMBOL

LUDLOW:
STA. 4+937.467 RT, T-3, "S,T,O,P" (4 EA)

675.50 REMOVING SIGNS

AS SHOWN - 5

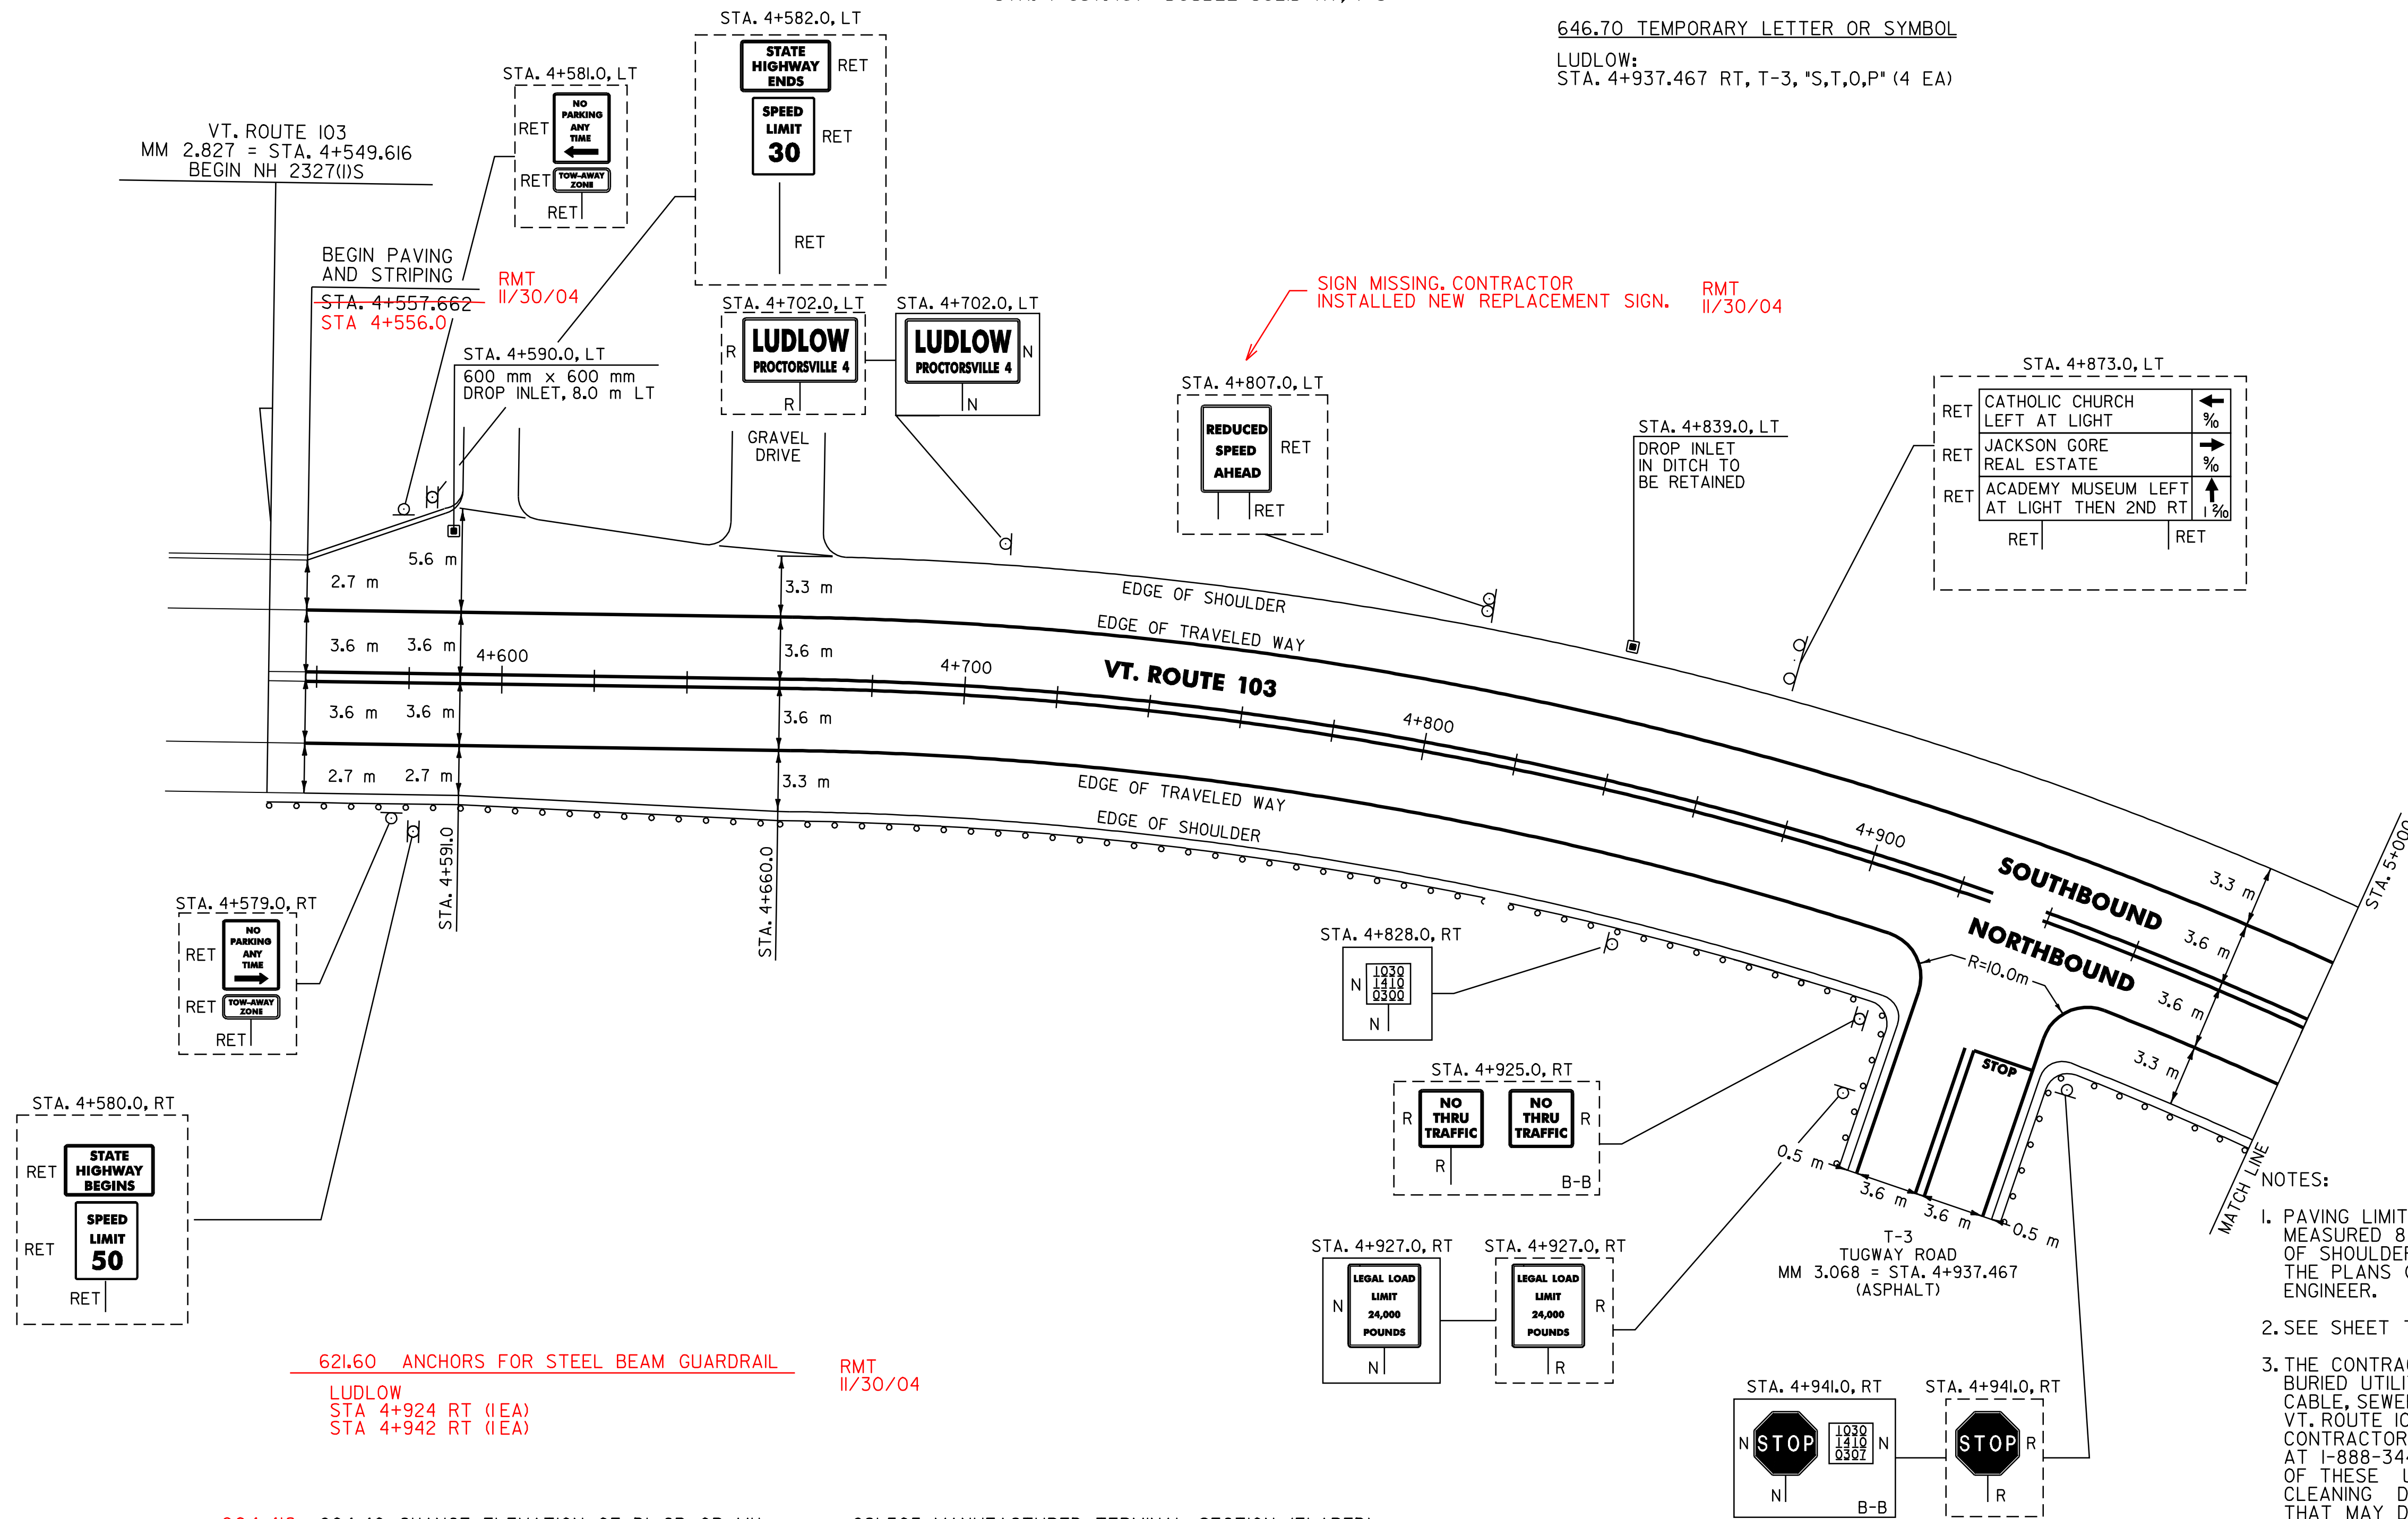

SIGN MISSING, CONTRACTOR INSTALLED NEW REPLACEMENT SIGN. RMT 11/30/04

ARCHIVED ON CADD

621.60 ANCHORS FOR STEEL BEAM GUARDRAIL
LUDLOW:
STA 4+924 RT (1EA)
STA 4+942 RT (1EA)
RMT 11/30/04

604.412 ~~604.40 CHANGE ELEVATION OF DI, CB OR MH~~
LUDLOW:
STA. 4+590.0 LT REHAB DI'S
RMT 11/30/04

621.20 STEEL BEAM GUARDRAIL
LUDLOW:
STA. 4+562.4 - STA. 4+927.2 RT (364.8 m)
STA. 4+944.8 - STA. 5+000.0 RT (55.2 m)

621.21 HEAVY DUTY STEEL BEAM GUARDRAIL
LUDLOW:
STA. 4+927.2 - STA. 4+931.0 RT (9.5 m)
STA. 4+941.0 - STA. 4+944.8 RT (9.5 m)

621.505 MANUFACTURED TERMINAL SECTION (FLARED)
LUDLOW:
STA. 4+562.4 RT

621.80 REMOVAL AND DISPOSAL OF GUARDRAIL
LUDLOW:
STA. 4+551.6 - STA. 4+931.0 RT (387.0 m)
STA. 4+941.0 - STA. 5+000.0 RT (66.6 m)

DATUM

VERTICAL	N/A
HORIZONTAL	N/A

SIGN LEGEND
R= REMOVE
S= SALVAGE
N= NEW
RET= RETAIN
B-B= BACK TO BACK
EXISTING= _____
NEW= _____

PAVING PROJECT LAYOUT # 1

- NOTES:
- PAVING LIMIT ON ALL TOWN HIGHWAYS SHALL BE MEASURED 8 m BACK FROM VT. ROUTE 103 EDGE OF SHOULDER UNLESS DENOTED OTHERWISE ON THE PLANS OR AS DIRECTED BY THE RESIDENT ENGINEER.
 - SEE SHEET 77 OF 84 FOR T-3 BRIDGE DETAILS.
 - THE CONTRACTOR SHOULD BE AWARE THAT EXISTING BURIED UTILITIES (SUCH AS PHONE CABLE, FIBER OPTIC CABLE, SEWER LINES, ETC.) ARE LOCATED ADJACENT TO VT. ROUTE 103 WITHIN THE PROJECT LIMITS. THE CONTRACTOR IS RESPONSIBLE FOR CONTACTING "DIG SAFE" AT 1-888-344-7233 TO DETERMINE THE EXACT LOCATIONS OF THESE UTILITIES PRIOR TO INSTALLING GUARDRAIL, CLEANING DITCHES OR PERFORMING ANY OTHER OPERATIONS THAT MAY DISTURB THE EXISTING SUBSURFACE CONDITIONS.

SURVEYED BY	N/A	DATE	N/A
DRAWN BY	C.A.K.	DATE	
SQUAD LEADER	T.P.K.		
DESIGN FILE NO.	/pave/Qlb024/pb024.dgn		
IPARM FILE	pb02401L	DATE PLOTTED	\$DATE\$
PROJ. NAME	LUDLOW - MT. HOLLY		
PROJ. NO.	NH_232111S		
SHEET	10	OF	84 SHEETS