

646.40 DURABLE 100 mm WHITE LINE
 (ALL LINES WILL INCLUDE EDGE LINE BREAKS AND RADIUS FOR TOWN HIGHWAYS)
 LUDLOW:
 STA. 5+540.0 - STA. 6+080.0, LT & RT

646.41 DURABLE 100 mm YELLOW LINE
 (ALL LINES WILL INCLUDE C/L BREAKS FOR TOWN HIGHWAYS) S=SOLID, D=DASHED
 LUDLOW:
 STA. 5+540.0 - STA. 5+734.0 LT - C
 STA. 5+734.0 - STA. 5+855.0 D - D
 STA. 5+855.0 - STA. 6+080.0 S - S
 STA. 5+875.715 DOUBLE SOLID, LT T-54
 STA. 5+888.590 DOUBLE SOLID, RT T-17

646.46 DURABLE 600 mm STOP BAR
 LUDLOW:
 STA. 5+875.715, LT, T-52
 STA. 5+888.590, RT, T-17

646.50 DURABLE LETTER OR SYMBOL
 LUDLOW:
 STA. 5+875.715 LT, T-52, "S.T.O.P." (4 EA)
 STA. 5+888.590, RT, T-17, "S.T.O.P." (4 EA)

675.50 REMOVING SIGNS
 AS SHOWN - II


646.60 TEMPORARY 100 mm WHITE LINE
 (ALL LINES WILL INCLUDE EDGE LINE BREAKS AND RADIUS FOR TOWN HIGHWAYS)
 LUDLOW:
 STA. 5+540.0 - STA. 6+080.0, LT & RT

646.61 TEMPORARY 100 mm YELLOW LINE
 (ALL LINES WILL INCLUDE C/L BREAKS FOR TOWN HIGHWAYS) S=SOLID, D=DASHED
 LUDLOW:
 STA. 5+540.0 - STA. 5+734.0 LT - C
 STA. 5+734.0 - STA. 5+855.0 D - D
 STA. 5+855.0 - STA. 6+080.0 S - S
 STA. 5+875.715 DOUBLE SOLID, LT T-54
 STA. 5+888.590 DOUBLE SOLID, RT T-17

646.66 TEMPORARY 600 mm STOP BAR
 LUDLOW:
 STA. 5+875.715, LT, T-52
 STA. 5+888.590, RT, T-17

646.70 TEMPORARY LETTER OR SYMBOL
 LUDLOW:
 STA. 5+875.715 LT, T-52, "S.T.O.P." (4 EA)
 STA. 5+888.590, RT, T-17, "S.T.O.P." (4 EA)

675.60 ERECTING SALVAGED SIGNS
 AS SHOWN - 4

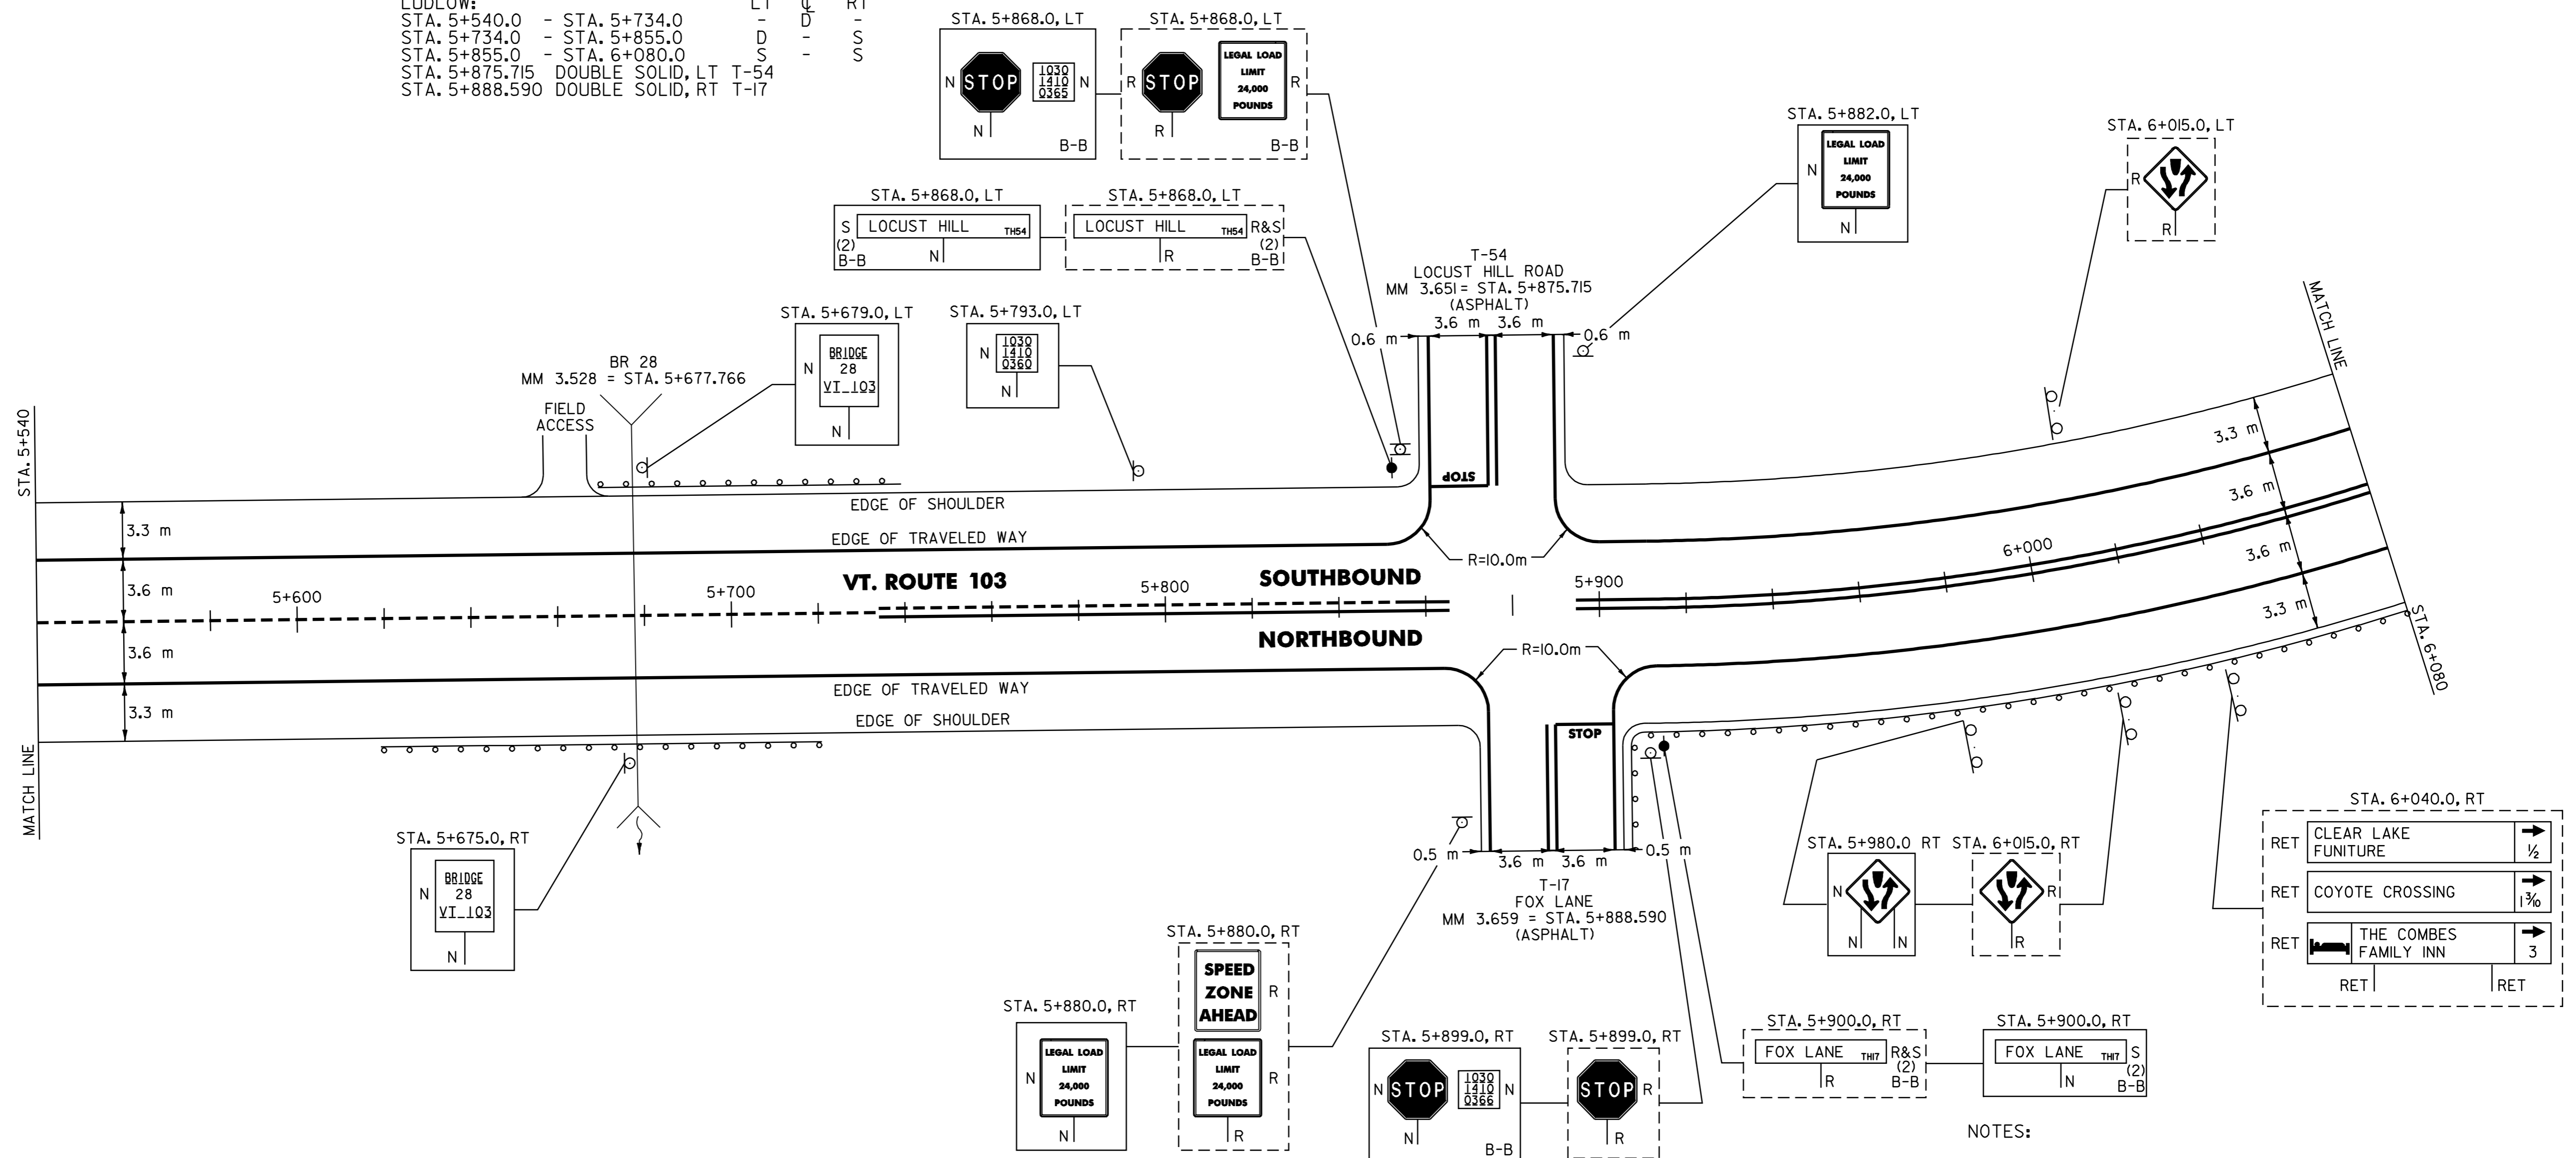

RET	DESCRIPTION	QUANTITY
RET	CLEAR LAKE FURNITURE	1/2
RET	COYOTE CROSSING	1 1/2
RET	THE COMBES FAMILY INN	3
RET		

- NOTES:
- PAVING LIMIT ON ALL TOWN HIGHWAYS SHALL BE MEASURED 8 m BACK FROM VT. ROUTE 103 EDGE OF SHOULDER UNLESS DENOTED OTHERWISE ON THE PLANS OR AS DIRECTED BY THE RESIDENT ENGINEER.
 - THE CONTRACTOR SHOULD BE AWARE THAT EXISTING BURIED UTILITIES (SUCH AS PHONE CABLE, FIBER OPTIC CABLE, SEWER LINES, ETC.) ARE LOCATED ADJACENT TO VT. ROUTE 103 WITHIN THE PROJECT LIMITS. THE CONTRACTOR IS RESPONSIBLE FOR CONTACTING "DIG SAFE" AT 1-888-344-7233 TO DETERMINE THE EXACT LOCATIONS OF THESE UTILITIES PRIOR TO INSTALLING GUARDRAIL, CLEANING DITCHES OR PERFORMING ANY OTHER OPERATIONS THAT MAY DISTURB THE EXISTING SUBSURFACE CONDITIONS.

621.20 STEEL BEAM GUARDRAIL STA 5+727.6
 LUDLOW:
 STA. 5+632.4 - STA. 5+704.6 RT (72.2 m)
 STA. 5+670.4 - STA. 5+723.6 LT (63.2 m) 57.2m RMT
 STA. 5+893.3 - STA. 6+080.0 RT (201.9 m) 11/30/04

621.60 ANCHORS FOR STEEL BEAM GUARDRAIL RMT 11/30/04
 LUDLOW
 STA 5+895 RT (1EA)

621.505 MANUFACTURED TERMINAL SECTION (FLARED)
 LUDLOW:
 STA. 5+632.4 RT
 STA. 5+670.4 LT
 STA. 5+704.6 RT
 STA. 5+723.6 LT
 STA. 5+893.3 RT

621.80 REMOVAL AND DISPOSAL OF GUARDRAIL
 LUDLOW:
 STA. 5+647.0 - STA. 5+701.0 RT (54.0 m)
 STA. 5+659.0 - STA. 5+713.0 LT (54.0 m)
 STA. 5+893.0 - STA. 6+080.0 RT (213.6 m)

DATUM	
VERTICAL	N/A
HORIZONTAL	N/A

ARCHIVED
ON CADD

SIGN LEGEND
 R= REMOVE
 S= SALVAGE
 N= NEW
 RET= RETAIN
 B-B= BACK TO BACK
 EXISTING= _____
 NEW= _____

**PAVING
PROJECT
LAYOUT
3**

SURVEYED BY	N/A	DATE	N/A
DRAWN BY	C.A.K.	DATE	
SQUAD LEADER	T.P.K.		
DESIGN FILE NO.	/pave/01b024/pb024.dgn		
IPARM FILE	pb024i03.l	DATE PLOTTED	\$DATE\$
PROJ. NAME	LUDLOW - MI. HOLLY		
PROJ. NO.	NH_2327(1)S		
SHEET	12	OF	84 SHEETS