

646.40 DURABLE 100 mm WHITE LINE
(ALL LINES WILL INCLUDE EDGE LINE BREAKS AND RADIUS FOR TOWN HIGHWAYS)

LUDLOW:
STA. 6+880.0 - STA. 7+160.0 LT & RT

646.60 TEMPORARY 100 mm WHITE LINE
(ALL LINES WILL INCLUDE EDGE LINE BREAKS AND RADIUS FOR TOWN HIGHWAYS)

LUDLOW:
STA. 6+880.0 - STA. 7+160.0 LT & RT

646.41 DURABLE 100 mm YELLOW LINE
(ALL LINES WILL INCLUDE C/L BREAKS FOR TOWN HIGHWAYS) S=SOLID, D=DASHED

LUDLOW:
STA. 6+880.0 - STA. 7+081.1
STA. 7+081.1 - STA. 7+160.0
STA. 6+952.366, LT, OKEMO RIDGE ROAD
STA. 7+000.646, RT, T-53

646.61 TEMPORARY 100 mm YELLOW LINE
(ALL LINES WILL INCLUDE C/L BREAKS FOR TOWN HIGHWAYS) S=SOLID, D=DASHED

LUDLOW:
STA. 6+880.0 - STA. 7+081.1
STA. 7+081.1 - STA. 7+160.0
STA. 6+952.366, LT, OKEMO RIDGE ROAD
STA. 7+000.646, RT, T-53

LT C RT
S - - S
S - - S

LT C RT
S - - S
S - - S

646.46 DURABLE 600 mm STOP BAR

LUDLOW:
STA. 6+952.366, LT, OKEMO RIDGE ROAD
STA. 7+000.646, RT, T-53

646.66 TEMPORARY 600 mm STOP BAR

LUDLOW:
STA. 6+952.366, LT, OKEMO RIDGE ROAD
STA. 7+000.646, RT, T-53

646.50 DURABLE LETTER OR SYMBOL


LUDLOW:
STA. 6+952.366, LT, OKEMO RIDGE ROAD, "S.T.O.P." (4 EA)
STA. 7+000.646, RT, T-53, "S.T.O.P." (4 EA)

646.70 TEMPORARY LETTER OR SYMBOL

LUDLOW:
STA. 6+952.366, LT, OKEMO RIDGE ROAD, "S.T.O.P." (4 EA)
STA. 7+000.646, RT, T-53, "S.T.O.P." (4 EA)

675.50 REMOVING SIGNS
AS SHOWN - II

675.60 ERECTING SALVAGED SIGNS
AS SHOWN - 2

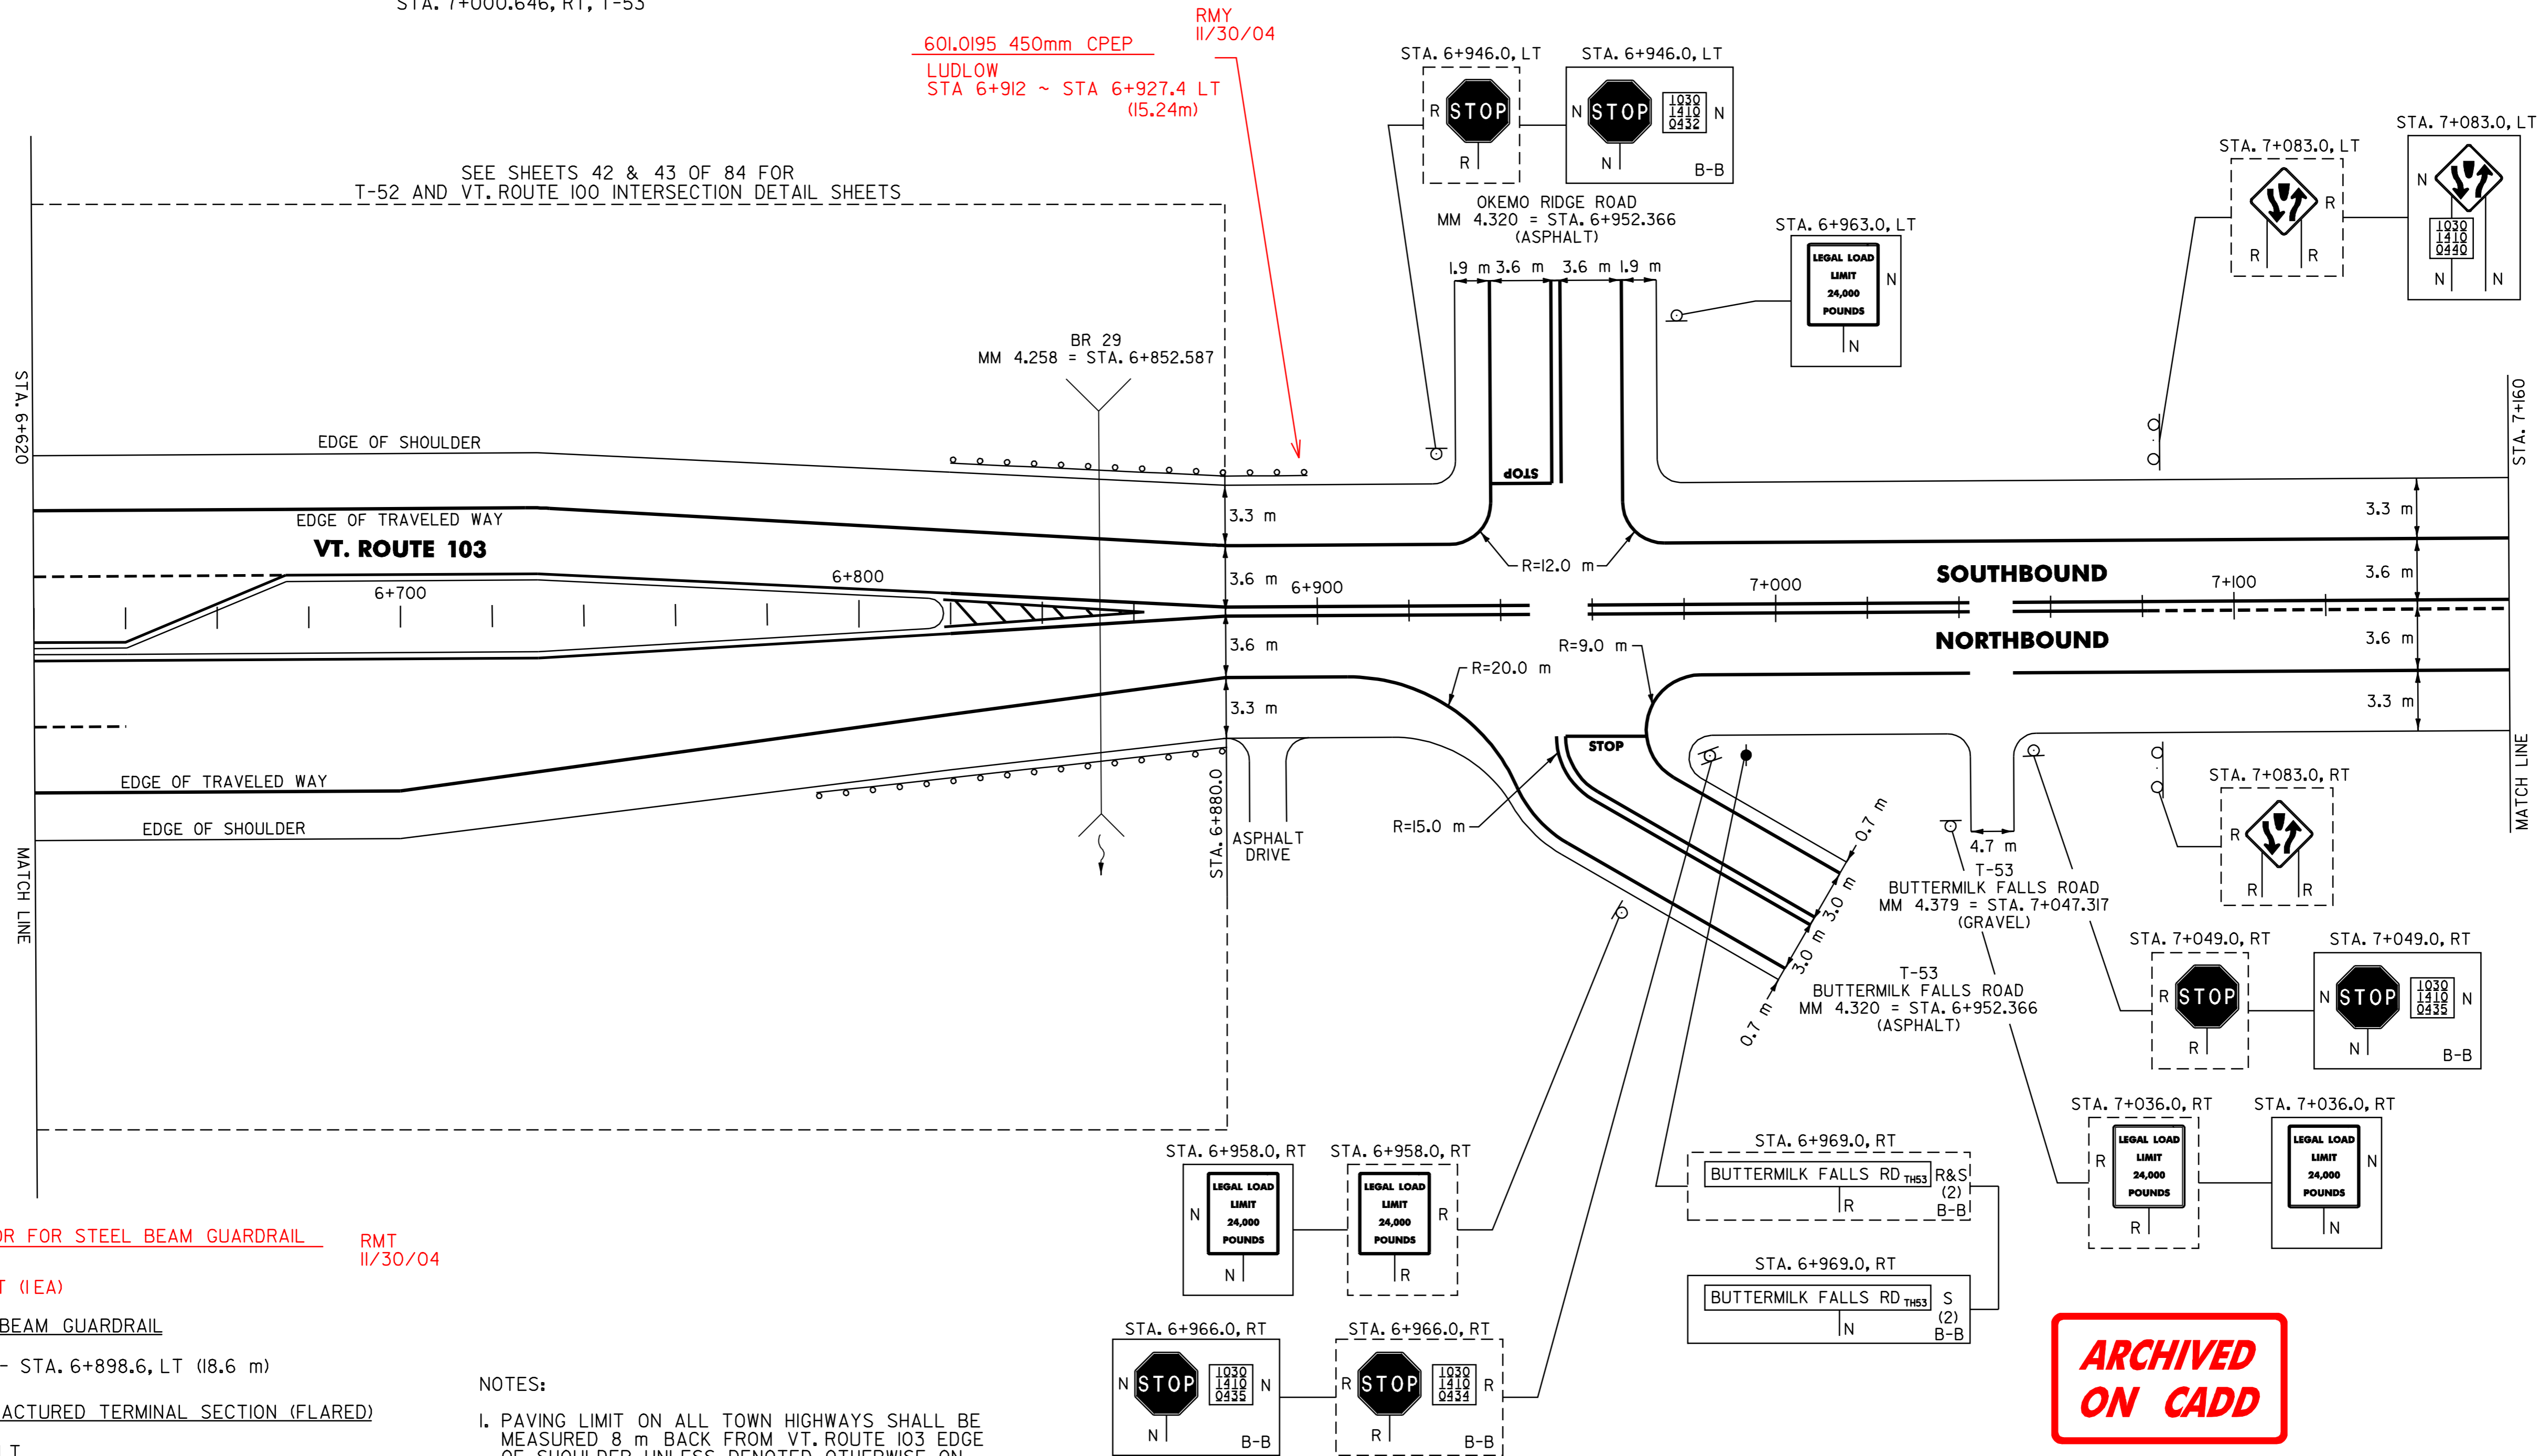

621.60 ANCHOR FOR STEEL BEAM GUARDRAIL

LUDLOW:
STA. 6+890 RT (1EA)

621.20 STEEL BEAM GUARDRAIL

LUDLOW:
STA. 6+880.0 - STA. 6+898.6, LT (18.6 m)

621.505 MANUFACTURED TERMINAL SECTION (FLARED)

LUDLOW:
STA. 6+898.6 LT

621.80 REMOVAL AND DISPOSAL OF GUARDRAIL

LUDLOW:
STA. 6+880.0 - STA. 6+893.0 LT (13.0 m)

RMT
11/30/04

NOTES:

- PAVING LIMIT ON ALL TOWN HIGHWAYS SHALL BE MEASURED 8 m BACK FROM VT. ROUTE 103 EDGE OF SHOULDER UNLESS DENOTED OTHERWISE ON THE PLANS OR AS DIRECTED BY THE RESIDENT ENGINEER.
- THE CONTRACTOR SHOULD BE AWARE THAT EXISTING BURIED UTILITIES (SUCH AS PHONE CABLE, FIBER OPTIC CABLE, SEWER LINES, ETC.) ARE LOCATED ADJACENT TO VT. ROUTE 103 WITHIN THE PROJECT LIMITS. THE CONTRACTOR IS RESPONSIBLE FOR CONTACTING "DIG SAFE" AT 1-888-344-7233 TO DETERMINE THE EXACT LOCATIONS OF THESE UTILITIES PRIOR TO INSTALLING GUARDRAIL, CLEANING DITCHES OR PERFORMING ANY OTHER OPERATIONS THAT MAY DISTURB THE EXISTING SUBSURFACE CONDITIONS.

DATUM	
VERTICAL	N/A
HORIZONTAL	N/A

SIGN LEGEND
R= REMOVE
S= SALVAGE
N= NEW
RET= RETAIN
B-B= BACK TO BACK
EXISTING= _____
NEW= _____

**ARCHIVED
ON CADD**

PAVING PROJECT LAYOUT # 5	SURVEYED BY	N/A	DATE	N/A
	DRAWN BY	C.A.K.	DATE	
	SQUAD LEADER	T.P.K.		
	DESIGN FILE NO.	/pave/01b024/pb024.dgn		
	IPARM FILE	pb024105.L	DATE PLOTTED	*DATE*
PROJ. NAME	LUDLOW - MI. HOLLY			
PROJ. NO.	NH_232711S			
SHEET	14	OF	84	SHEETS