

646.40 DURABLE 100 mm WHITE LINE
 (ALL LINES WILL INCLUDE EDGE LINE BREAKS AND RADIUS FOR TOWN HIGHWAYS)
 LUDLOW:
 STA. 7+160.0 - STA. 7+700.0, LT & RT
 STA. 7+550.0 - STA. 7+700.0, DASHED LINE 3.6 m RT

646.60 TEMPORARY 100 mm WHITE LINE
 (ALL LINES WILL INCLUDE EDGE LINE BREAKS AND RADIUS FOR TOWN HIGHWAYS)
 LUDLOW:
 STA. 7+160.0 - STA. 7+700.0, LT & RT
 STA. 7+550.0 - STA. 7+700.0, DASHED LINE 3.6 m RT

BB 12/13/04


646.41 DURABLE 100 mm YELLOW LINE
 (ALL LINES WILL INCLUDE C/L BREAKS FOR TOWN HIGHWAYS) S=SOLID, D=DASHED

LUDLOW:
 STA. 7+160.0 - STA. 7+209.9 S - D
 STA. 7+209.9 - STA. 7+338.0 - D - S
 STA. 7+338.0 - STA. 7+460.0 - D - S
 STA. 7+460.0 - STA. 7+700.0 S - S

646.61 TEMPORARY 100 mm YELLOW LINE
 (ALL LINES WILL INCLUDE C/L BREAKS FOR TOWN HIGHWAYS) S=SOLID, D=DASHED

LUDLOW:
 STA. 7+160.0 - STA. 7+209.9 S - D
 STA. 7+209.9 - STA. 7+338.0 - D - S
 STA. 7+338.0 - STA. 7+460.0 D - S
 STA. 7+460.0 - STA. 7+700.0 S - S

675.50 REMOVING SIGNS
 AS SHOWN - 5

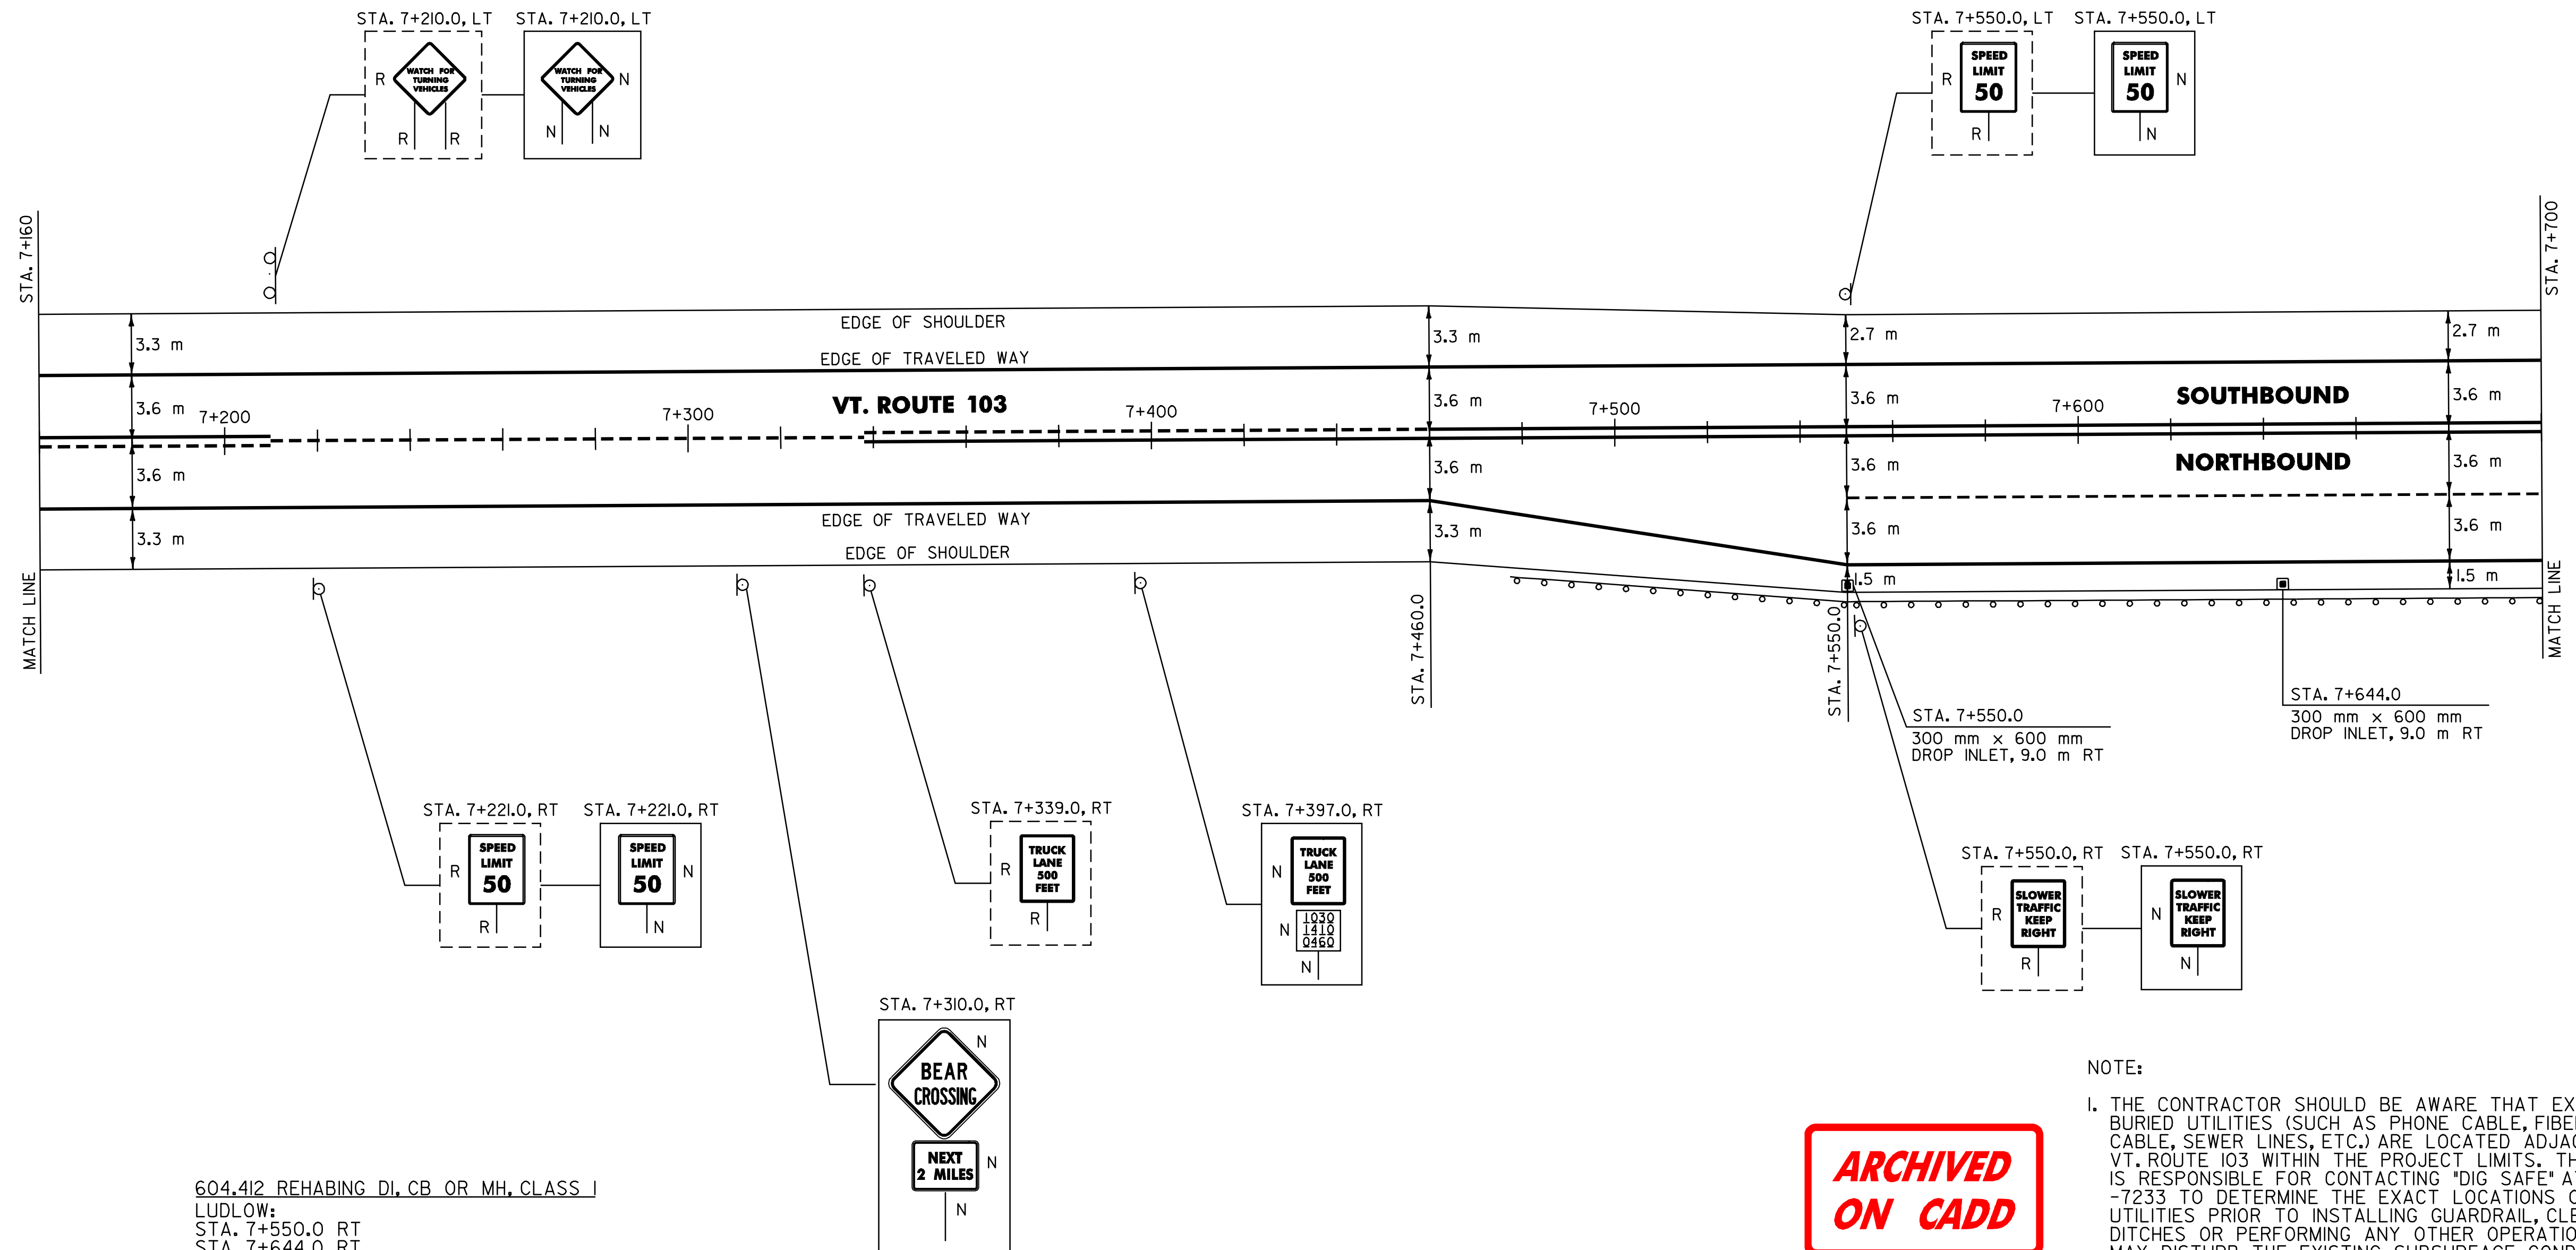

604.412 REHABING DI, CB OR MH, CLASS I
 LUDLOW:
 STA. 7+550.0 RT
 STA. 7+644.0 RT

621.20 STEEL BEAM GUARDRAIL
 LUDLOW:
 STA. 7+493.6 - STA. 7+700.0 RT (206.4 m)

621.505 MANUFACTURED TERMINAL SECTION (FLARED)
 LUDLOW:
 STA. 7+493.6 RT

621.80 REMOVAL AND DISPOSAL OF GUARDRAIL
 LUDLOW:
 STA. 7+483.0 - STA. 7+700.0 RT (217.0 m)

616.35 TREATED TIMBER CURB RMT 11/30/04
 LUDLOW:
 STA 7+548 ~ STA 7+700 RT (152m)

NOTE:

1. THE CONTRACTOR SHOULD BE AWARE THAT EXISTING BURIED UTILITIES (SUCH AS PHONE CABLE, FIBER OPTIC CABLE, SEWER LINES, ETC.) ARE LOCATED ADJACENT TO VT. ROUTE 103 WITHIN THE PROJECT LIMITS. THE CONTRACTOR IS RESPONSIBLE FOR CONTACTING "DIG SAFE" AT 1-888-344-7233 TO DETERMINE THE EXACT LOCATIONS OF THESE UTILITIES PRIOR TO INSTALLING GUARDRAIL, CLEANING DITCHES OR PERFORMING ANY OTHER OPERATIONS THAT MAY DISTURB THE EXISTING SUBSURFACE CONDITIONS.

ARCHIVED ON CADD

DATUM
 VERTICAL N/A
 HORIZONTAL N/A

SIGN LEGEND
 R= REMOVE
 S= SALVAGE
 N= NEW
 RET= RETAIN
 B-B= BACK TO BACK
 EXISTING= _____
 NEW= _____

PAVING PROJECT LAYOUT # 6

SURVEYED BY N/A DATE N/A
 DRAWN BY C.A.K. DATE _____
 SQUAD LEADER T.P.K.
 DESIGN FILE NO. pb02406L DATE PLOTTED \$DATE\$
 IPARM FILE pb02406L DATE PLOTTED \$DATE\$
 PROJ. NAME LUDLOW - MI. HOLLY
 PROJ. NO. NH_2327(1)S
 SHEET 15 OF 84 SHEETS _____