


646.40 DURABLE 100 mm WHITE LINE
 (ALL LINES WILL INCLUDE EDGE LINE BREAKS AND RADIUS FOR TOWN HIGHWAYS)
 LUDLOW:
 STA. 7+700.0 - STA. 8+240.0, LT & RT
 STA. 7+700.0 - STA. 8+240.0, DASHED LINE 3.6 m RT

646.41 DURABLE 100 mm YELLOW LINE
 (ALL LINES WILL INCLUDE C/L BREAKS FOR TOWN HIGHWAYS) S=SOLID, D=DASHED
 LUDLOW:
 STA. 7+700.0 - STA. 8+240.0 LT S Q RT S

675.50 REMOVING SIGNS
 AS SHOWN - I

646.60 TEMPORARY 100 mm WHITE LINE
 (ALL LINES WILL INCLUDE EDGE LINE BREAKS AND RADIUS FOR TOWN HIGHWAYS)
 LUDLOW:
 STA. 7+700.0 - STA. 8+240.0, LT & RT
 STA. 7+700.0 - STA. 8+240.0, DASHED LINE 3.6 m RT

646.61 TEMPORARY 100 mm YELLOW LINE
 (ALL LINES WILL INCLUDE C/L BREAKS FOR TOWN HIGHWAYS) S=SOLID, D=DASHED
 LUDLOW:
 STA. 7+700.0 - STA. 8+240.0 LT S Q RT S

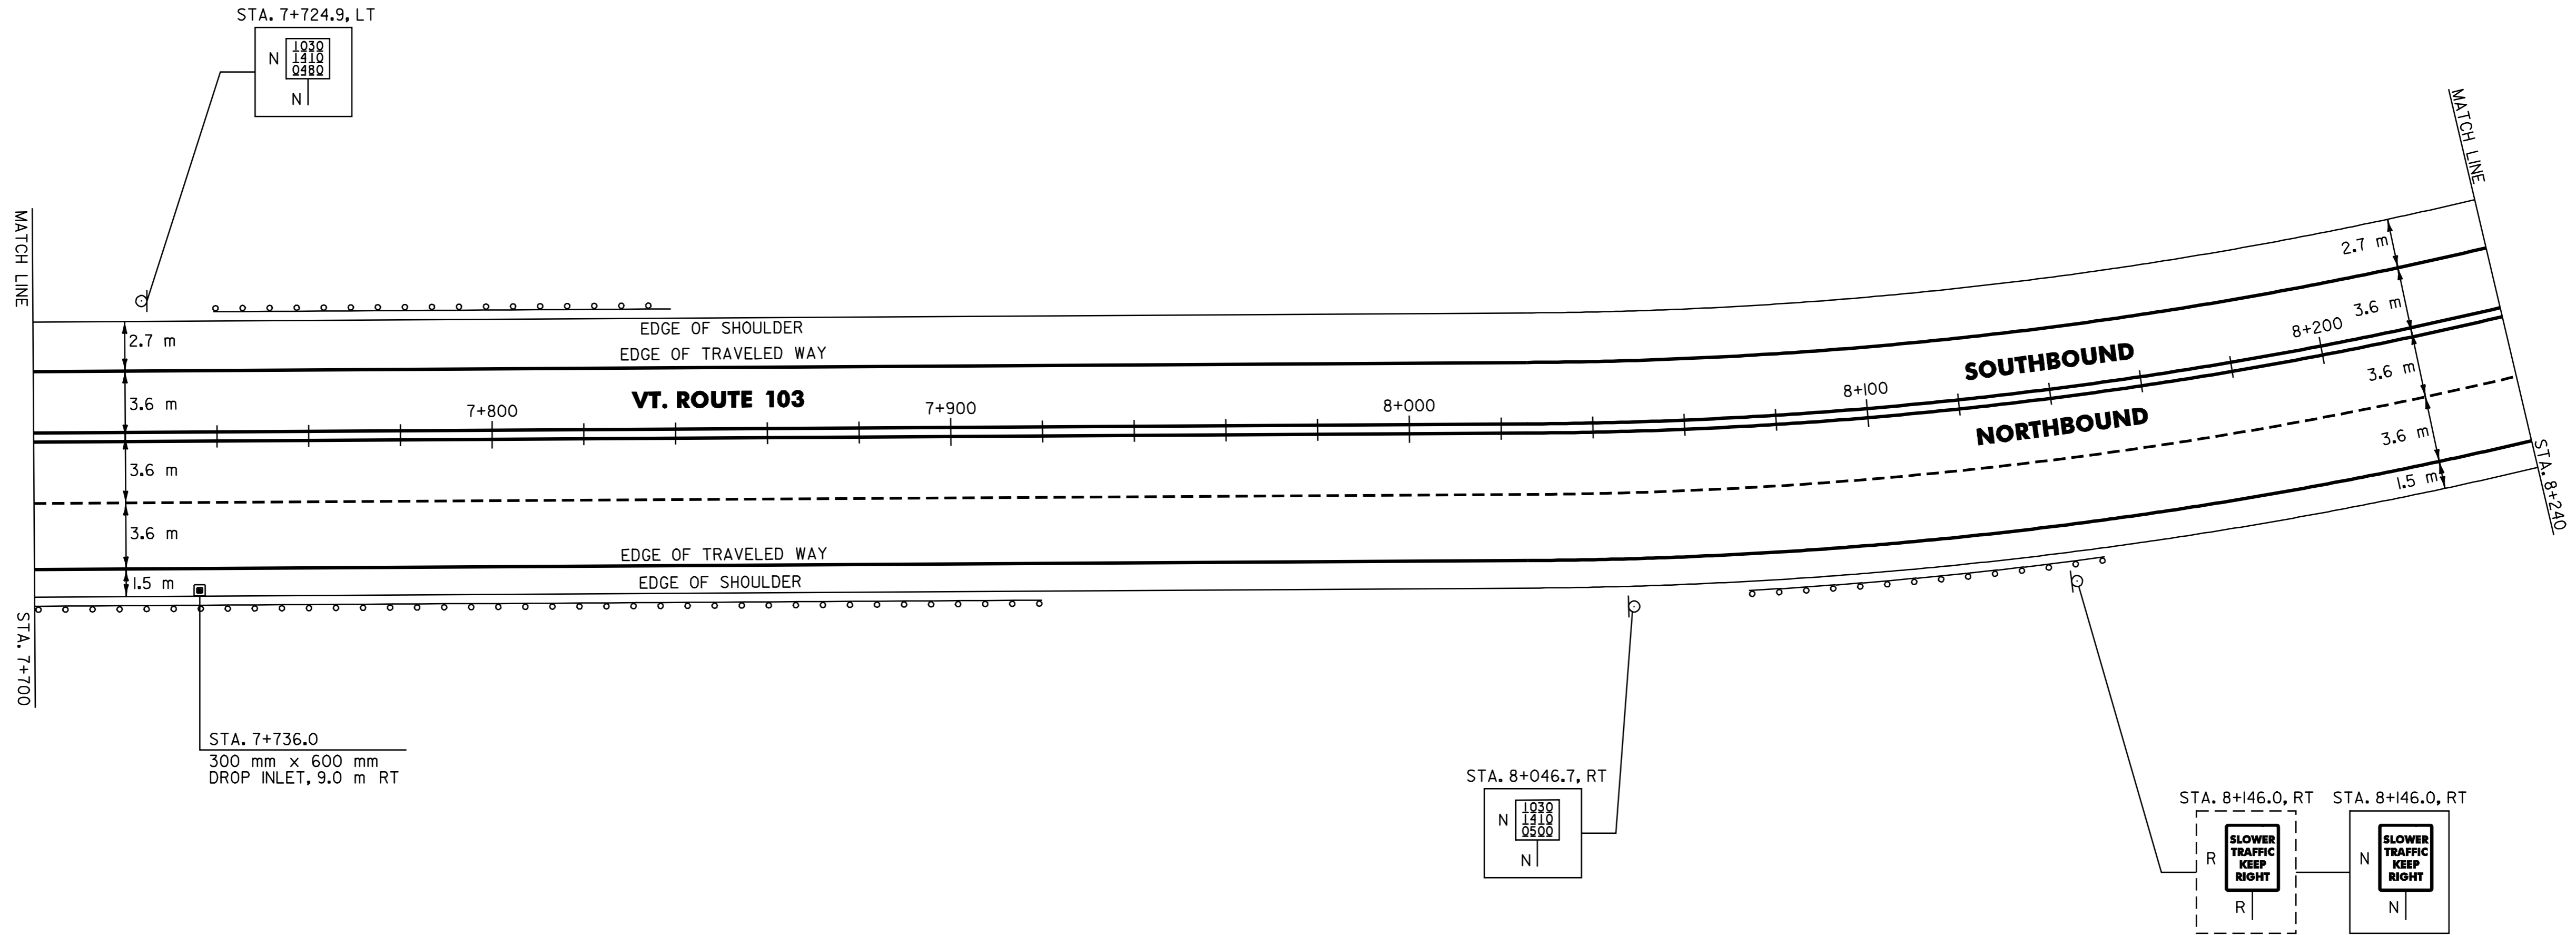

616.35 TREATED TIMBER CURB RMT
 LUDLOW: 11/30/04
 STA 7+700 ~ STA 7+830 (129.7m)

604.412 REHABING DI, CB OR MH, CLASS I
 LUDLOW:
 STA. 7+736.0 RT

621.505 MANUFACTURED TERMINAL SECTION (FLARED)
 LUDLOW:
 STA. 7+892.6 RT
 STA. 7+753.0 LT
 STA. 7+829.0 LT
 STA. 8+089.4 RT
 STA. 8+142.6 RT

621.20 STEEL BEAM GUARDRAIL
 LUDLOW:
 STA. 7+700.0 - STA. 7+892.6 RT (192.6 m)
 STA. 7+753.0 - STA. 7+829.0 LT (76.0 m)
 STA. 8+089.4 - STA. 8+142.6 RT (53.2 m)
 STA 8+062.6 (80.0m)

621.80 REMOVAL AND DISPOSAL OF GUARDRAIL
 LUDLOW:
 STA. 7+700.0 - STA. 7+904.0 RT (204.0 m)
 STA. 7+743.0 - STA. 7+839.0 LT (96.0 m)
 STA. 8+078.0 - STA. 8+152.0 RT (74.0 m)

RMT
 11/30/04

**ARCHIVED
ON CADD**

NOTE:
 I. THE CONTRACTOR SHOULD BE AWARE THAT EXISTING BURIED UTILITIES (SUCH AS PHONE CABLE, FIBER OPTIC CABLE, SEWER LINES, ETC.) ARE LOCATED ADJACENT TO VT. ROUTE 103 WITHIN THE PROJECT LIMITS. THE CONTRACTOR IS RESPONSIBLE FOR CONTACTING "DIG SAFE" AT 1-888-344-7233 TO DETERMINE THE EXACT LOCATIONS OF THESE UTILITIES PRIOR TO INSTALLING GUARDRAIL, CLEANING DITCHES OR PERFORMING ANY OTHER OPERATIONS THAT MAY DISTURB THE EXISTING SUBSURFACE CONDITIONS.

SIGN LEGEND
 R= REMOVE
 S= SALVAGE
 N= NEW
 RET= RETAIN
 B-B= BACK TO BACK
 EXISTING= -----
 NEW= _____

**PAVING
PROJECT
LAYOUT
7**

SURVEYED BY N/A DATE N/A
 DRAWN BY C.A.K. DATE _____
 SQUAD LEADER T.P.K.
 DESIGN FILE NO. pb024107.d
 IPARM pb024107.d DATE PLOTTED \$DATE\$
 PROJ. NAME LUDLOW - MI. HOLLY
 PROJ. NO. NH_2327(1)S
 SHEET 16 OF 84 SHEETS _____

DATUM
 VERTICAL N/A
 HORIZONTAL N/A