

646.40 DURABLE 100 mm WHITE LINE
(ALL LINES WILL INCLUDE EDGE LINE BREAKS AND RADIUS FOR TOWN HIGHWAYS)

MT. HOLLY:
STA. 0+020.0 - STA. 0+560.0, LT & RT

646.60 TEMPORARY 100 mm WHITE LINE
(ALL LINES WILL INCLUDE EDGE LINE BREAKS AND RADIUS FOR TOWN HIGHWAYS)

MT. HOLLY:
STA. 0+020.0 - STA. 0+560.0, LT & RT

646.41 DURABLE 100 mm YELLOW LINE
(ALL LINES WILL INCLUDE C/L BREAKS FOR TOWN HIGHWAYS) S=SOLID, D=DASHED

MT. HOLLY: 0+048 LT C RT
STA. 0+020.0 - STA. ~~0+085.0~~ S - S
0+048 STA. ~~0+085.0~~ - STA. 0+289.7 S - D
STA. 0+289.7 - STA. 0+560.0 - D -


646.61 TEMPORARY 100 mm YELLOW LINE
(ALL LINES WILL INCLUDE C/L BREAKS FOR TOWN HIGHWAYS) S=SOLID, D=DASHED

MT. HOLLY: LT C RT
STA. 0+020.0 - STA. 0+085.0 S - S
STA. 0+085.0 - STA. 0+289.7 S - D
STA. 0+289.7 - STA. 0+560.0 - D -

675.50 REMOVING SIGNS

AS SHOWN - 3

BB 12/23/04

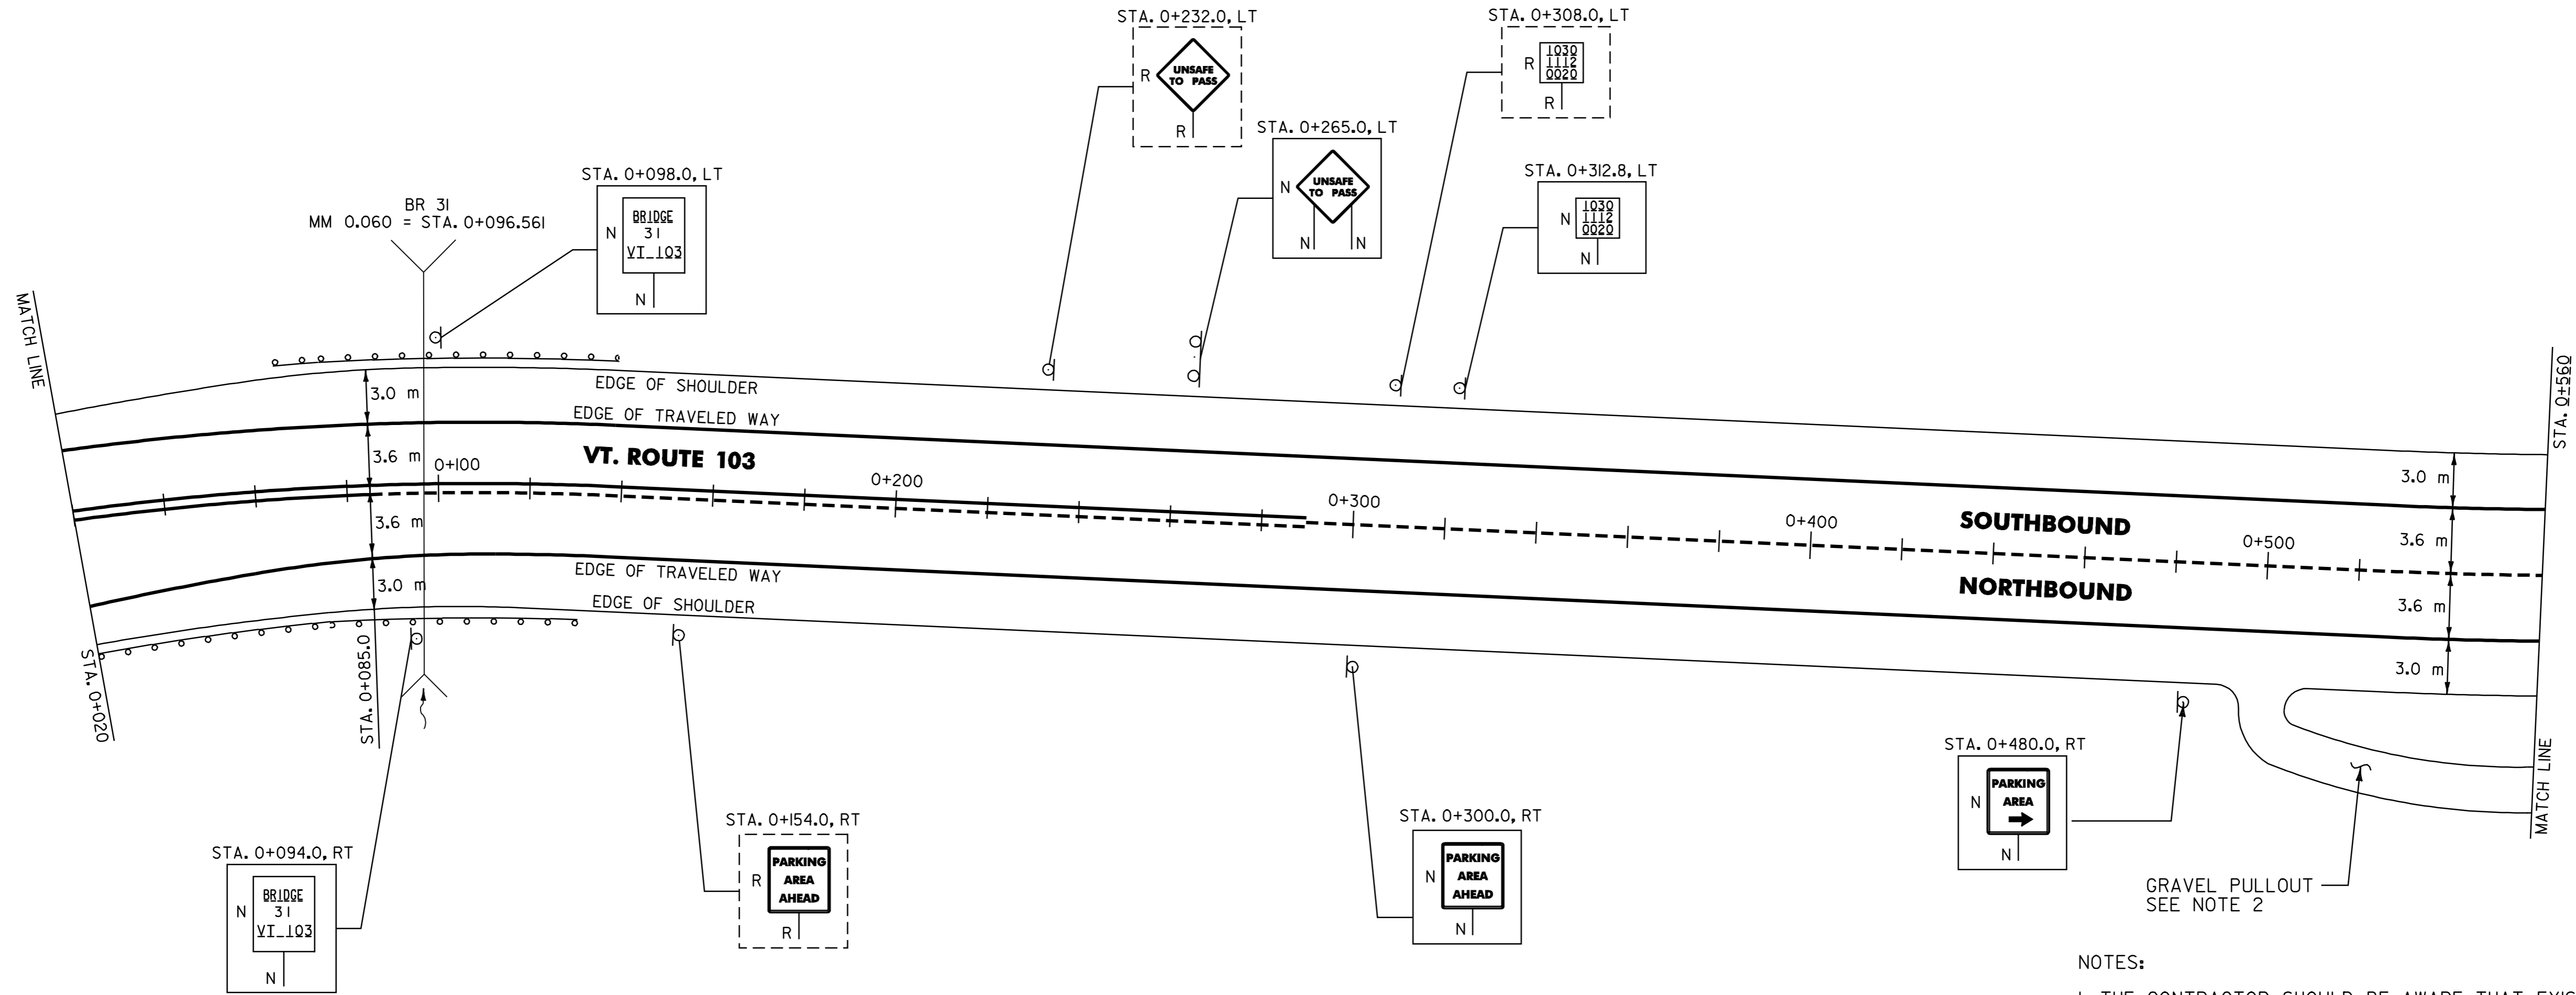

NOTES:

1. THE CONTRACTOR SHOULD BE AWARE THAT EXISTING BURIED UTILITIES (SUCH AS PHONE CABLE, FIBER OPTIC CABLE, SEWER LINES, ETC.) ARE LOCATED ADJACENT TO VT. ROUTE 103 WITHIN THE PROJECT LIMITS. THE CONTRACTOR IS RESPONSIBLE FOR CONTACTING "DIG SAFE" AT 1-888-344-7233 TO DETERMINE THE EXACT LOCATIONS OF THESE UTILITIES PRIOR TO INSTALLING GUARDRAIL, CLEANING DITCHES OR PERFORMING ANY OTHER OPERATIONS THAT MAY DISTURB THE EXISTING SUBSURFACE CONDITIONS.
2. PLACE 100 mm OF COMPACTED COLD PLANE GRINDINGS ON THE EXISTING GRAVEL PULLOUT AND PROVIDE A 30 mm TYPE IVS 1.5 m WIDE APRON. ANY REQUIRED EXCAVATION SHALL BE PERFORMED AS DIRECTED BY THE RESIDENT ENGINEER AND PAID UNDER ITEM 608.25.

ARCHIVED
ON CADD

616.35 TREATED TIMBER CURB RMT 11/30/04
MT. HOLLY:
STA. 0+020.0 - ~~STA. 0+083.9 RT (63.9 m)~~
STA. 0+047.4 RT (27.4m)

621.20 STEEL BEAM GUARDRAIL
MT. HOLLY:
STA. 0+020.0 - STA. 0+112.5 RT (92.5 m)
STA. 0+079.4 - STA. 0+128.8 LT (49.4 m)

621.505 MANUFACTURED TERMINAL SECTION (FLARED)
MT. HOLLY:
STA. 0+112.5 RT
STA. 0+079.4 LT
STA. 0+0128.8 LT

621.80 REMOVAL AND DISPOSAL OF GUARDRAIL
MT. HOLLY:
STA. 0+020.0 - STA. 0+122.0 RT (102.0 m)
STA. 0+068.0 - STA. 0+137.0 LT (69.0 m)

SIGN LEGEND

R= REMOVE
S= SALVAGE
N= NEW
RET= RETAIN
B-B= BACK TO BACK
EXISTING= _____
NEW= _____

**PAVING
PROJECT
LAYOUT
10**

SURVEYED BY	N/A	DATE	N/A
DRAWN BY	C.A.K.	DATE	
SQUAD LEADER	T.P.K.		
DESIGN FILE NO.	/pave/01b024/pb024.dgn		
IPARM FILE	pb02410.i	DATE PLOTTED	*DATE*
PROJ. NAME	LUDLOW - MT. HOLLY		
PROJ. NO.	NH_232711S		
SHEET	19	OF	84 SHEETS

DATUM
VERTICAL N/A
HORIZONTAL N/A