

646.40 DURABLE 100 mm WHITE LINE
(ALL LINES WILL INCLUDE EDGE LINE BREAKS AND RADIUS FOR TOWN HIGHWAYS)

MT. HOLLY:
STA. 4+340.0 - STA. 4+880.0, LT & RT

646.60 TEMPORARY 100 mm WHITE LINE
(ALL LINES WILL INCLUDE EDGE LINE BREAKS AND RADIUS FOR TOWN HIGHWAYS)

MT. HOLLY:
STA. 4+340.0 - STA. 4+880.0, LT & RT

BB 12/13/04
646.41 DURABLE 100 mm YELLOW LINE
(ALL LINES WILL INCLUDE C/L BREAKS FOR TOWN HIGHWAYS) S=SOLID, D=DASHED


4+249.8	STA. 4+380.0 - STA. 4+380.0	LT	□	RT
4+430	STA. 4+380.0 - STA. 4+510.0	S	-	S
4+528	STA. 4+510.0 - STA. 4+584.0	S	-	S
	STA. 4+584.0 - STA. 4+654.0	D	-	S
	STA. 4+654.0 - STA. 4+880.0	S	-	S

646.61 TEMPORARY 100 mm YELLOW LINE
(ALL LINES WILL INCLUDE C/L BREAKS FOR TOWN HIGHWAYS) S=SOLID, D=DASHED

	STA. 4+340.0 - STA. 4+380.0	LT	□	RT
	STA. 4+380.0 - STA. 4+510.0	S	-	D
	STA. 4+510.0 - STA. 4+584.0	-	D	-
	STA. 4+584.0 - STA. 4+654.0	D	-	S
	STA. 4+654.0 - STA. 4+880.0	S	-	S

675.50 REMOVING SIGNS
AS SHOWN - 7

676.60 ERECTING SALVAGED SIGNS
AS SHOWN - 1

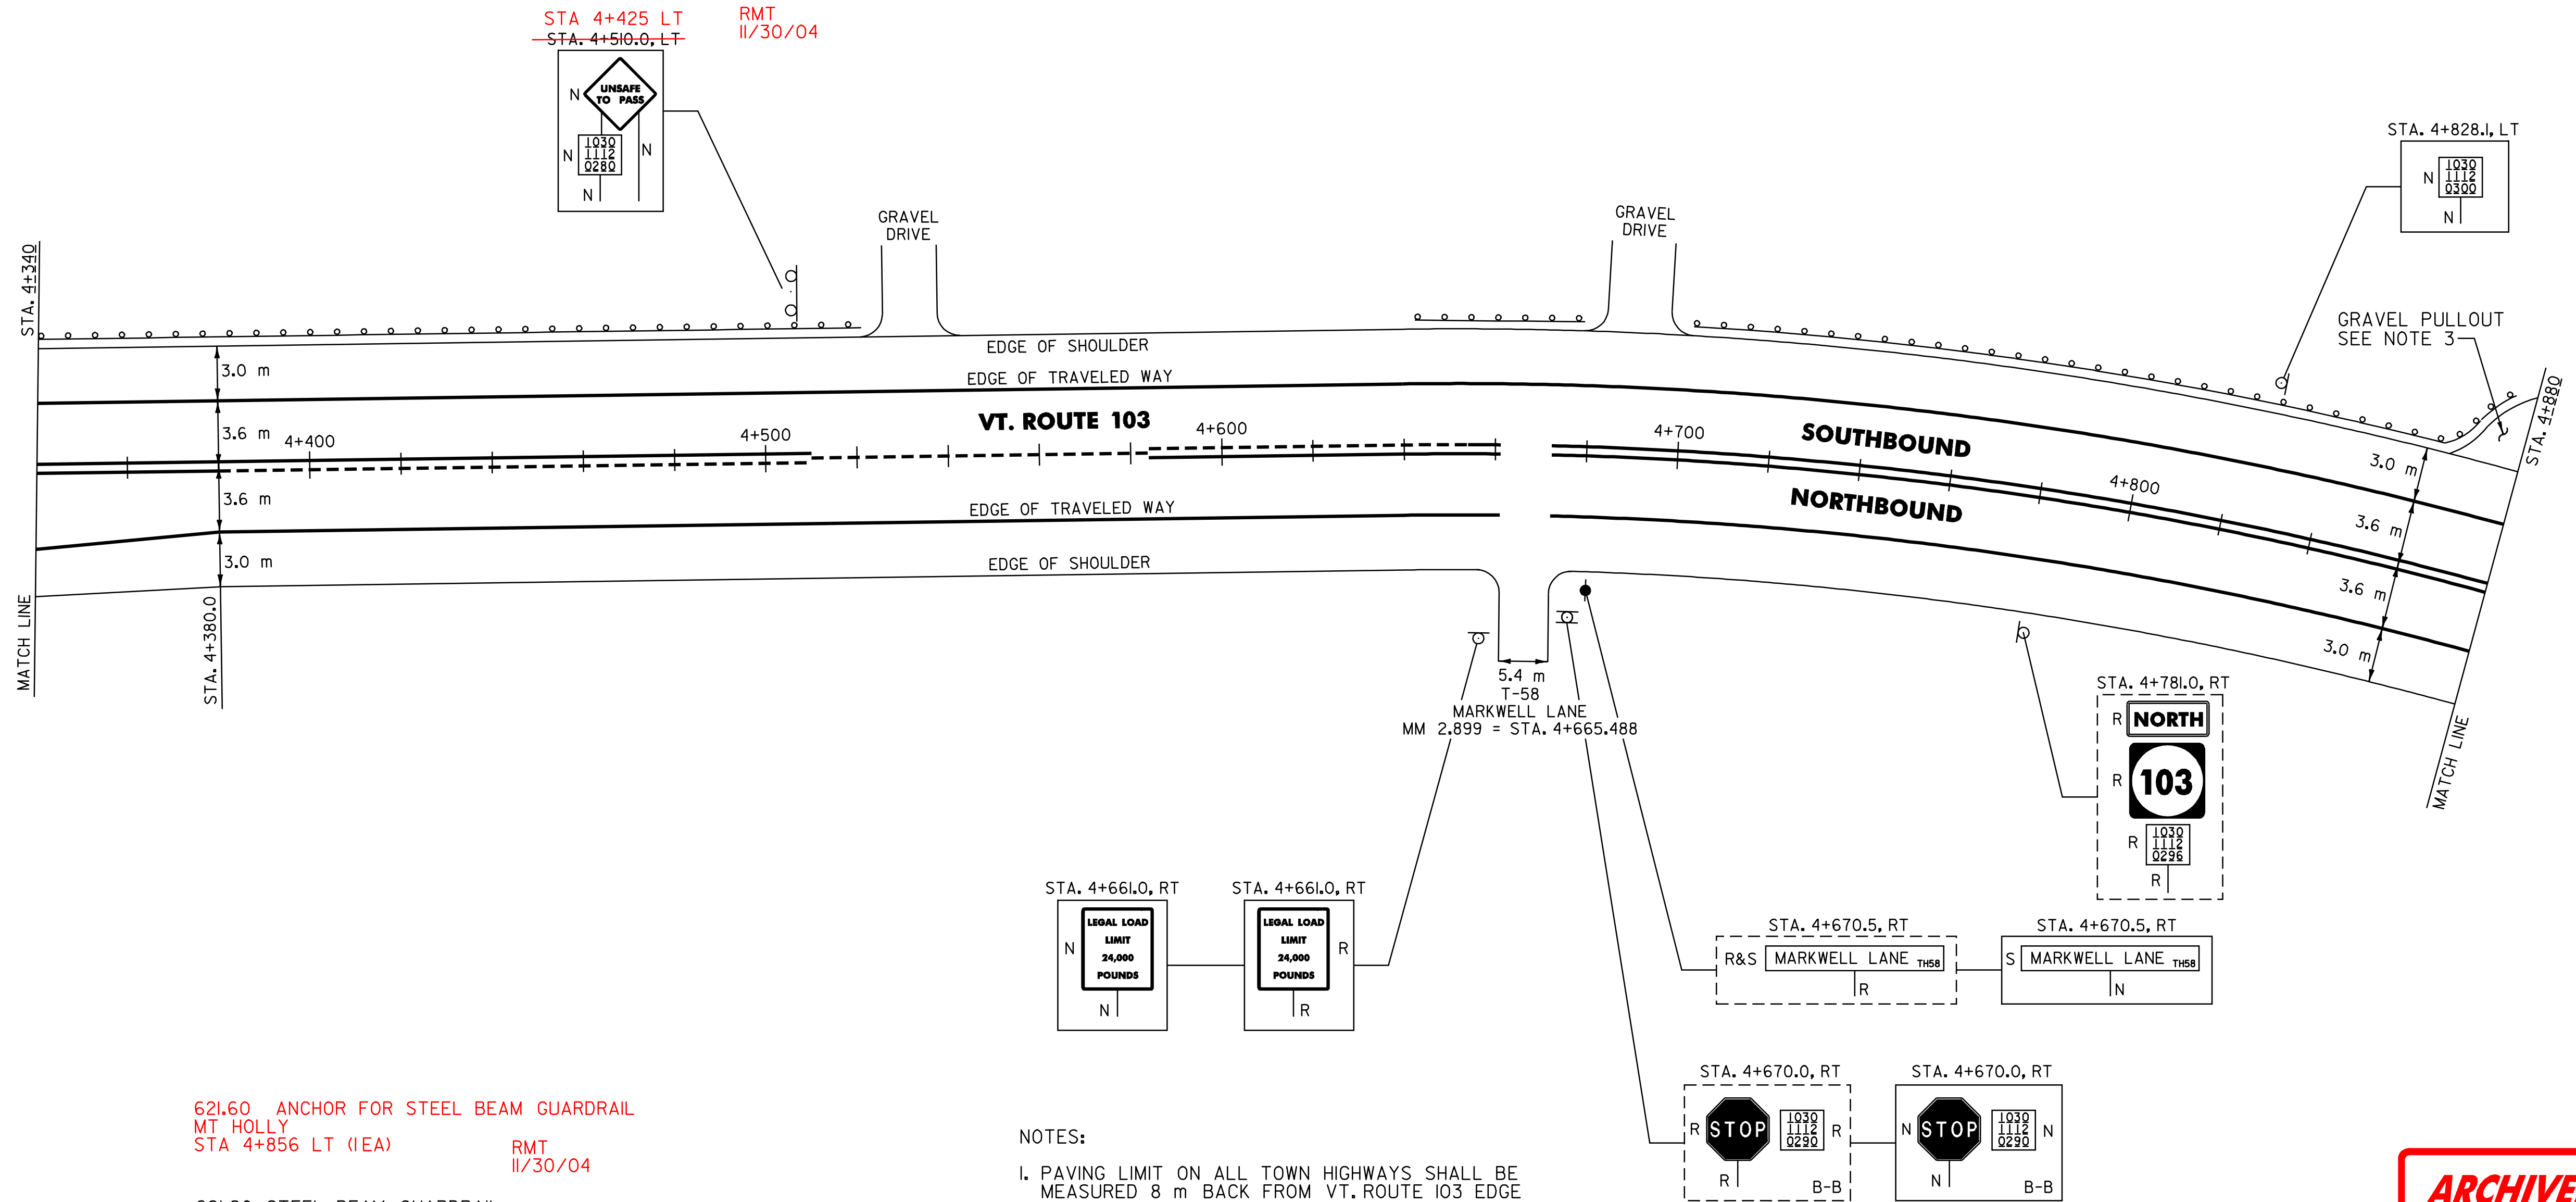

621.60 ANCHOR FOR STEEL BEAM GUARDRAIL
MT. HOLLY
STA 4+856 LT (1EA) RMT 11/30/04

621.20 STEEL BEAM GUARDRAIL
MT. HOLLY:
STA. 4+340.0 - STA. 4+515.6 LT (175.6 m)
STA. 4+651.6 - STA. 4+670.6 LT (19.0 m)
STA. 4+709.4 - STA. 4+861.4 LT (201.4 m)

621.505 MANUFACTURED TERMINAL SECTION (FLARED)
MT. HOLLY:
STA. 4+515.6 LT
STA. 4+651.6 LT
STA. 4+670.6 LT
STA. 4+709.4 LT
~~STA. 4+861.4 LT~~ NOT INSTALLED RMT 11/30/04

621.80 REMOVAL AND DISPOSAL OF GUARDRAIL
MT. HOLLY:
STA. 4+340.0 - STA. 4+527.0 LT (187.0 m)
STA. 4+641.0 - STA. 4+670.6 LT (41.0 m)
STA. 4+698.0 - STA. 4+859.0 LT (221.8 m)

NOTES:

- PAVING LIMIT ON ALL TOWN HIGHWAYS SHALL BE MEASURED 8 m BACK FROM VT. ROUTE 103 EDGE OF SHOULDER UNLESS DENOTED OTHERWISE ON THE PLANS OR AS DIRECTED BY THE RESIDENT ENGINEER.
- THE CONTRACTOR SHOULD BE AWARE THAT EXISTING BURIED UTILITIES (SUCH AS PHONE CABLE, FIBER OPTIC CABLE, SEWER LINES, ETC.) ARE LOCATED ADJACENT TO VT. ROUTE 103 WITHIN THE PROJECT LIMITS. THE CONTRACTOR IS RESPONSIBLE FOR CONTACTING "DIG SAFE" AT 1-888-344-7233 TO DETERMINE THE EXACT LOCATIONS OF THESE UTILITIES PRIOR TO INSTALLING GUARDRAIL, CLEANING DITCHES OR PERFORMING ANY OTHER OPERATIONS THAT MAY DISTURB THE EXISTING SUBSURFACE CONDITIONS.
- PLACE 100 mm OF COMPACTED COLD PLANE GRINDINGS ON THE EXISTING GRAVEL PULLOUT AND PROVIDE A 30 mm TYPE IVS 1.5 m WIDE APRON. ANY REQUIRED EXCAVATION SHALL BE PERFORMED AS DIRECTED BY THE RESIDENT ENGINEER AND PAID UNDER ITEM 608.25.

SIGN LEGEND
R= REMOVE
S= SALVAGE
N= NEW
RET= RETAIN
B-B= BACK TO BACK
EXISTING= _____
NEW= _____

ARCHIVED ON CADD

DATUM
VERTICAL N/A
HORIZONTAL N/A

PAVING PROJECT LAYOUT # 18

SURVEYED BY N/A DATE N/A
DRAWN BY C.A.K. DATE _____
SQUAD LEADER T.P.K.
DESIGN FILE NO. z:\pave\01b024\pb024.dgn
IPARM FILE pb024\IB.L DATE _____ PLOTTED \$DATE\$
PROJ. NAME LUDLOW - MT. HOLLY
PROJ. NO. NH_2327(1)S
SHEET 27 OF 84 SHEETS _____