


646.40 DURABLE 100 mm WHITE LINE  
 (ALL LINES WILL INCLUDE EDGE LINE BREAKS AND RADIUS FOR TOWN HIGHWAYS)  
 MT. HOLLY:  
 STA. 4+880.0 - STA. 5+420.0, LT & RT

646.41 DURABLE 100 mm YELLOW LINE  
 (ALL LINES WILL INCLUDE C/L BREAKS FOR TOWN HIGHWAYS) S=SOLID, D=DASHED  
 MT. HOLLY:  
 STA. 4+880.0 - STA. 5+420.0 LT C RT  
 S - - S

675.50 REMOVING SIGNS  
 AS SHOWN - I

646.60 TEMPORARY 100 mm WHITE LINE  
 (ALL LINES WILL INCLUDE EDGE LINE BREAKS AND RADIUS FOR TOWN HIGHWAYS)  
 MT. HOLLY:  
 STA. 4+880.0 - STA. 5+420.0, LT & RT

646.61 TEMPORARY 100 mm YELLOW LINE  
 (ALL LINES WILL INCLUDE C/L BREAKS FOR TOWN HIGHWAYS) S=SOLID, D=DASHED  
 MT. HOLLY:  
 STA. 4+880.0 - STA. 5+420.0 LT C RT  
 S - - S

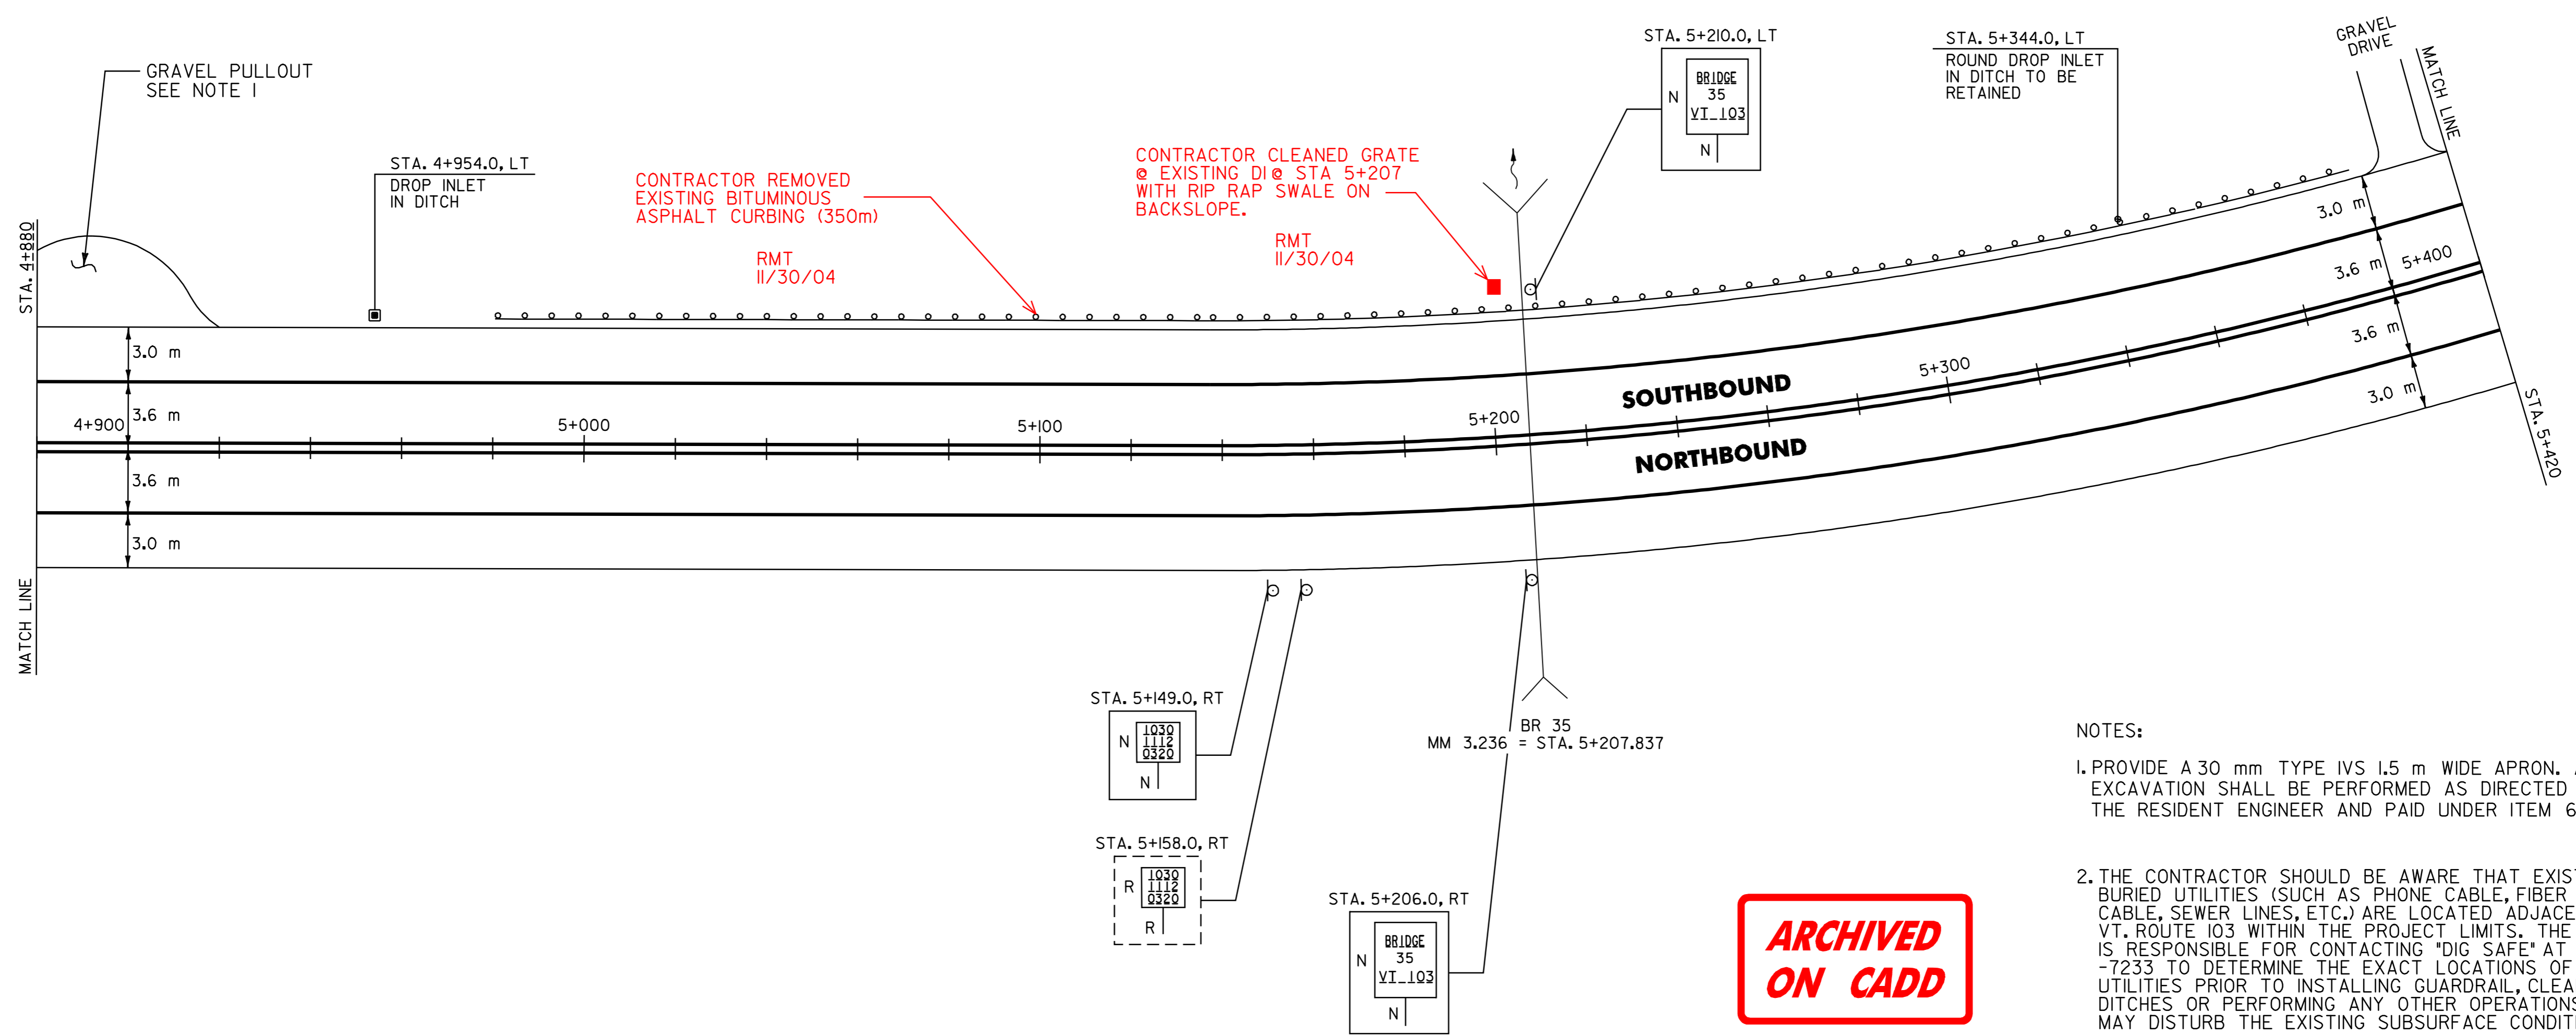

NOTES:  
 1. PROVIDE A 30 mm TYPE IVS 1.5 m WIDE APRON. ANY REQUIRED EXCAVATION SHALL BE PERFORMED AS DIRECTED BY THE RESIDENT ENGINEER AND PAID UNDER ITEM 608.25.  
 2. THE CONTRACTOR SHOULD BE AWARE THAT EXISTING BURIED UTILITIES (SUCH AS PHONE CABLE, FIBER OPTIC CABLE, SEWER LINES, ETC.) ARE LOCATED ADJACENT TO VT. ROUTE 103 WITHIN THE PROJECT LIMITS. THE CONTRACTOR IS RESPONSIBLE FOR CONTACTING "DIG SAFE" AT 1-888-344-7233 TO DETERMINE THE EXACT LOCATIONS OF THESE UTILITIES PRIOR TO INSTALLING GUARDRAIL, CLEANING DITCHES OR PERFORMING ANY OTHER OPERATIONS THAT MAY DISTURB THE EXISTING SUBSURFACE CONDITIONS.

621.20 STEEL BEAM GUARDRAIL  
 MT. HOLLY:  
 STA. 4+988.2 - STA. 5+379.6 LT (391.4 m)

621.60 ANCHOR FOR STEEL BEAM GUARDRAIL  
 MT. HOLLY  
 STA 4+987 LT (1EA) RMT 11/30/04

621.505 MANUFACTURED TERMINAL SECTION (FLARED)  
 MT. HOLLY:  
 STA. 4+988.2 LT - NOT INSTALLED RMT 11/30/04  
 STA. 5+379.6 LT

616.35 TREATED TIMBER CURB  
 MT. HOLLY  
 STA 5+020.5 ~ STA 5+354.2 LT (330.4m) RMT 11/30/04

621.80 REMOVAL AND DISPOSAL OF GUARDRAIL  
 MT. HOLLY:  
 STA. 4+979.0 - STA. 5+391.0 LT (412.0 m)

SIGN LEGEND  
 R= REMOVE  
 S= SALVAGE  
 N= NEW  
 RET= RETAIN  
 B-B= BACK TO BACK  
 EXISTING= \_\_\_\_\_  
 NEW= \_\_\_\_\_

<b>PAVING PROJECT LAYOUT # 19</b>	SURVEYED BY	N/A	DATE	N/A
	DRAWN BY	C.A.K.	DATE	
	SQUAD LEADER	T.P.K.		
	DESIGN FILE NO.	pave/01b024/pb024.dgn		
	IPARM FILE	pb02419.i	DATE PLOTTED	\$DATE\$
PROJ. NAME	LUDLOW - MI. HOLLY			
PROJ. NO.	NH_2327(I)S			
SHEET	28	OF	84	SHEETS

DATUM	
VERTICAL	N/A
HORIZONTAL	N/A