

646.40 DURABLE 100 mm WHITE LINE
(ALL LINES WILL INCLUDE EDGE LINE BREAKS AND RADIUS FOR TOWN HIGHWAYS)

MT. HOLLY:
STA. 7+580.0 - STA. 8+120.0, LT & RT

646.60 TEMPORARY 100 mm WHITE LINE
(ALL LINES WILL INCLUDE EDGE LINE BREAKS AND RADIUS FOR TOWN HIGHWAYS)

MT. HOLLY:
STA. 7+580.0 - STA. 8+120.0, LT & RT


646.41 DURABLE 100 mm YELLOW LINE
(ALL LINES WILL INCLUDE C/L BREAKS FOR TOWN HIGHWAYS) S=SOLID, D=DASHED

MT. HOLLY: LT CL RT
STA. 7+580.0 - STA. 7+644.4 D - S
STA. 7+644.4 - STA. 7+853.6 S - S
STA. 7+853.6 - STA. 7+998.4 S - D
STA. 7+998.4 - STA. 8+095.0 8+143 D - S
8+143 - STA. 8+095.0 - STA. 8+120.0 D - S

646.61 TEMPORARY 100 mm YELLOW LINE
(ALL LINES WILL INCLUDE C/L BREAKS FOR TOWN HIGHWAYS) S=SOLID, D=DASHED

MT. HOLLY: LT CL RT
STA. 7+580.0 - STA. 7+644.4 D - S
STA. 7+644.4 - STA. 7+853.6 S - S
STA. 7+853.6 - STA. 7+998.4 S - D
STA. 7+998.4 - STA. 8+095.0 D - S
STA. 8+095.0 - STA. 8+120.0 D - S

675.50 REMOVING SIGNS
AS SHOWN - 4

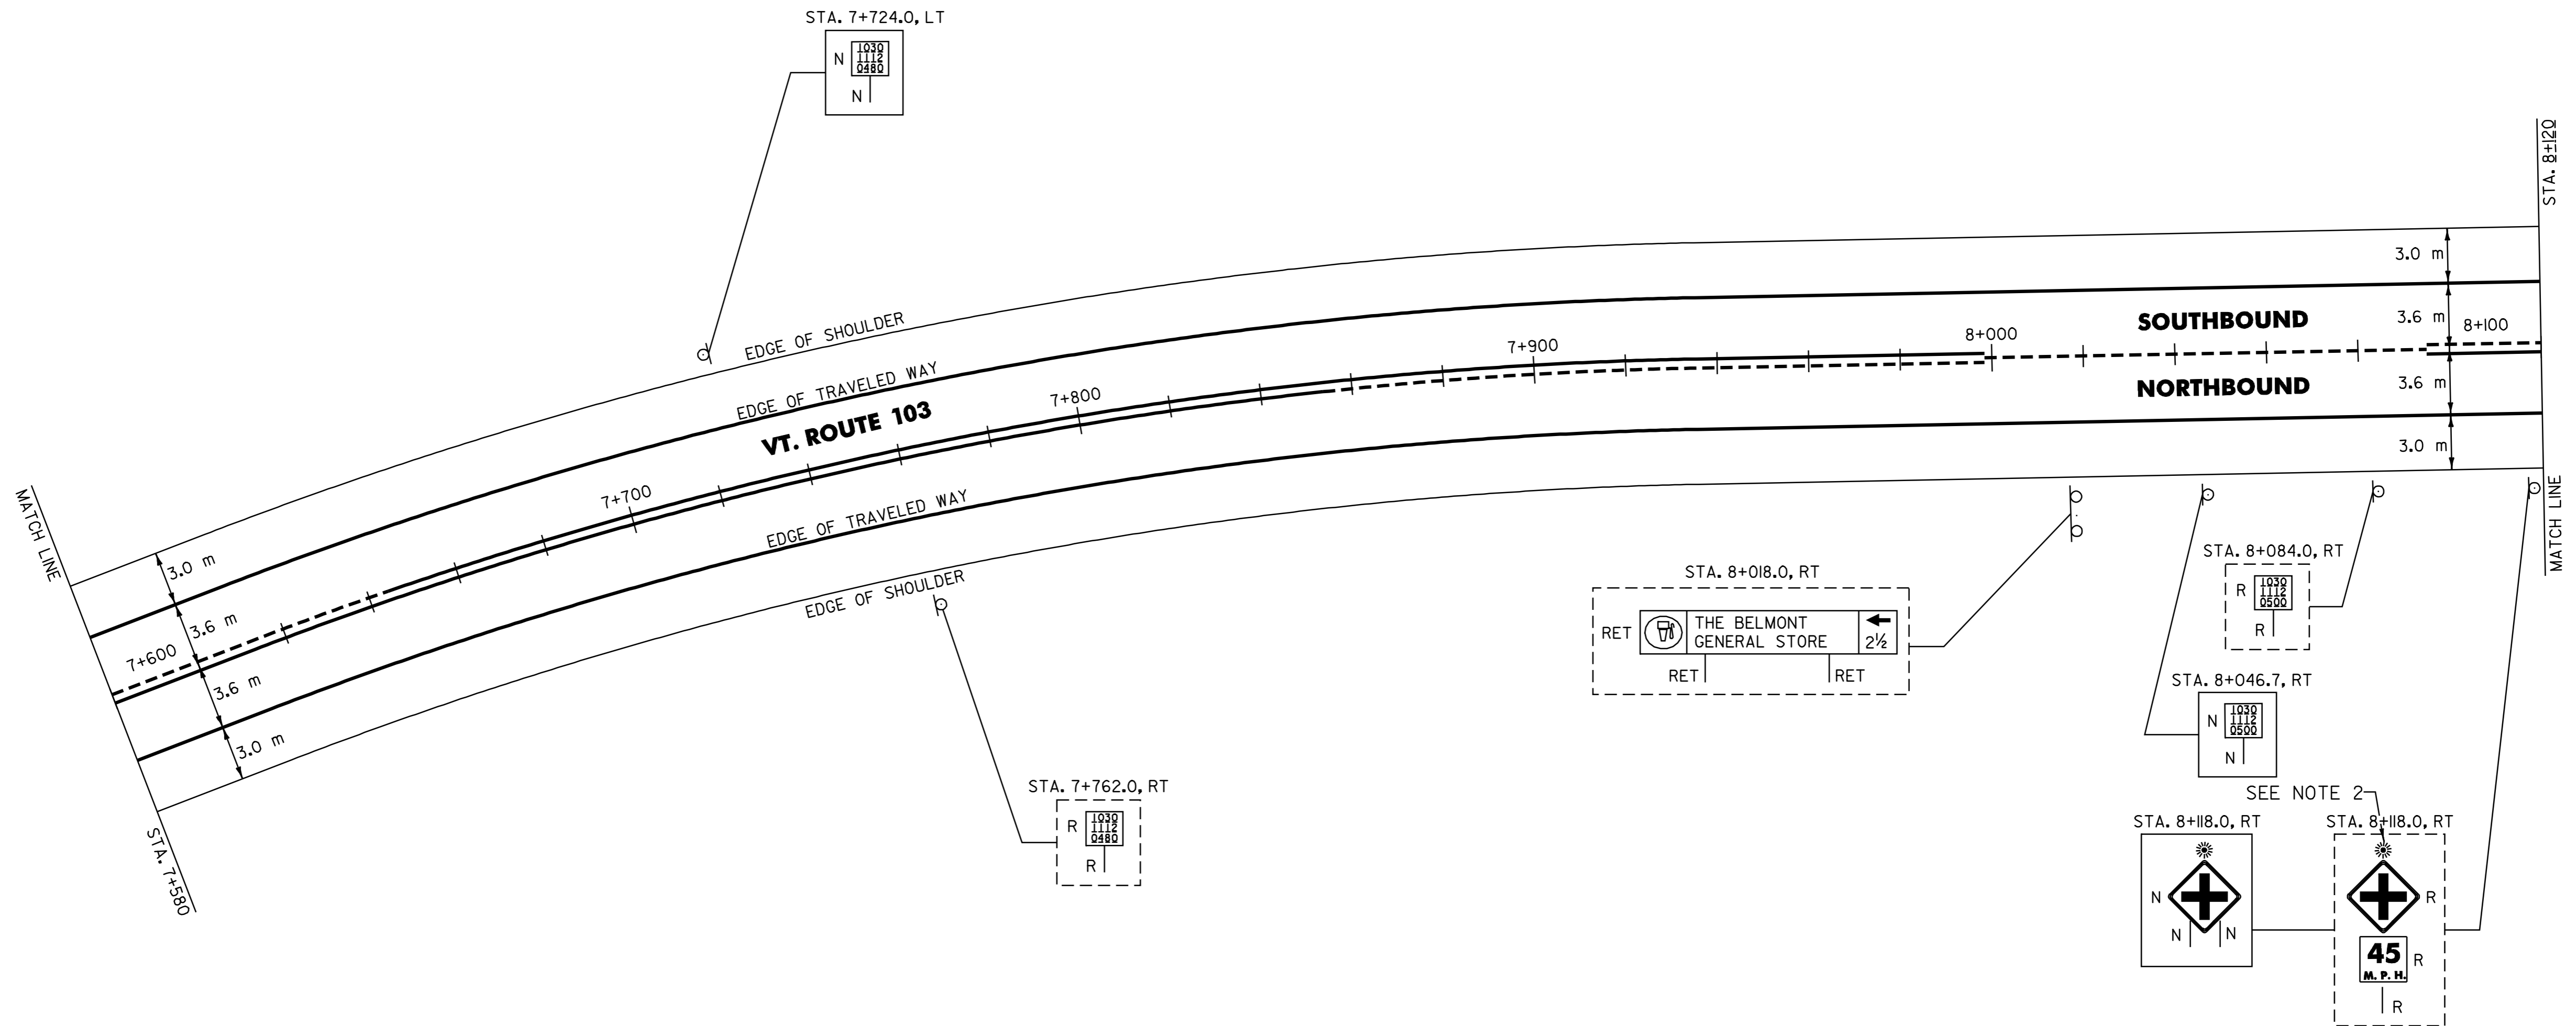

NOTE:

1. THE CONTRACTOR SHOULD BE AWARE THAT EXISTING BURIED UTILITIES (SUCH AS PHONE CABLE, FIBER OPTIC CABLE, SEWER LINES, ETC.) ARE LOCATED ADJACENT TO VT. ROUTE 103 WITHIN THE PROJECT LIMITS. THE CONTRACTOR IS RESPONSIBLE FOR CONTACTING "DIG SAFE" AT 1-888-344-7233 TO DETERMINE THE EXACT LOCATIONS OF THESE UTILITIES PRIOR TO INSTALLING GUARDRAIL, CLEANING DITCHES OR PERFORMING ANY OTHER OPERATIONS THAT MAY DISTURB THE EXISTING SUBSURFACE CONDITIONS.
2. REMOVE EXISTING FLASHING BEACON AND INSTALL ON NEW SIGN ASSEMBLY. THIS WORK TO BE PAID FOR AS ITEM 676.16 FLASHING BEACON-GROUND MOUNTED (MOD.)

SIGN LEGEND

- R= REMOVE
- S= SALVAGE
- N= NEW
- RET= RETAIN
- B-B= BACK TO BACK
- EXISTING= _____
- NEW= _____

DATUM	
VERTICAL	N/A
HORIZONTAL	N/A

**PAVING
PROJECT
LAYOUT
24**

SURVEYED BY	N/A	DATE	N/A
DRAWN BY	C.A.K.	DATE	
SQUAD LEADER	T.P.K.		
DESIGN FILE NO.	/pave/01b024/pb024.dgn		
IPARM FILE	pb024i24.i	DATE PLOTTED	\$DATE\$
PROJ. NAME	LUDLOW - MT. HOLLY		
PROJ. NO.	NH_2327(I)S		
SHEET	33	OF	84 SHEETS

**ARCHIVED
ON CADD**