

646.40 DURABLE 100 mm WHITE LINE
 (ALL LINES WILL INCLUDE EDGE LINE BREAKS AND RADIUS FOR TOWN HIGHWAYS)
 MT. HOLLY:
 STA. 8+120.0 - STA. 8+660.0, LT & RT

646.60 TEMPORARY 100 mm WHITE LINE
 (ALL LINES WILL INCLUDE EDGE LINE BREAKS AND RADIUS FOR TOWN HIGHWAYS)
 MT. HOLLY:
 STA. 8+120.0 - STA. 8+660.0, LT & RT

646.41 DURABLE 100 mm YELLOW LINE
 (ALL LINES WILL INCLUDE C/L BREAKS FOR TOWN HIGHWAYS) S=SOLID, D=DASHED
 MT. HOLLY:
 STA. 8+120.0 - STA. 8+352.0 D - RT S
 STA. 8+352.0 - STA. 8+660.0 S - S
 STA. 8+495.727 DOUBLE SOLID LT, T-I
 STA. 8+495.727 DOUBLE SOLID RT, T-I

646.61 TEMPORARY 100 mm YELLOW LINE
 (ALL LINES WILL INCLUDE C/L BREAKS FOR TOWN HIGHWAYS) S=SOLID, D=DASHED
 MT. HOLLY:
 STA. 8+120.0 - STA. 8+352.0 D - RT S
 STA. 8+352.0 - STA. 8+660.0 S - S
 STA. 8+495.727 DOUBLE SOLID LT, T-I
 STA. 8+495.727 DOUBLE SOLID RT, T-I

646.46 DURABLE 600 mm STOP BAR
 MT. HOLLY:
 STA. 8+495.727 LT, T-I
 STA. 8+495.727 RT, T-I

646.66 TEMPORARY 600 mm STOP BAR
 MT. HOLLY:
 STA. 8+495.727 LT, T-I
 STA. 8+495.727 RT, T-I

646.50 DURABLE LETTER OR SYMBOL
 MT. HOLLY:
 STA. 8+495.727 LT, T-I, "S,T,O,P" (4 EA)
 STA. 8+495.727 RT, T-I, "S,T,O,P" (4 EA)


646.70 TEMPORARY LETTER OR SYMBOL
 MT. HOLLY:
 STA. 8+495.727 LT, T-I, "S,T,O,P" (4 EA)
 STA. 8+495.727 RT, T-I, "S,T,O,P" (4 EA)

675.50 REMOVING SIGNS
 AS SHOWN - 25

675.60 ERECTING SALVAGED SIGNS
 AS SHOWN - 2

BB
 12/13/04

8+371

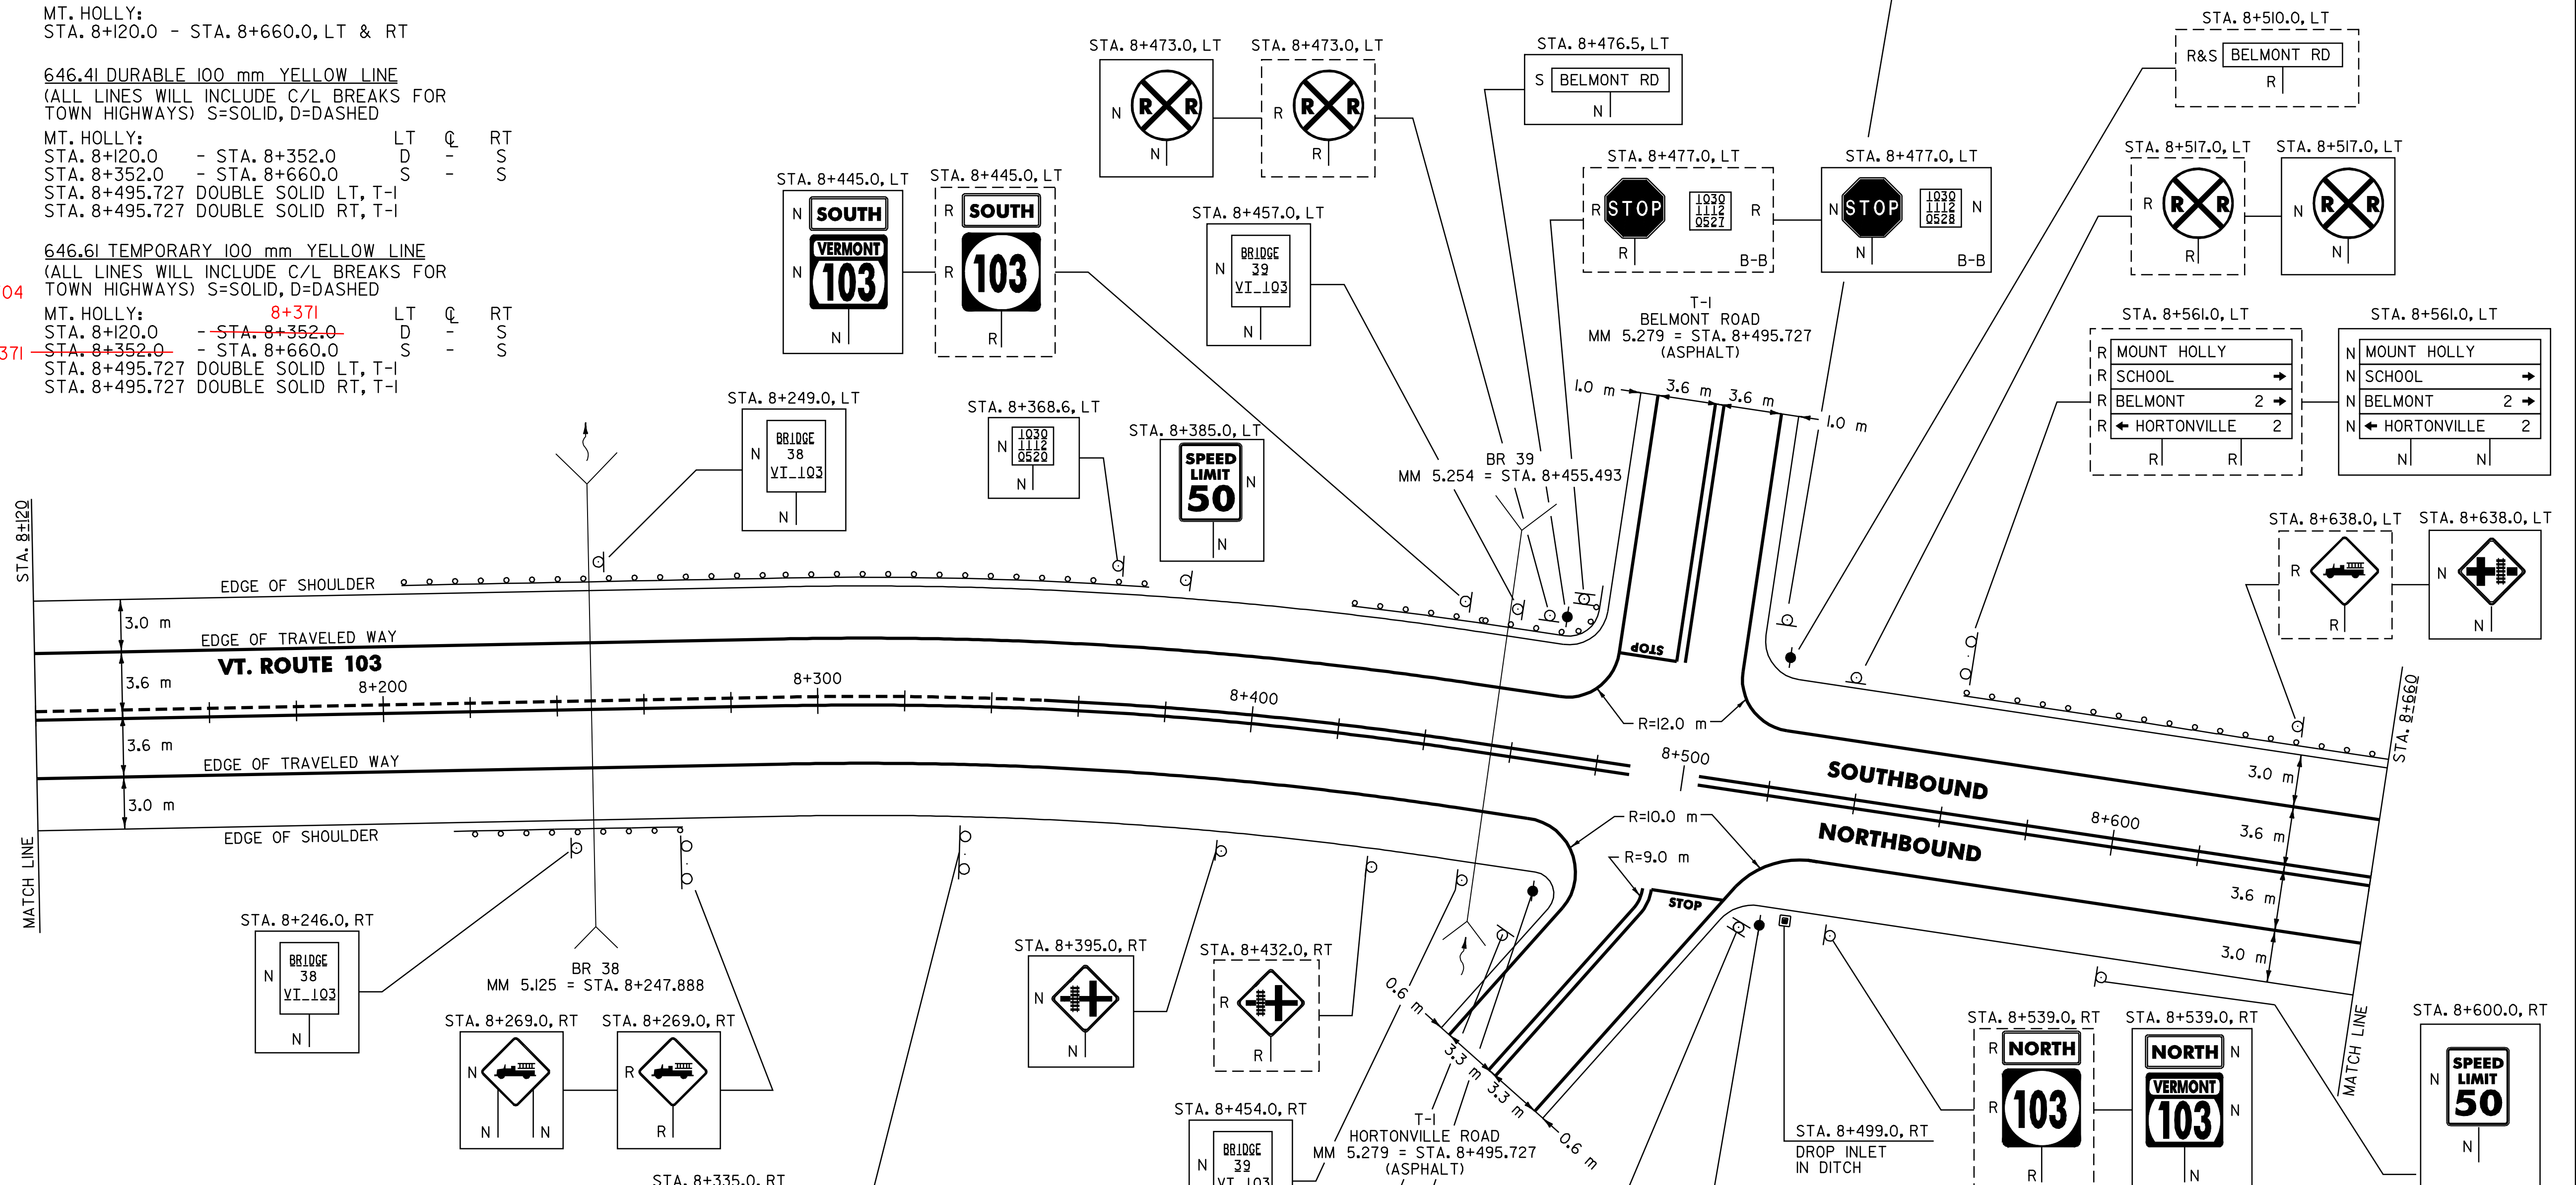

621.60 ANCHORS FOR STEEL BEAM GUARDRAIL
 MT HOLLY
 STA 8+476 & STA 8+480 LT (2 EA) RMT
 11/30/04

STA 8+231.7
 621.20 STEEL BEAM GUARDRAIL
 MT. HOLLY:
 STA. 8+197.6 - STA. 8+277.4 RT (79.8 m) (45.7)
 STA. 8+214.2 - STA. 8+290.2 LT (76.0 m)
 STA. 8+425.6 - STA. 8+475.0 LT (60.8 m)
 STA. 8+577.2 - STA. 8+660.0 LT (82.8 m) RMT
 11/30/04

621.20 STEEL BEAM GUARDRAIL WITH 2.4 m POSTS (MOD.)
 MT. HOLLY:
 STA. 8+290.2 - STA. 8+358.6 LT (68.4 m)

621.505 MANUFACTURED TERMINAL SECTION (FLARED)
 MT. HOLLY:
 STA. 8+197.6 RT
 STA. 8+237.0 LT
 STA. 8+277.4 RT
 STA. 8+358.6 LT
 STA. 8+425.6 LT
 STA. 8+475.0 LT NOT INSTALLED
 STA. 8+577.2 LT RMT
 11/30/04

621.80 REMOVAL AND DISPOSAL OF GUARDRAIL
 MT. HOLLY:
 STA. 8+229.0 - STA. 8+263.0 RT (34.0 m)
 STA. 8+232.0 - STA. 8+370.0 LT (138.0 m)
 STA. 8+417.0 - STA. 8+475.0 LT (80.8 m)
 STA. 8+567.0 - STA. 8+660.0 LT (93.0 m)

NOTES:
 1. PAVING LIMIT ON ALL TOWN HIGHWAYS SHALL BE MEASURED 8 m BACK FROM VT. ROUTE 103 EDGE OF SHOULDER UNLESS DENOTED OTHERWISE ON THE PLANS OR AS DIRECTED BY THE RESIDENT ENGINEER.
 2. THE CONTRACTOR SHOULD BE AWARE THAT EXISTING BURIED UTILITIES (SUCH AS PHONE CABLE, FIBER OPTIC CABLE, SEWER LINES, ETC.) ARE LOCATED ADJACENT TO VT. ROUTE 103 WITHIN THE PROJECT LIMITS. THE CONTRACTOR IS RESPONSIBLE FOR CONTACTING "DIG SAFE" AT 1-888-344-7233 TO DETERMINE THE EXACT LOCATIONS OF THESE UTILITIES PRIOR TO INSTALLING GUARDRAIL, CLEANING DITCHES OR PERFORMING ANY OTHER OPERATIONS THAT MAY DISTURB THE EXISTING SUBSURFACE CONDITIONS.

**ARCHIVED
 ON CADD**

DATUM	
VERTICAL	N/A
HORIZONTAL	N/A

SIGN LEGEND
 R= REMOVE
 S= SALVAGE
 N= NEW
 RET= RETAIN
 B-B= BACK TO BACK
 EXISTING= _____
 NEW= _____

PAVING PROJECT LAYOUT # 25	SURVEYED BY	N/A	DATE	N/A
	DRAWN BY	C.A.K.	DATE	
	SQUAD LEADER	T.P.K.		
	DESIGN FILE NO.	/pave/01b024/pb024.dgn		
	IPARM FILE	pb024125-1	DATE PLOTTED	\$DATE\$
PROJ. NAME	LUDLOW - MT. HOLLY			
PROJ. NO.	NH_232111S			
SHEET	34	OF	84	SHEETS