

646.40 DURABLE 100 mm WHITE LINE  
(ALL LINES WILL INCLUDE EDGE LINE BREAKS AND RADIUS FOR TOWN HIGHWAYS)

MT. HOLLY:  
STA. 8+660.0 - STA. 9+200.0, LT & RT

646.60 TEMPORARY 100 mm WHITE LINE  
(ALL LINES WILL INCLUDE EDGE LINE BREAKS AND RADIUS FOR TOWN HIGHWAYS)

MT. HOLLY:  
STA. 8+660.0 - STA. 9+200.0, LT & RT


646.41 DURABLE 100 mm YELLOW LINE  
(ALL LINES WILL INCLUDE C/L BREAKS FOR TOWN HIGHWAYS) S=SOLID, D=DASHED

MT. HOLLY:  
STA. 8+660.0 - STA. 9+200.0 LT C RT  
S - S

646.61 TEMPORARY 100 mm YELLOW LINE  
(ALL LINES WILL INCLUDE C/L BREAKS FOR TOWN HIGHWAYS) S=SOLID, D=DASHED

MT. HOLLY:  
STA. 8+660.0 - STA. 9+200.0 LT C RT  
S - S

675.50 REMOVING SIGNS  
AS SHOWN - 3

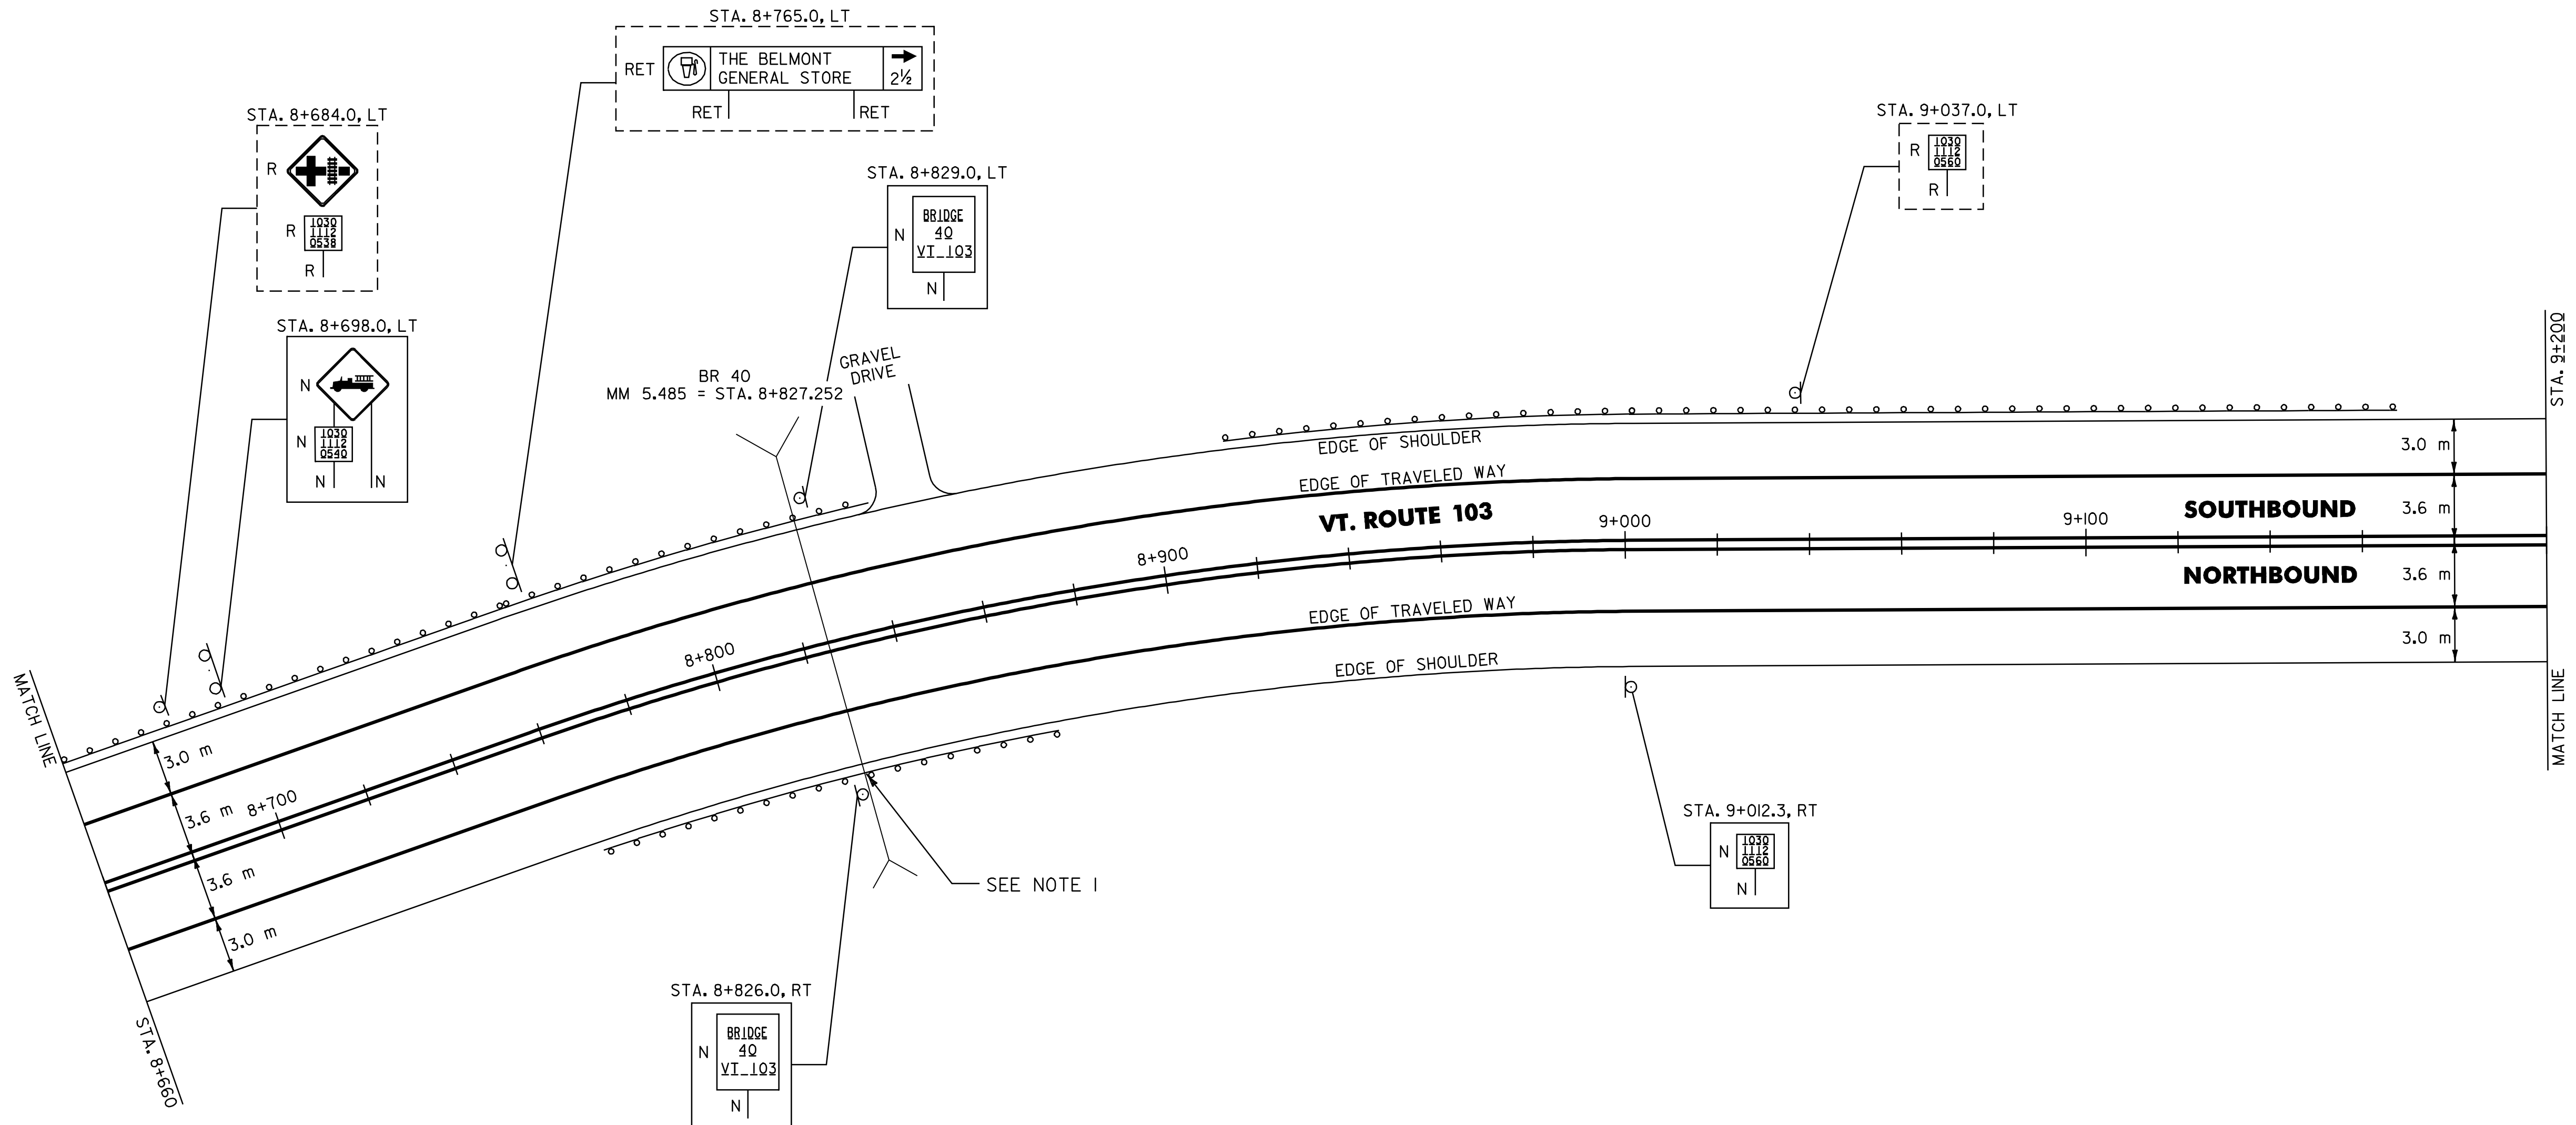

621.20 STEEL BEAM GUARDRAIL  
MT. HOLLY:  
STA. 8+660.0 - STA. 8+835.6 LT (175.6 m)  
STA. 8+777.9 - STA. 8+857.7 RT (79.8 m)  
~~STA. 8+927.4 - STA. 9+151.6 LT (224.2 m) (217.2m)~~  
STA. 8+920.4  
RMT 11/30/04

621.505 MANUFACTURED TERMINAL SECTION (FLARED)  
MT. HOLLY:  
STA. 8+777.9 RT  
STA. 8+835.6 RT  
~~STA. 8+857.7 LT NOT INSTALLED~~ RMT 11/30/04  
STA. 8+927.4 LT  
STA. 9+151.6 LT

621.80 REMOVAL AND DISPOSAL OF GUARDRAIL  
MT. HOLLY:  
STA. 8+660.0 - STA. 8+847.0 LT (187.0 m)  
STA. 8+797.0 - STA. 8+843.0 RT (46.0 m)  
STA. 8+917.0 - STA. 9+162.0 LT (245.0 m)

601.0915 450mm CPEP RMT 11/30/04  
MT HOLLY  
STA 8+840 ~ STA 8+846 RT (6.10m)

621.60 ANCHOR FOR STEEL BEAM GUARDRAIL  
MT HOLLY  
STA 8+842 LT (1EA) RMT 11/30/04

**ARCHIVED  
ON CADD**

SIGN LEGEND  
R= REMOVE  
S= SALVAGE  
N= NEW  
RET= RETAIN  
B-B= BACK TO BACK  
EXISTING= \_\_\_\_\_  
NEW= \_\_\_\_\_

- NOTES:
- SEE SHEET 84 OF 84 FOR STEEL BEAM GUARDRAIL AT SMALL CULVERTS DETAIL.
  - THE CONTRACTOR SHOULD BE AWARE THAT EXISTING BURIED UTILITIES (SUCH AS PHONE CABLE, FIBER OPTIC CABLE, SEWER LINES, ETC.) ARE LOCATED ADJACENT TO VT. ROUTE 103 WITHIN THE PROJECT LIMITS. THE CONTRACTOR IS RESPONSIBLE FOR CONTACTING "DIG SAFE" AT 1-888-344-7233 TO DETERMINE THE EXACT LOCATIONS OF THESE UTILITIES PRIOR TO INSTALLING GUARDRAIL, CLEANING DITCHES OR PERFORMING ANY OTHER OPERATIONS THAT MAY DISTURB THE EXISTING SUBSURFACE CONDITIONS.

DATUM  
VERTICAL N/A  
HORIZONTAL N/A

<b>PAVING PROJECT LAYOUT # 26</b>	SURVEYED BY <u>N/A</u> DATE <u>N/A</u>
	DRAWN BY <u>C.A.K.</u> DATE _____
	SQUAD LEADER <u>T.P.K.</u>
	DESIGN FILE NO. <u>lpave/01b024/pb024.dgn</u>
	IPARM FILE <u>pb024i26.i</u> DATE PLOTTED <u>\$DATE\$</u>
PROJ. NAME <u>LUJLOW -- MT. HOLLY</u>	
PROJ. NO. <u>NH_2327(1)S</u>	
SHEET <u>35</u> OF <u>84</u> SHEETS _____	