

646.40 DURABLE 100 mm WHITE LINE
(ALL LINES WILL INCLUDE EDGE LINE BREAKS AND RADIUS FOR TOWN HIGHWAYS)

MT. HOLLY:
STA. 9+740.0 - STA. 10+280.0 LT & RT

646.60 TEMPORARY 100 mm WHITE LINE
(ALL LINES WILL INCLUDE EDGE LINE BREAKS AND RADIUS FOR TOWN HIGHWAYS)

MT. HOLLY:
STA. 9+740.0 - STA. 10+280.0 LT & RT

646.41 DURABLE 100 mm YELLOW LINE
(ALL LINES WILL INCLUDE C/L BREAKS FOR TOWN HIGHWAYS) S=SOLID, D=DASHED

MT. HOLLY:
STA. 9+740.0 - STA. 9+752.0 9+771 LT - D G RT - S
9+771 - STA. 9+752.0 - STA. 9+900.0 10+017 D - S
10+017 - STA. 9+900.0 - STA. 10+280.0 S - S


BB 12/13/04

675.50 REMOVING SIGNS

AS SHOWN - 8

646.61 TEMPORARY 100 mm YELLOW LINE
(ALL LINES WILL INCLUDE C/L BREAKS FOR TOWN HIGHWAYS) S=SOLID, D=DASHED

MT. HOLLY:
STA. 9+740.0 - STA. 9+752.0 LT - D G RT - S
STA. 9+752.0 - STA. 9+900.0 D - S
STA. 9+900.0 - STA. 10+280.0 S - S

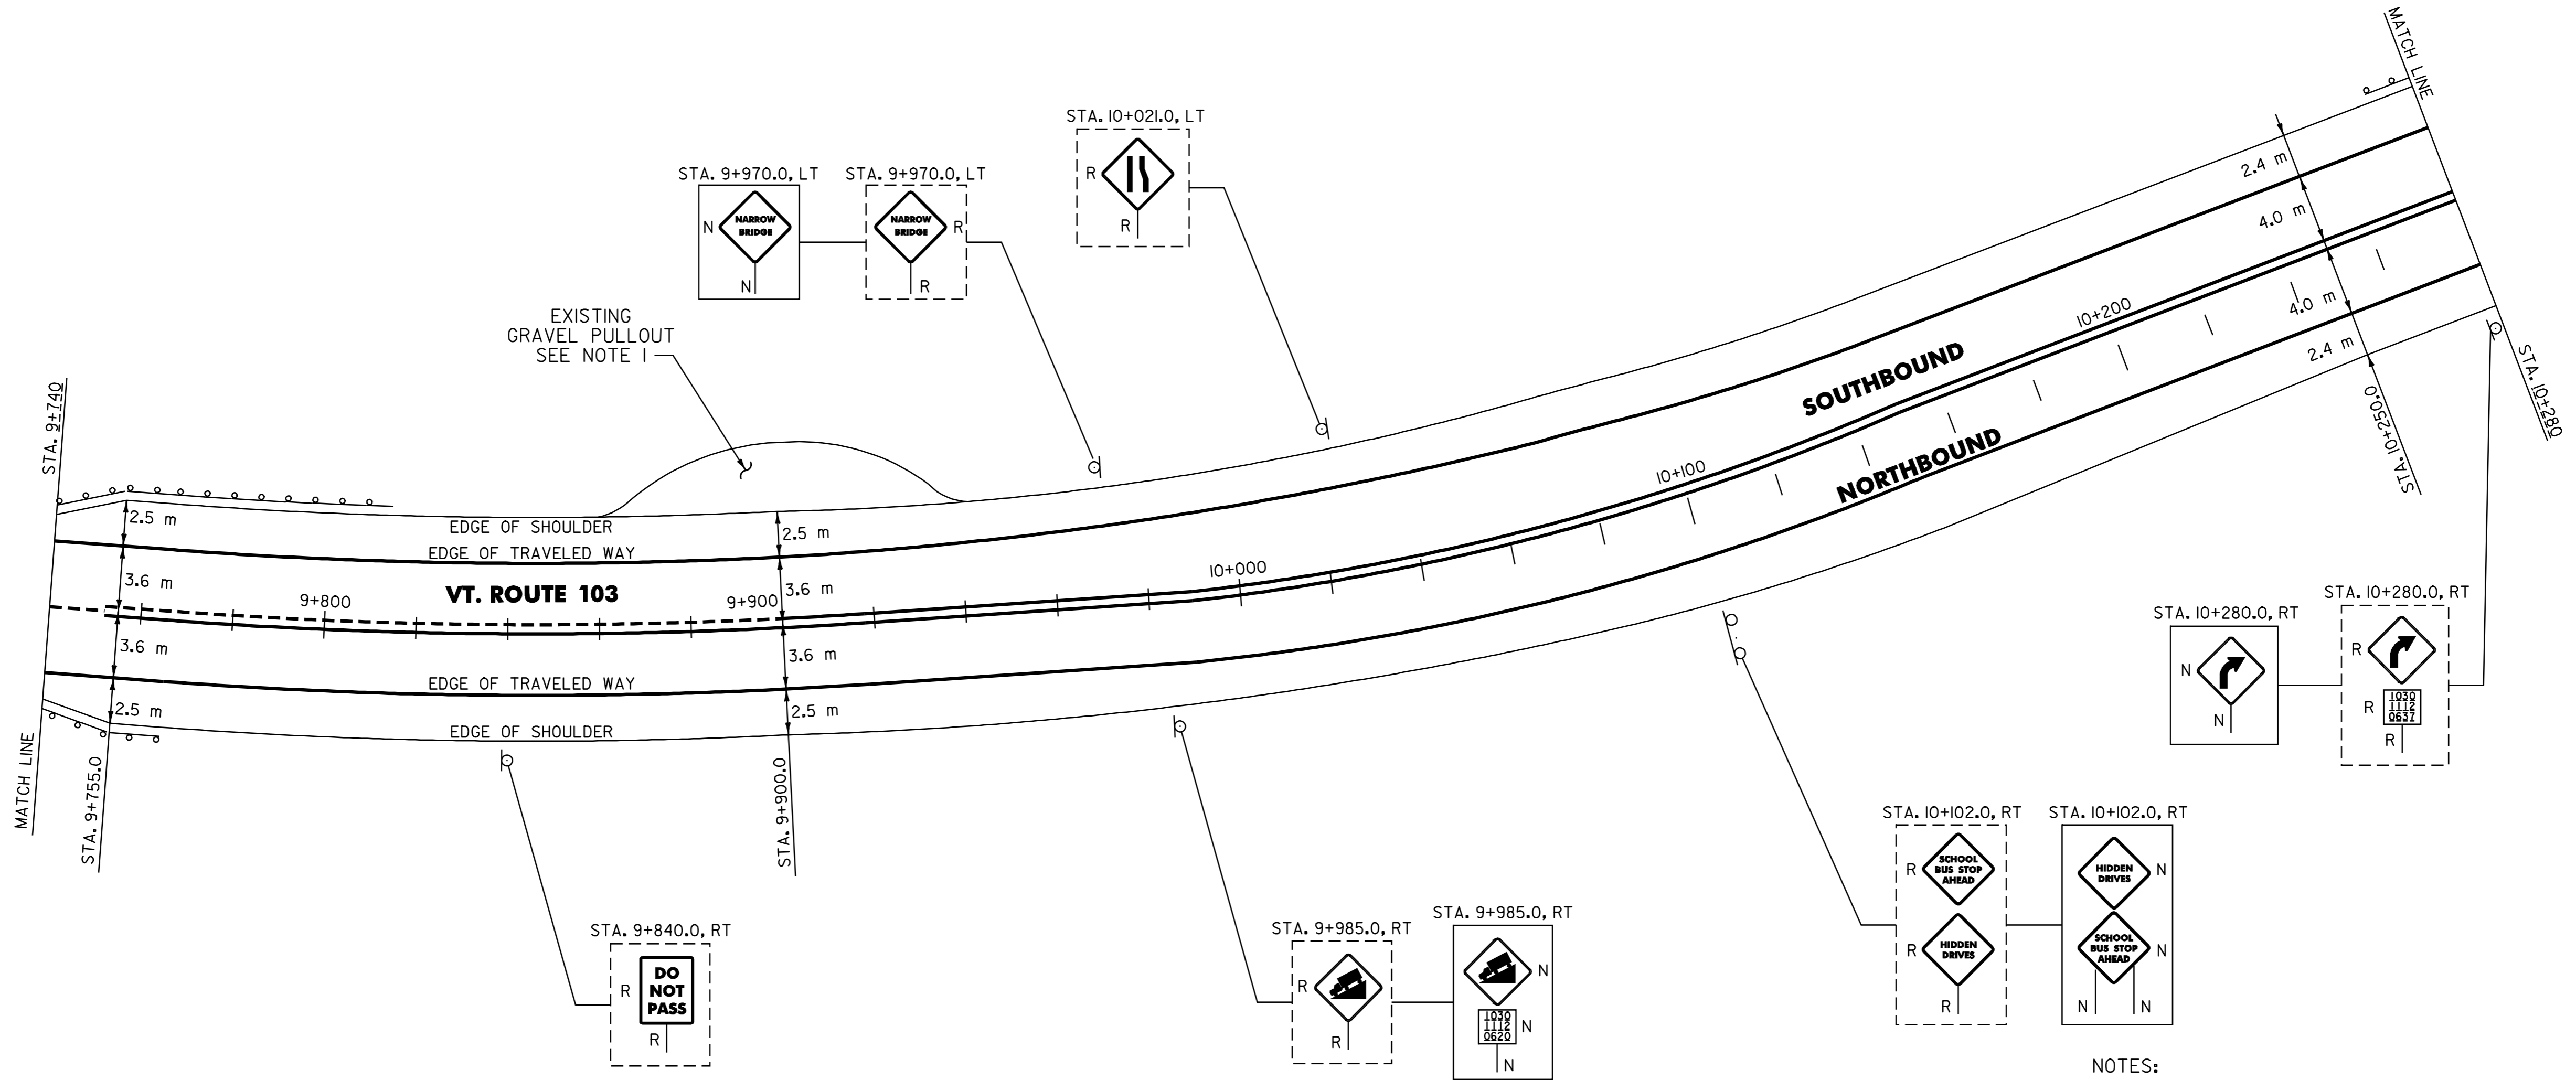

NOTES:

1. PROVIDE A 30 mm TYPE IVS 1.5 m WIDE APRON. ANY REQUIRED EXCAVATION SHALL BE PERFORMED AS DIRECTED BY THE RESIDENT ENGINEER AND PAID UNDER ITEM 608.25.

2. THE CONTRACTOR SHOULD BE AWARE THAT EXISTING BURIED UTILITIES (SUCH AS PHONE CABLE, FIBER OPTIC CABLE, SEWER LINES, ETC.) ARE LOCATED ADJACENT TO VT. ROUTE 103 WITHIN THE PROJECT LIMITS. THE CONTRACTOR IS RESPONSIBLE FOR CONTACTING "DIG SAFE" AT 1-888-344-7233 TO DETERMINE THE EXACT LOCATIONS OF THESE UTILITIES PRIOR TO INSTALLING GUARDRAIL, CLEANING DITCHES OR PERFORMING ANY OTHER OPERATIONS THAT MAY DISTURB THE EXISTING SUBSURFACE CONDITIONS.

ARCHIVED
ON CADD

DATUM	
VERTICAL	N/A
HORIZONTAL	N/A

621.20 STEEL BEAM GUARDRAIL RMT 11/30/04
MT. HOLLY:
STA. 9+743.3 - STA. 9+754.7 RT (11.4 m)
STA. 9+745.2 - STA. 9+790.8 LT (45.6 m)
STA. 10+257.0 ~ STA. 10+280.0 LT (23.0m)

621.21 HEAVY DUTY STEEL BEAM GUARDRAIL
MT. HOLLY:
STA. 9+740.0 - STA. 9+743.3 RT (3.3 m)
STA. 9+740.0 - STA. 9+745.2 LT (5.2 m)

621.505 MANUFACTURED TERMINAL SECTION (FLARED)
MT. HOLLY:
STA. 9+745.7 RT
STA. 9+790.8 LT RMT 11/30/04
STA. 10+257.0 LT

621.80 REMOVAL AND DISPOSAL OF GUARDRAIL
MT. HOLLY:
STA. 9+740.0 - STA. 9+761.0 RT (21.0 m)
STA. 9+740.0 - STA. 9+800.0 LT (60.0 m)
STA. 10+271.0 - STA. 10+280.0 LT (9.0 m)

SIGN LEGEND
R= REMOVE
S= SALVAGE
N= NEW
RET= RETAIN
B-B= BACK TO BACK
EXISTING= _____
NEW= _____

PAVING
PROJECT
LAYOUT
28

SURVEYED BY	N/A	DATE	N/A
DRAWN BY	C.A.K.	DATE	
SQUAD LEADER	T.P.K.		
DESIGN FILE NO.	/pave/01b024/pb024.dgn		
IPARM FILE	pb02428.L	DATE PLOTTED	\$DATE\$
PROJ. NAME	LUDLOW - MT. HOLLY		
PROJ. NO.	NH_232711S		
SHEET	37	OF	84 SHEETS