

646.40 DURABLE 100 mm WHITE LINE
(ALL LINES WILL INCLUDE EDGE LINE BREAKS AND RADIUS FOR TOWN HIGHWAYS)

MT. HOLLY:
STA. II+360.0 - STA. II+900.0, LT & RT

646.60 TEMPORARY 100 mm WHITE LINE
(ALL LINES WILL INCLUDE EDGE LINE BREAKS AND RADIUS FOR TOWN HIGHWAYS)

MT. HOLLY:
STA. II+360.0 - STA. II+900.0, LT & RT

646.41 DURABLE 100 mm YELLOW LINE
(ALL LINES WILL INCLUDE C/L BREAKS FOR TOWN HIGHWAYS) S=SOLID, D=DASHED

MT. HOLLY: LT C RT
STA. II+360.0 - STA. II+900.0 S - S

646.61 TEMPORARY 100 mm YELLOW LINE
(ALL LINES WILL INCLUDE C/L BREAKS FOR TOWN HIGHWAYS) S=SOLID, D=DASHED


MT. HOLLY: LT C RT
STA. II+360.0 - STA. II+900.0 S - S

675.50 REMOVING SIGNS

AS SHOWN - 2

NOTES:

1. THE CONTRACTOR SHOULD BE AWARE THAT EXISTING BURIED UTILITIES (SUCH AS PHONE CABLE, FIBER OPTIC CABLE, SEWER LINES, ETC.) ARE LOCATED ADJACENT TO VT. ROUTE 103 WITHIN THE PROJECT LIMITS. THE CONTRACTOR IS RESPONSIBLE FOR CONTACTING 'DIG SAFE' AT 1-888-344-7233 TO DETERMINE THE EXACT LOCATIONS OF THESE UTILITIES PRIOR TO INSTALLING GUARDRAIL, CLEANING DITCHES OR PERFORMING ANY OTHER OPERATIONS THAT MAY DISTURB THE EXISTING SUBSURFACE CONDITIONS.
2. PROVIDE A 30 mm TYPE IVS 5 m WIDE APRON FOR THE EXISTING PRIVATE ROAD. ANY REQUIRED EXCAVATION SHALL BE PERFORMED AS DIRECTED BY THE RESIDENT ENGINEER AND PAID FOR UNDER ITEM 210.10 OR 608.25.
3. SEE SHEET 84 OF 84 FOR STEEL BEAM GUARDRAIL AT SMALL CULVERTS DETAIL.

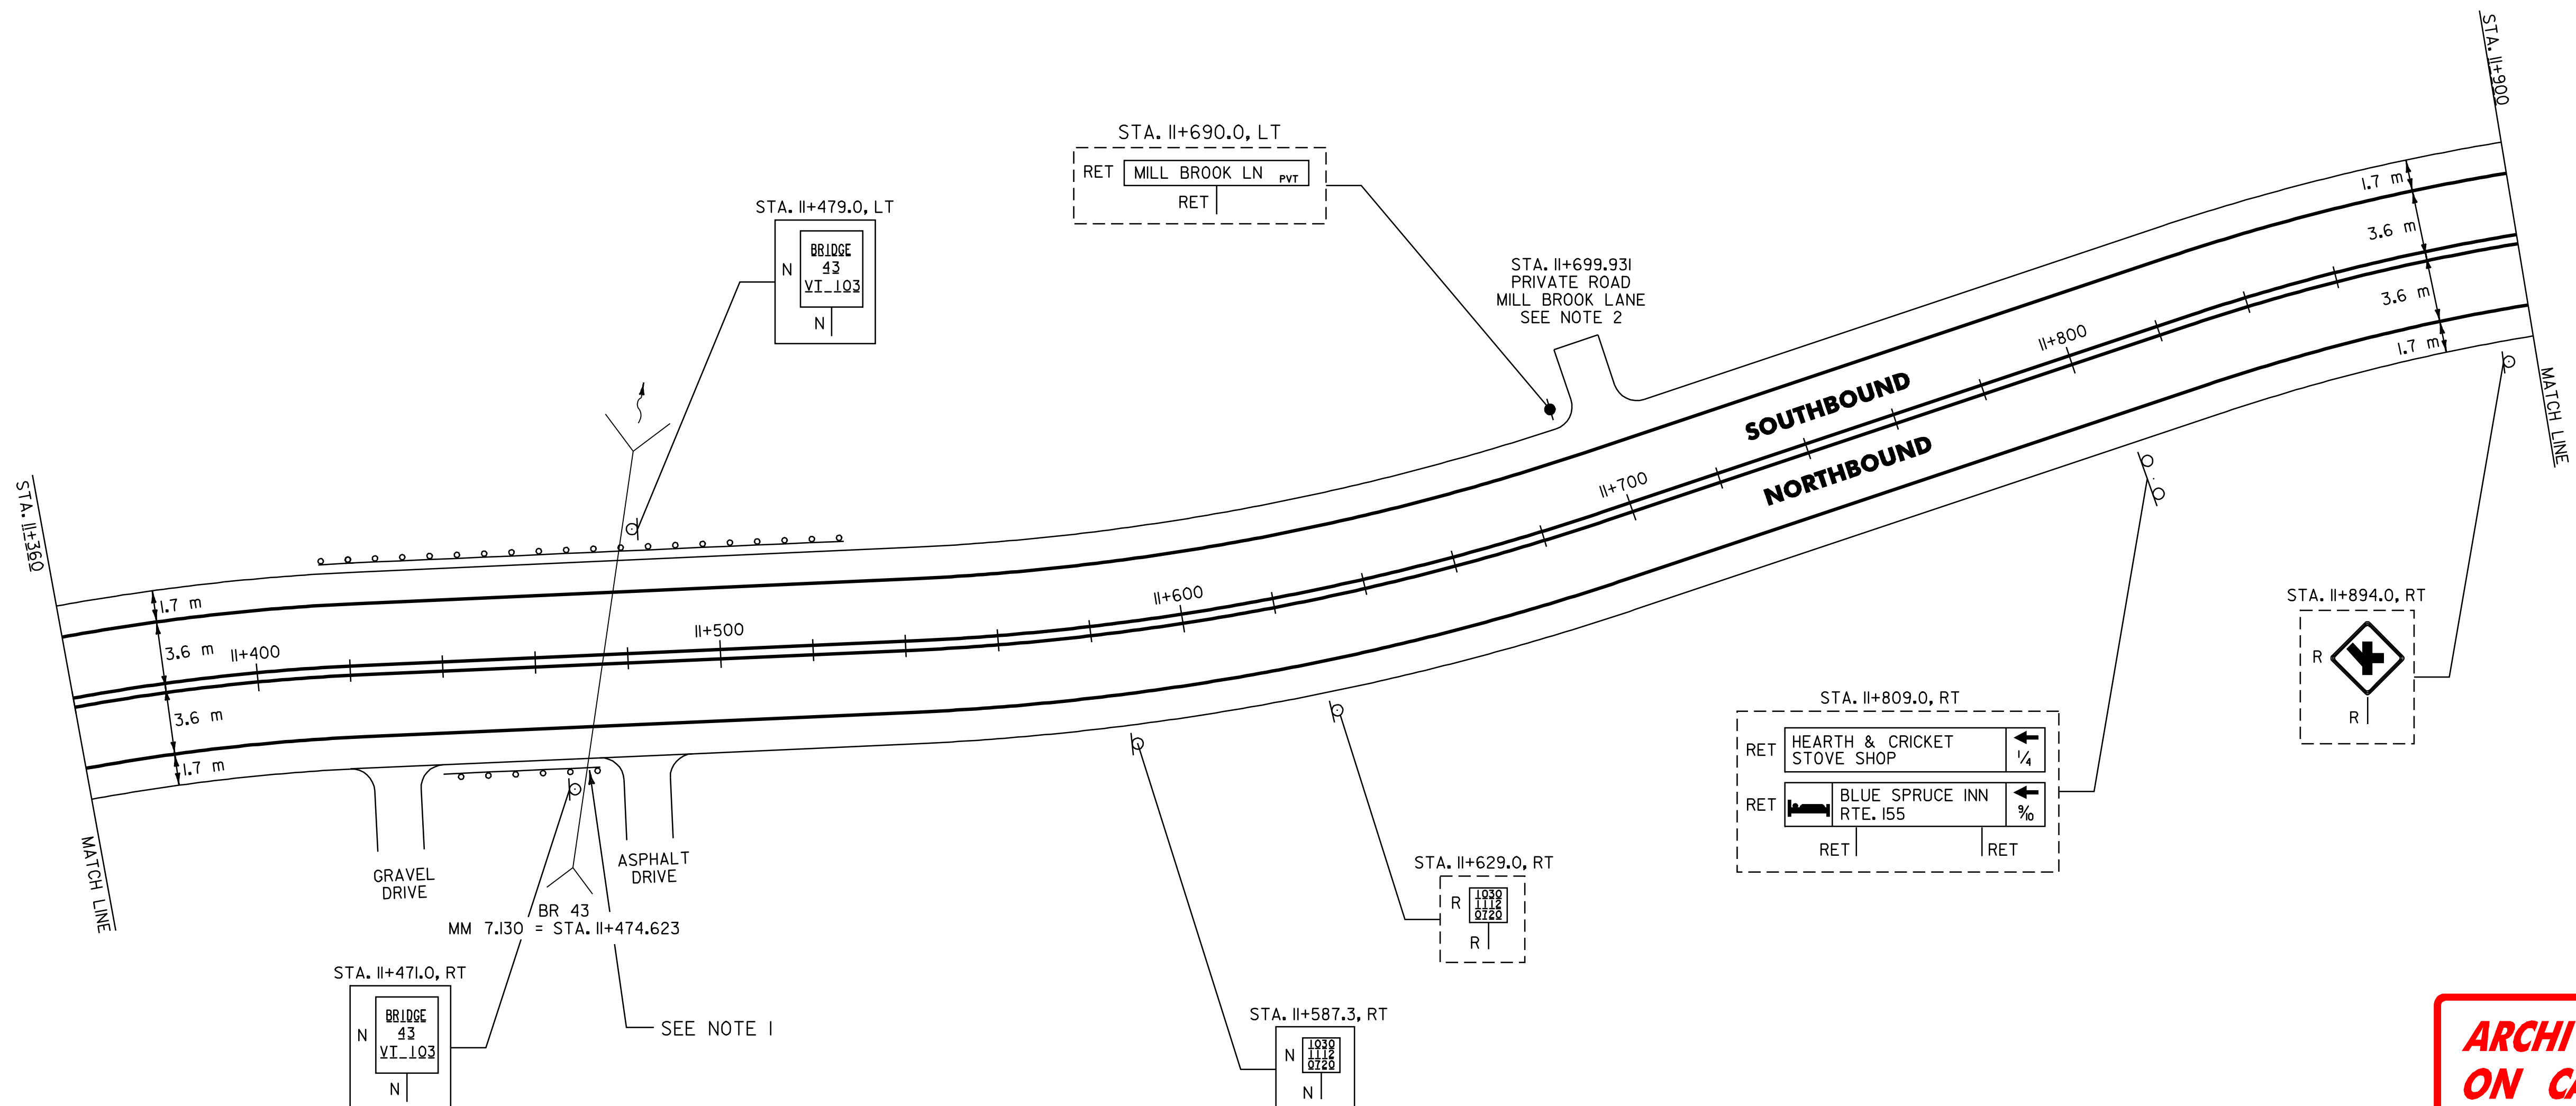

621.20 STEEL BEAM GUARDRAIL
MT. HOLLY:
STA. II+424.6 - STA. II+508.2 LT (83.6 m) RMT II/30/04
~~STA. II+448.6 - STA. II+475.2 RT (26.6 m) NOT INSTALLED RMT II/30/04~~

621.505 MANUFACTURED TERMINAL SECTION (FLARED)
MT. HOLLY:
STA. II+424.6 LT
STA. II+448.6 RT
~~STA. II+475.2 RT~~ NOT INSTALLED RMT II/30/04
STA. II+508.2 LT

621.20 STEEL BEAM GUARDRAIL W/2.4m POSTS RMT II/30/04
MT. HOLLY:
STA. II+448.6 ~ STA. II+471.5 RT (22.9m)

621.60 ANCHOR FOR STEEL BEAM GUARDRAIL RMT II/30/04
MT. HOLLY:
STA. II+474 RT (1EA)

601.0915 450mm CPEP RMT II/30/04
MT. HOLLY:
STA. II+445 ~ II+436 RT (9.15m)

621.80 REMOVAL AND DISPOSAL OF GUARDRAIL
MT. HOLLY:
STA. II+414.0 - STA. II+497.0 LT (83.0 m)
STA. II+445.0 - STA. II+479.0 RT (34.0 m)

DATUM
VERTICAL N/A
HORIZONTAL N/A

SIGN LEGEND
R= REMOVE
S= SALVAGE
N= NEW
RET= RETAIN
B-B= BACK TO BACK
EXISTING= _____
NEW= _____

PAVING PROJECT LAYOUT # 31

SURVEYED BY N/A DATE N/A
DRAWN BY C.A.K. DATE
SQUAD LEADER T.P.K.
DESIGN FILE NO. ZpaveZ01b024Zpb024.dgn
IPARM FILE pb024131L DATE PLOTTED \$DATE\$
PROJ. NAME LUDLOW -- MT. HOLLY
PROJ. NO. NH_232711S
SHEET 40 OF 84 SHEETS

ARCHIVED ON CADD