

**ARCHIVED
ON CADD**

646.40 DURABLE 100 mm WHITE LINE
(ALL LINES WILL INCLUDE EDGE LINE BREAKS AND RADIUS FOR TOWN HIGHWAYS)
MT. HOLLY:
STA. 11+900.0 - STA. 12+412.870 LT & RT

646.60 TEMPORARY 100 mm WHITE LINE
(ALL LINES WILL INCLUDE EDGE LINE BREAKS AND RADIUS FOR TOWN HIGHWAYS)
MT. HOLLY:
STA. 11+900.0 - STA. 12+412.870 LT & RT

646.41 DURABLE 100 mm YELLOW LINE
(ALL LINES WILL INCLUDE C/L BREAKS FOR TOWN HIGHWAYS) S=SOLID, D=DASHED
MT. HOLLY:
STA. 11+900.0 - STA. 12+412.870 LT & RT
STA. 12+161.813 DOUBLE SOLID LT, VT. ROUTE 140

646.46 DURABLE 600 mm STOP BAR
MT. HOLLY:
STA. 12+161.113 LT, VT. ROUTE 140

646.66 TEMPORARY 600 mm STOP BAR
MT. HOLLY:
STA. 12+161.113 LT, VT. ROUTE 140


646.50 DURABLE LETTER & SYMBOL
MT. HOLLY:
STA. 12+161.113 LT, VT. ROUTE 140, "S,T,O,P"

646.70 TEMPORARY LETTER & SYMBOL
MT. HOLLY:
STA. 12+161.113 LT, VT. ROUTE 140, "S,T,O,P"

675.50 REMOVING SIGNS
AS SHOWN - 49

676.60 ERECTING SALVAGED SIGNS
AS SHOWN - 1

646.61 TEMPORARY 100 mm YELLOW LINE
(ALL LINES WILL INCLUDE C/L BREAKS FOR TOWN HIGHWAYS) S=SOLID, D=DASHED
MT. HOLLY:
STA. 11+900.0 - STA. 12+412.870 LT & RT
STA. 12+161.813 DOUBLE SOLID LT, VT. ROUTE 140

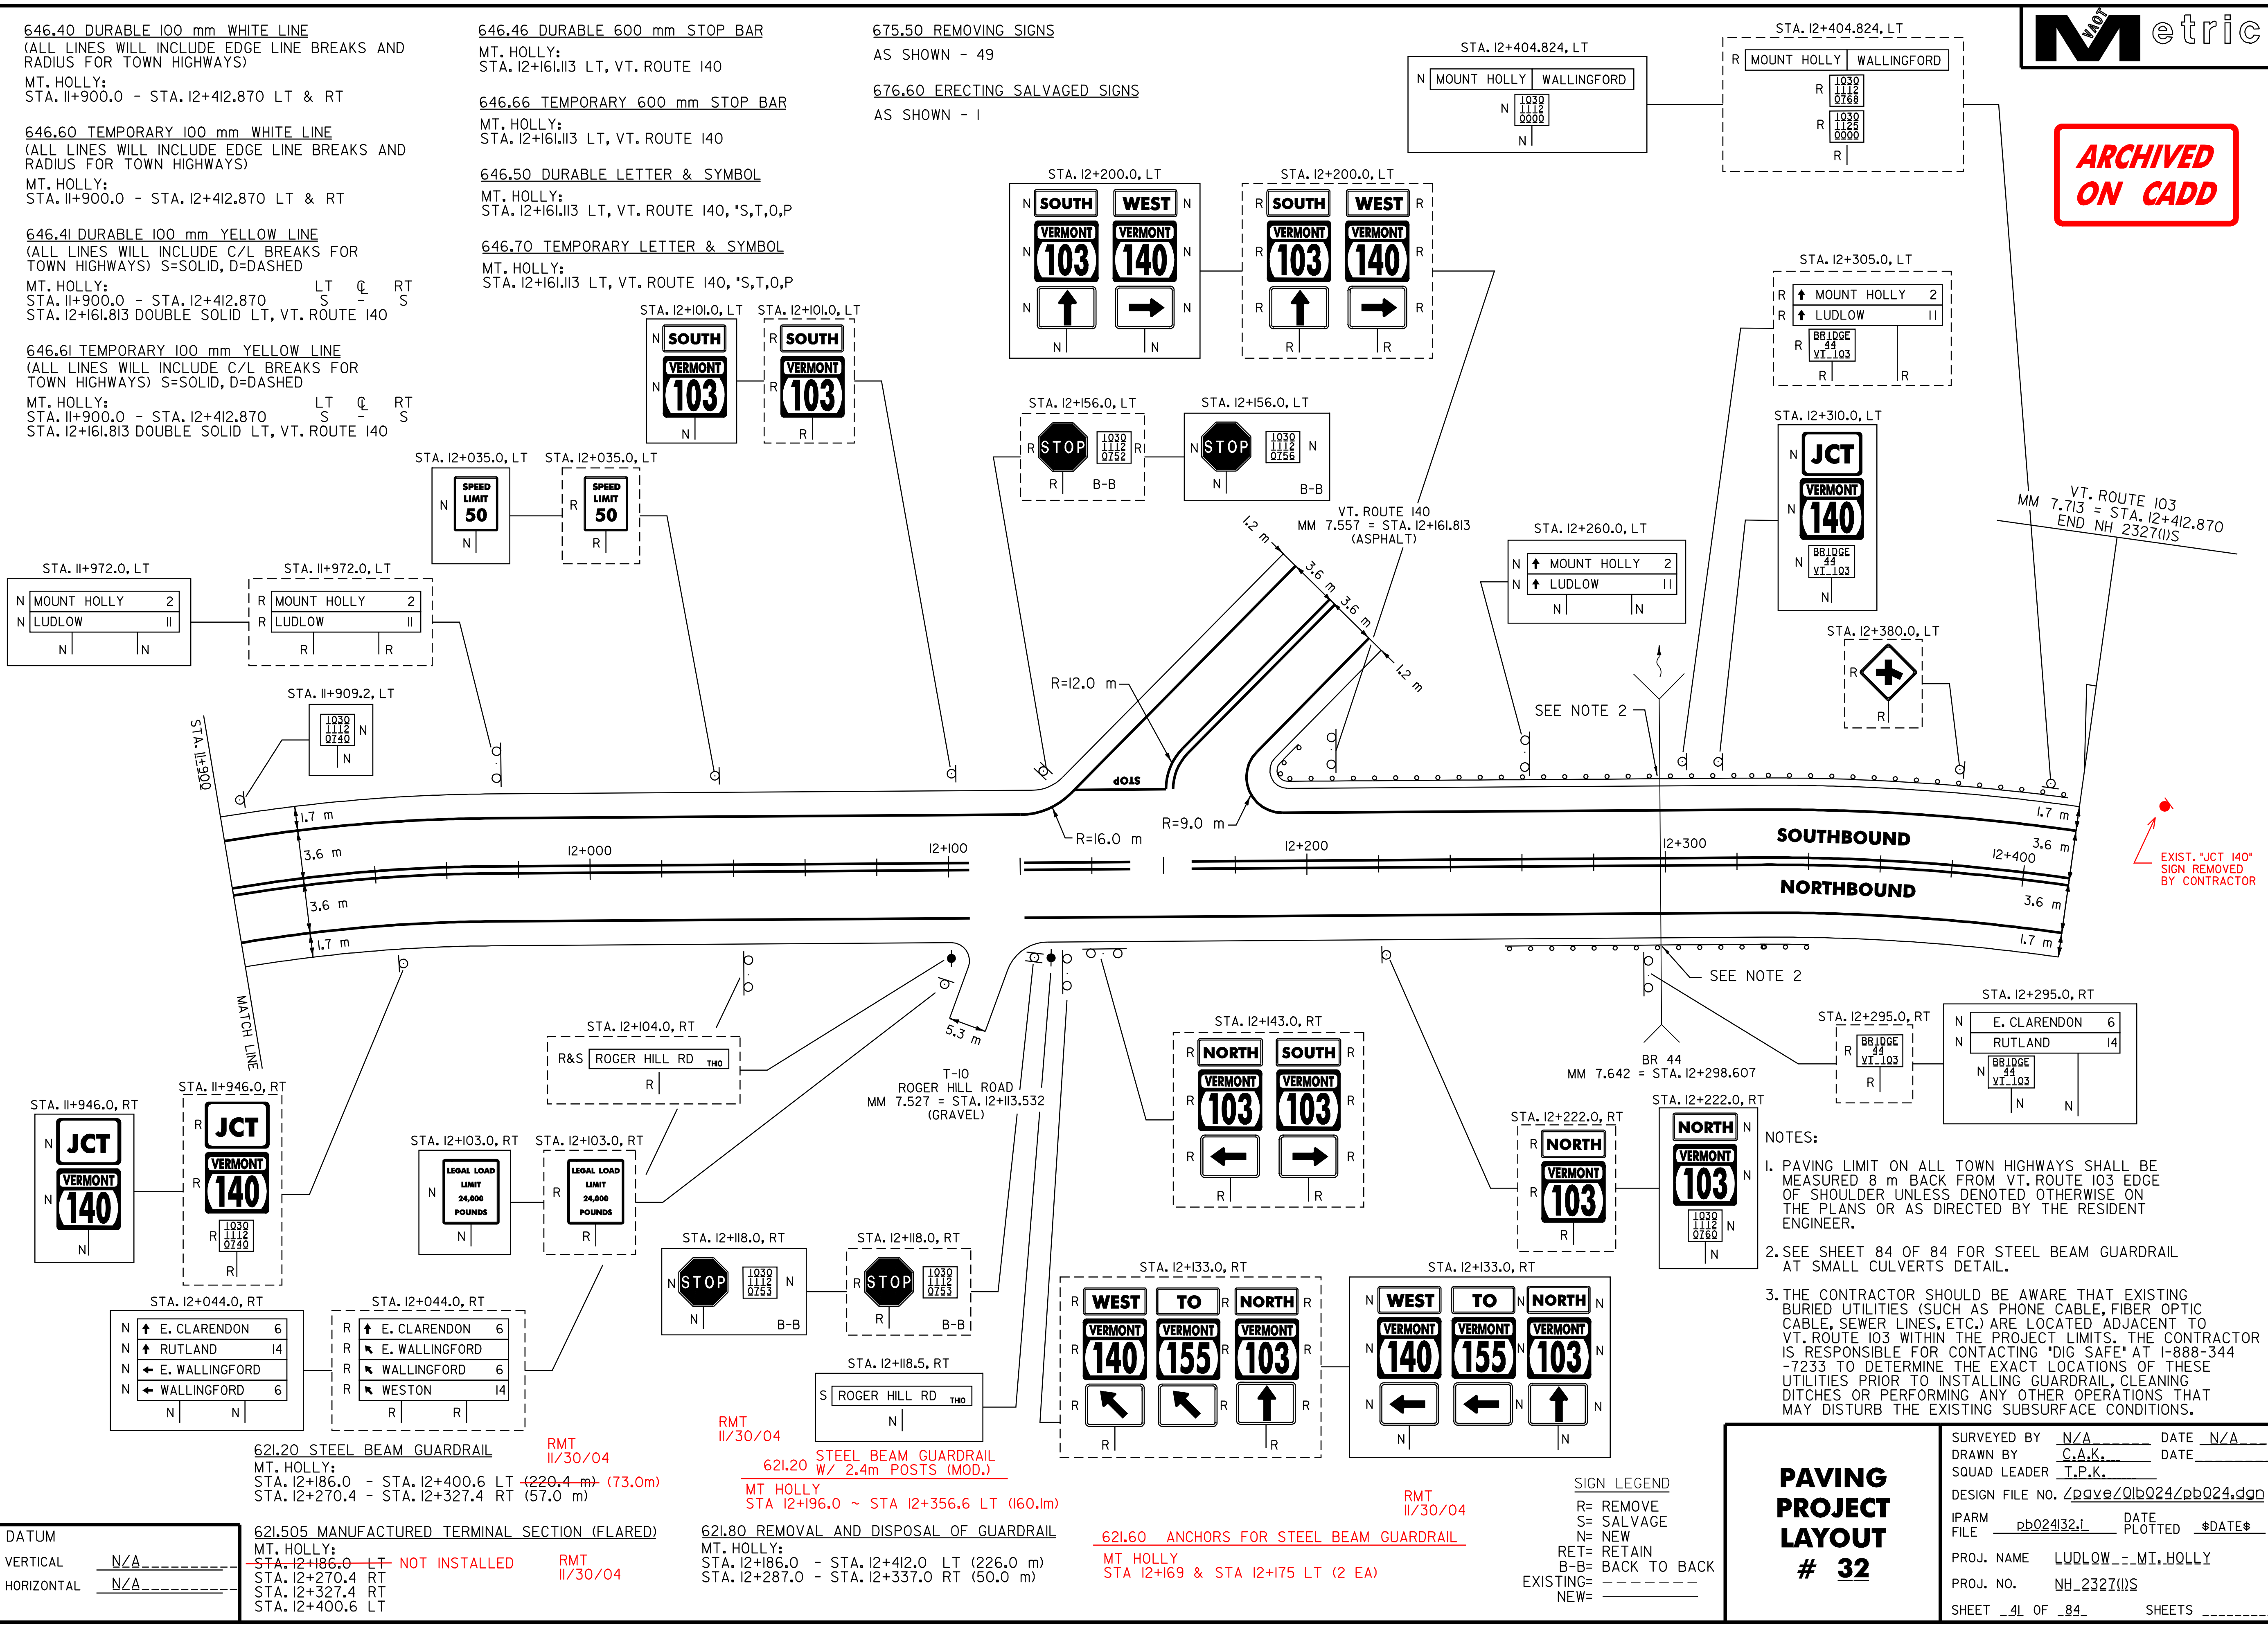

- NOTES:
- PAVING LIMIT ON ALL TOWN HIGHWAYS SHALL BE MEASURED 8 m BACK FROM VT. ROUTE 103 EDGE OF SHOULDER UNLESS DENOTED OTHERWISE ON THE PLANS OR AS DIRECTED BY THE RESIDENT ENGINEER.
 - SEE SHEET 84 OF 84 FOR STEEL BEAM GUARDRAIL AT SMALL CULVERTS DETAIL.
 - THE CONTRACTOR SHOULD BE AWARE THAT EXISTING BURIED UTILITIES (SUCH AS PHONE CABLE, FIBER OPTIC CABLE, SEWER LINES, ETC.) ARE LOCATED ADJACENT TO VT. ROUTE 103 WITHIN THE PROJECT LIMITS. THE CONTRACTOR IS RESPONSIBLE FOR CONTACTING "DIG SAFE" AT 1-888-344-7233 TO DETERMINE THE EXACT LOCATIONS OF THESE UTILITIES PRIOR TO INSTALLING GUARDRAIL, CLEANING DITCHES OR PERFORMING ANY OTHER OPERATIONS THAT MAY DISTURB THE EXISTING SUBSURFACE CONDITIONS.

DATUM

VERTICAL	N/A
HORIZONTAL	N/A

621.505 MANUFACTURED TERMINAL SECTION (FLARED)
MT. HOLLY:
STA. 12+186.0 - STA. 12+270.4 LT (220.4 m) NOT INSTALLED
STA. 12+270.4 RT
STA. 12+327.4 RT
STA. 12+400.6 LT

621.80 REMOVAL AND DISPOSAL OF GUARDRAIL
MT. HOLLY:
STA. 12+186.0 - STA. 12+412.0 LT (226.0 m)
STA. 12+287.0 - STA. 12+337.0 RT (50.0 m)

621.60 ANCHORS FOR STEEL BEAM GUARDRAIL
MT. HOLLY:
STA. 12+169 & STA. 12+175 LT (2 EA)

SIGN LEGEND

R= REMOVE
S= SALVAGE
N= NEW
RET= RETAIN
B-B= BACK TO BACK
EXISTING= _____
NEW= _____

PAVING PROJECT LAYOUT # 32

SURVEYED BY	N/A	DATE	N/A
DRAWN BY	C.A.K.	DATE	
SQUAD LEADER	T.P.K.		
DESIGN FILE NO.	Z:\pave\01b024\pb024.dgn		
IPARM FILE	pb024\32.l	DATE PLOTTED	\$DATE\$
PROJ. NAME	LUDLOW - MT. HOLLY		
PROJ. NO.	NH_232111S		
SHEET	41	OF	84
SHEETS			