

646.40 DURABLE 100 mm WHITE LINE  
(ALL LINES WILL INCLUDE EDGE LINE BREAKS AND RADIUS FOR TOWN HIGHWAYS)

LUDLOW:  
STA. 6+620.0 - STA. 6+880.0, LT & RT  
STA. 6+620.0 - STA. 6+630.0, LANE LINE LT  
STA. 6+620.0 - STA. 6+640.0, DASHED LINE RT  
STA. 6+630.0 - STA. 6+675.0, DASHED LINE LT

646.60 TEMPORARY 100 mm WHITE LINE  
(ALL LINES WILL INCLUDE EDGE LINE BREAKS AND RADIUS FOR TOWN HIGHWAYS)

LUDLOW:  
STA. 6+620.0 - STA. 6+880.0, LT & RT  
STA. 6+620.0 - STA. 6+630.0, LANE LINE LT  
STA. 6+620.0 - STA. 6+640.0, DASHED LINE RT  
STA. 6+630.0 - STA. 6+675.0, DASHED LINE LT

646.41 DURABLE 100 mm YELLOW LINE  
(ALL LINES WILL INCLUDE C/L BREAKS FOR TOWN HIGHWAYS) S=SOLID, D=DASHED

LUDLOW:  
STA. 6+620.0 - STA. 6+820.0, LT, C, RT  
STA. 6+620.0 - STA. 6+820.0, SOLID LINE LT & RT (RAISED ISLAND)  
STA. 6+820.0 - STA. 6+880.0, DOUBLE SOLID LT & RT (MEDIAN TAPER)

646.61 TEMPORARY 100 mm YELLOW LINE  
(ALL LINES WILL INCLUDE C/L BREAKS FOR TOWN HIGHWAYS) S=SOLID, D=DASHED


LUDLOW:  
STA. 6+620.0 - STA. 6+820.0, LT, C, RT  
STA. 6+820.0 - STA. 6+880.0, DOUBLE SOLID LT & RT (MEDIAN TAPER)

646.43 DURABLE 200 mm YELLOW LINE  
LUDLOW:  
STA. 6+820.0 - STA. 6+880.0, HATCHED MEDIAN (306.0 m)

675.50 REMOVING SIGNS  
AS SHOWN - 19

646.81 PAINTED CURB

LUDLOW:  
STA. 6+620.0 - STA. 6+820.0, LT & RT, RAISED ISLAND

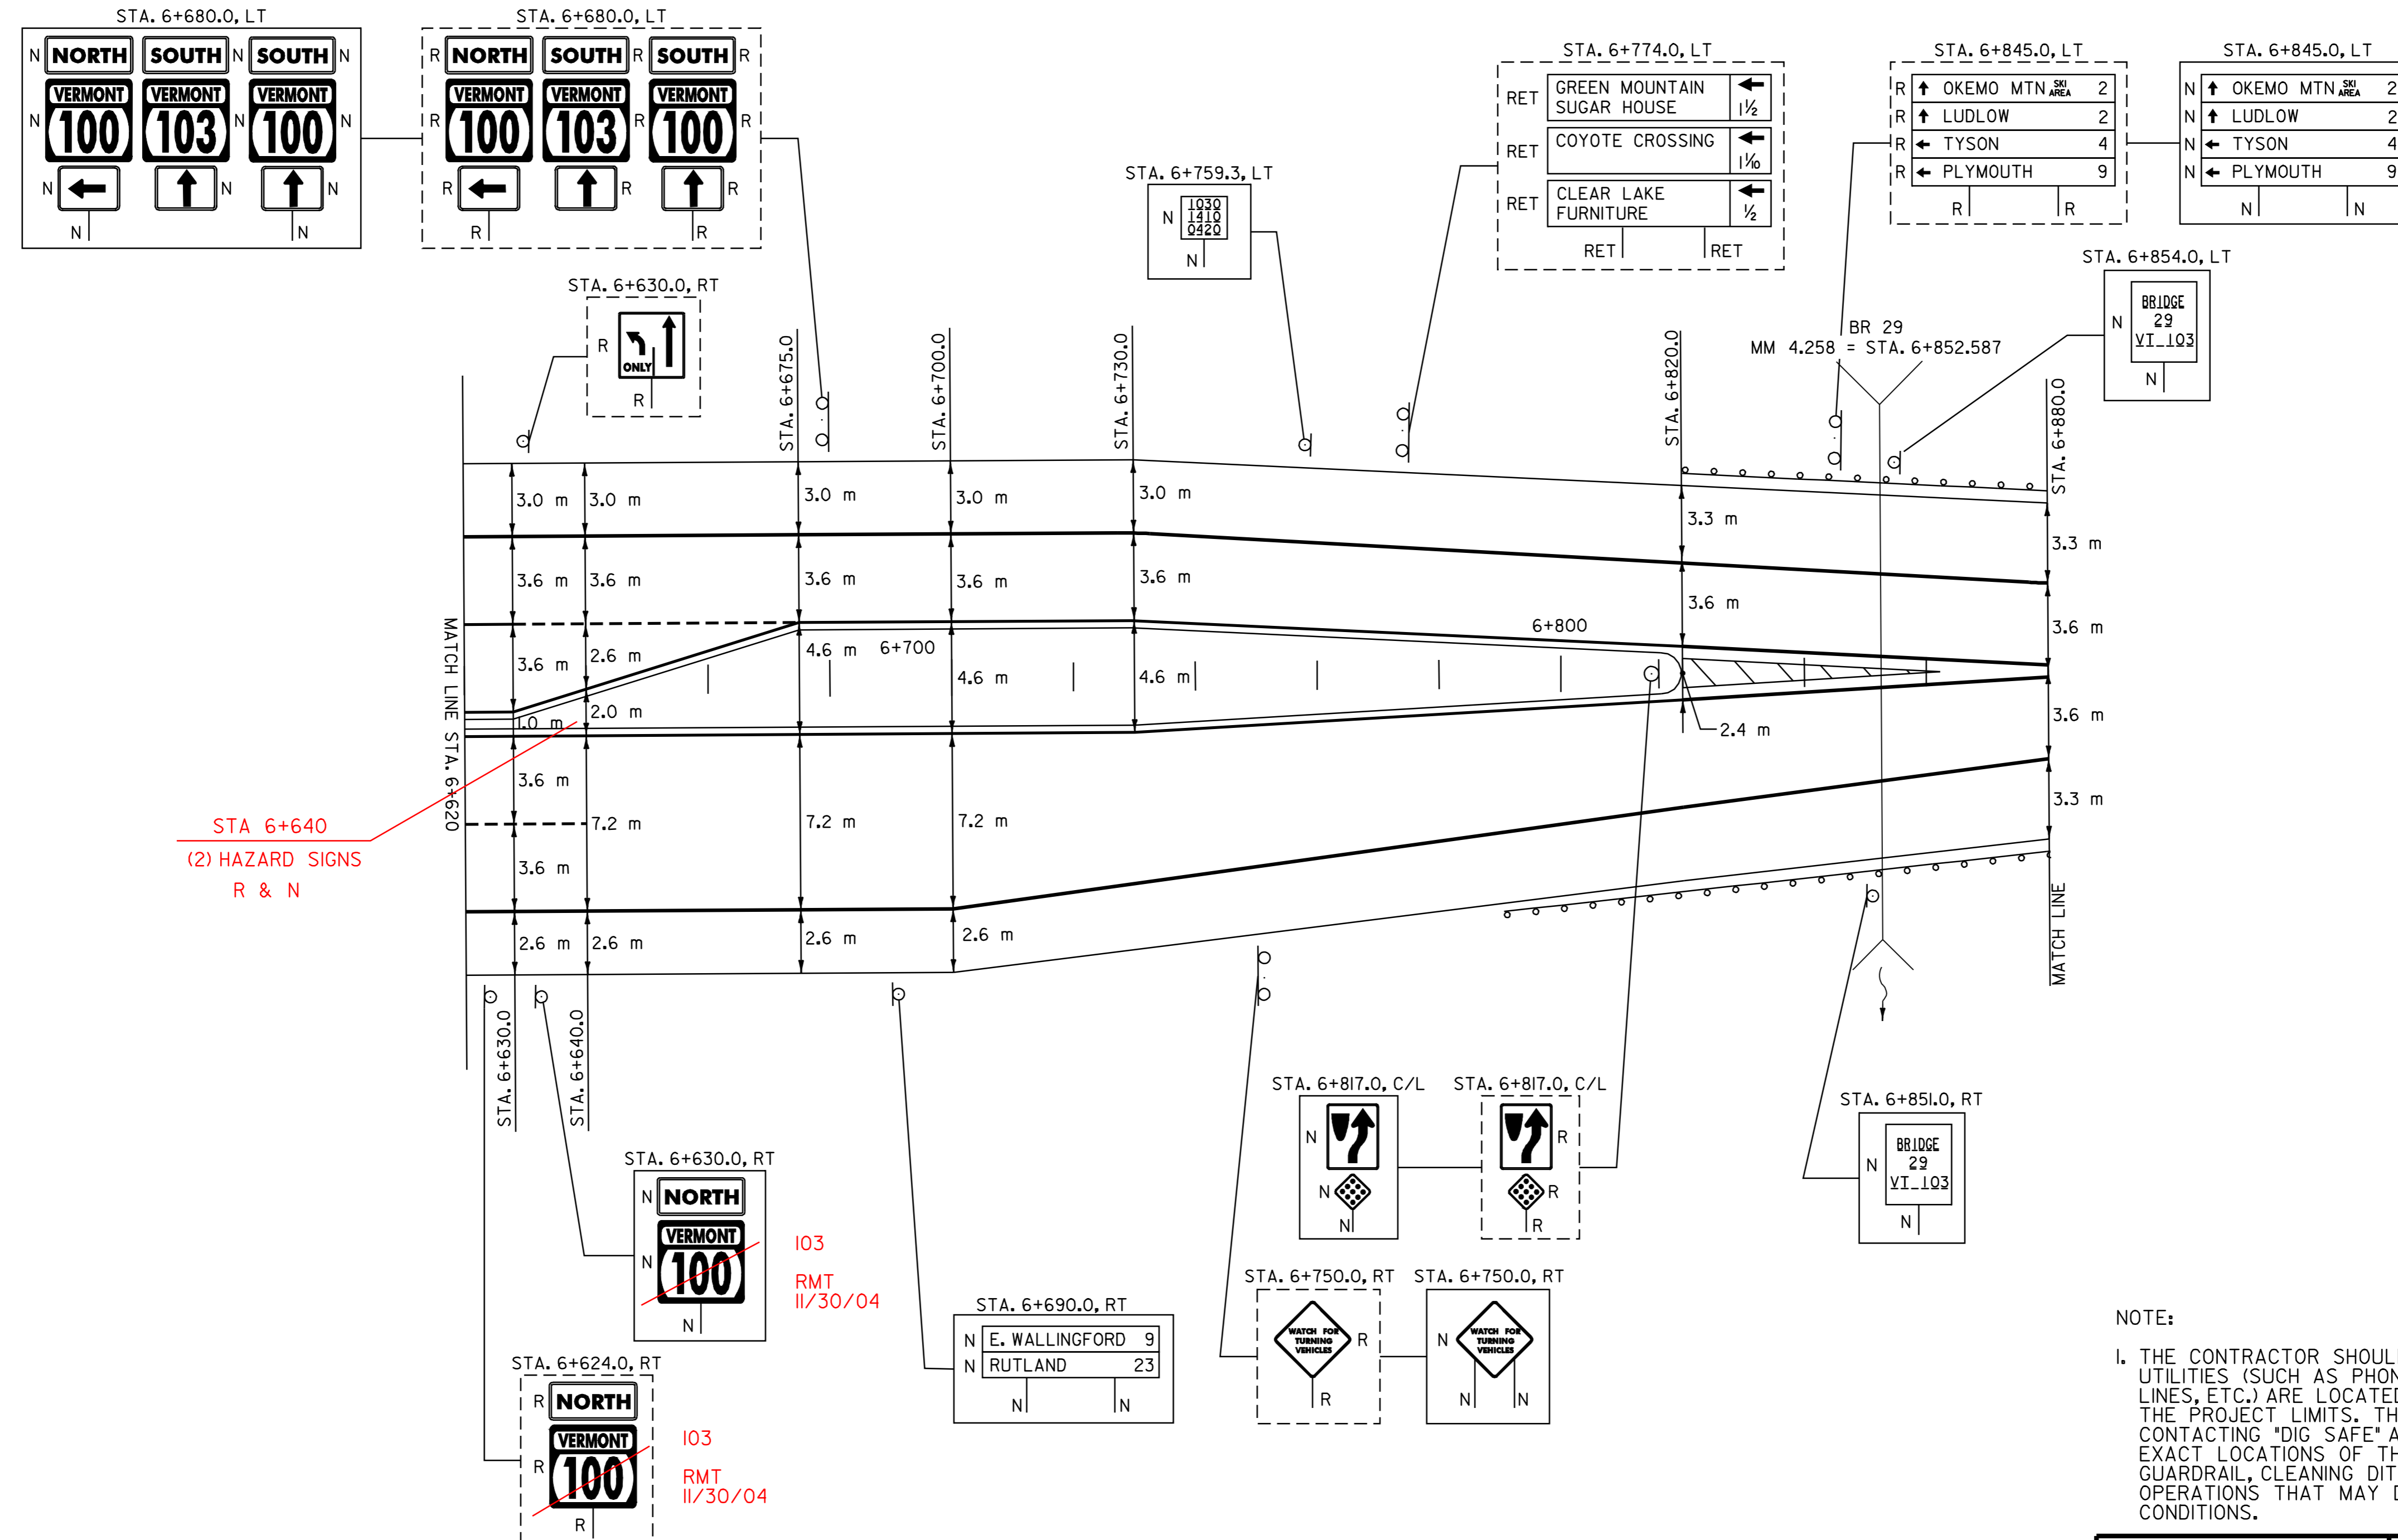

STA 6+640  
(2) HAZARD SIGNS  
R & N

**ARCHIVED  
ON CADD**

NOTE:  
1. THE CONTRACTOR SHOULD BE AWARE THAT EXISTING BURIED UTILITIES (SUCH AS PHONE CABLE, FIBER OPTIC CABLE, SEWER LINES, ETC.) ARE LOCATED ADJACENT TO VT. ROUTE 103 WITHIN THE PROJECT LIMITS. THE CONTRACTOR IS RESPONSIBLE FOR CONTACTING "DIG SAFE" AT 1-888-344-7233 TO DETERMINE THE EXACT LOCATIONS OF THESE UTILITIES PRIOR TO INSTALLING GUARDRAIL, CLEANING DITCHES OR PERFORMING ANY OTHER OPERATIONS THAT MAY DISTURB THE EXISTING SUBSURFACE CONDITIONS.

DATUM  
VERTICAL N/A  
HORIZONTAL N/A

621.20 STEEL BEAM GUARDRAIL  
LUDLOW:  
STA. 6+807.4 - STA. 6+875.8 RT (68.4 m)  
STA. 6+826.4 - STA. 6+880.0 LT (53.6 m)

621.505 MANUFACTURED TERMINAL SECTION (FLARED)  
LUDLOW:  
STA. 6+807.4 RT  
STA. 6+826.4 LT  
~~STA. 6+875.8 RT~~ NOT INSTALLED RMT 11/30/04

621.80 REMOVAL AND DISPOSAL OF GUARDRAIL  
LUDLOW:  
STA. 6+796.0 - STA. 6+885.0 RT (89.0 m)  
STA. 6+832.0 - STA. 6+880.0 LT (48.0 m)

SIGN LEGEND  
R= REMOVE  
S= SALVAGE  
N= NEW  
RET= RETAIN  
B-B= BACK TO BACK  
EXISTING= \_\_\_\_\_  
NEW= \_\_\_\_\_

**T-5 AND  
VT. ROUTE 100  
INTERSECTION  
DETAIL  
SHEET**

SURVEYED BY N/A DATE N/A  
DRAWN BY C.A.K. DATE \_\_\_\_\_  
SQUAD LEADER T.P.K.  
DESIGN FILE NO. z:\pave\01b024\pb024.dgn  
IPARM FILE pb024i34.i DATE PLOTTED \$DATE\$  
PROJ. NAME LUDLOW - .MI., HOLLY  
PROJ. NO. NH\_2327(I)S  
SHEET 43 OF 84 SHEETS \_\_\_\_\_