



T-47
STATION ROAD

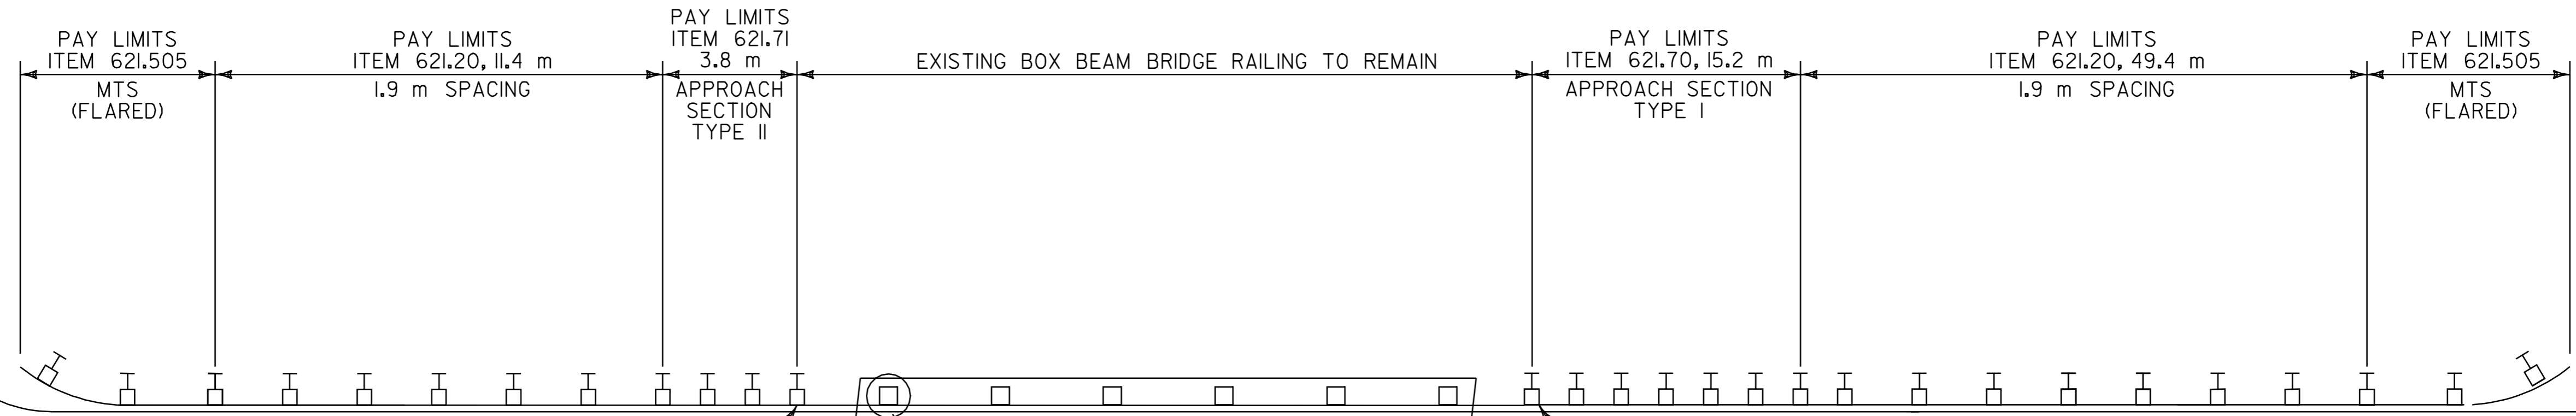

VT. ROUTE 103

SOUTHBOUND

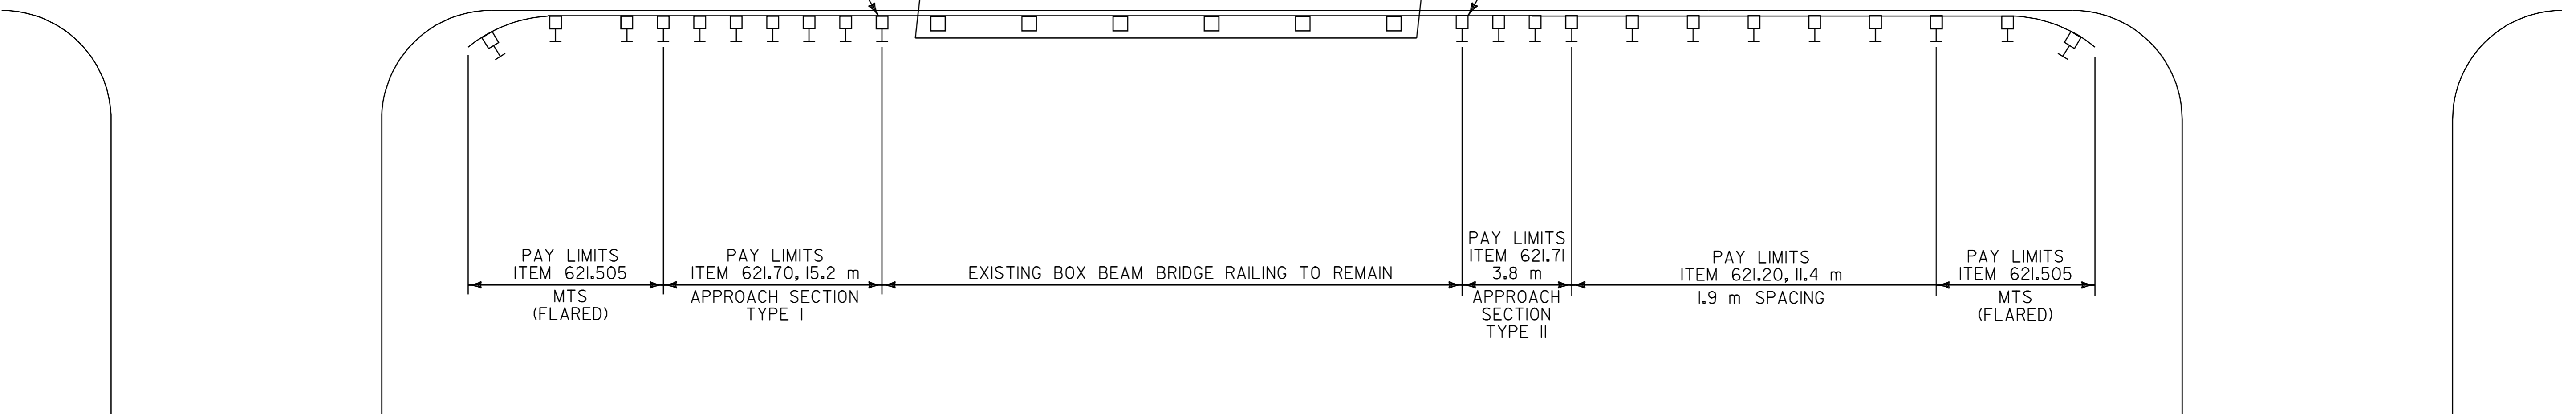

NORTHBOUND

GRAVEL DRIVE

GRAVEL DRIVE

BR 33 MT. HOLLY MM 1.059 = STA. 1+704.295

NOT TO SCALE

DATUM	
VERTICAL	N/A
HORIZONTAL	N/A

<p>BRIDGE DETAIL SHEET #4</p>	SURVEYED BY	N/A	DATE	N/A
	DRAWN BY	C.A.K.	DATE	
	SQUAD LEADER	T.P.K.		
	DESIGN FILE NO.	/pave/01b024/pb024.dgn		
	IPARM FILE	pb024bd4.i	DATE PLOTTED	\$DATE\$
PROJ. NAME	LUDLOW - MI. HOLLY			
PROJ. NO.	NH_232I(1)S			
SHEET	79	OF	84	SHEETS