


BR 42 MT. HOLLY MM 6.043 = STA. 9+725.266

NOT TO SCALE


RMT
11/30/04

EXISTING STEEL OFFSET BLOCKS REINSTALLED
DUE TO ALIGNMENT PROBLEM W/ NEW TIMBER BLOCKS

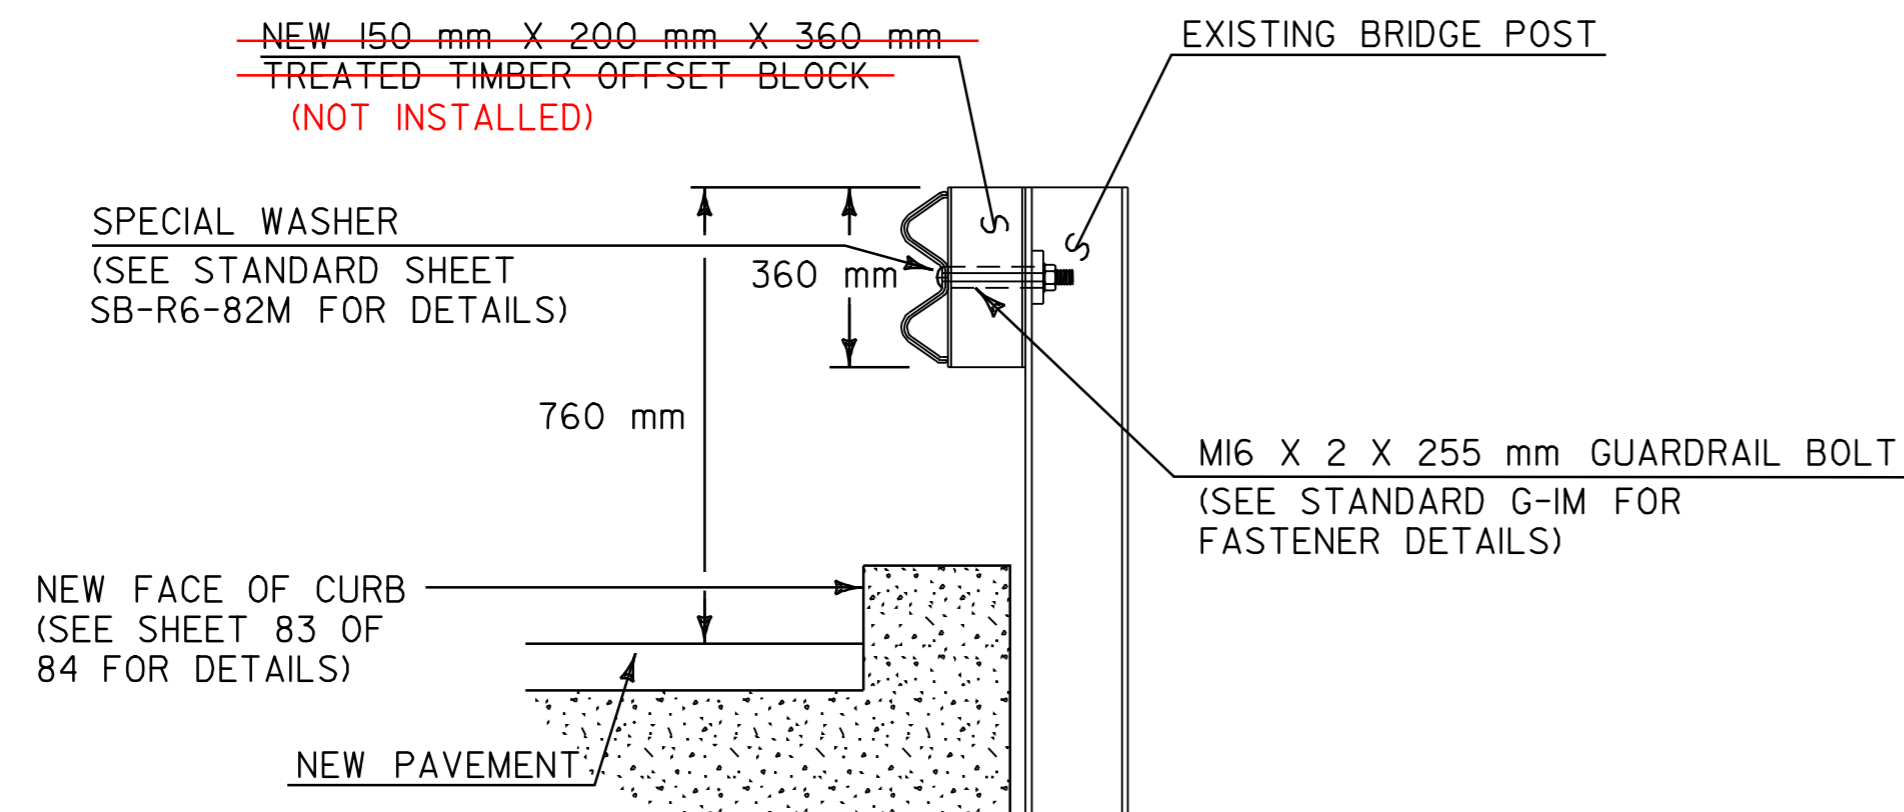

BR 42 BRIDGE POST DETAIL

NOT TO SCALE

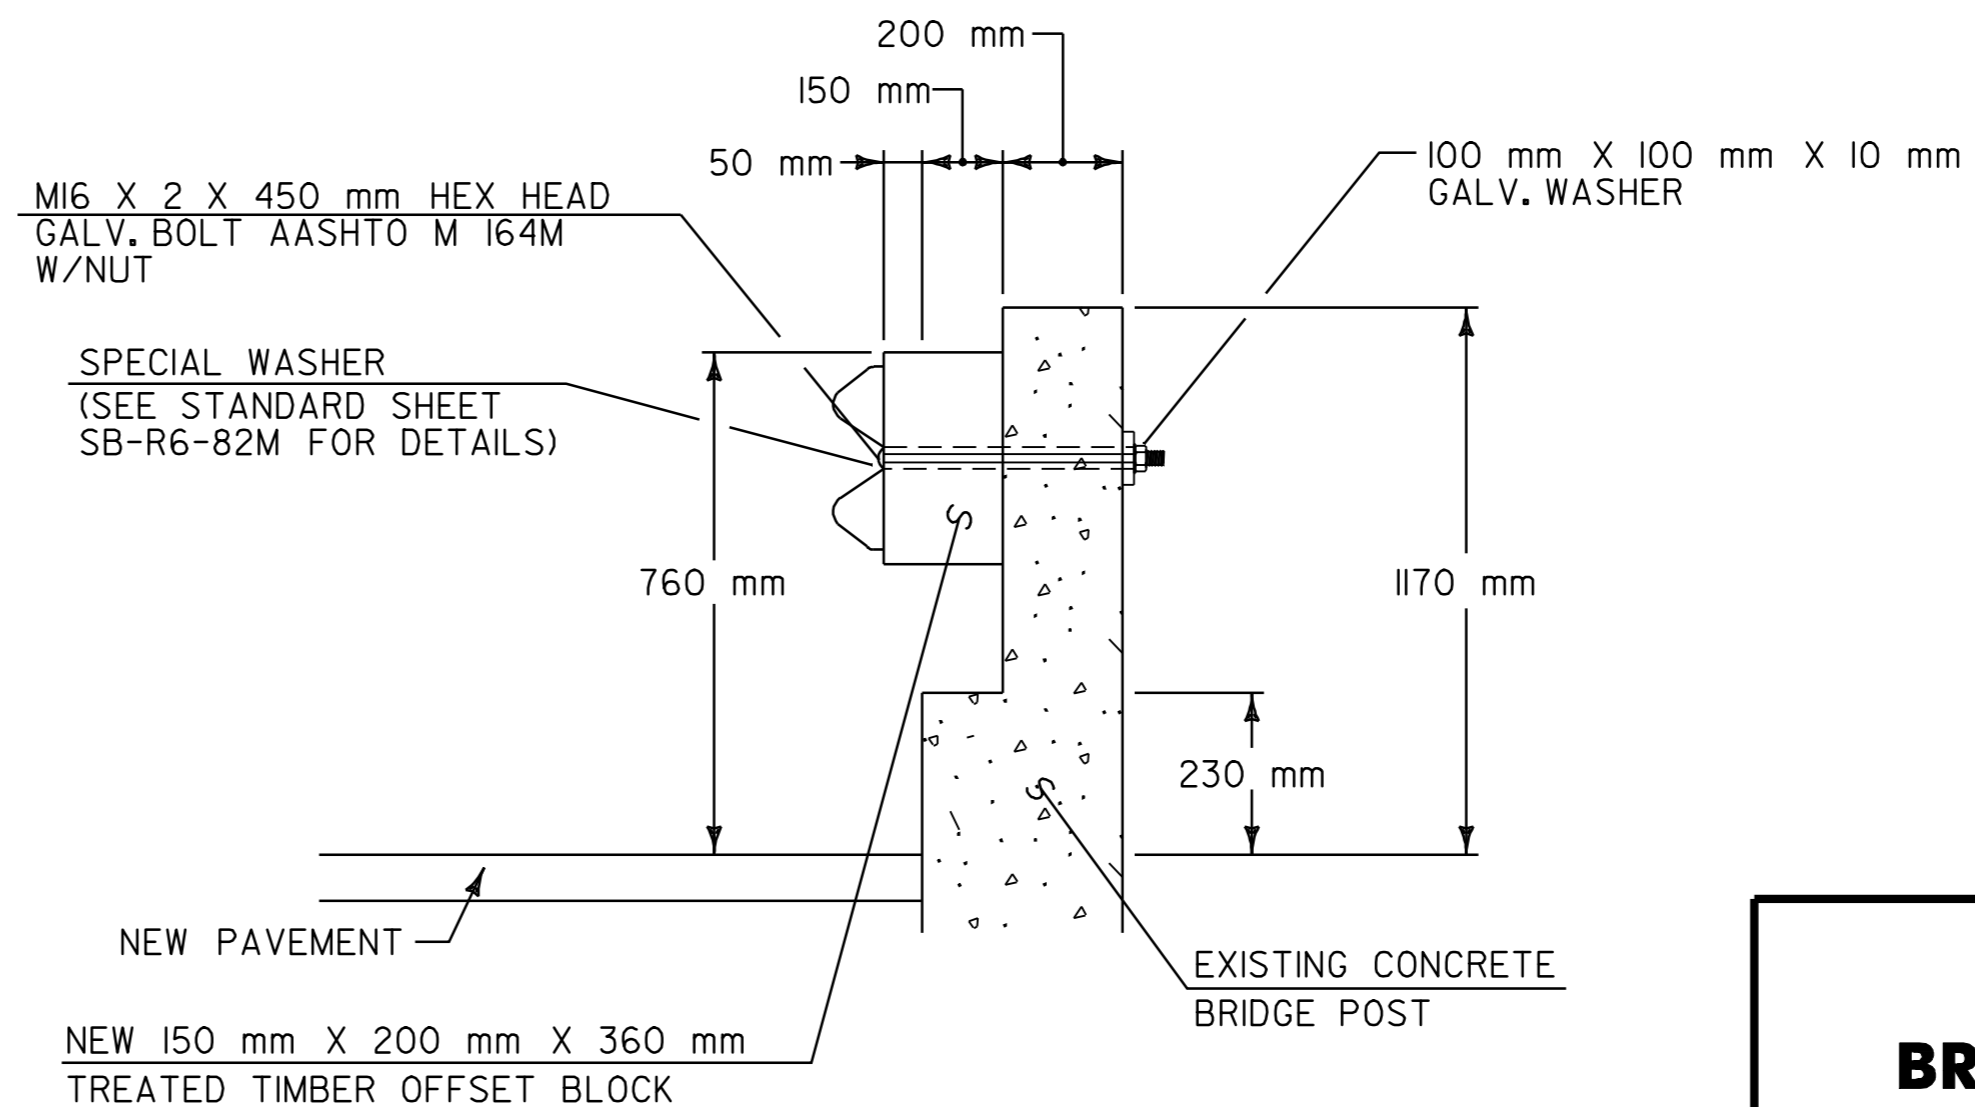

BR 42 BRIDGE POST DETAIL

NOT TO SCALE

**ARCHIVED
ON CADD**

DATUM	
VERTICAL	N/A
HORIZONTAL	N/A

**BRIDGE
DETAIL
SHEET #5**

SURVEYED BY	N/A	DATE	N/A
DRAWN BY	C.A.K.	DATE	
SQUAD LEADER	T.P.K.		
DESIGN FILE NO.	/pave/01b024/pb024.dgn		
IPARM FILE	pb024b05.d	DATE PLOTTED	\$DATE\$
PROJ. NAME	LUDLOW - MT. HOLLY		
PROJ. NO.	NH_2327(1)S		
SHEET	80	OF	84 SHEETS