


646.402 DURABLE 4 INCH WHITE LINE, THERMOPLASTIC
 (ALL LINES WILL INCLUDE EDGE LINE BREAKS AND
 RADII FOR SIDE ROADS)
 STA. 158+50 TO 164+50, SOLID LT & RT

646.602 TEMPORARY 4 INCH WHITE LINE, PAINT
 (ALL LINES WILL INCLUDE EDGE LINE BREAKS AND
 RADII FOR SIDE ROADS)
 STA. 158+50 TO 164+50, SOLID LT & RT

619.17 YIELDING MARKER POSTS
 STA. 160+60 LT & RT

646.412 DURABLE 4 INCH YELLOW LINE, THERMOPLASTIC
 (ALL LINES WILL INCLUDE C BREAKS FOR SIDE ROADS)
 STA. 158+50 TO 164+50, SOLID LT & RT

646.612 TEMPORARY 4 INCH YELLOW LINE, PAINT
 (ALL LINES WILL INCLUDE C BREAKS FOR SIDE ROADS)
 STA. 158+50 TO 164+50, SOLID LT & RT

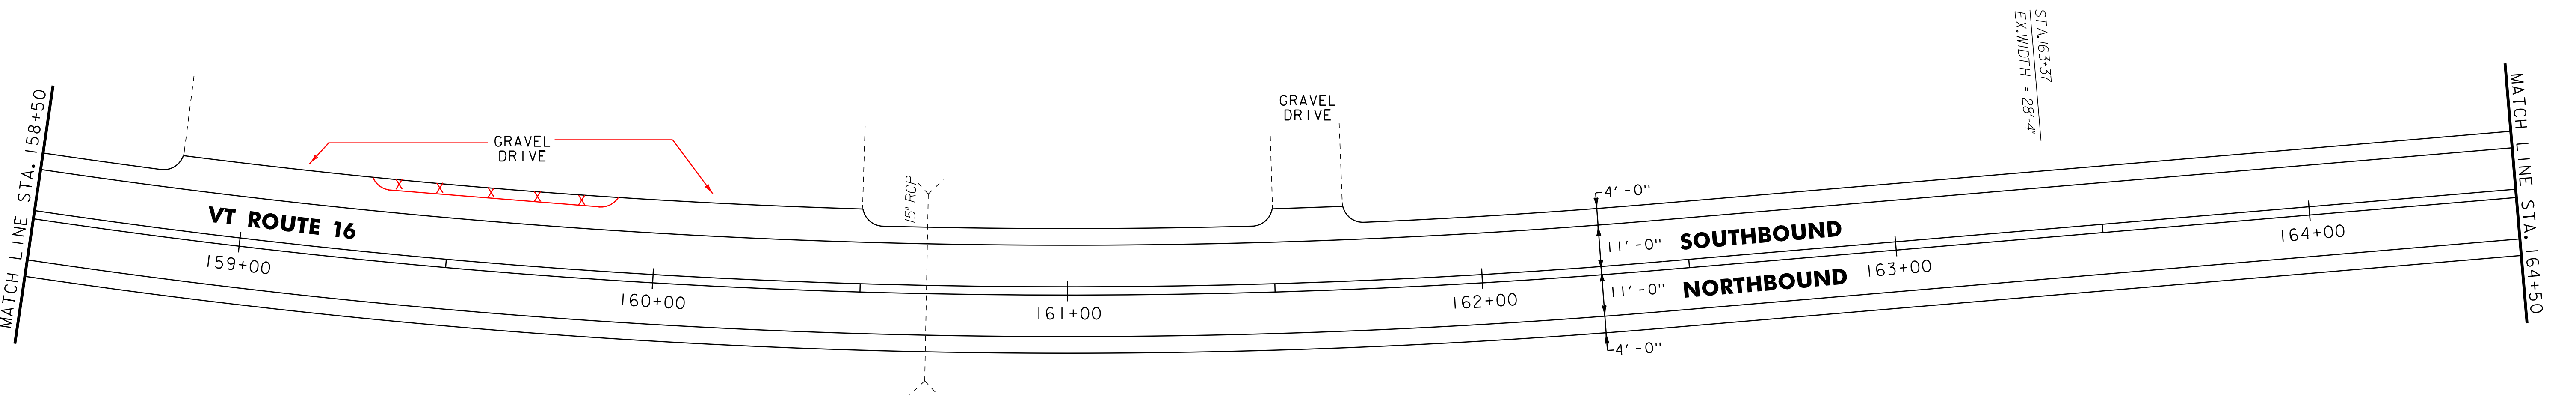

621.20 STEEL BEAM GUARDRAIL, GALVANIZED
 STA. 167+16.5 TO 169+79.0, LT

646.402 DURABLE 4 INCH WHITE LINE, THERMOPLASTIC
 (ALL LINES WILL INCLUDE EDGE LINE BREAKS AND
 RADII FOR SIDE ROADS)
 STA. 164+50 TO 170+50, SOLID LT & RT


646.602 TEMPORARY 4 INCH WHITE LINE, PAINT
 (ALL LINES WILL INCLUDE EDGE LINE BREAKS AND
 RADII FOR SIDE ROADS)
 STA. 164+50 TO 170+50, SOLID LT & RT

675.50 REMOVING SIGNS
 AS SHOWN - 1

621.50 MANUFACTURED TERMINAL SECTION, FLARED
 STA. 166+79.0 TO 167+16.5, LT
 STA. 169+79.0 TO 170+16.5, LT

646.412 DURABLE 4 INCH YELLOW LINE, THERMOPLASTIC
 (ALL LINES WILL INCLUDE C BREAKS FOR SIDE ROADS)
 STA. 164+50 TO 168+54, SOLID LT & RT
 STA. 168+54 TO 170+50, SOLID LT, DASHED RT

646.612 TEMPORARY 4 INCH YELLOW LINE, PAINT
 (ALL LINES WILL INCLUDE C BREAKS FOR SIDE ROADS)
 STA. 164+50 TO 168+54, SOLID LT & RT
 STA. 168+54 TO 170+50, SOLID LT, DASHED RT

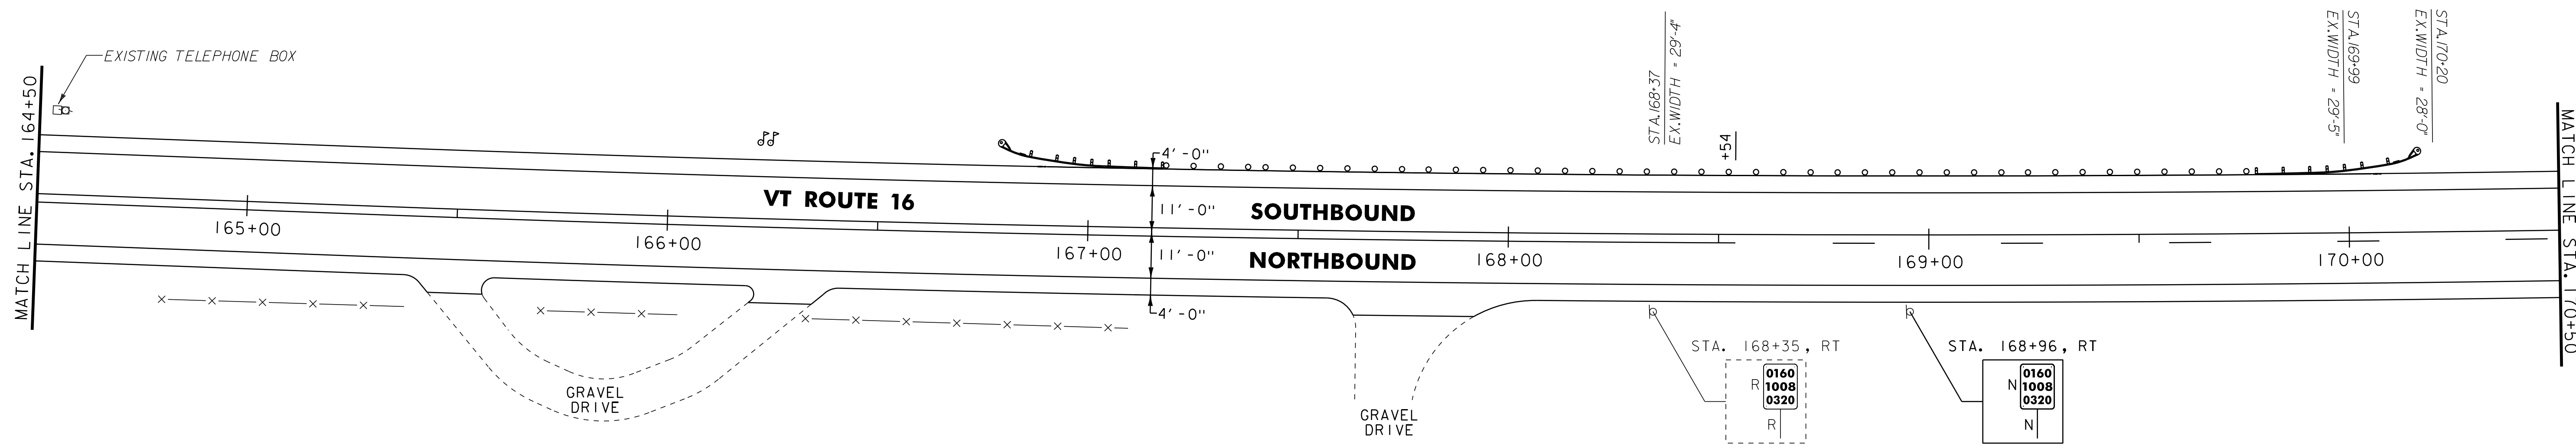

NOTES:

- FOR LEGENDS, SEE LAYOUT SHEET #1.
- ALL EXISTING SIGNS NOT SHOWN SHALL BE RETAINED.



**PROJECT
 LAYOUT
 SHEET #2**

PROJECT NAME: GLOVER - BARTON
 PROJECT NUMBER: STP 2318(I)

FILE NAME: p01b034.dgn
 PROJECT LEADER: JLL
 DESIGNED BY: STANTEC
 IPARM FILE: p01b034I02.i

PLOT DATE: 28-NOV-2012 15:0
 DRAWN BY: STANTEC
 CHECKED BY: STANTEC
 SHEET 14 OF 60

NOT TO SCALE