


646.402 DURABLE 4 INCH WHITE LINE, THERMOPLASTIC  
 (ALL LINES WILL INCLUDE EDGE LINE BREAKS AND  
 RADII FOR SIDE ROADS)  
 STA. 182+50 TO 188+50, SOLID LT & RT

646.412 DURABLE 4 INCH YELLOW LINE, THERMOPLASTIC  
 (ALL LINES WILL INCLUDE C BREAKS FOR SIDE ROADS)  
 STA. 182+50 TO 185+18, DASHED LT, SOLID RT  
 STA. 185+18 TO 188+50, SOLID LT & RT

646.602 TEMPORARY 4 INCH WHITE LINE, PAINT  
 (ALL LINES WILL INCLUDE EDGE LINE BREAKS AND  
 RADII FOR SIDE ROADS)  
 STA. 182+50 TO 188+50, SOLID LT & RT

646.612 TEMPORARY 4 INCH YELLOW LINE, PAINT  
 (ALL LINES WILL INCLUDE C BREAKS FOR SIDE ROADS)  
 STA. 182+50 TO 185+18, DASHED LT, SOLID RT  
 STA. 185+18 TO 188+50, SOLID LT & RT

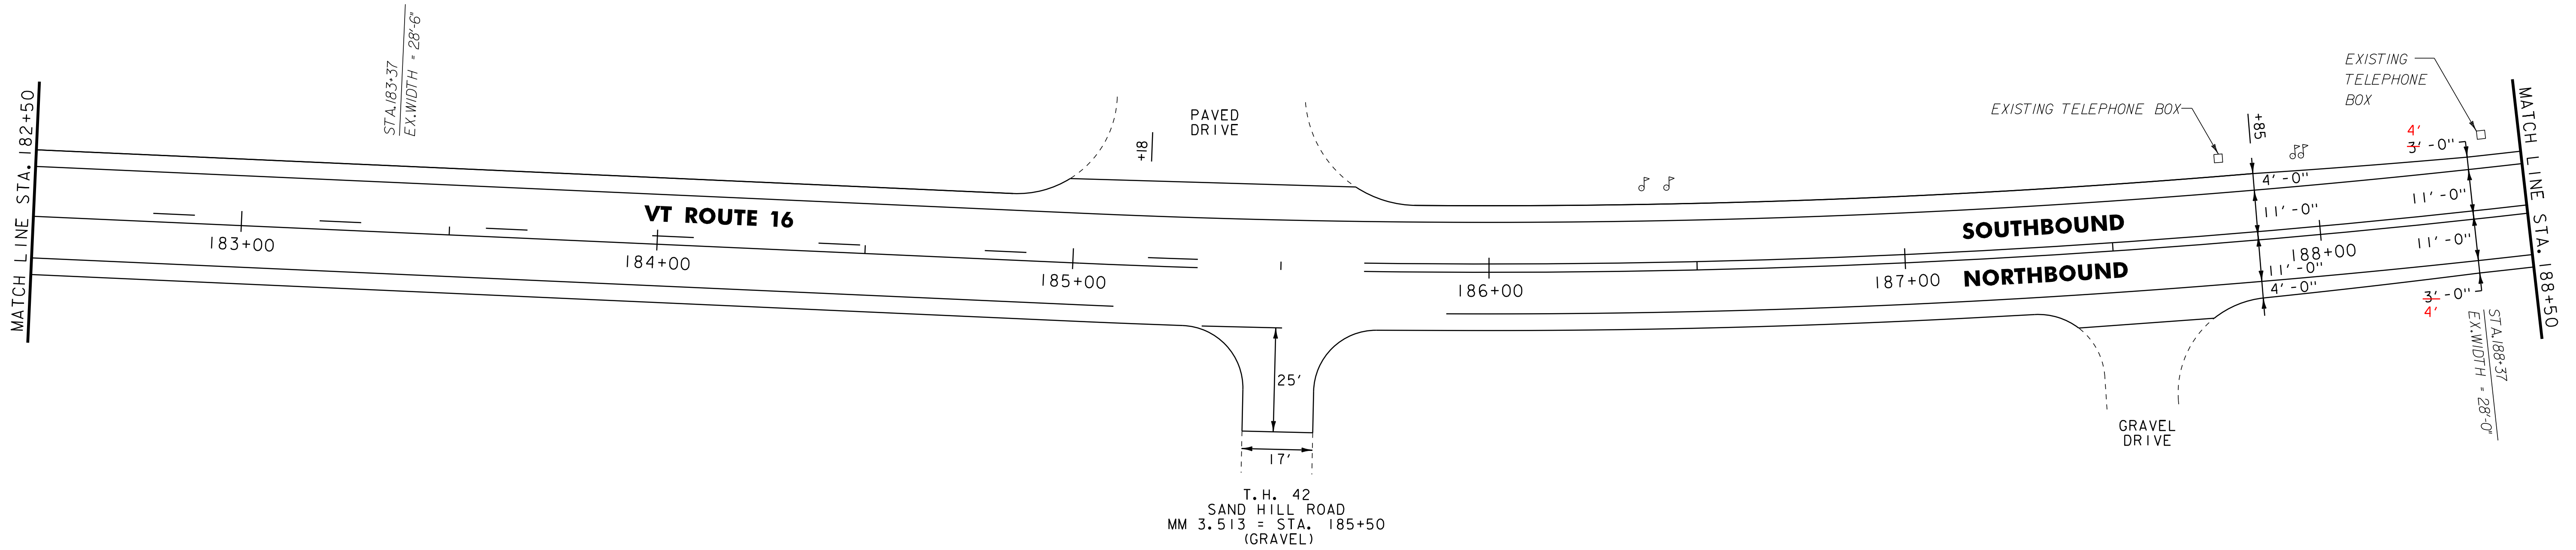

621.20 STEEL BEAM GUARDRAIL, GALVANIZED  
 STA. 191+01.5 TO 194+50.0, LT

621.50 MANUFACTURED TERMINAL SECTION, FLARED  
 STA. 190+64.0 TO 191+01.5, LT

621.80 REMOVAL AND DISPOSAL OF GUARDRAIL  
 STA. 190+70 TO 194+50, LT  
 64

646.402 DURABLE 4 INCH WHITE LINE, THERMOPLASTIC  
 (ALL LINES WILL INCLUDE EDGE LINE BREAKS AND  
 RADII FOR SIDE ROADS)  
 STA. 188+50 TO 194+50, SOLID LT & RT


646.412 DURABLE 4 INCH YELLOW LINE, THERMOPLASTIC  
 (ALL LINES WILL INCLUDE C BREAKS FOR SIDE ROADS)  
 STA. 188+50 TO 194+50, SOLID LT & RT

646.602 TEMPORARY 4 INCH WHITE LINE, PAINT  
 (ALL LINES WILL INCLUDE EDGE LINE BREAKS AND  
 RADII FOR SIDE ROADS)  
 STA. 188+50 TO 194+50, SOLID LT & RT

646.612 TEMPORARY 4 INCH YELLOW LINE, PAINT  
 (ALL LINES WILL INCLUDE C BREAKS FOR SIDE ROADS)  
 STA. 188+50 TO 194+50, SOLID LT & RT

675.50 REMOVING SIGNS  
 AS SHOWN - 1

619.17 YIELDING MARKER POSTS  
 STA. 189+00, LT & RT

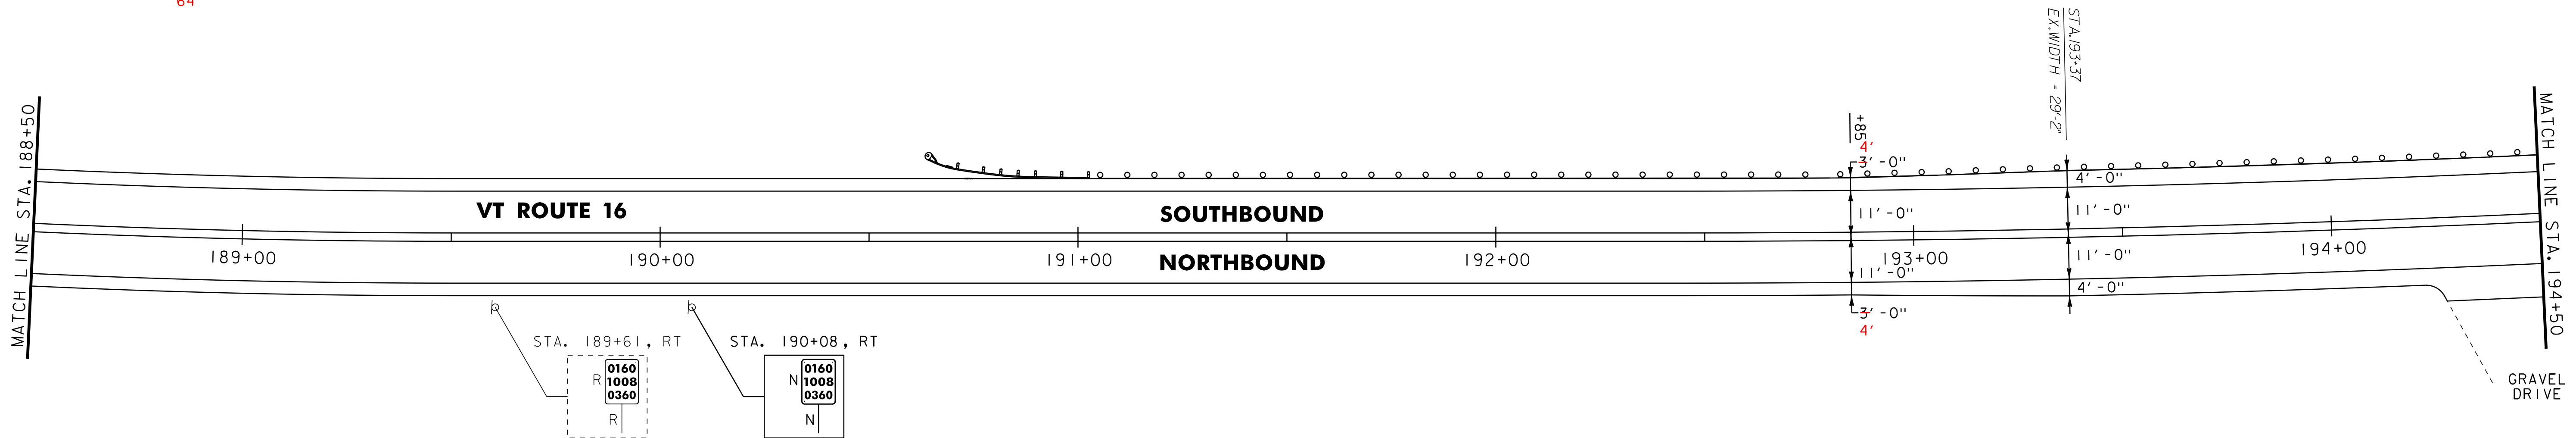

- NOTES:
- FOR LEGENDS, SEE LAYOUT SHEET #1.
  - ALL EXISTING SIGNS NOT SHOWN SHALL BE RETAINED.

NOT TO SCALE

**PROJECT  
 LAYOUT  
 SHEET #4**



PROJECT NAME: GLOVER - BARTON  
 PROJECT NUMBER: STP 2318(I)

FILE NAME: p01b034.dgn  
 PROJECT LEADER: JLL  
 DESIGNED BY: STANTEC  
 IPARM FILE: p01b034I04.i

PLOT DATE: 28-NOV-2012 15:0  
 DRAWN BY: STANTEC  
 CHECKED BY: STANTEC  
 SHEET 16 OF 60