

621.20 STEEL BEAM GUARDRAIL, GALVANIZED

STA. 194+50.0 TO 195+26.5, LT
STA. 194+95.5 TO 195+70.5, RT

621.50 MANUFACTURED TERMINAL SECTION, FLARED

STA. 194+58.0 TO 194+95.5, RT
STA. 195+26.5 TO 195+64.0, LT
STA. 195+70.5 TO 196+08.0, RT

621.80 REMOVAL AND DISPOSAL OF GUARDRAIL

STA. 194+50 TO 195+64, LT
STA. 194+58 TO 196+10, RT

646.402 DURABLE 4 INCH WHITE LINE, THERMOPLASTIC

(ALL LINES WILL INCLUDE EDGE LINE BREAKS AND RADIi FOR SIDE ROADS)
STA. 194+50 TO 200+50, SOLID LT & RT

646.412 DURABLE 4 INCH YELLOW LINE, THERMOPLASTIC

(ALL LINES WILL INCLUDE @ BREAKS FOR SIDE ROADS)
STA. 194+50 TO 200+50, SOLID LT & RT

646.602 TEMPORARY 4 INCH WHITE LINE, PAINT

(ALL LINES WILL INCLUDE EDGE LINE BREAKS AND RADIi FOR SIDE ROADS)
STA. 194+50 TO 200+50, SOLID LT & RT

646.612 TEMPORARY 4 INCH YELLOW LINE, PAINT

(ALL LINES WILL INCLUDE @ BREAKS FOR SIDE ROADS)
STA. 194+50 TO 200+50, SOLID LT & RT

613.10 STONE FILL TYPE I

STA. 194+55 TO 194+98, LT (DITCH)

613.11 STONE FILL TYPE II

STA. 195+27 TO 195+46, RT (SLOPE EROSION REPAIR)


675.50 REMOVING SIGNS
AS SHOWN - 3

621.60 ANCHOR FOR STEEL BEAM RAIL

STA. 194+60, RT
STA. 196+14, RT

621.205 STEEL BEAM GUARDRAIL WITH 8FT POST

STA. 194+60 TO 195+74.5 RT

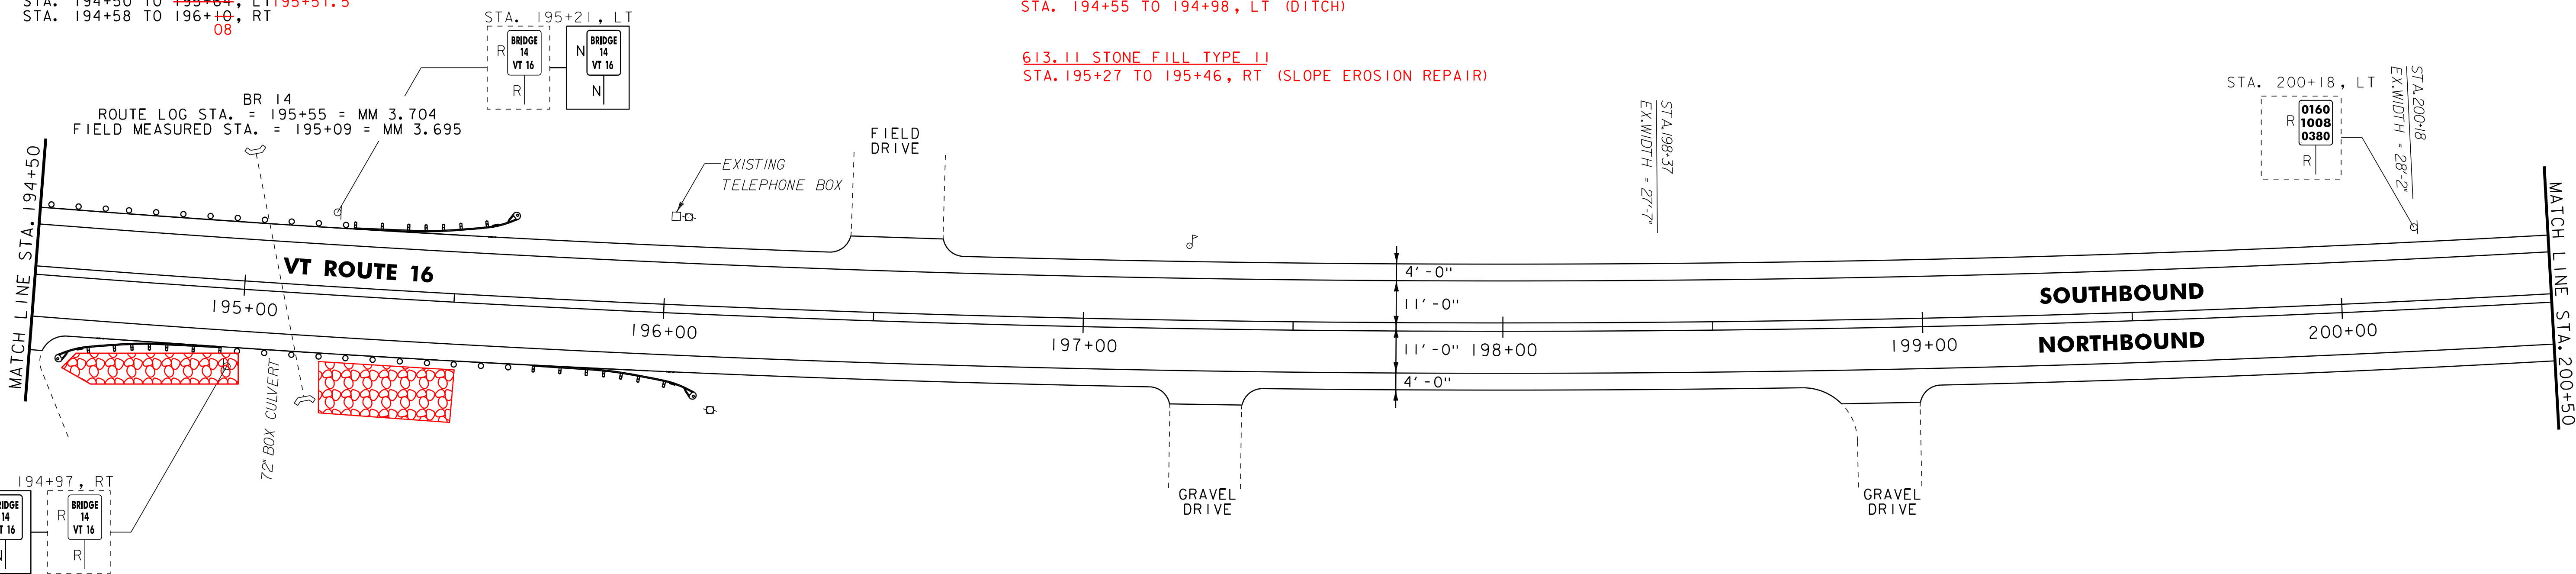

525.10 REMOVAL OF EXISTING RAILING

STA. 206+37.0 TO 206+50.0, LT
STA. 206+35.0 TO 206+50.0, RT
(SEE BRIDGE DETAIL SHEETS)

525.60 BRIDGE RAILING REPAIR, TYPE III

STA. 206+37.0 TO 206+50.0, LT
STA. 206+35.0 TO 206+50.0, RT
(SEE BRIDGE DETAIL SHEETS)

STA. 200+64, LT

621.20 STEEL BEAM GUARDRAIL, GALVANIZED

STA. 205+68.25 TO 206+05.75, LT
STA. 206+03.75 TO 206+35.0, RT

621.21 HD STEEL BEAM GUARDRAIL, GALVANIZED

STA. 206+05.75 TO 206+37.0, LT
STA. 206+03.75 TO 206+35.0, RT

621.50 MANUFACTURED TERMINAL SECTION, FLARED

STA. 205+30.75 TO 205+68.25, LT
STA. 205+66.25 TO 206+03.75, RT

621.80 REMOVAL AND DISPOSAL OF GUARDRAIL

STA. 205+68 TO 206+35, RT
STA. 205+73 TO 206+37, LT

646.402 DURABLE 4 INCH WHITE LINE, THERMOPLASTIC

(ALL LINES WILL INCLUDE EDGE LINE BREAKS AND RADIi FOR SIDE ROADS)
STA. 200+50 TO 206+50, SOLID LT & RT

646.412 DURABLE 4 INCH YELLOW LINE, THERMOPLASTIC

(ALL LINES WILL INCLUDE @ BREAKS FOR SIDE ROADS)
STA. 200+50 TO 206+50, SOLID LT & RT

646.602 TEMPORARY 4 INCH WHITE LINE, PAINT

(ALL LINES WILL INCLUDE EDGE LINE BREAKS AND RADIi FOR SIDE ROADS)
STA. 200+50 TO 206+50, SOLID LT & RT

646.612 TEMPORARY 4 INCH YELLOW LINE, PAINT

(ALL LINES WILL INCLUDE @ BREAKS FOR SIDE ROADS)
STA. 200+50 TO 206+50, SOLID LT & RT

675.50 REMOVING SIGNS


AS SHOWN - 1

613.10 STONE FILL, TYPE I

STA. 206+37, LT

STA. 206+42, LT
SLOPE EROSION REPAIR
SEE MISCELLANEOUS
DETAIL SHEET #2

STA. 205+96, LT - EXISTING UTILITY POLE
SEE REDUCED GUARDRAIL POST SPACING
ON BRIDGE DETAIL SHEET #2

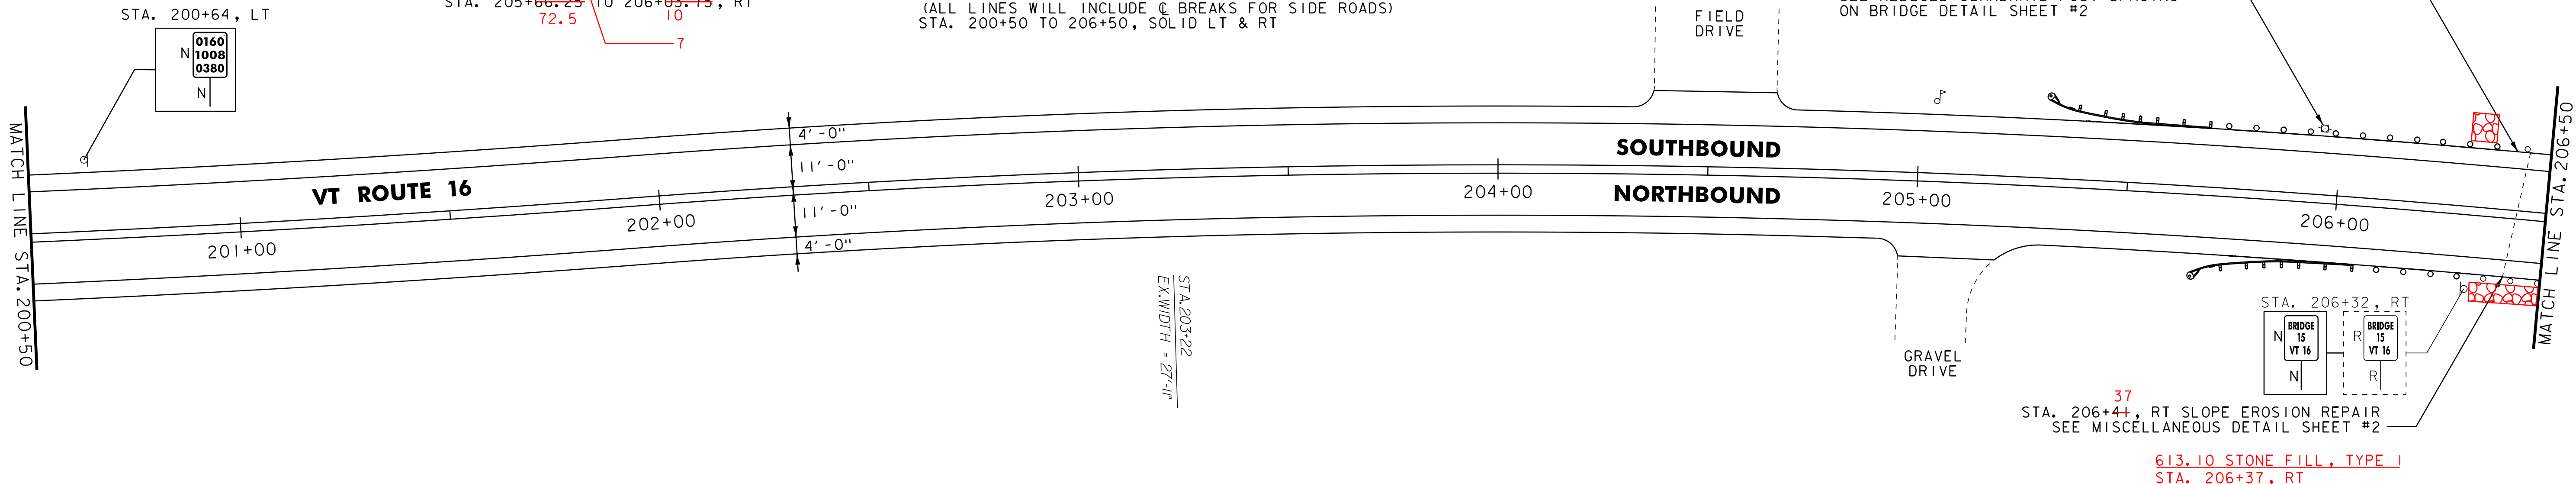

NOTES:

- FOR LEGENDS, SEE LAYOUT SHEET #1.
- ALL EXISTING SIGNS NOT SHOWN SHALL BE RETAINED.



NOT TO SCALE

PROJECT LAYOUT SHEET #5

PROJECT NAME: GLOVER - BARTON

PROJECT NUMBER: STP 2318(I)

FILE NAME: p01b034.dgn

PROJECT LEADER: JLL

DESIGNED BY: STANTEC

IPARM FILE: p01b034I05.i

PLOT DATE: 28-NOV-2012 15:0

DRAWN BY: STANTEC

CHECKED BY: STANTEC

SHEET 17 OF 60