

525.10 REMOVAL OF EXISTING RAILING

STA. 206+50.0 TO 206+85.0, RT
 STA. 206+50.0 TO 206+87.0, LT
 (SEE BRIDGE DETAIL SHEETS)

525.60 BRIDGE RAILING REPAIR, TYPE III

STA. 206+50.0 TO 206+85.0, RT
 STA. 206+50.0 TO 206+87.0, LT
 (SEE BRIDGE DETAIL SHEETS)

621.21 HD STEEL BEAM GUARDRAIL, GALVANIZED

STA. 206+85.0 TO 207+6.25, RT 10
 STA. 206+87.0 TO 207+18.25, LT 12

621.50 MANUFACTURED TERMINAL SECTION, FLARED

STA. 207+16.25 TO 207+53.75, RT 47.5
 STA. 207+18.25 TO 207+55.75, LT 49.5

12 10

621.80 REMOVAL AND DISPOSAL OF GUARDRAIL

STA. 206+85 TO 207+50, RT
 STA. 206+87 TO 207+54, LT

646.402 DURABLE 4 INCH WHITE LINE, THERMOPLASTIC

(ALL LINES WILL INCLUDE EDGE LINE BREAKS AND RADIUS FOR SIDE ROADS)
 STA. 206+50 TO 212+50, SOLID LT & RT
 STA. 209+48, SOLID RT (PARISH SCHOOL ROAD)

646.412 DURABLE 4 INCH YELLOW LINE, THERMOPLASTIC

(ALL LINES WILL INCLUDE C BREAKS FOR SIDE ROADS)
 STA. 206+50 TO 212+50, SOLID LT & RT
 STA. 209+48, DOUBLE SOLID RT (PARISH SCHOOL ROAD)

646.482 DURABLE 24 INCH STOP BAR, THERMOPLASTIC

STA. 209+48, RT (PARISH SCHOOL ROAD)

646.492 DURABLE LETTER OR SYMBOL, THERMOPLASTIC

STA. 209+48, RT (PARISH SCHOOL ROAD) - "STOP"

646.602 TEMPORARY 4 INCH WHITE LINE, PAINT

(ALL LINES WILL INCLUDE EDGE LINE BREAKS AND RADIUS FOR SIDE ROADS)
 STA. 206+50 TO 212+50, SOLID LT & RT
 STA. 209+48, SOLID RT (PARISH SCHOOL ROAD)

646.612 TEMPORARY 4 INCH YELLOW LINE, PAINT

(ALL LINES WILL INCLUDE C BREAKS FOR SIDE ROADS)
 STA. 206+50 TO 212+50, SOLID LT & RT
 STA. 209+48, DOUBLE SOLID RT (PARISH SCHOOL ROAD)

646.682 TEMPORARY 24 INCH STOP BAR, PAINT


STA. 209+48, RT (PARISH SCHOOL ROAD)

646.692 TEMPORARY LETTER OR SYMBOL, PAINT

STA. 209+48, RT (PARISH SCHOOL ROAD) - "STOP"

675.50 REMOVING SIGNS

AS SHOWN - 1

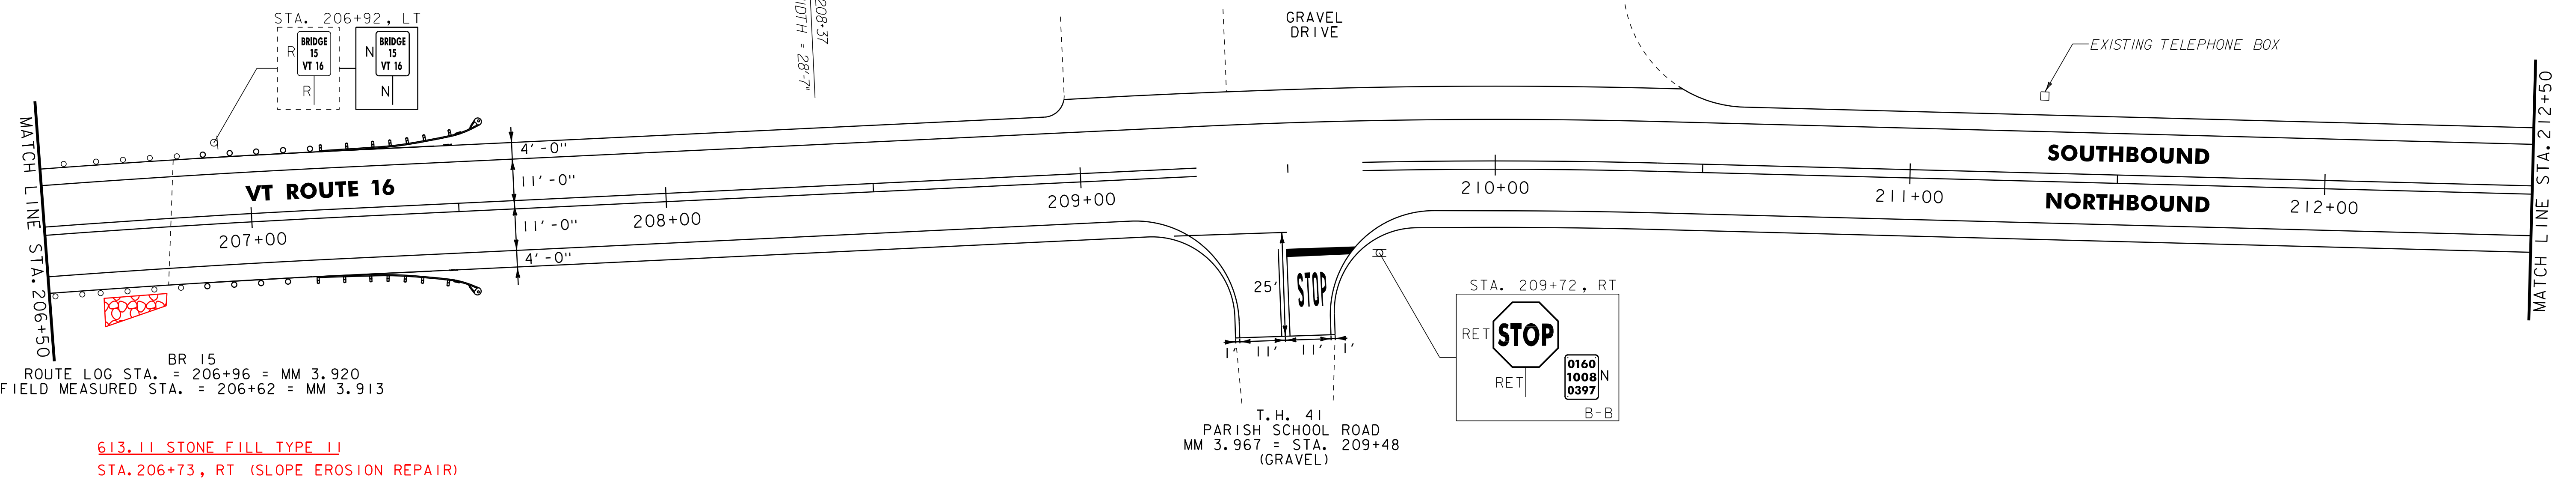

613.11 STONE FILL TYPE I1
 STA. 206+73, RT (SLOPE EROSION REPAIR)


BR 15
 ROUTE LOG STA. = 206+96 = MM 3.920
 FIELD MEASURED STA. = 206+62 = MM 3.913

646.402 DURABLE 4 INCH WHITE LINE, THERMOPLASTIC
 (ALL LINES WILL INCLUDE EDGE LINE BREAKS AND RADIUS FOR SIDE ROADS)
 STA. 212+50 TO 218+50, SOLID LT & RT

646.412 DURABLE 4 INCH YELLOW LINE, THERMOPLASTIC
 (ALL LINES WILL INCLUDE C BREAKS FOR SIDE ROADS)
 STA. 212+50 TO 218+50, SOLID LT & RT

646.602 TEMPORARY 4 INCH WHITE LINE, PAINT
 (ALL LINES WILL INCLUDE EDGE LINE BREAKS AND RADIUS FOR SIDE ROADS)
 STA. 212+50 TO 218+50, SOLID LT & RT

646.612 TEMPORARY 4 INCH YELLOW LINE, PAINT
 (ALL LINES WILL INCLUDE C BREAKS FOR SIDE ROADS)
 STA. 212+50 TO 218+50, SOLID LT & RT

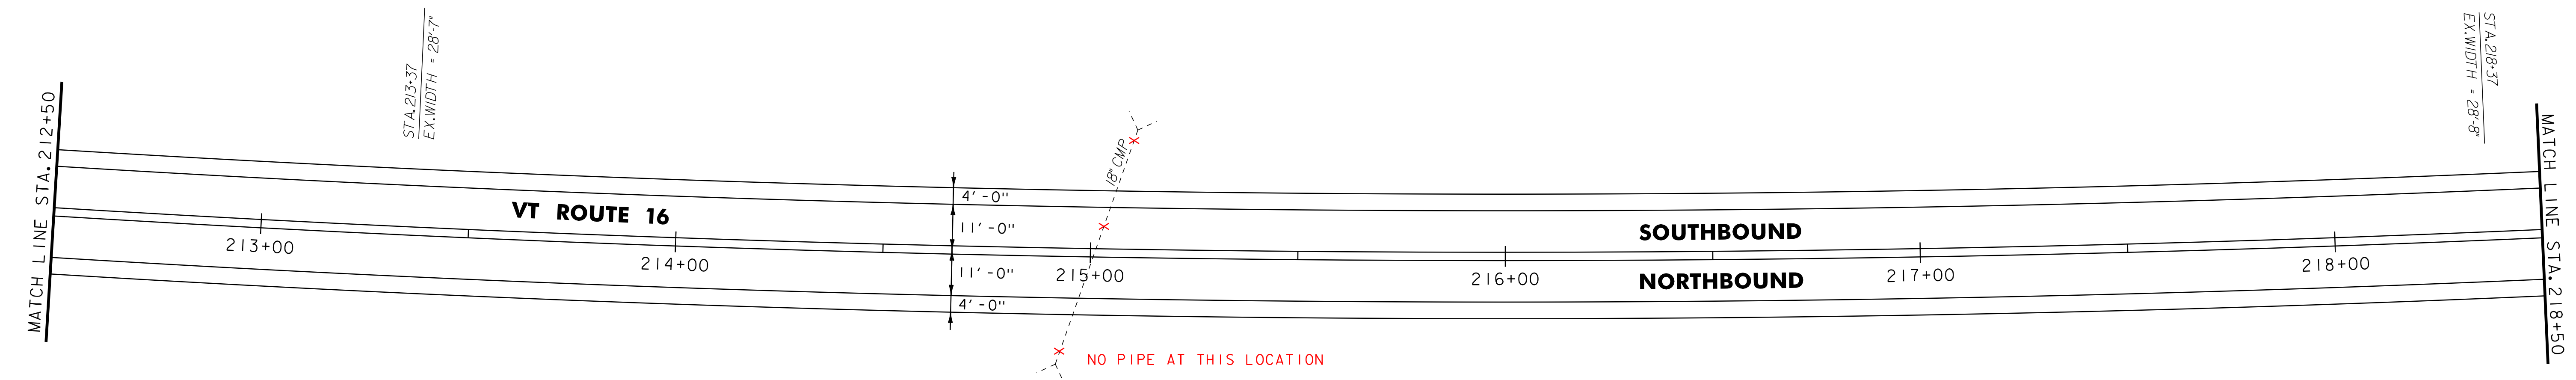

- NOTES:
- FOR LEGENDS, SEE LAYOUT SHEET #1.
 - ALL EXISTING SIGNS NOT SHOWN SHALL BE RETAINED.

NOT TO SCALE

PROJECT LAYOUT SHEET #6



PROJECT NAME: GLOVER - BARTON	FILE NAME: p01b034.dgn	PLOT DATE: 28-NOV-2012 15:00
PROJECT NUMBER: STP 2318(I)	PROJECT LEADER: JLL	DRAWN BY: STANTEC
	DESIGNED BY: STANTEC	CHECKED BY: STANTEC
	IPARM FILE: p01b034I06.i	SHEET 18 OF 60