

646.402 DURABLE 4 INCH WHITE LINE, THERMOPLASTIC  
 (ALL LINES WILL INCLUDE EDGE LINE BREAKS AND  
 RADI FOR SIDE ROADS)  
 STA. 228+00 TO 234+00, SOLID LT & RT  
 STA. 229+95, SOLID LT (PERRON HILL)

646.412 DURABLE 4 INCH YELLOW LINE, THERMOPLASTIC  
 (ALL LINES WILL INCLUDE C BREAKS FOR SIDE ROADS)  
 STA. 228+00 TO 234+00, SOLID LT & RT  
 STA. 229+95, DOUBLE SOLID LT (PERRON HILL)

646.482 DURABLE 24 INCH STOP BAR, THERMOPLASTIC  
 STA. 229+95, LT (PERRON HILL)

646.492 DURABLE LETTER OR SYMBOL, THERMOPLASTIC  
 STA. 229+95, LT (PERRON HILL) - "STOP"

646.602 TEMPORARY 4 INCH WHITE LINE, PAINT  
 (ALL LINES WILL INCLUDE EDGE LINE BREAKS AND  
 RADI FOR SIDE ROADS)  
 STA. 228+00 TO 234+00, SOLID LT & RT  
 STA. 229+95, SOLID LT (PERRON HILL)

646.612 TEMPORARY 4 INCH YELLOW LINE, PAINT  
 (ALL LINES WILL INCLUDE C BREAKS FOR SIDE ROADS)  
 STA. 228+00 TO 234+00, SOLID LT & RT  
 STA. 229+95, DOUBLE SOLID LT (PERRON HILL)


646.682 TEMPORARY 24 INCH STOP BAR, PAINT  
 STA. 229+95, LT (PERRON HILL)

646.692 TEMPORARY LETTER OR SYMBOL, PAINT  
 STA. 229+95, LT (PERRON HILL) - "STOP"

675.50 REMOVING SIGNS  
 AS SHOWN - I

619.17 YIELDING MARKER POSTS  
 STA. 228+20, LT & RT  
 STA. 233+20, LT & RT

NEW STOP SIGN WAS INSTALLED 5/11  
 UNDER STATEWIDE SIGN PROJECT

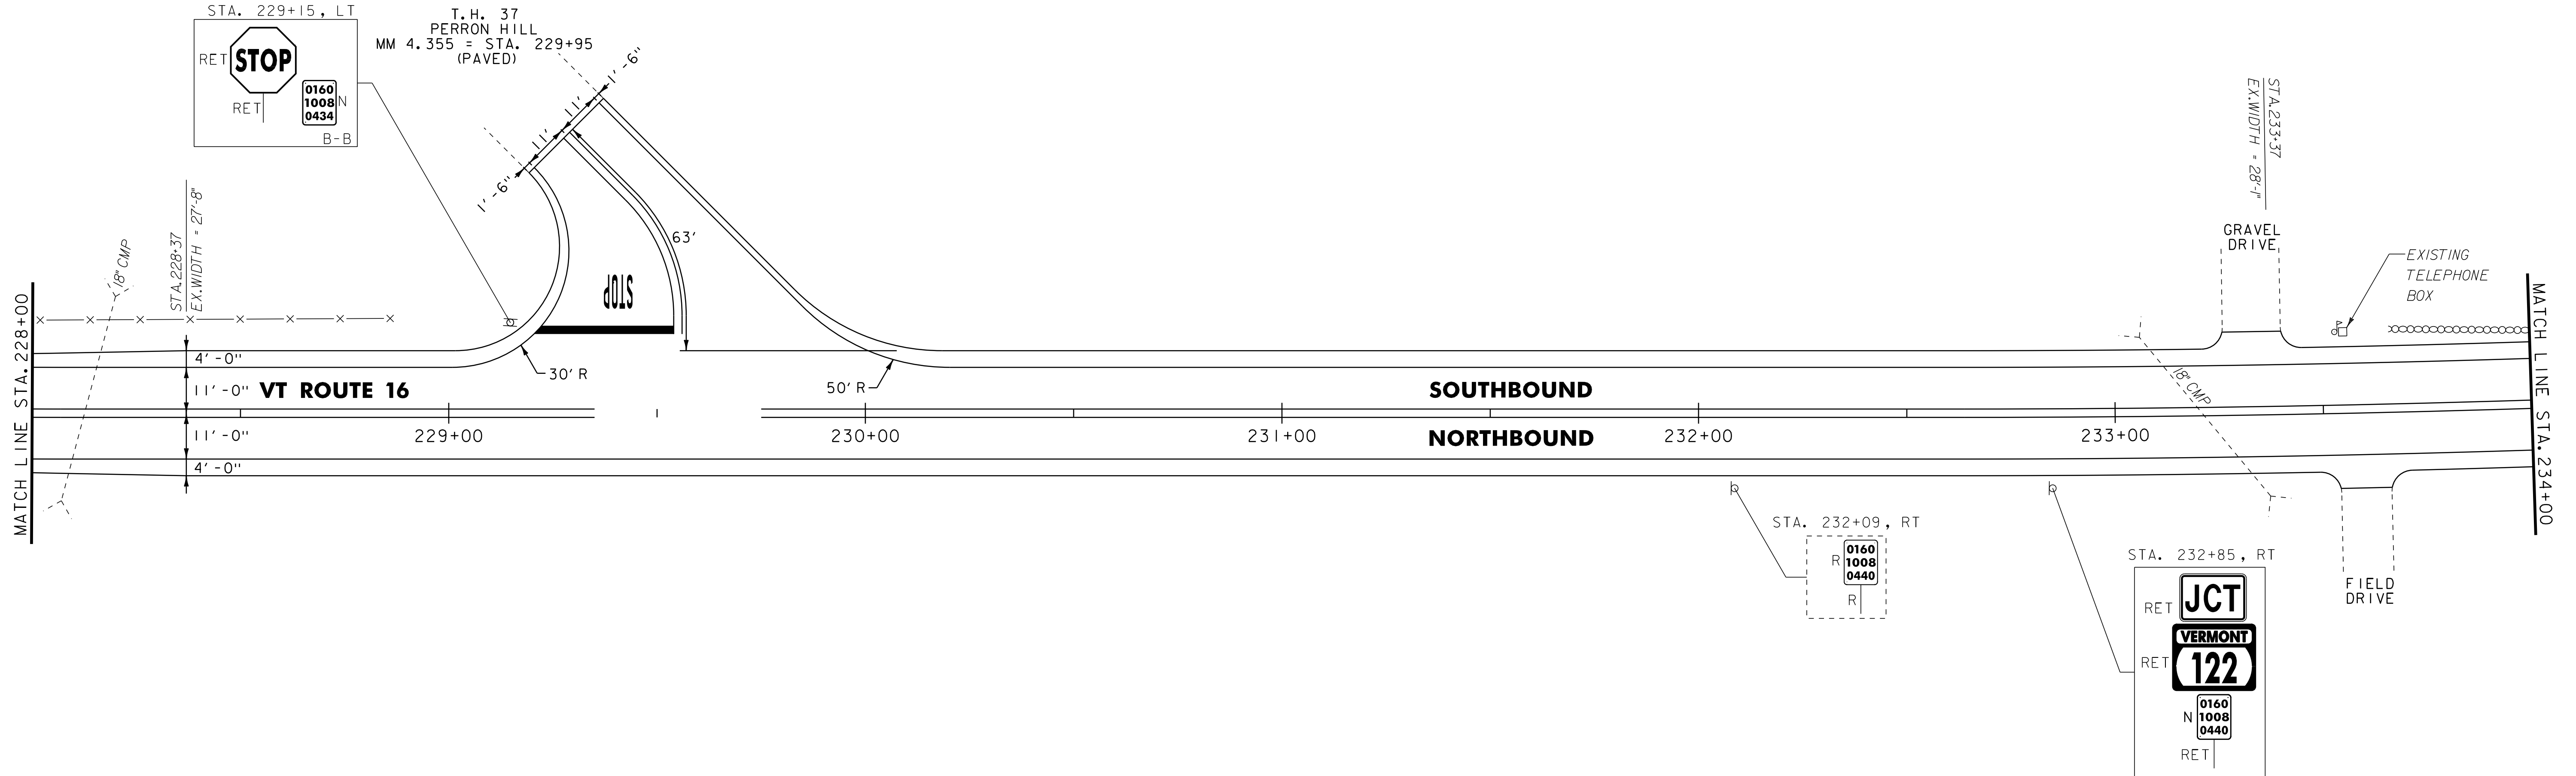

- NOTES:
- FOR LEGENDS, SEE LAYOUT SHEET #1.
  - ALL EXISTING SIGNS NOT SHOWN SHALL BE RETAINED.

NOT TO SCALE

**PROJECT LAYOUT SHEET #8**



PROJECT NAME: GLOVER - BARTON  
 PROJECT NUMBER: STP 2318(I)

FILE NAME: p01b034.dgn  
 PROJECT LEADER: JLL  
 DESIGNED BY: STANTEC  
 IPARM FILE: p01b034I08.i

PLOT DATE: 28-NOV-2012 15:0  
 DRAWN BY: STANTEC  
 CHECKED BY: STANTEC  
 SHEET 20 OF 60