

621.20 STEEL BEAM GUARDRAIL, GALVANIZED  
 STA. 237+82.0 TO 239+50.0, LT 237+80.5 TO 239+95, RT  
 VT 122 STA. 81+56.5, RT TO VT 16 STA. 239+09.2, RT  
 621.50 MANUFACTURED TERMINAL SECTION, FLARED  
 VT 122 STA. 81+19.0 TO 81+56.5, RT  
 VT 16 STA. 237+44.5 TO 237+82.0, LT  
 VT 16 STA. 239+09.2 TO 239+46.7, RT  
 621.80 REMOVAL AND DISPOSAL OF GUARDRAIL  
 STA. 238+47 TO 239+50, LT  
 VT 122 STA. 81+19, RT TO VT 16 STA. 239+44, RT

646.402 DURABLE 4 INCH WHITE LINE, THERMOPLASTIC  
 (ALL LINES WILL INCLUDE EDGE LINE BREAKS AND  
 RADI FOR SIDE ROADS)  
 STA. 234+00 TO 239+50, SOLID LT & RT  
 STA. 238+27, SOLID RT (VT ROUTE 122)  
 646.412 DURABLE 4 INCH YELLOW LINE, THERMOPLASTIC  
 (ALL LINES WILL INCLUDE C BREAKS FOR SIDE ROADS)  
 STA. 234+00 TO 239+50, SOLID LT & RT  
 STA. 238+27, DOUBLE SOLID RT (VT ROUTE 122)  
 646.482 DURABLE 24 INCH STOP BAR, THERMOPLASTIC  
 STA. 238+27, RT (VT ROUTE 122)  
 646.492 DURABLE LETTER OR SYMBOL, THERMOPLASTIC  
 STA. 238+27, RT (VT ROUTE 122) - "STOP"


646.602 TEMPORARY 4 INCH WHITE LINE, PAINT  
 (ALL LINES WILL INCLUDE EDGE LINE BREAKS AND  
 RADI FOR SIDE ROADS)  
 STA. 234+00 TO 239+50, SOLID LT & RT  
 STA. 238+27, SOLID RT (VT ROUTE 122)  
 646.612 TEMPORARY 4 INCH YELLOW LINE, PAINT  
 (ALL LINES WILL INCLUDE C BREAKS FOR SIDE ROADS)  
 STA. 234+00 TO 239+50, SOLID LT & RT  
 STA. 238+27, DOUBLE SOLID RT (VT ROUTE 122)  
 646.682 TEMPORARY 24 INCH STOP BAR, PAINT  
 STA. 238+27, RT (VT ROUTE 122)

646.692 TEMPORARY LETTER OR SYMBOL, PAINT  
 STA. 238+27, RT (VT ROUTE 122) - "STOP"  
 675.50 REMOVING SIGNS  
 AS SHOWN - +0-3  
 675.60 ERECTING SALVAGED SIGNS  
 AS SHOWN - 6

619.17 YIELDING MARKER POSTS  
 STA. 236+20, LT & RT  
 621.205 STEEL BEAM GUARDRAIL, WITH 8FT POST  
 VT 122 81+56.5 TO VT16 239+09 RT

239+05 TO 239+46.5  
 237+43 TO 237+80.5

613.11 STONE FILL, TYPE 11  
 STA. 238+63, RT  
 (SLOPE EROSION REPAIR)

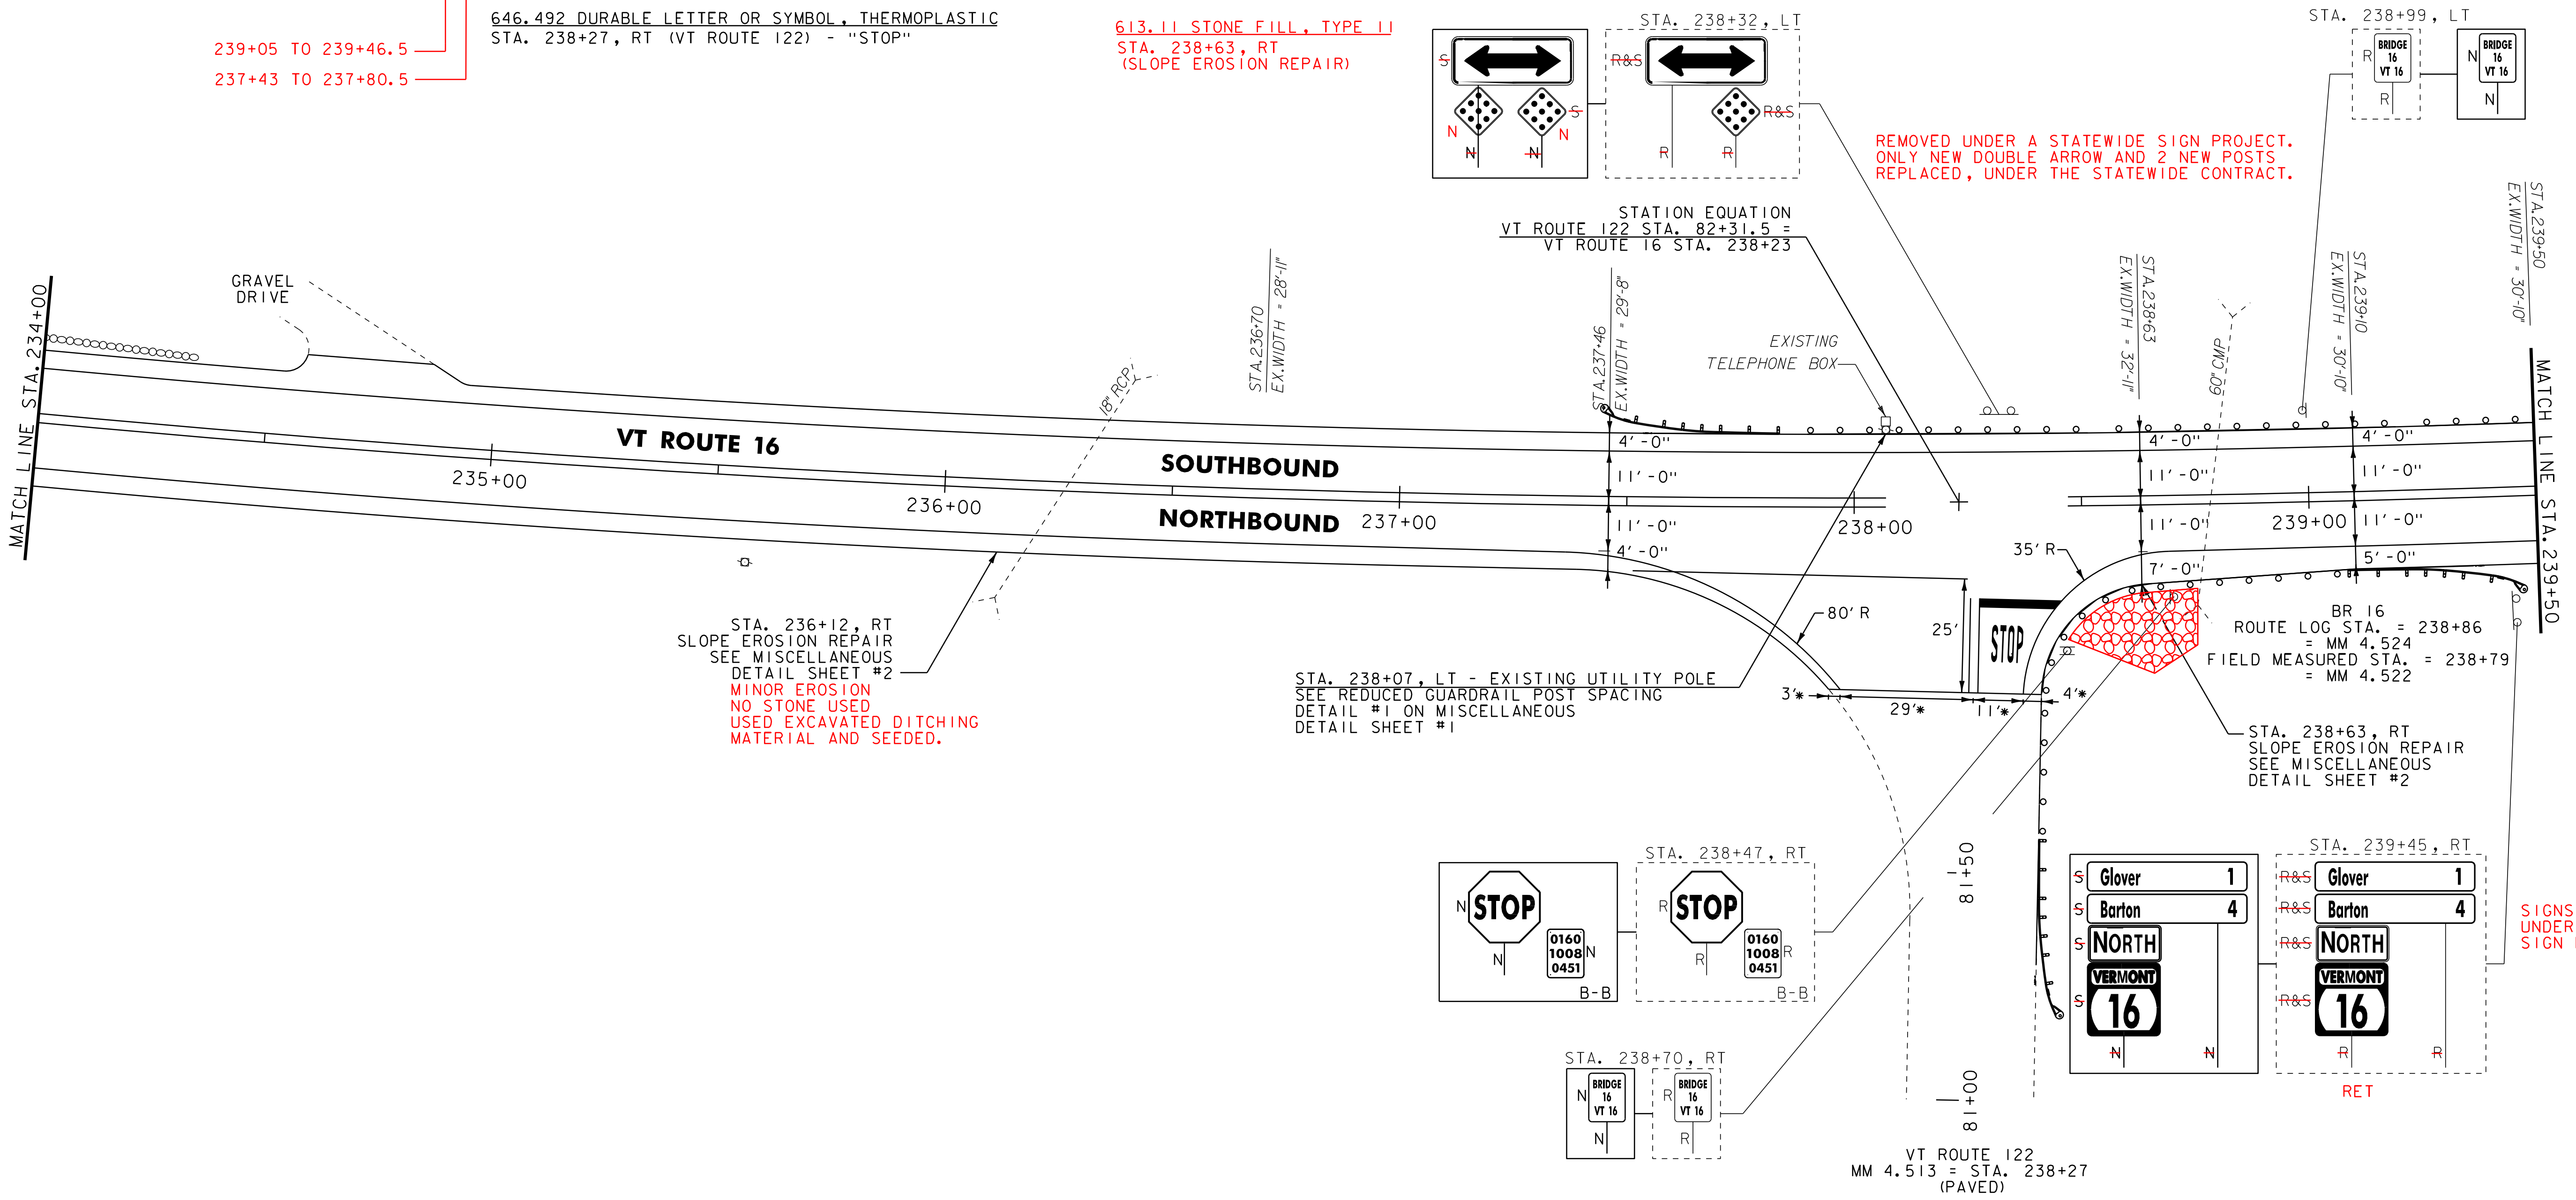

REMOVED UNDER A STATEWIDE SIGN PROJECT.  
 ONLY NEW DOUBLE ARROW AND 2 NEW POSTS  
 REPLACED, UNDER THE STATEWIDE CONTRACT.

SIGNS REPLACED 5/11  
 UNDER STATEWIDE  
 SIGN PROJECT.

\* MATCH EXISTING PAVEMENT MARKINGS  
 ON VT ROUTE 122

- NOTES:
- FOR LEGENDS, SEE LAYOUT SHEET #1.
  - ALL EXISTING SIGNS NOT SHOWN SHALL BE RETAINED.

NOT TO SCALE

<b>PROJECT LAYOUT SHEET #9</b>	PROJECT NAME: GLOVER - BARTON
	PROJECT NUMBER: STP 2318(I)
	FILE NAME: p01b034.dgn
	PLOT DATE: 28-NOV-2012 15:00
DESIGNED BY: STANTEC	DRAWN BY: STANTEC
CHECKED BY: STANTEC	SHEET 21 OF 60
IPARM FILE: p01b034I09.i	

