


621.20 STEEL BEAM GUARDRAIL, GALVANIZED  
 STA. 239+50.0 TO 239+57.0, LT  
~~621.50 MANUFACTURED TERMINAL SECTION, FLARED~~  
~~STA. 239+57.0 TO 239+94.5, LT~~  
 621.80 REMOVAL AND DISPOSAL OF GUARDRAIL  
 STA. 239+50 TO 239+89, LT  
 84.5

646.402 DURABLE 4 INCH WHITE LINE, THERMOPLASTIC  
 (ALL LINES WILL INCLUDE EDGE LINE BREAKS AND  
 RADII FOR SIDE ROADS)  
 STA. 239+50 TO 245+50, SOLID LT & RT  
 646.412 DURABLE 4 INCH YELLOW LINE, THERMOPLASTIC  
 (ALL LINES WILL INCLUDE C BREAKS FOR SIDE ROADS)  
 STA. 239+50 TO 245+50, SOLID LT & RT

646.602 TEMPORARY 4 INCH WHITE LINE, PAINT  
 (ALL LINES WILL INCLUDE EDGE LINE BREAKS AND  
 RADII FOR SIDE ROADS)  
 STA. 239+50 TO 245+50, SOLID LT & RT  
 646.612 TEMPORARY 4 INCH YELLOW LINE, PAINT  
 (ALL LINES WILL INCLUDE C BREAKS FOR SIDE ROADS)  
 STA. 239+50 TO 245+50, SOLID LT & RT


621.60 ANCHOR FOR STEEL BEAM RAIL  
 STA. 239+95, LT

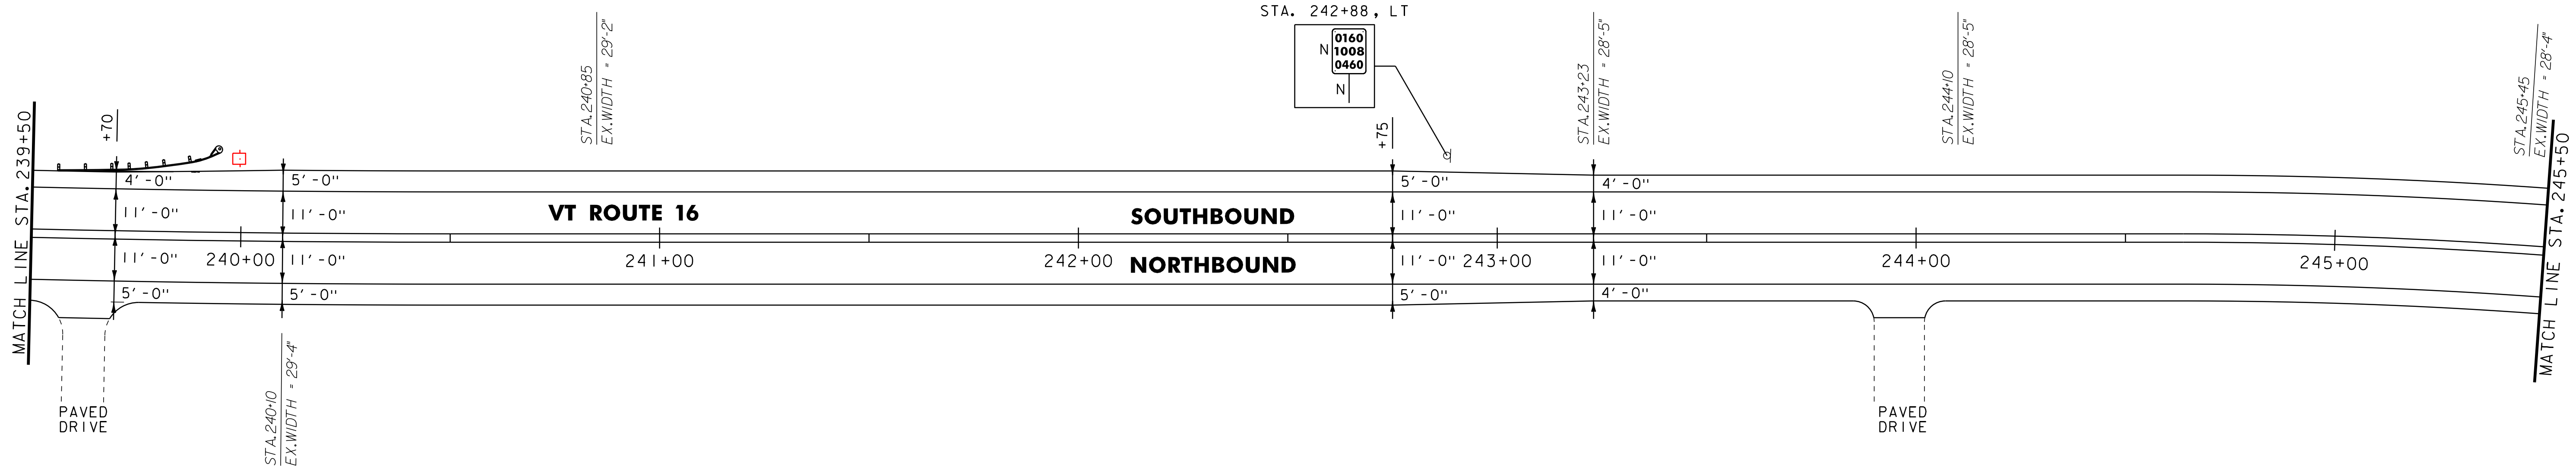

646.402 DURABLE 4 INCH WHITE LINE, THERMOPLASTIC  
 (ALL LINES WILL INCLUDE EDGE LINE BREAKS AND  
 RADII FOR SIDE ROADS)  
 STA. 245+50 TO 251+50, SOLID LT & RT  
 646.412 DURABLE 4 INCH YELLOW LINE, THERMOPLASTIC  
 (ALL LINES WILL INCLUDE C BREAKS FOR SIDE ROADS)  
 STA. 245+50 TO 251+50, SOLID LT & RT

646.602 TEMPORARY 4 INCH WHITE LINE, PAINT  
 (ALL LINES WILL INCLUDE EDGE LINE BREAKS AND  
 RADII FOR SIDE ROADS)  
 STA. 245+50 TO 251+50, SOLID LT & RT  
 646.612 TEMPORARY 4 INCH YELLOW LINE, PAINT  
 (ALL LINES WILL INCLUDE C BREAKS FOR SIDE ROADS)  
 STA. 245+50 TO 251+50, SOLID LT & RT

613.10 STONE FILL, TYPE 1  
 STA. 250+70 TO 251+50 RT

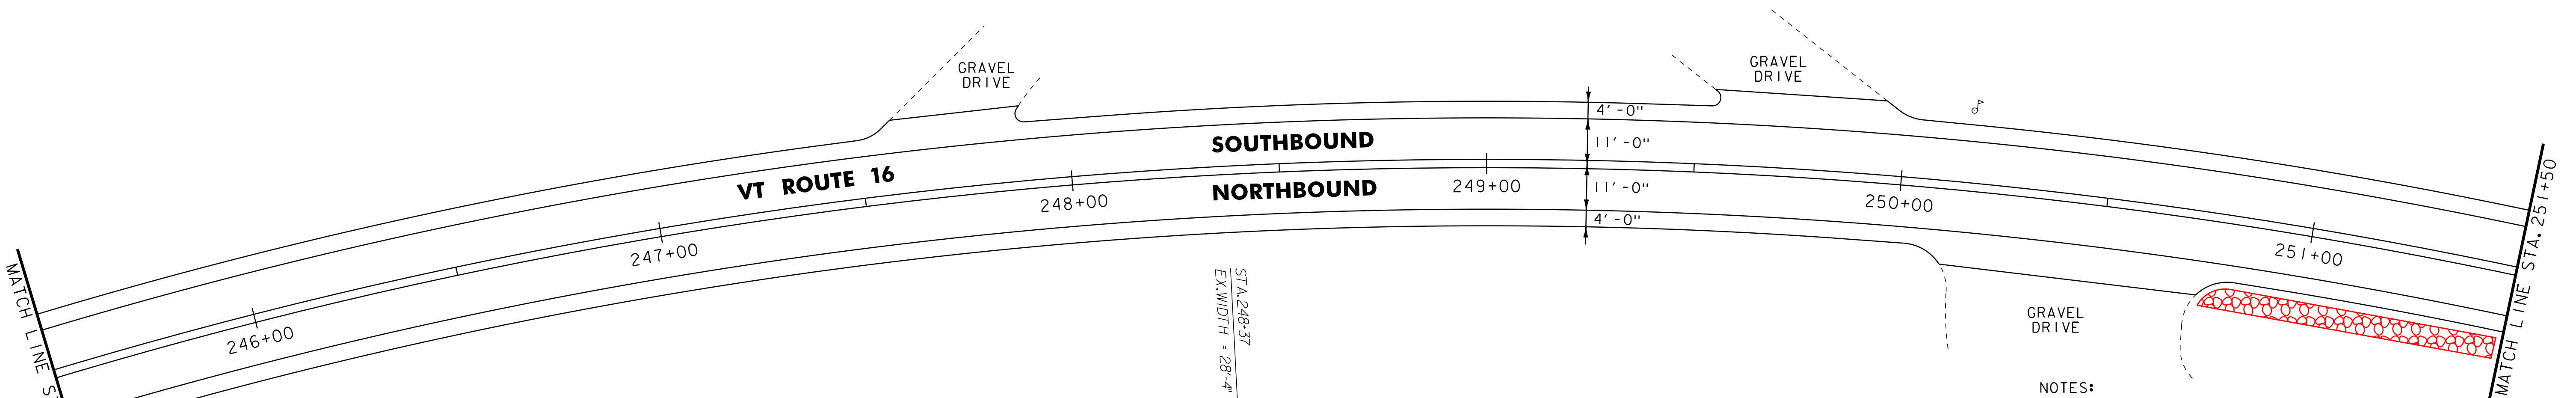

- NOTES:
1. FOR LEGENDS, SEE LAYOUT SHEET #1.
  2. ALL EXISTING SIGNS NOT SHOWN SHALL BE RETAINED.

NOT TO SCALE

**PROJECT  
 LAYOUT  
 SHEET #10**



PROJECT NAME: GLOVER - BARTON  
 PROJECT NUMBER: STP 2318(I)

FILE NAME: p01b034.dgn  
 PROJECT LEADER: JLL  
 DESIGNED BY: STANTEC  
 IPARM FILE: p01b034\10.i

PLOT DATE: 28-NOV-2012 15:0  
 DRAWN BY: STANTEC  
 CHECKED BY: STANTEC  
 SHEET 22 OF 60