


621.20 STEEL BEAM GUARDRAIL, GALVANIZED  
 STA. 286+50.0 TO 292+50.0, LT  
 621.80 REMOVAL AND DISPOSAL OF GUARDRAIL  
 STA. 286+50 TO 292+50, LT

646.402 DURABLE 4 INCH WHITE LINE, THERMOPLASTIC  
 (ALL LINES WILL INCLUDE EDGE LINE BREAKS AND  
 RADII FOR SIDE ROADS)  
 STA. 286+50 TO 292+50, SOLID LT & RT  
 646.412 DURABLE 4 INCH YELLOW LINE, THERMOPLASTIC  
 (ALL LINES WILL INCLUDE @ BREAKS FOR SIDE ROADS)  
 STA. 286+50 TO 292+50, SOLID LT & RT

646.602 TEMPORARY 4 INCH WHITE LINE, PAINT  
 (ALL LINES WILL INCLUDE EDGE LINE BREAKS AND  
 RADII FOR SIDE ROADS)  
 STA. 286+50 TO 292+50, SOLID LT & RT  
 646.612 TEMPORARY 4 INCH YELLOW LINE, PAINT  
 (ALL LINES WILL INCLUDE @ BREAKS FOR SIDE ROADS)  
 STA. 286+50 TO 292+50, SOLID LT & RT

619.17 YIELDING MARKER POSTS  
 STA. 287+10 RT  
 STA. 290+40 LT & RT  
 STA. 294+10 RT  
 STA. 295+60 RT  
 STA. 298+10 RT

613.11 STONE FILL, TYPE I  
 STA. 286+50 TO 287+00 RT (DITCH)  
 STA. 290+54 TO 292+50 RT (DITCH)

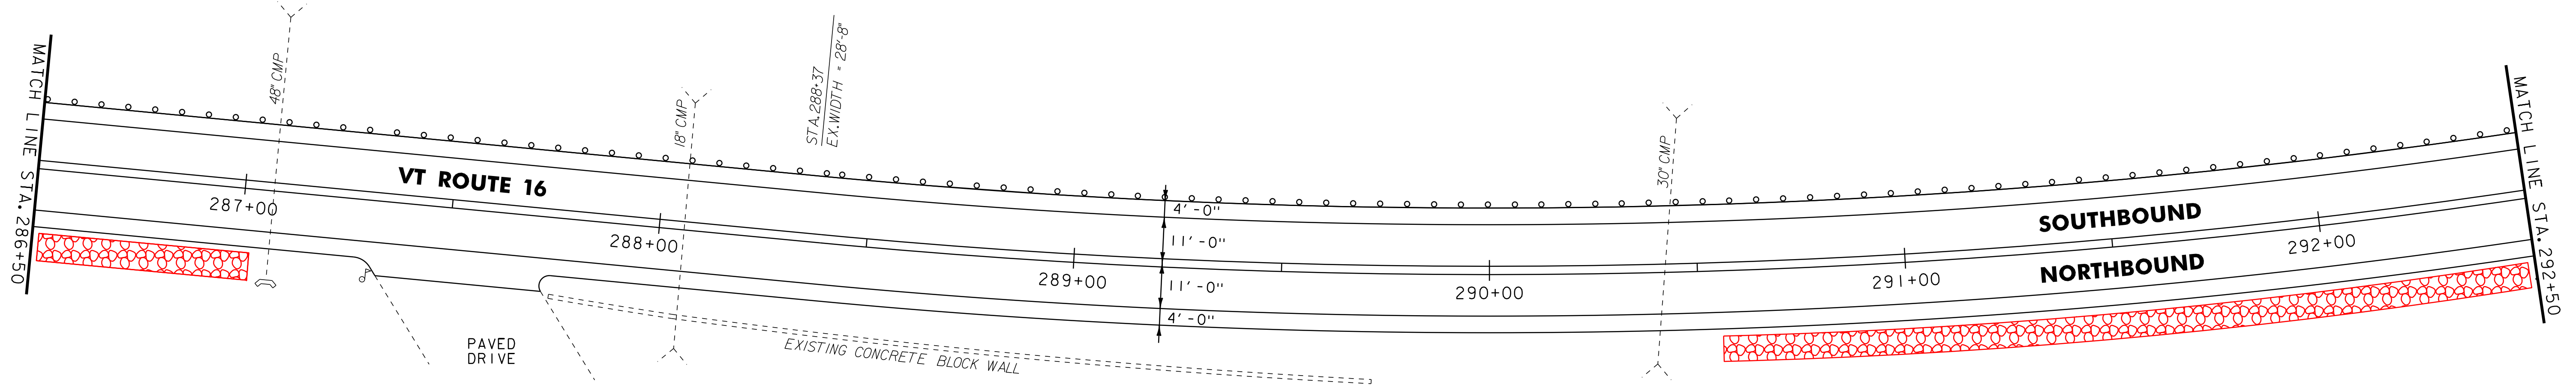

604.412 OR 604.415 REHAB.  
 DIS, CBS OR MHS, CLASS I OR II  
 STA. 298+15, RT


621.20 STEEL BEAM GUARDRAIL, GALVANIZED  
 STA. 292+50.0 TO 298+50.0, LT  
 621.80 REMOVAL AND DISPOSAL OF GUARDRAIL  
 STA. 292+50 TO 298+50, LT

646.402 DURABLE 4 INCH WHITE LINE, THERMOPLASTIC  
 (ALL LINES WILL INCLUDE EDGE LINE BREAKS AND  
 RADII FOR SIDE ROADS)  
 STA. 292+50 TO 298+50, SOLID LT & RT  
 646.412 DURABLE 4 INCH YELLOW LINE, THERMOPLASTIC  
 (ALL LINES WILL INCLUDE @ BREAKS FOR SIDE ROADS)  
 STA. 292+50 TO 298+50, SOLID LT & RT

646.602 TEMPORARY 4 INCH WHITE LINE, PAINT  
 (ALL LINES WILL INCLUDE EDGE LINE BREAKS AND  
 RADII FOR SIDE ROADS)  
 STA. 292+50 TO 298+50, SOLID LT & RT  
 646.612 TEMPORARY 4 INCH YELLOW LINE, PAINT  
 (ALL LINES WILL INCLUDE @ BREAKS FOR SIDE ROADS)  
 STA. 292+50 TO 298+50, SOLID LT & RT

675.50 REMOVING SIGNS  
 AS SHOWN - 1  
 675.60 ERECTING SALVAGED SIGNS  
 AS SHOWN - 1

613.10 STONE FILL, TYPE I  
 STA. 292+50 TO 292+56 RT (DITCH)  
 STA. 293+30 TO 294+07 RT (DITCH)  
 STA. 294+14 TO 295+23 RT (DITCH)

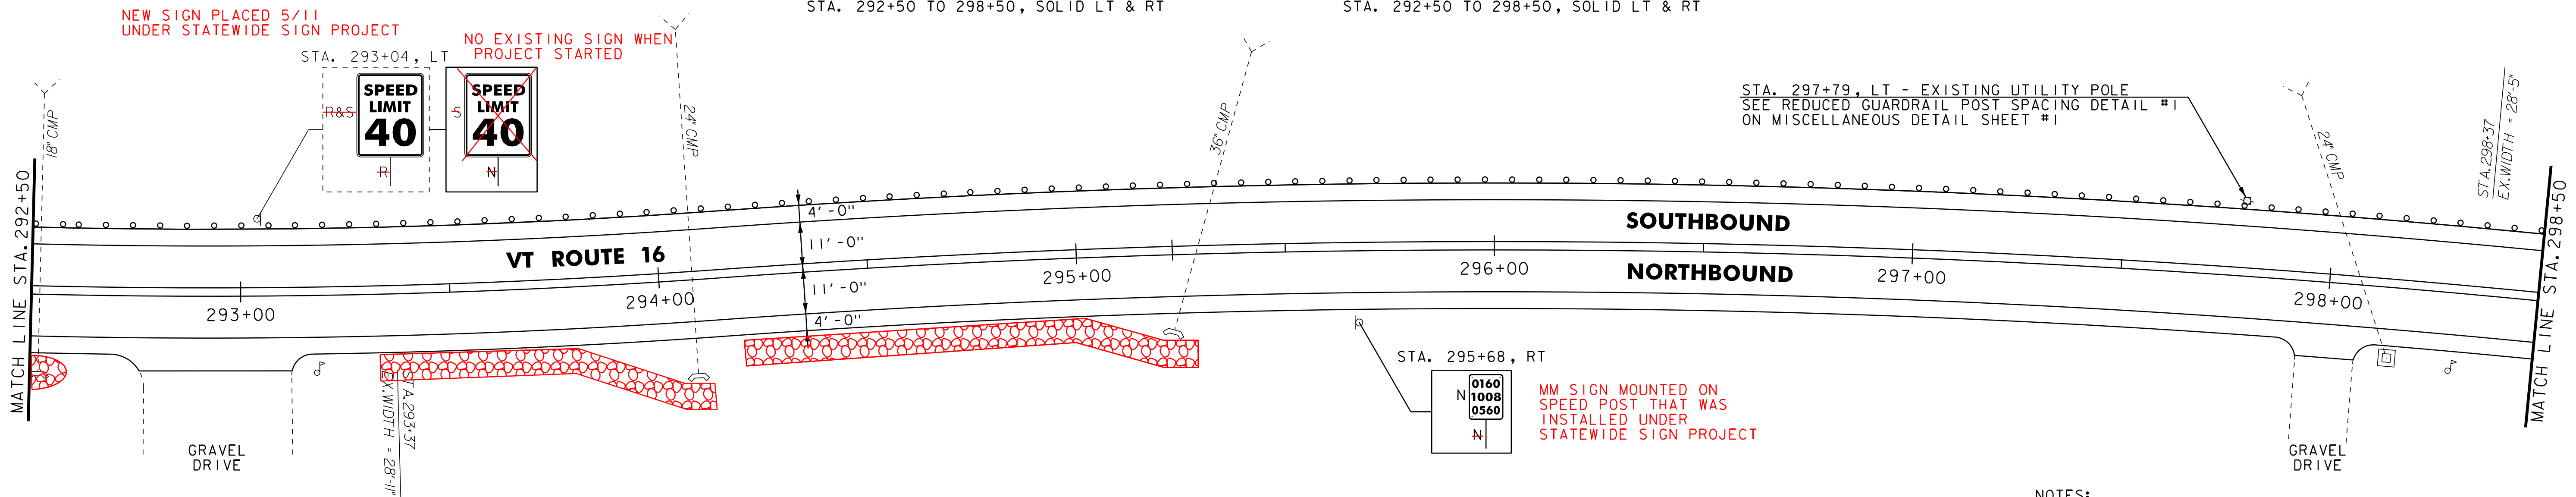

- NOTES:
- FOR LEGENDS, SEE LAYOUT SHEET #1.
  - ALL EXISTING SIGNS NOT SHOWN SHALL BE RETAINED.

NOT TO SCALE

**PROJECT LAYOUT SHEET #14**



PROJECT NAME: GLOVER - BARTON  
 PROJECT NUMBER: STP 2318(I)

FILE NAME: p01b034.dgn  
 PROJECT LEADER: JLL  
 DESIGNED BY: STANTEC  
 IPARM FILE: p01b034I14.i

PLOT DATE: 28-NOV-2012 15:0  
 DRAWN BY: STANTEC  
 CHECKED BY: STANTEC  
 SHEET 26 OF 60