

604.412 OR 604.415 REHAB.
DIS, CBS OR MHS, CLASS I OR II

STA. 299+44, RT
STA. 301+35, RT
STA. 303+12, LT
STA. 303+12, RT
STA. 304+35, LT
STA. 304+35, RT

621.20 STEEL BEAM GUARDRAIL, GALVANIZED

STA. 298+50.0 TO 300+33.0, LT

621.60 ANCHOR FOR STEEL BEAM RAIL

STA. 300+33.0, LT 300+22.5

621.80 REMOVAL AND DISPOSAL OF GUARDRAIL

STA. 298+50 TO 300+37, LT

646.402 DURABLE 4 INCH WHITE LINE, THERMOPLASTIC
(ALL LINES WILL INCLUDE EDGE LINE BREAKS AND RADIi FOR SIDE ROADS)

STA. 298+50 TO 304+50, SOLID LT & RT
STA. 302+80, SOLID LT (STILL HILL)

646.412 DURABLE 4 INCH YELLOW LINE, THERMOPLASTIC
(ALL LINES WILL INCLUDE C BREAKS FOR SIDE ROADS)

STA. 298+50 TO 304+50, SOLID LT & RT
STA. 302+80, DOUBLE SOLID LT (STILL HILL)

646.482 DURABLE 24 INCH STOP BAR, THERMOPLASTIC
STA. 302+80, LT (STILL HILL)

646.492 DURABLE LETTER OR SYMBOL, THERMOPLASTIC
STA. 302+80, LT (STILL HILL) - "STOP"

646.602 TEMPORARY 4 INCH WHITE LINE, PAINT
(ALL LINES WILL INCLUDE EDGE LINE BREAKS AND RADIi FOR SIDE ROADS)

STA. 298+50 TO 304+50, SOLID LT & RT
STA. 302+80, SOLID LT (STILL HILL)


646.612 TEMPORARY 4 INCH YELLOW LINE, PAINT
(ALL LINES WILL INCLUDE C BREAKS FOR SIDE ROADS)

STA. 298+50 TO 304+50, SOLID LT & RT
STA. 302+80, DOUBLE SOLID LT (STILL HILL)

646.682 TEMPORARY 24 INCH STOP BAR, PAINT
STA. 302+80, LT (STILL HILL)

646.692 TEMPORARY LETTER OR SYMBOL, PAINT
STA. 302+80, LT (STILL HILL) - "STOP"

619.17 YIELDING MARKER POSTS
STA. 301+40, RT

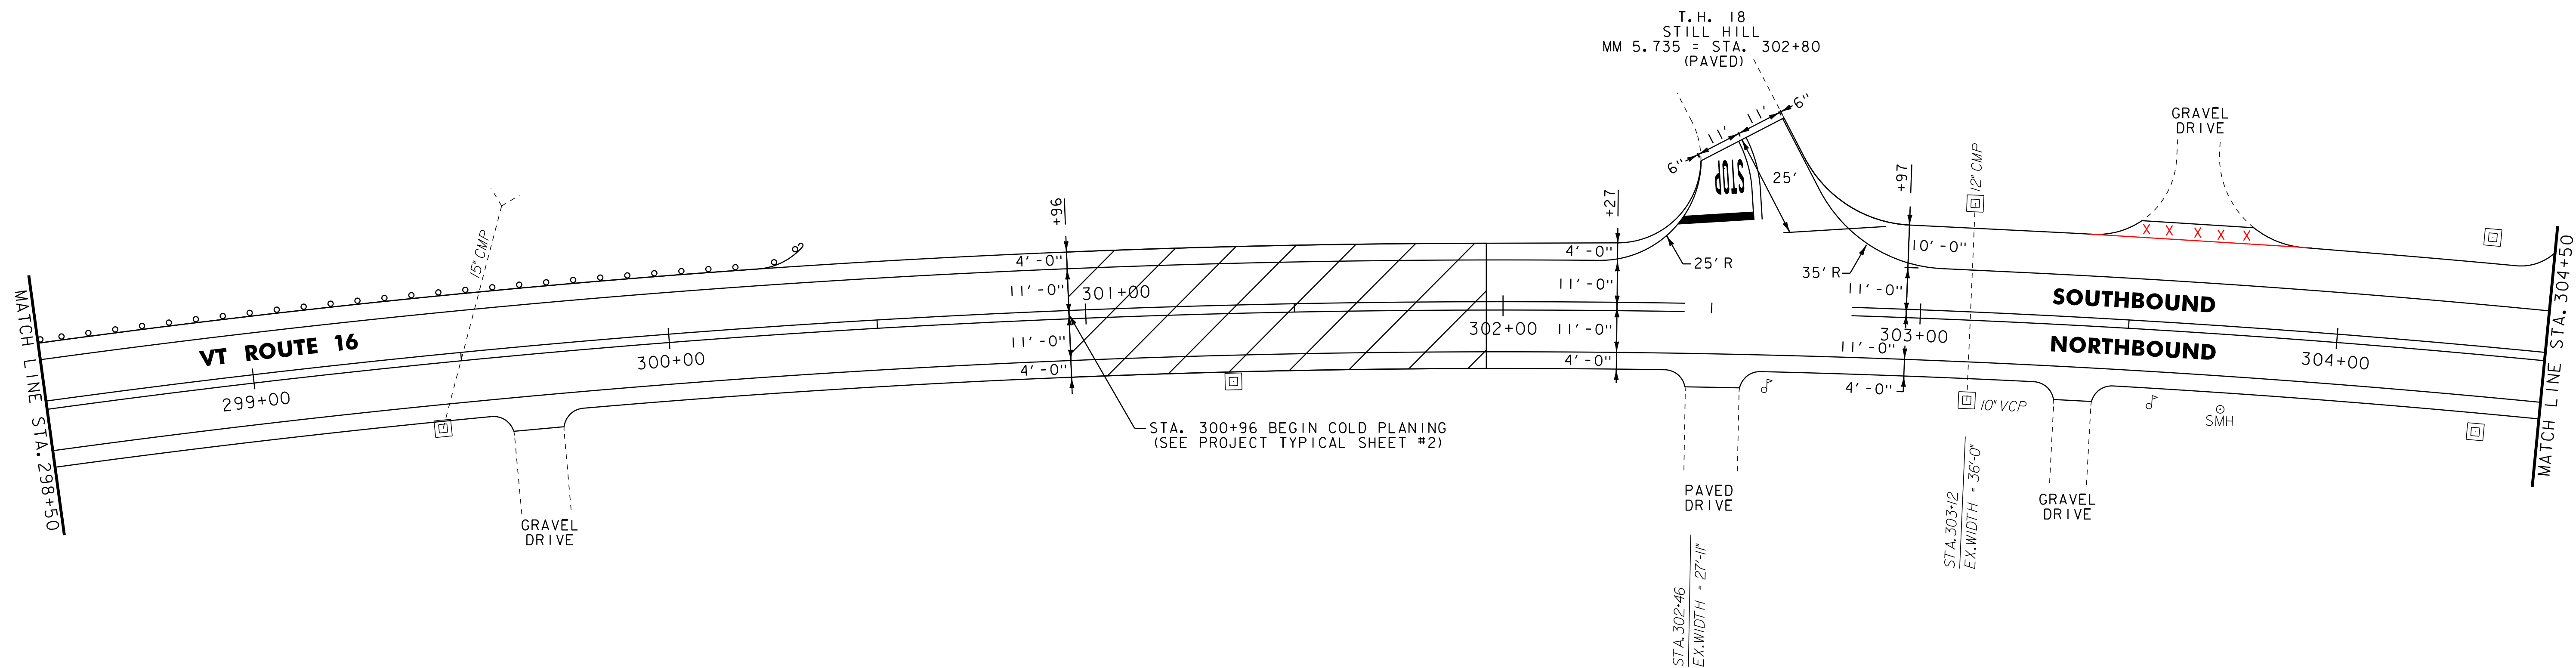

- NOTES:
- FOR LEGENDS, SEE LAYOUT SHEET #1.
 - ALL EXISTING SIGNS NOT SHOWN SHALL BE RETAINED.

NOT TO SCALE

PROJECT LAYOUT SHEET #15

PROJECT NAME: GLOVER - BARTON
PROJECT NUMBER: STP 2318(I)

FILE NAME: p01b034.dgn
PROJECT LEADER: JLL
DESIGNED BY: STANTEC
IPARM FILE: p01b034i15.i

PLOT DATE: 28-NOV-2012 15:00
DRAWN BY: STANTEC
CHECKED BY: STANTEC
SHEET 27 OF 60

 TRANSITION AREA
SEE PROJECT TYPICAL SHEET #2

