


604.412 OR 604.415 REHAB.  
 DIS, CBS OR MHS, CLASS I OR II  
 STA. 305+51, RT  
 STA. 305+59, LT  
 STA. 306+82, RT  
 STA. 307+32, LT  
 STA. 309+50, RT  
 STA. 309+70, LT  
 STA. 310+41, RT  
 STA. 310+41, LT

646.402 DURABLE 4 INCH WHITE LINE, THERMOPLASTIC  
 (ALL LINES WILL INCLUDE EDGE LINE BREAKS AND  
 RADII FOR SIDE ROADS)  
 STA. 304+50 TO 310+50, SOLID LT & RT  
 646.412 DURABLE 4 INCH YELLOW LINE, THERMOPLASTIC  
 (ALL LINES WILL INCLUDE @ BREAKS FOR SIDE ROADS)  
 STA. 304+50 TO 310+50, SOLID LT & RT

646.602 TEMPORARY 4 INCH WHITE LINE, PAINT  
 (ALL LINES WILL INCLUDE EDGE LINE BREAKS AND  
 RADII FOR SIDE ROADS)  
 STA. 304+50 TO 310+50, SOLID LT & RT  
 646.612 TEMPORARY 4 INCH YELLOW LINE, PAINT  
 (ALL LINES WILL INCLUDE @ BREAKS FOR SIDE ROADS)  
 STA. 304+50 TO 310+50, SOLID LT & RT

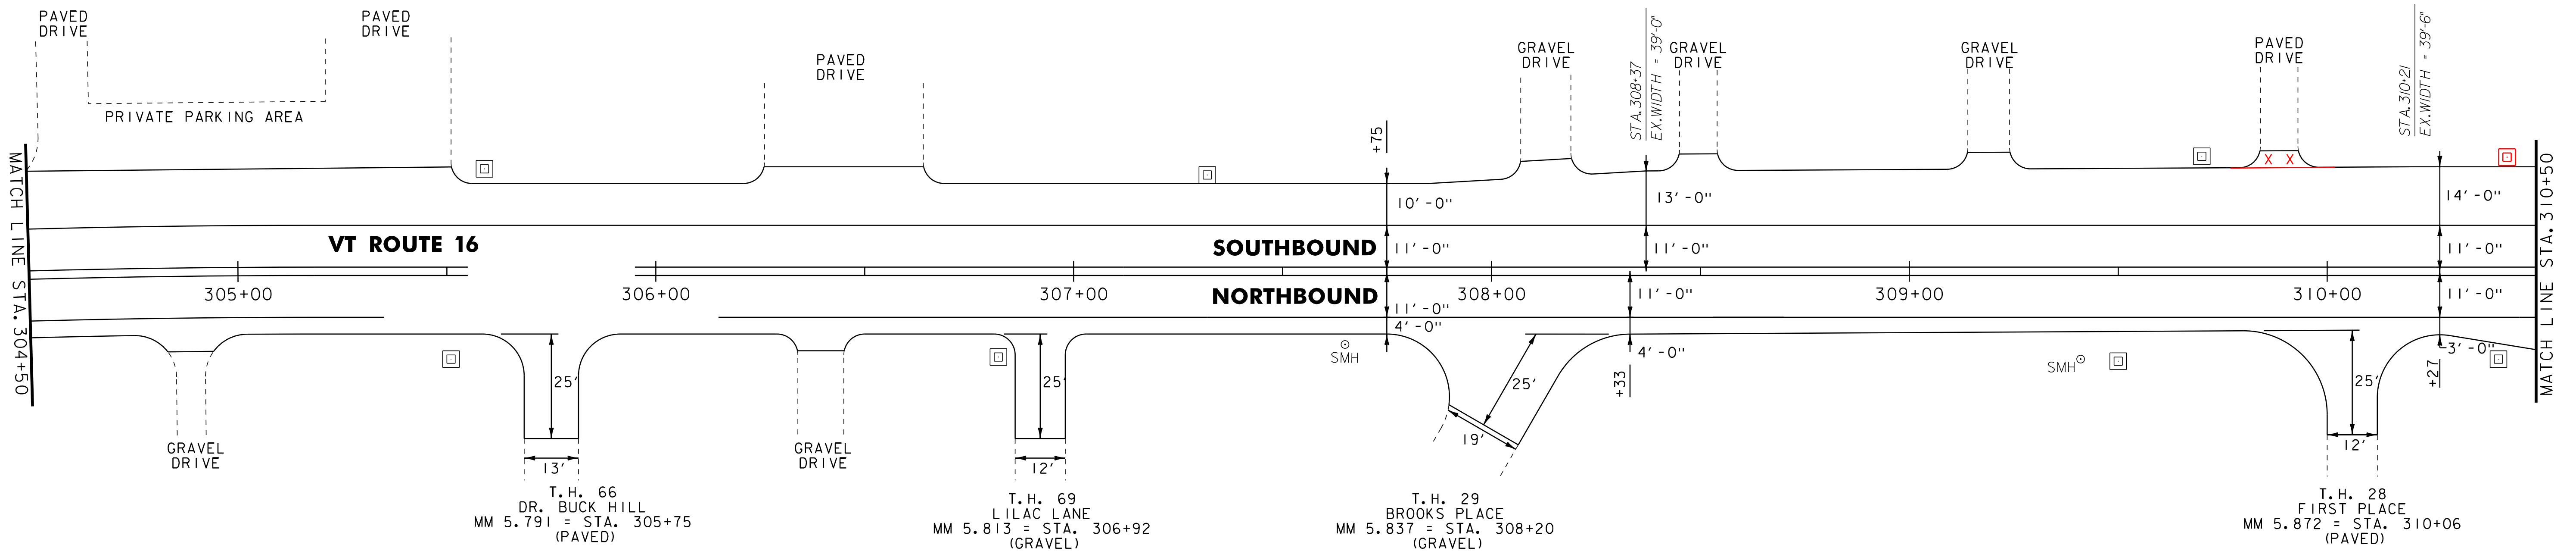

- NOTES:
- FOR LEGENDS, SEE LAYOUT SHEET #1.
  - ALL EXISTING SIGNS NOT SHOWN SHALL BE RETAINED.

NOT TO SCALE

**PROJECT LAYOUT SHEET #16**



PROJECT NAME: GLOVER - BARTON	FILE NAME: p01b034.dgn	PLOT DATE: 28-NOV-2012 15:00
PROJECT NUMBER: STP 2318(I)	PROJECT LEADER: JLL	DRAWN BY: STANTEC
	DESIGNED BY: STANTEC	CHECKED BY: STANTEC
	IPARM FILE: p01b034116.i	SHEET 28 OF 60