

604.412 OR 604.415 REHAB.
 Dis. CBs OR MHS, CLASS I OR II
 STA. 311+85, RT
 STA. 311+96, LT
 STA. 313+11, RT
 STA. 313+38, LT
 STA. 313+98, RT
 STA. 314+37, LT
 STA. 315+11, RT

621.21 HD STEEL BEAM GUARDRAIL, GALVANIZED
 STA. 314+91.0 TO 315+06.0, LT 315+25.5, LT
 STA. 315+56.0 TO 315+68.0, RT 315+68.5, RT
 STA. 315+97.0 TO 316+09.0, LT
 (SEE BRIDGE DETAIL SHEETS)
 STA. 316+34 TO 316+50 RT
 621.53 TERMINAL CONNECTOR FOR STEEL BEAM GUARDRAIL
 STA. 315+06.0 TO 315+31.0, LT
 STA. 316+34.0 TO 316+50.0, RT

621.60 ANCHOR FOR STEEL BEAM RAIL
 STA. 315+56.0, RT STA. 314+91, LT
 STA. 316+09.0, LT

621.80 REMOVAL AND DISPOSAL OF GUARDRAIL
 STA. 314+90 TO 315+31, LT
 STA. 315+56 TO 315+68, RT
 STA. 315+97 TO 316+09, LT
 STA. 316+34 TO 316+50, RT

646.402 DURABLE 4 INCH WHITE LINE, THERMOPLASTIC
 (ALL LINES WILL INCLUDE EDGE LINE BREAKS AND
 RADIUS FOR SIDE ROADS)
 STA. 310+50 TO 316+50, SOLID LT & RT
 (INCLUDES DIAGONALS)
 STA. 314+72, SOLID RT (DEXTER MOUNTAIN ROAD)
 STA. 314+83, SOLID LT (BEAN HILL ROAD)
 STA. 314+83, SOLID RT (MILL PLACE)
 STA. 314+83, SOLID RT (MILL PLACE PARKING STALLS)

646.412 DURABLE 4 INCH YELLOW LINE, THERMOPLASTIC
 (ALL LINES WILL INCLUDE C BREAKS FOR SIDE ROADS)
 STA. 310+50 TO 316+50, SOLID LT & RT
 STA. 314+72, DOUBLE SOLID RT (DEXTER MOUNTAIN ROAD)
 STA. 314+83, DOUBLE SOLID LT (BEAN HILL ROAD)
 STA. 314+83, DOUBLE SOLID RT (MILL PLACE)

646.482 DURABLE 24 INCH STOP BAR, THERMOPLASTIC
 STA. 314+72, RT (DEXTER MOUNTAIN ROAD)
 STA. 314+83, RT (MILL PLACE)
 STA. 314+83, LT (BEAN HILL ROAD)

646.492 DURABLE LETTER OR SYMBOL, THERMOPLASTIC
 STA. 314+72, RT (DEXTER MOUNTAIN ROAD) - "STOP"
 STA. 314+83, RT (MILL PLACE) - "STOP"
 STA. 314+83, LT (BEAN HILL ROAD) - "STOP"

646.502 DURABLE CROSSWALK MARKING, THERMOPLASTIC
 STA. 311+94, RT TO 312+03, LT


646.602 TEMPORARY 4 INCH WHITE LINE, PAINT
 (ALL LINES WILL INCLUDE EDGE LINE BREAKS AND
 RADIUS FOR SIDE ROADS)
 STA. 310+50 TO 316+50, SOLID LT & RT
 (INCLUDES DIAGONALS)
 STA. 314+72, SOLID RT (DEXTER MOUNTAIN ROAD)
 STA. 314+83, SOLID LT (BEAN HILL ROAD)
 STA. 314+83, SOLID RT (MILL PLACE)
 STA. 314+83, SOLID RT (MILL PLACE PARKING STALLS)

646.612 TEMPORARY 4 INCH YELLOW LINE, PAINT
 (ALL LINES WILL INCLUDE C BREAKS FOR SIDE ROADS)
 STA. 310+50 TO 316+50, SOLID LT & RT
 STA. 314+72, DOUBLE SOLID RT (DEXTER MOUNTAIN ROAD)
 STA. 314+83, DOUBLE SOLID LT (BEAN HILL ROAD)
 STA. 314+83, DOUBLE SOLID RT (MILL PLACE)

646.622 TEMPORARY LETTER OR SYMBOL, PAINT
 STA. 314+72, RT (DEXTER MOUNTAIN ROAD) - "STOP"
 STA. 314+83, RT (MILL PLACE) - "STOP"
 STA. 314+83, LT (BEAN HILL ROAD) - "STOP"

646.602 TEMPORARY CROSSWALK MARKING, PAINT
 STA. 311+94, RT TO 312+03, LT

646.702 TEMPORARY CROSSWALK MARKING, PAINT
 STA. 311+94, RT TO 312+03, LT

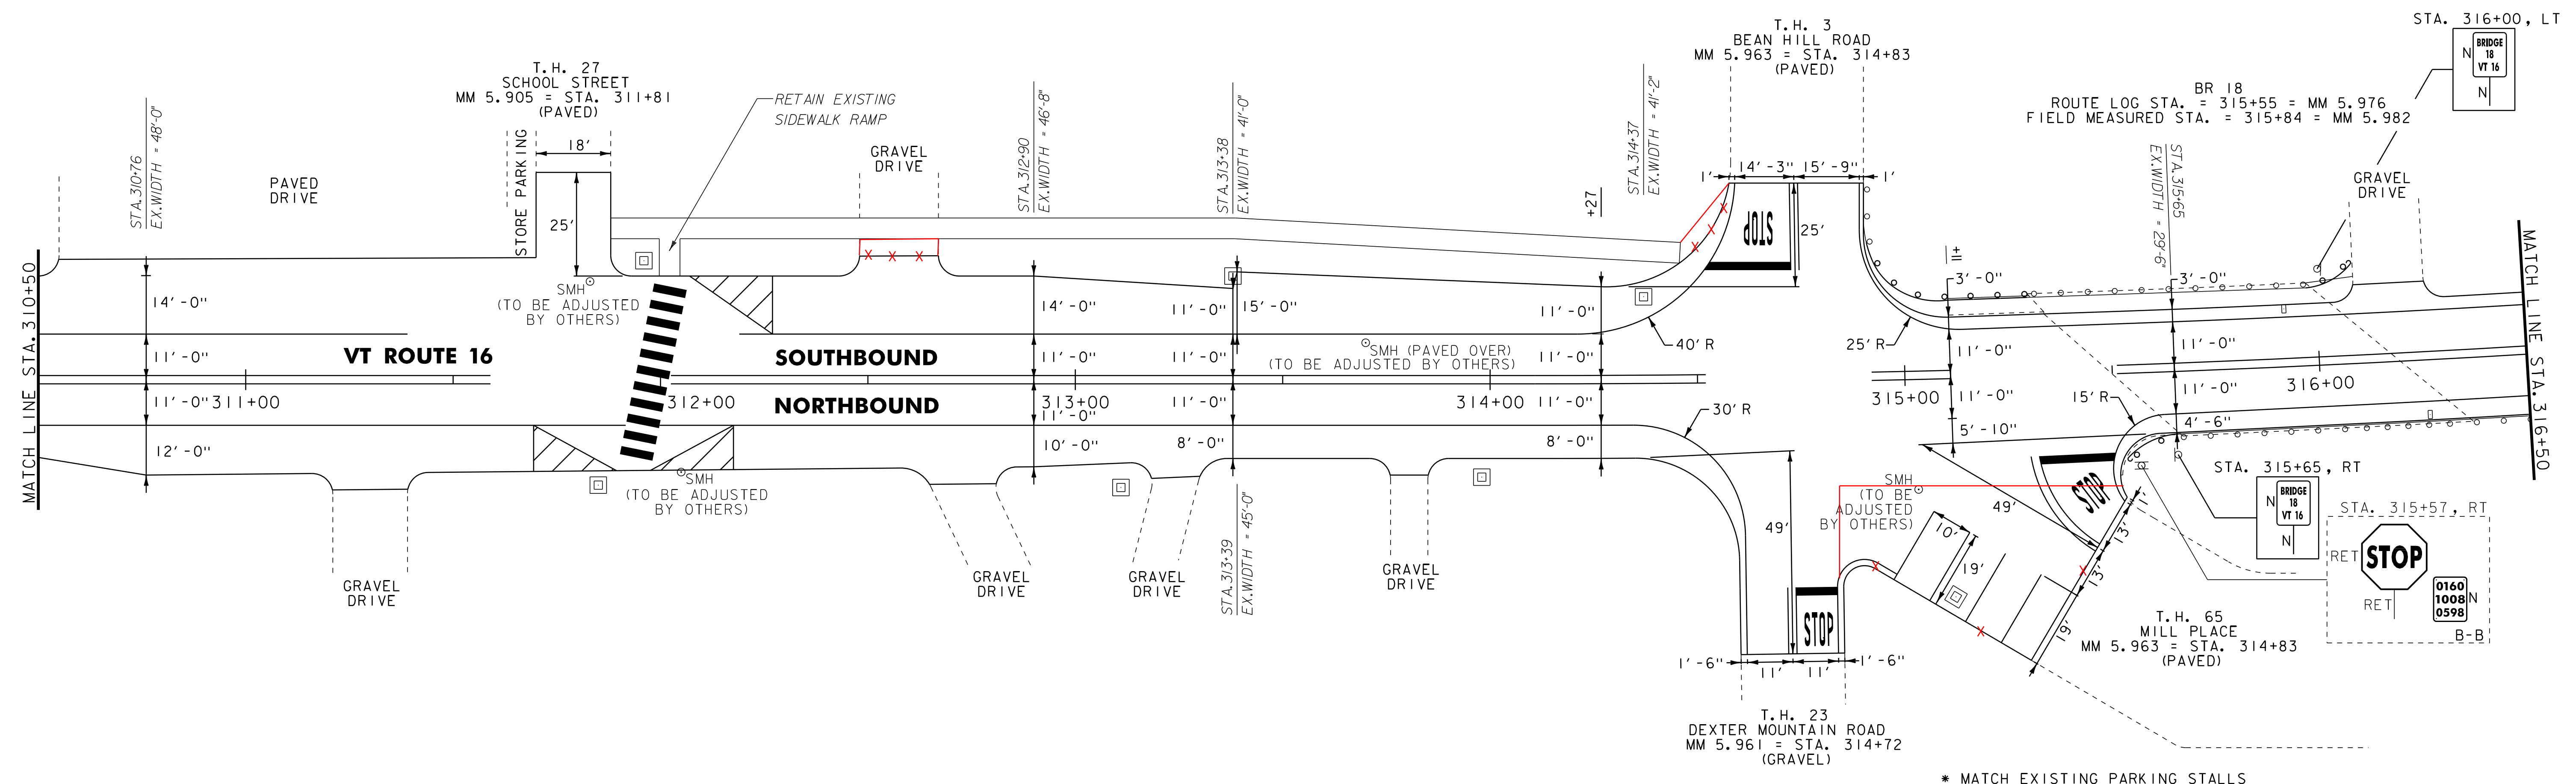

* MATCH EXISTING PARKING STALLS

- NOTES:
- FOR LEGENDS, SEE LAYOUT SHEET #1.
 - ALL EXISTING SIGNS NOT SHOWN SHALL BE RETAINED.

NOT TO SCALE

PROJECT LAYOUT SHEET #17	PROJECT NAME: GLOVER - BARTON	FILE NAME: p01b034.dgn	PLOT DATE: 28-NOV-2012 15:00
	PROJECT NUMBER: STP 2318(I)	PROJECT LEADER: JLL	DRAWN BY: STANTEC
	DESIGNED BY: STANTEC	CHECKED BY: STANTEC	
	IPARM FILE: p01b034I17.i		SHEET 29 OF 60

