

604.412 OR 604.415 REHAB.  
DIS. CBS OR MHS, CLASS I OR II  
STA. 317+97, LT  
STA. 320+06, LT

621.20 STEEL BEAM GUARDRAIL, GALVANIZED  
STA. 316+59.0 TO 317+09.0, RT 317+23.5  
STA. 319+63.5 TO 322+50.0, RT

621.21 HO STEEL BEAM GUARDRAIL, GALVANIZED  
STA. 316+50 TO 316+59 RT

621.53 TERMINAL CONNECTOR FOR STEEL BEAM GUARDRAIL  
STA. 316+50.0 TO 316+59.0, RT

621.60 ANCHOR FOR STEEL BEAM RAIL  
STA. 317+09.0, RT 317+23.5, RT  
STA. 319+63.5, RT

621.80 REMOVAL AND DISPOSAL OF GUARDRAIL  
STA. 316+50 TO 317+11, RT  
STA. 319+65 TO 322+50, RT

646.402 DURABLE 4 INCH WHITE LINE, THERMOPLASTIC  
(ALL LINES WILL INCLUDE EDGE LINE BREAKS AND  
RADI FOR SIDE ROADS)  
STA. 316+50 TO 322+50, SOLID LT & RT

646.412 DURABLE 4 INCH YELLOW LINE, THERMOPLASTIC  
(ALL LINES WILL INCLUDE @ BREAKS FOR SIDE ROADS)  
STA. 316+50 TO 322+50, SOLID LT & RT

646.602 TEMPORARY 4 INCH WHITE LINE, PAINT  
(ALL LINES WILL INCLUDE EDGE LINE BREAKS AND  
RADI FOR SIDE ROADS)  
STA. 316+50 TO 322+50, SOLID LT & RT


646.612 TEMPORARY 4 INCH YELLOW LINE, PAINT  
(ALL LINES WILL INCLUDE @ BREAKS FOR SIDE ROADS)  
STA. 316+50 TO 322+50, SOLID LT & RT

675.50 REMOVING SIGNS  
AS SHOWN - +

675.60 ERECTING SALVAGED SIGNS  
AS SHOWN - +

619.17 YIELDING MARKER POSTS  
STA. 319+95, LT

613.11 STONE FILL, TYPE I  
STA. 320+10, RT (SLOPE EROSION REPAIR)

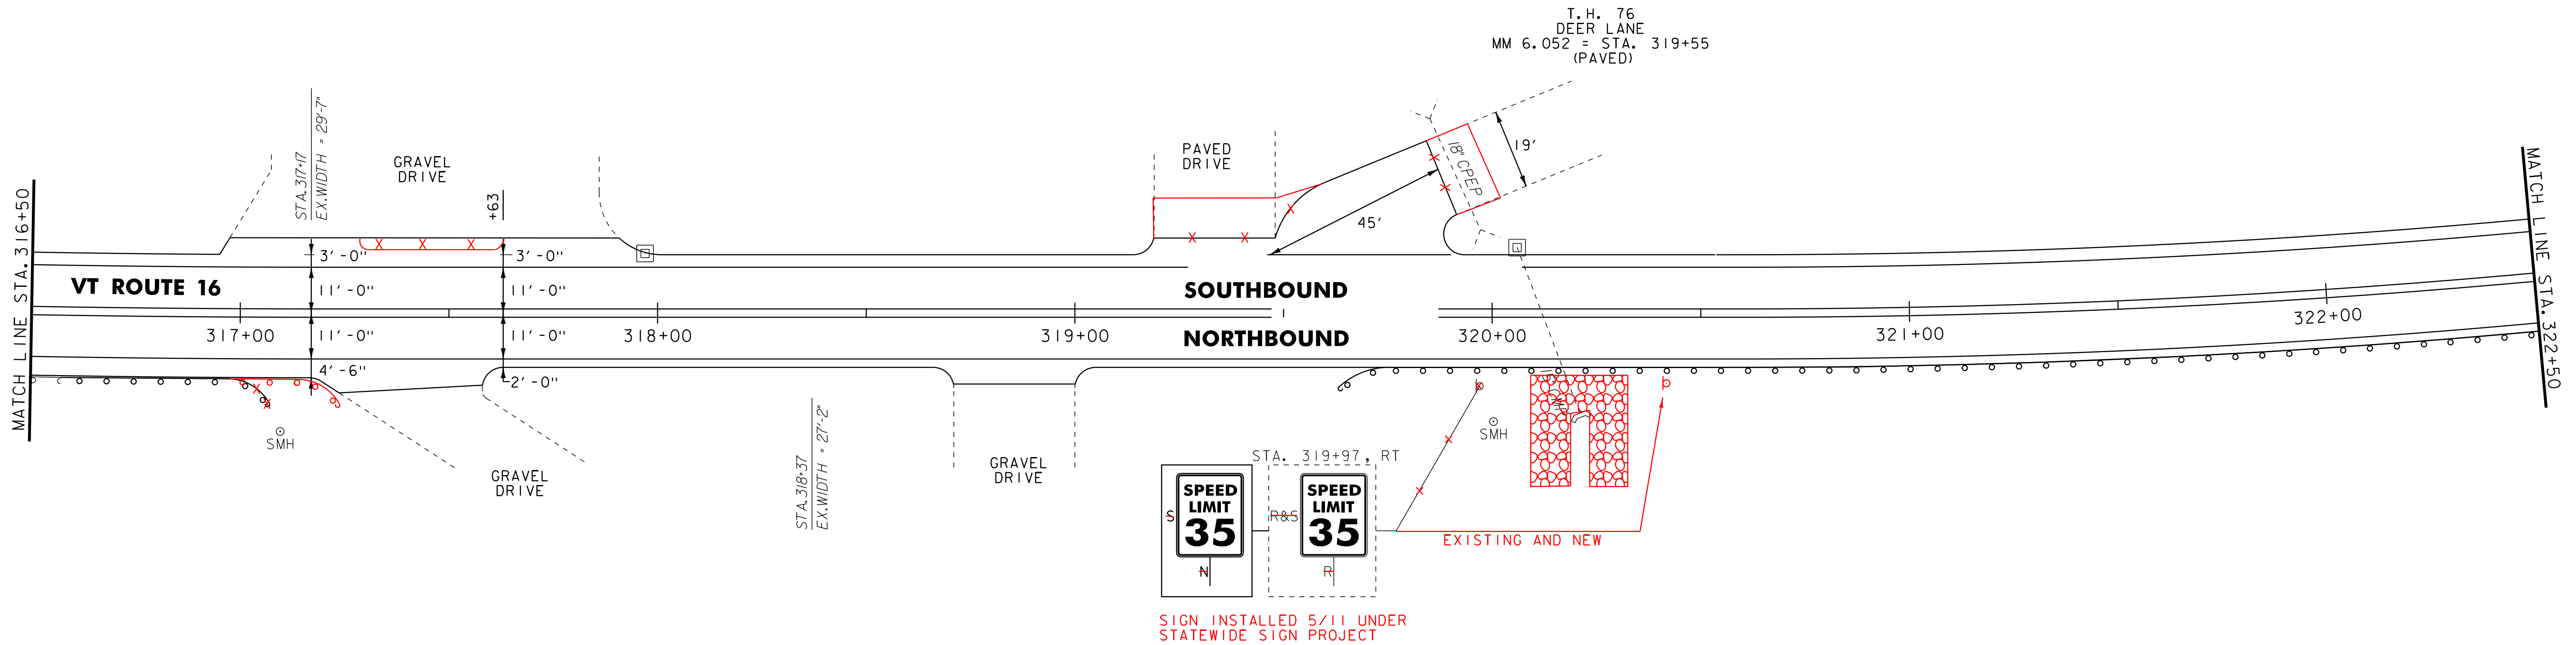

- NOTES:
- FOR LEGENDS, SEE LAYOUT SHEET #1.
  - ALL EXISTING SIGNS NOT SHOWN SHALL BE RETAINED.

NOT TO SCALE

**PROJECT LAYOUT SHEET #18**



PROJECT NAME: GLOVER - BARTON  
PROJECT NUMBER: STP 2318(I)

FILE NAME: p01b034.dgn  
PROJECT LEADER: JLL  
DESIGNED BY: STANTEC  
IPARM FILE: p01b034\18.i

PLOT DATE: 28-NOV-2012 15:0  
DRAWN BY: STANTEC  
CHECKED BY: STANTEC  
SHEET 30 OF 60