

604.412 OR 604.415 REHAB.
DIS, CBS OR MHS, CLASS I OR II
STA. 322+84, LT
STA. 325+17, LT


621.20 STEEL BEAM GUARDRAIL, GALVANIZED
STA. 322+50.0 TO 327+26.0, RT
30
621.60 ANCHOR FOR STEEL BEAM RAIL
STA. 327+26.0, RT
30
621.80 REMOVAL AND DISPOSAL OF GUARDRAIL
STA. 322+50 TO 327+26, RT
27.5

646.402 DURABLE 4 INCH WHITE LINE, THERMOPLASTIC
(ALL LINES WILL INCLUDE EDGE LINE BREAKS AND
RADI FOR SIDE ROADS)
STA. 322+50 TO 327+50, SOLID LT & RT
646.412 DURABLE 4 INCH YELLOW LINE, THERMOPLASTIC
(ALL LINES WILL INCLUDE C BREAKS FOR SIDE ROADS)
STA. 322+50 TO 327+50, SOLID LT & RT

646.602 TEMPORARY 4 INCH WHITE LINE, PAINT
(ALL LINES WILL INCLUDE EDGE LINE BREAKS AND
RADI FOR SIDE ROADS)
STA. 322+50 TO 327+50, SOLID LT & RT
646.612 TEMPORARY 4 INCH YELLOW LINE, PAINT
(ALL LINES WILL INCLUDE C BREAKS FOR SIDE ROADS)
STA. 322+50 TO 327+50, SOLID LT & RT

619.17 YIELDING MARKER POSTS
STA. 326+60, RT

621.205 STEEL BEAM GUARDRAIL, WITH 8FT POST
STA. 319+63.5 TO 327+30, RT

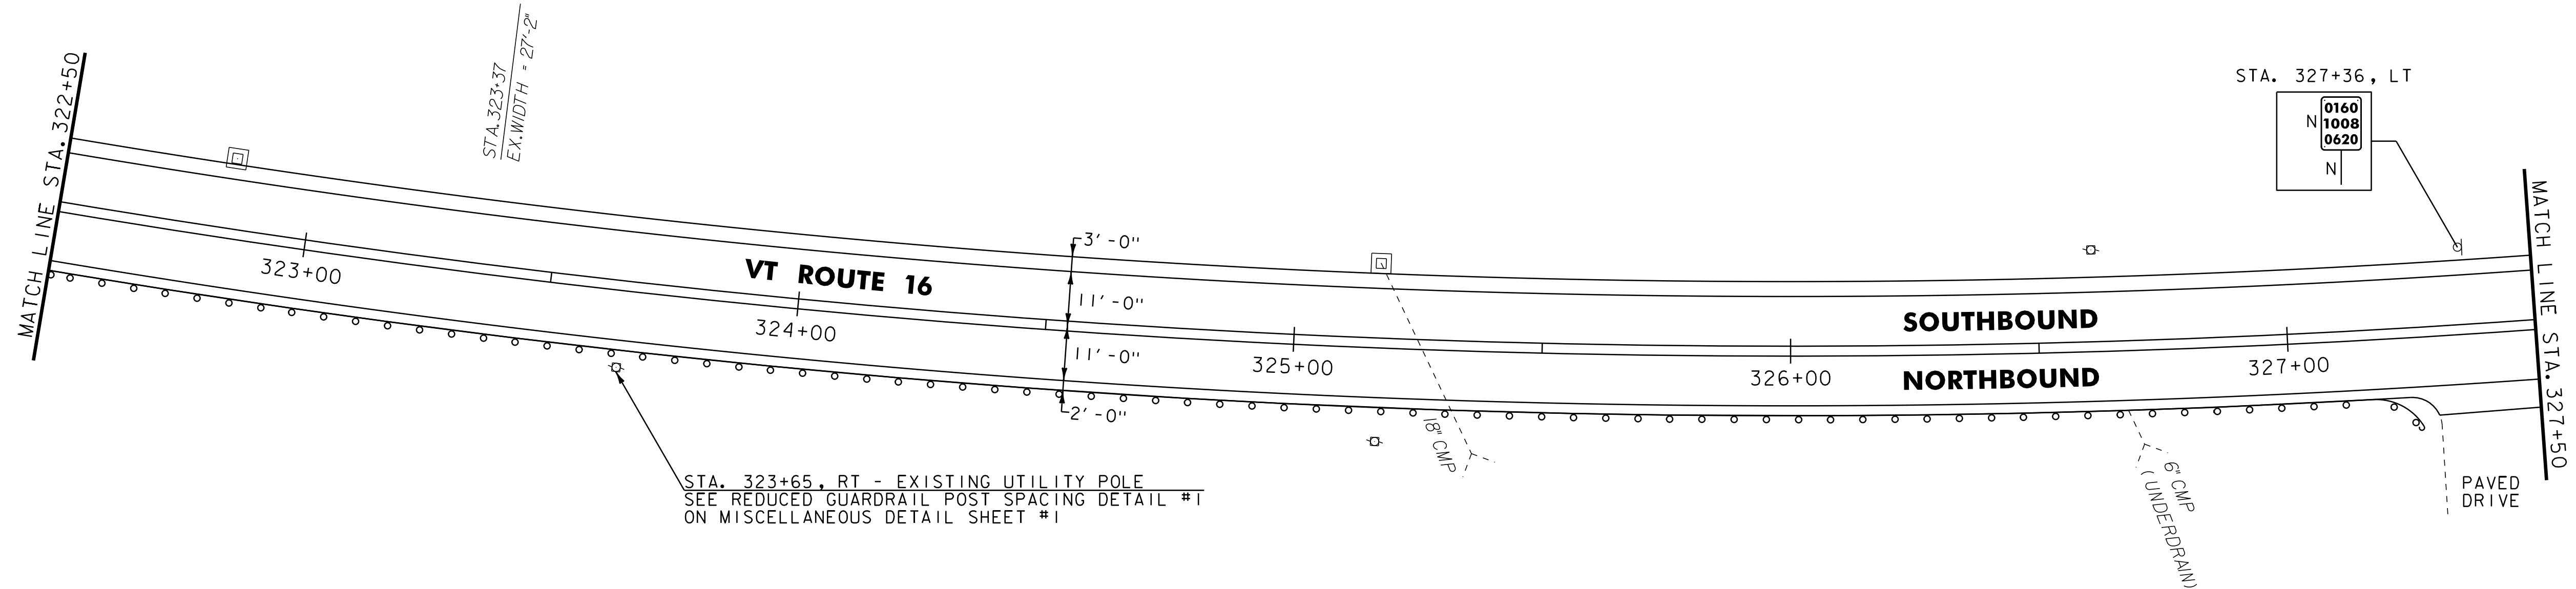


646.402 DURABLE 4 INCH WHITE LINE, THERMOPLASTIC
(ALL LINES WILL INCLUDE EDGE LINE BREAKS AND
RADI FOR SIDE ROADS)
STA. 327+50 TO 333+50, SOLID LT & RT

646.602 TEMPORARY 4 INCH WHITE LINE, PAINT
(ALL LINES WILL INCLUDE EDGE LINE BREAKS AND
RADI FOR SIDE ROADS)
STA. 327+50 TO 333+50, SOLID LT & RT

604.412 REHAB. DJ
STA. 329+65, LT

646.412 DURABLE 4 INCH YELLOW LINE, THERMOPLASTIC
(ALL LINES WILL INCLUDE C BREAKS FOR SIDE ROADS)
STA. 327+50 TO 333+50, SOLID LT & RT

646.612 TEMPORARY 4 INCH YELLOW LINE, PAINT
(ALL LINES WILL INCLUDE C BREAKS FOR SIDE ROADS)
STA. 327+50 TO 333+50, SOLID LT & RT

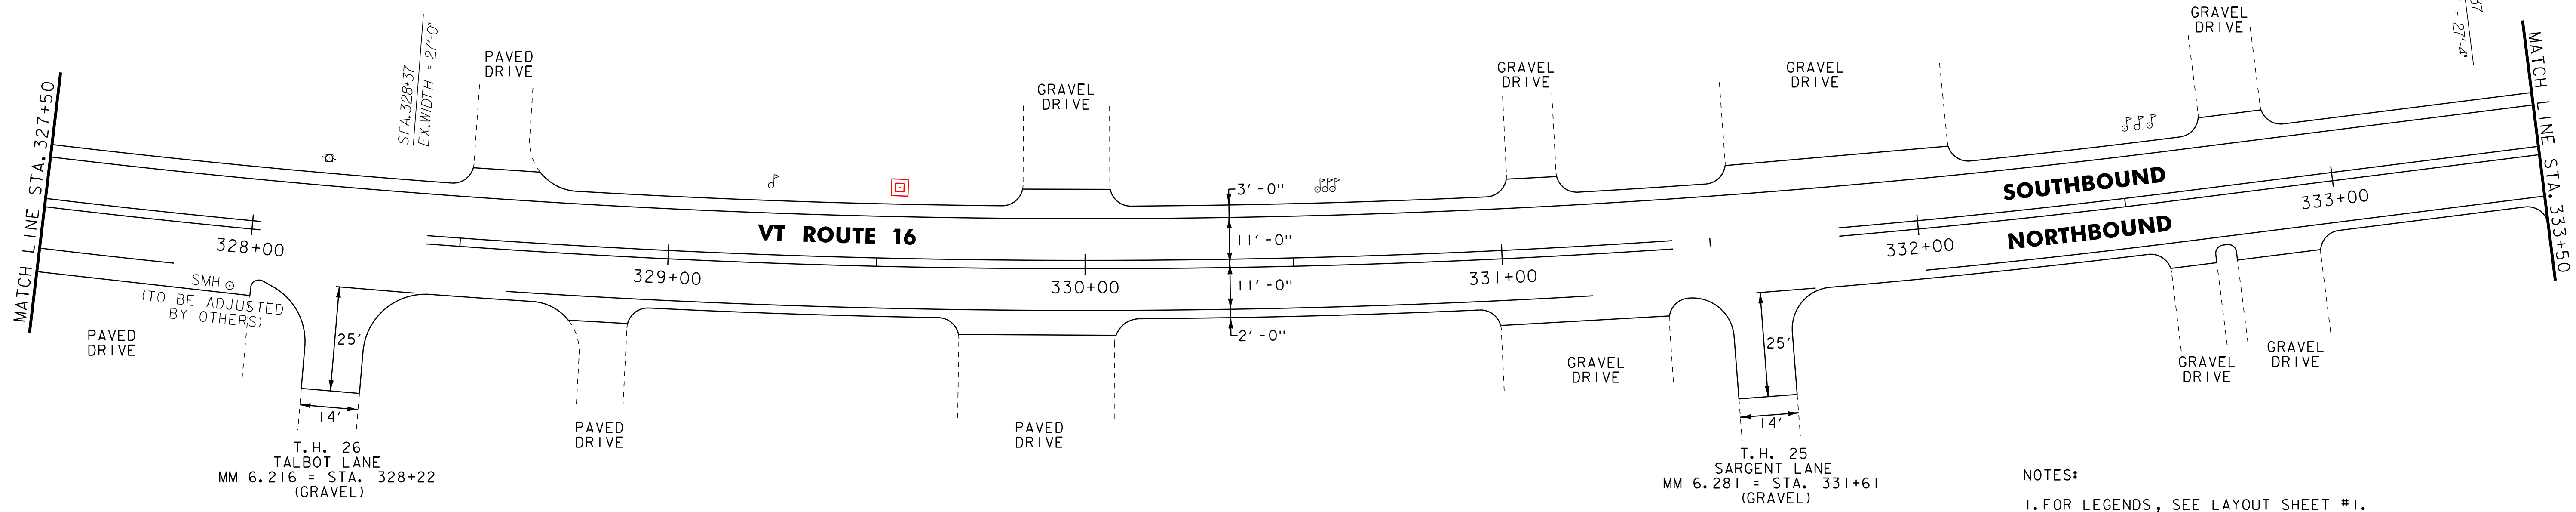

- NOTES:
- FOR LEGENDS, SEE LAYOUT SHEET #1.
 - ALL EXISTING SIGNS NOT SHOWN SHALL BE RETAINED.

NOT TO SCALE



PROJECT LAYOUT SHEET #19

PROJECT NAME: GLOVER - BARTON	FILE NAME: p01b034.dgn	PLOT DATE: 28-NOV-2012 15:0
PROJECT NUMBER: STP 2318(I)	PROJECT LEADER: JLL	DRAWN BY: STANTEC
	DESIGNED BY: STANTEC	CHECKED BY: STANTEC
	IPARM FILE: p01b034I19.i	SHEET 31 OF 60