

617.10 RELOCATE MAILBOX, SINGLE SUPPORT
STA. 335+50, LT

621.20 STEEL BEAM GUARDRAIL, GALVANIZED
STA. 337+69.5 TO 339+50.0, RT
STA. 339+29.0 TO 339+50.0, LT
(SEE BRIDGE DETAIL SHEETS)

621.60 ANCHOR FOR STEEL BEAM RAIL
STA. 337+69.5, RT
STA. 339+29.0, LT

621.80 REMOVAL AND DISPOSAL OF GUARDRAIL
STA. 337+67 TO 339+50, RT
STA. 339+24 TO 339+50, LT

646.402 DURABLE 4 INCH WHITE LINE, THERMOPLASTIC
(ALL LINES WILL INCLUDE EDGE LINE BREAKS AND
RADI1 FOR SIDE ROADS)
STA. 333+50 TO 339+50, SOLID LT & RT

646.412 DURABLE 4 INCH YELLOW LINE, THERMOPLASTIC
(ALL LINES WILL INCLUDE @ BREAKS FOR SIDE ROADS)
STA. 333+50 TO 339+50, SOLID LT & RT
STA. 335+09, DOUBLE SOLID LT (BAILEY LANE)

646.482 DURABLE 24 INCH STOP BAR, THERMOPLASTIC
STA. 335+09, LT (BAILEY LANE)

646.492 DURABLE LETTER OR SYMBOL, THERMOPLASTIC
STA. 335+09, LT (BAILEY LANE) - "STOP"

646.602 TEMPORARY 4 INCH WHITE LINE, PAINT
(ALL LINES WILL INCLUDE EDGE LINE BREAKS AND
RADI1 FOR SIDE ROADS)
STA. 333+50 TO 339+50, SOLID LT & RT


646.612 TEMPORARY 4 INCH YELLOW LINE, PAINT
(ALL LINES WILL INCLUDE @ BREAKS FOR SIDE ROADS)
STA. 333+50 TO 339+50, SOLID LT & RT
STA. 335+09, DOUBLE SOLID LT (BAILEY LANE)

646.682 TEMPORARY 24 INCH STOP BAR, PAINT
STA. 335+09, LT (BAILEY LANE)

646.692 TEMPORARY LETTER OR SYMBOL, PAINT
STA. 335+09, LT (BAILEY LANE) - "STOP"

675.50 REMOVING SIGNS
AS SHOWN - 3

675.60 ERECTING SALVAGED SIGNS
AS SHOWN - 2

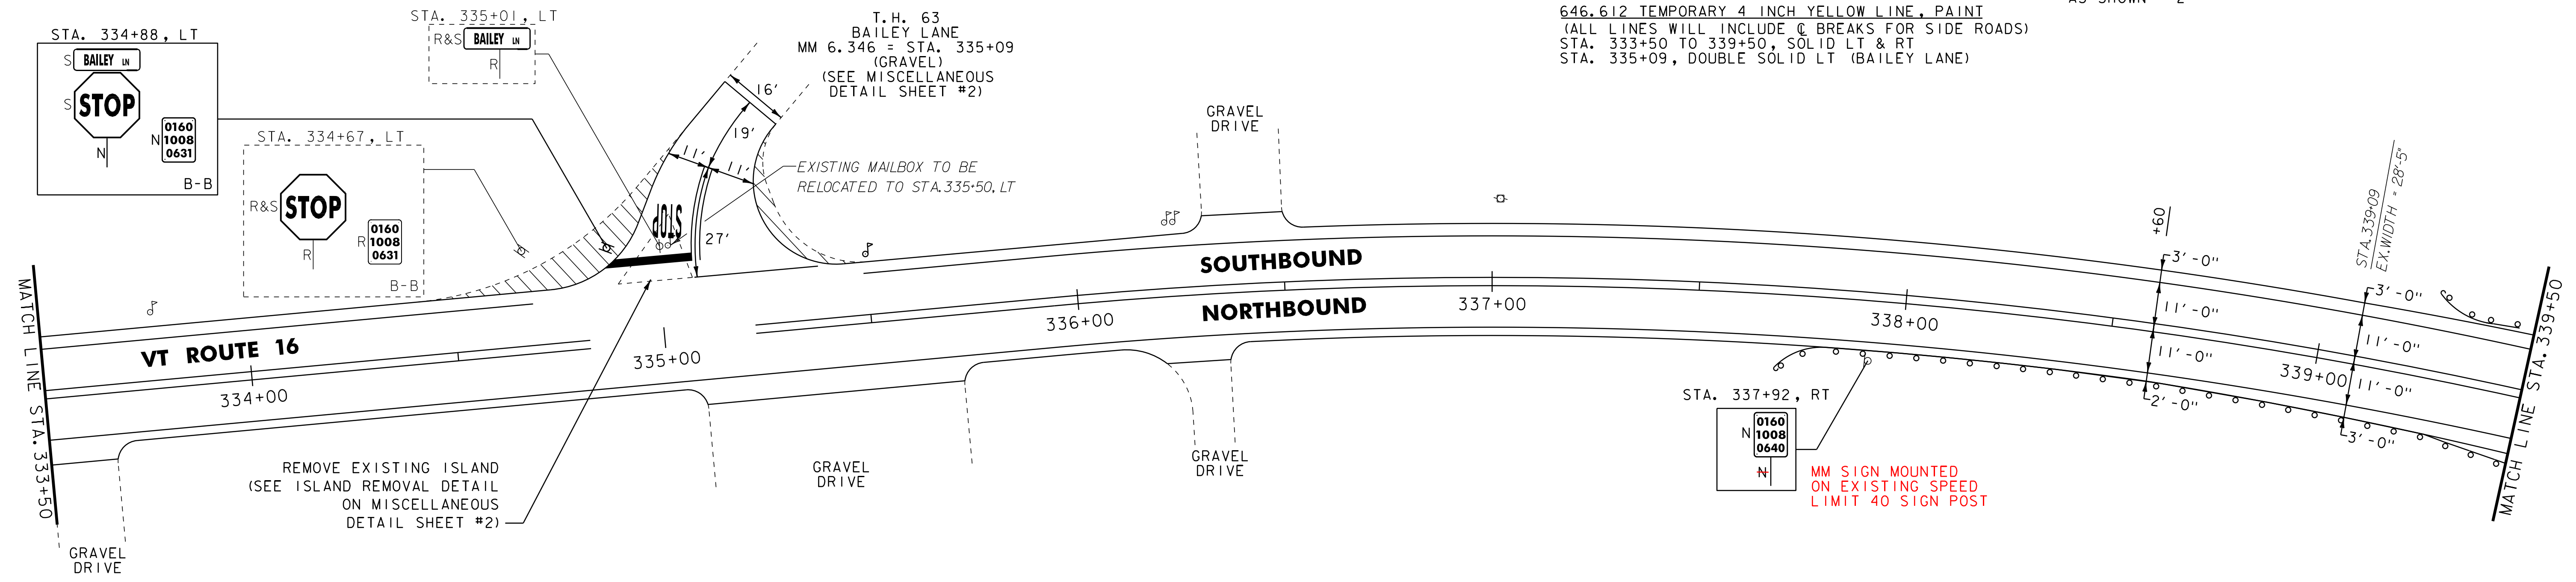

621.20 STEEL BEAM GUARDRAIL, GALVANIZED
STA. 339+50.0 TO 339+79.0, LT
STA. 339+50.0 TO 339+57.0, RT
STA. 340+78.0 TO 340+90.5, RT
STA. 341+00.0 TO 342+50.0, LT

621.21 HD STEEL BEAM GUARDRAIL, GALVANIZED
621.53 TERMINAL CONNECTOR FOR STEEL BEAM GUARDRAIL
STA. 339+57.0 TO 339+82.0, RT
STA. 339+79.0 TO 340+04.0, LT
STA. 340+53.0 TO 340+78.0, RT
STA. 340+75.0 TO 341+00.0, LT
(SEE BRIDGE DETAIL SHEETS)

621.60 ANCHOR FOR STEEL BEAM RAIL
STA. 340+90.5, RT
STA. 342+50.0, LT

621.80 REMOVAL AND DISPOSAL OF GUARDRAIL
STA. 339+50 TO 339+82, RT
STA. 339+50 TO 339+99, LT
STA. 340+57 TO 340+94, RT
STA. 340+75 TO 342+52, LT


646.402 DURABLE 4 INCH WHITE LINE, THERMOPLASTIC
(ALL LINES WILL INCLUDE EDGE LINE BREAKS AND
RADI1 FOR SIDE ROADS)
STA. 339+50 TO 345+50, SOLID LT & RT

646.412 DURABLE 4 INCH YELLOW LINE, THERMOPLASTIC
(ALL LINES WILL INCLUDE @ BREAKS FOR SIDE ROADS)
STA. 339+50 TO 345+50, SOLID LT & RT

646.602 TEMPORARY 4 INCH WHITE LINE, PAINT
(ALL LINES WILL INCLUDE EDGE LINE BREAKS AND
RADI1 FOR SIDE ROADS)
STA. 339+50 TO 345+50, SOLID LT & RT

646.612 TEMPORARY 4 INCH YELLOW LINE, PAINT
(ALL LINES WILL INCLUDE @ BREAKS FOR SIDE ROADS)
STA. 339+50 TO 345+50, SOLID LT & RT

619.17 YIELDING MARKER POSTS
STA. 343+70, RT

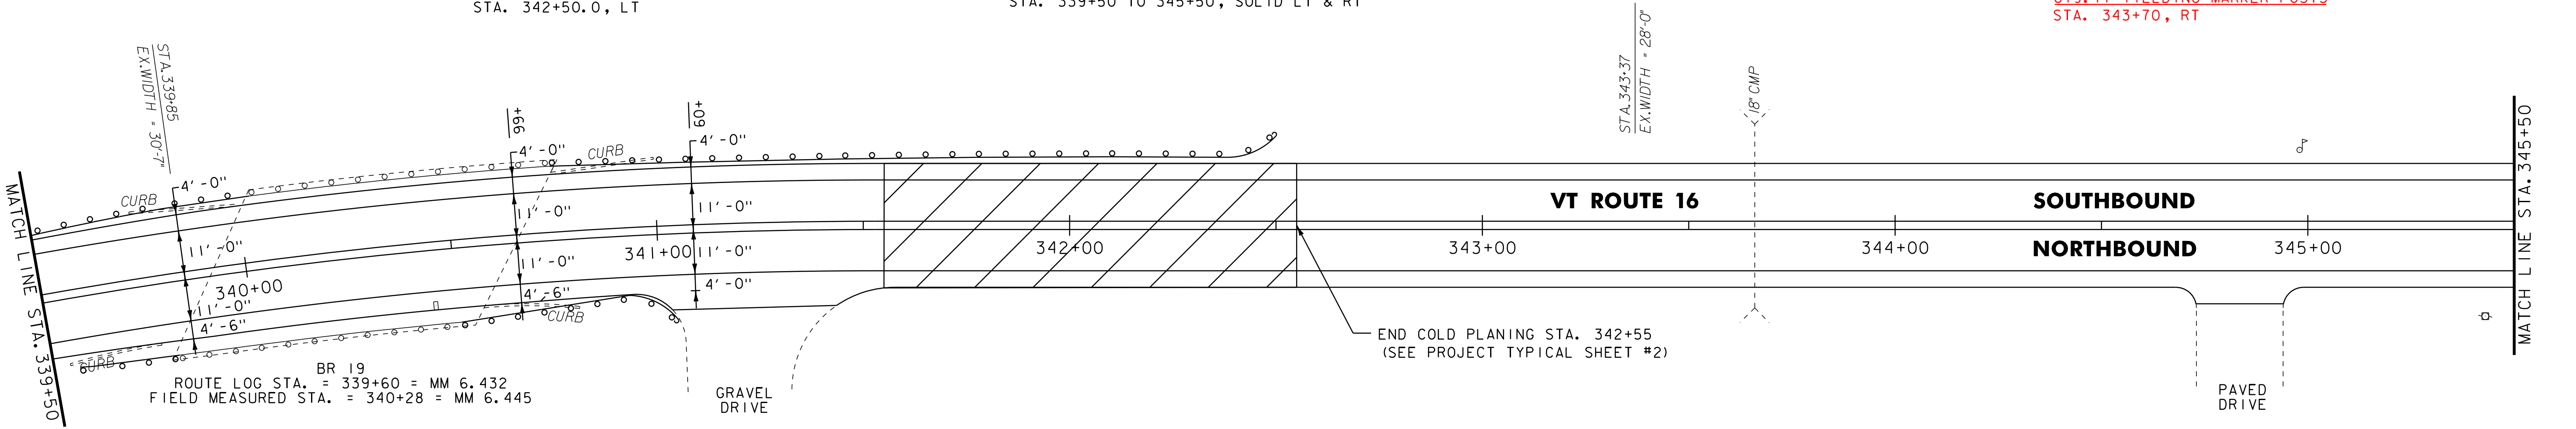

- NOTES:
- FOR LEGENDS, SEE LAYOUT SHEET #1.
 - ALL EXISTING SIGNS NOT SHOWN SHALL BE RETAINED.

NOT TO SCALE

PROJECT LAYOUT SHEET #20	PROJECT NAME: GLOVER - BARTON	
	PROJECT NUMBER: STP 2318(I)	
	FILE NAME: p01b034.dgn	PLOT DATE: 28-NOV-2012 15:0
	PROJECT LEADER: JLL	DRAWN BY: STANTEC
DESIGNED BY: STANTEC	CHECKED BY: STANTEC	
IPARM FILE: p01b034I20.i	SHEET 32 OF 60	

TRANSITION AREA
SEE PROJECT TYPICAL SHEET #2

