

617.10 RELOCATE MAILBOX, SINGLE SUPPORT  
 STA. 7+74, LT  
 STA. 7+76, LT  
 STA. 7+78, LT

619.17 YIELDING MARKER POSTS  
 STA. 4+10, LT & RT

621.20 STEEL BEAM GUARDRAIL, GALVANIZED  
 STA. 7+08.5 TO 8+50.0, LT

621.50 MANUFACTURED TERMINAL SECTION, FLARED  
 STA. 6+71.0 TO 7+08.5, LT

621.80 REMOVAL AND DISPOSAL OF GUARDRAIL  
 STA. 6+66 TO 8+50, LT

646.402 DURABLE 4 INCH WHITE LINE, THERMOPLASTIC  
 (ALL LINES WILL INCLUDE EDGE LINE BREAKS AND  
 RADII FOR SIDE ROADS)  
 STA. 3+00 TO 8+50, SOLID LT & RT


646.412 DURABLE 4 INCH YELLOW LINE, THERMOPLASTIC  
 (ALL LINES WILL INCLUDE @ BREAKS FOR SIDE ROADS)  
 STA. 3+00 TO 8+50, SOLID LT & RT

646.602 TEMPORARY 4 INCH WHITE LINE, PAINT  
 (ALL LINES WILL INCLUDE EDGE LINE BREAKS AND  
 RADII FOR SIDE ROADS)  
 STA. 3+00 TO 8+50, SOLID LT & RT

646.612 TEMPORARY 4 INCH YELLOW LINE, PAINT  
 (ALL LINES WILL INCLUDE @ BREAKS FOR SIDE ROADS)  
 STA. 3+00 TO 8+50, SOLID LT & RT

675.50 REMOVING SIGNS  
 AS SHOWN - +

675.60 ERECTING SALVAGED SIGNS  
 AS SHOWN - +

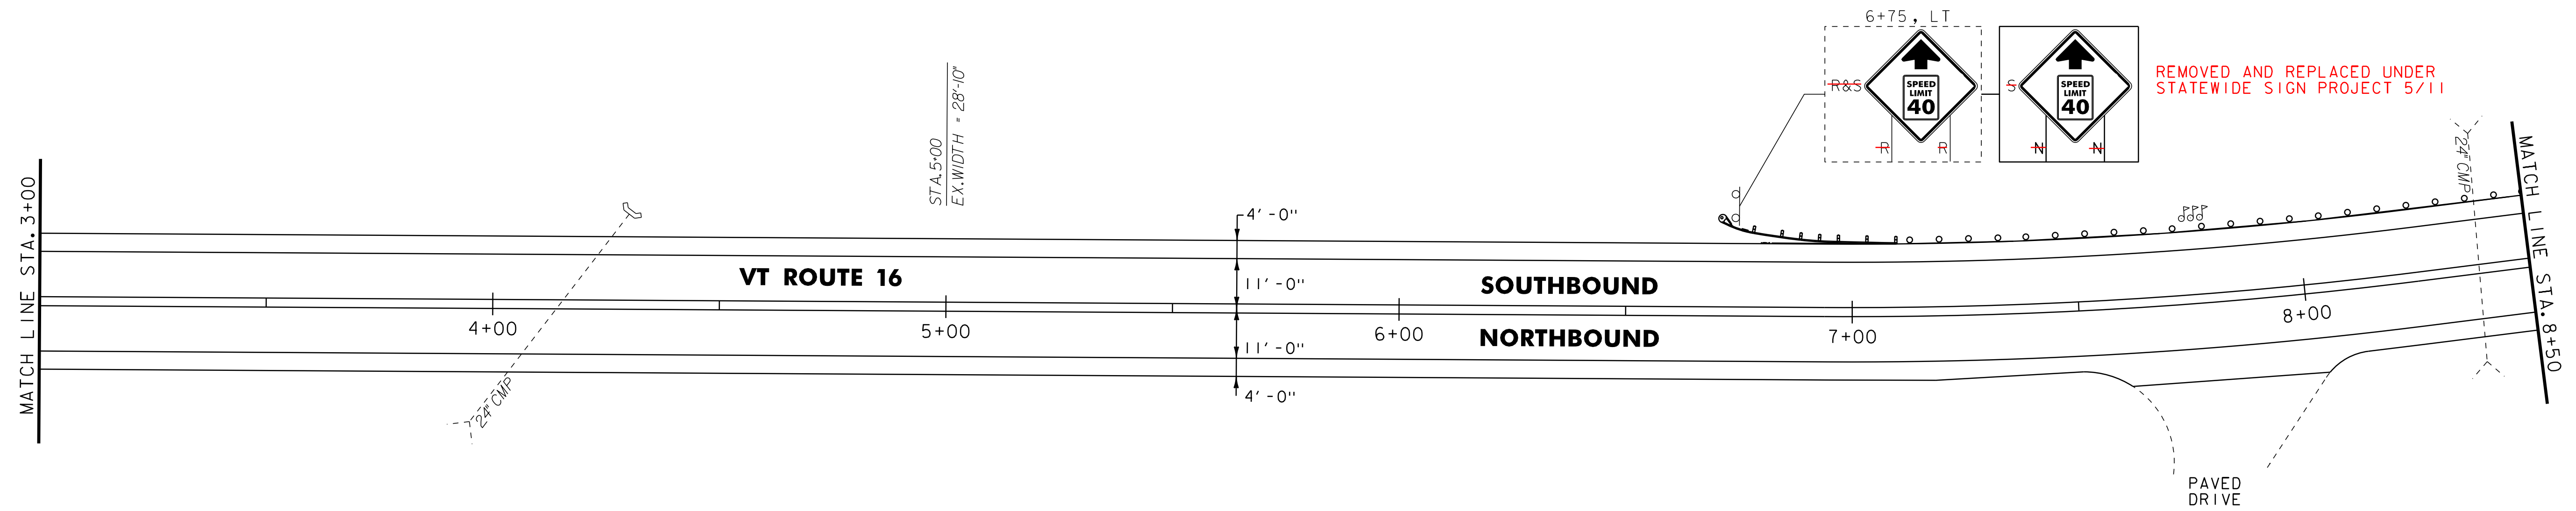

621.20 STEEL BEAM GUARDRAIL, GALVANIZED  
 STA. 8+50.0 TO 9+58.5, LT 8+83.5  
 STA. 9+08 TO 9+85.5, LT  
 621.50 MANUFACTURED TERMINAL SECTION, FLARED  
 STA. 9+58.5 TO 9+96.0, LT

621.80 REMOVAL AND DISPOSAL OF GUARDRAIL  
 STA. 8+50 TO 9+71, LT

646.402 DURABLE 4 INCH WHITE LINE, THERMOPLASTIC  
 (ALL LINES WILL INCLUDE EDGE LINE BREAKS AND  
 RADII FOR SIDE ROADS)  
 STA. 8+50 TO 14+50, SOLID LT & RT  
 STA. 10+16, SOLID LT (FULTON LANE)

646.412 DURABLE 4 INCH YELLOW LINE, THERMOPLASTIC  
 (ALL LINES WILL INCLUDE @ BREAKS FOR SIDE ROADS)  
 STA. 8+50 TO 14+50, SOLID LT & RT  
 STA. 10+16, DOUBLE SOLID LT (FULTON LANE)

646.482 DURABLE 24 INCH STOP BAR, THERMOPLASTIC  
 STA. 10+16, LT (FULTON LANE)  
 646.492 DURABLE LETTER OR SYMBOL, THERMOPLASTIC  
 STA. 10+16, LT (FULTON LANE) - "STOP"

621.60 ANCHOR FOR STEEL BEAM RAIL  
 STA. 9+85.5, LT

621.205 STEEL BEAM GUARDRAIL, WITH 8FT POST  
 STA. 8+83.5 TO 9+08.5, LT

646.602 TEMPORARY 4 INCH WHITE LINE, PAINT  
 (ALL LINES WILL INCLUDE EDGE LINE BREAKS AND  
 RADII FOR SIDE ROADS)  
 STA. 8+50 TO 14+50, SOLID LT & RT  
 STA. 10+16, SOLID LT (FULTON LANE)


646.612 TEMPORARY 4 INCH YELLOW LINE, PAINT  
 (ALL LINES WILL INCLUDE @ BREAKS FOR SIDE ROADS)  
 STA. 8+50 TO 14+50, SOLID LT & RT  
 STA. 10+16, DOUBLE SOLID LT (FULTON LANE)

646.682 TEMPORARY 24 INCH STOP BAR, PAINT  
 STA. 10+16, LT (FULTON LANE)

646.692 TEMPORARY LETTER OR SYMBOL, PAINT  
 STA. 10+16, LT (FULTON LANE) - "STOP"

675.50 REMOVING SIGNS  
 AS SHOWN - +

675.60 ERECTING SALVAGED SIGNS  
 AS SHOWN - +

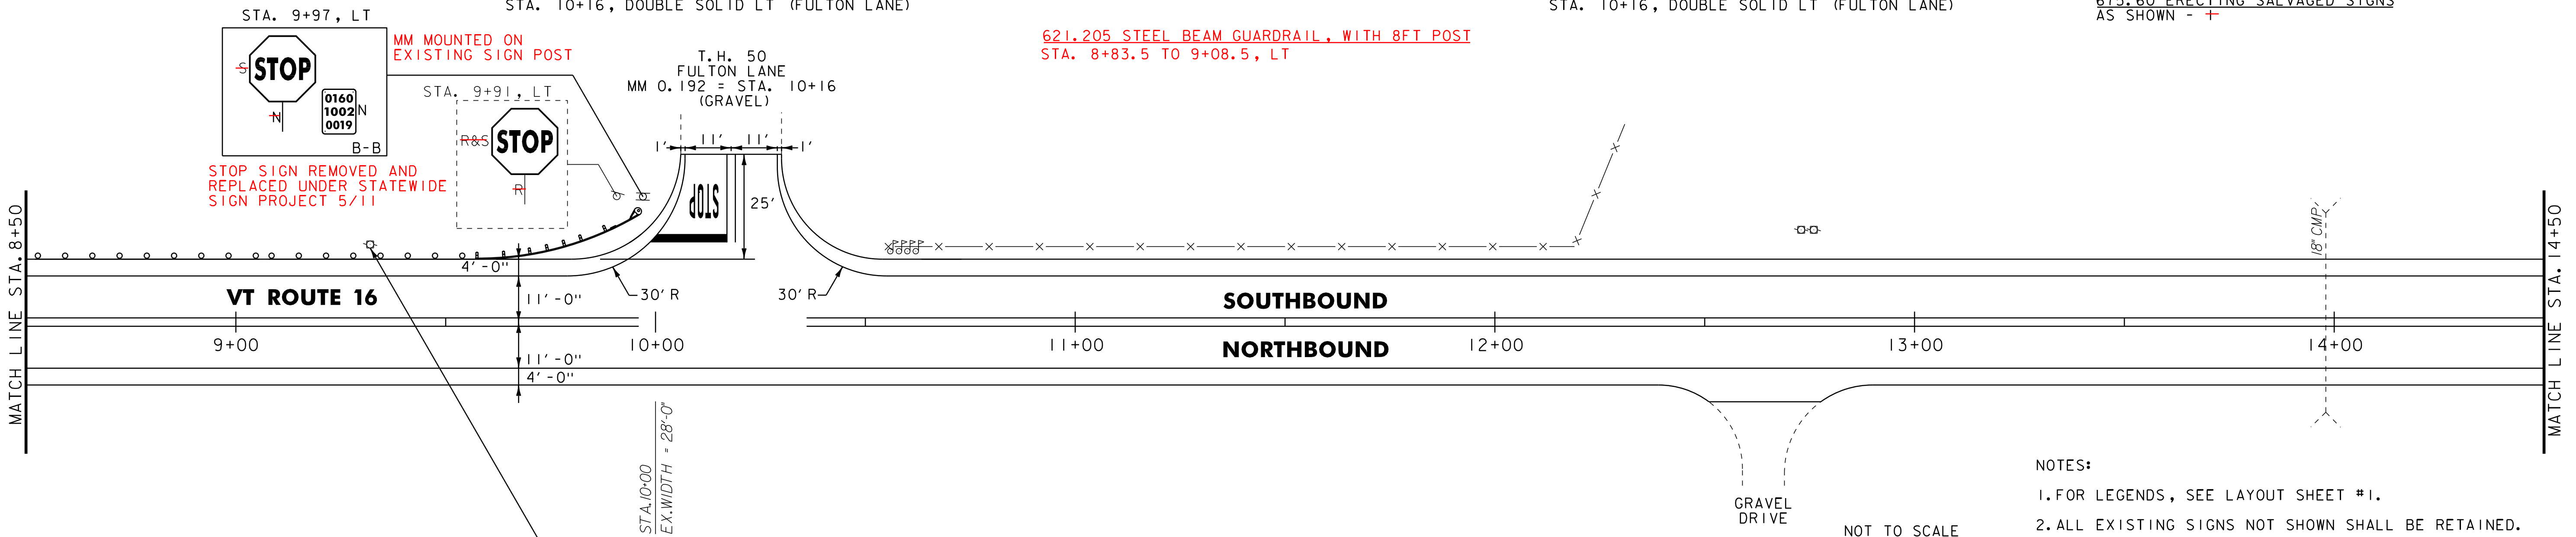

STA. 9+32, LT - EXISTING UTILITY POLE  
 SEE REDUCED GUARDRAIL POST SPACING DETAIL #2  
 ON MISCELLANEOUS DETAIL SHEET #1

- NOTES:
1. FOR LEGENDS, SEE LAYOUT SHEET #1.
  2. ALL EXISTING SIGNS NOT SHOWN SHALL BE RETAINED.

PROJECT NAME: GLOVER - BARTON  
 PROJECT NUMBER: STP 2318(I)

FILE NAME: p01b034.dgn  
 PROJECT LEADER: JLL  
 DESIGNED BY: STANTEC  
 IPARM FILE: p01b034I22.i

PLOT DATE: 28-NOV-2012 15:0  
 DRAWN BY: STANTEC  
 CHECKED BY: STANTEC  
 SHEET 34 OF 60



**PROJECT  
 LAYOUT  
 SHEET #22**