


646.402 DURABLE 4 INCH WHITE LINE, THERMOPLASTIC  
 (ALL LINES WILL INCLUDE EDGE LINE BREAKS AND RADI FOR SIDE ROADS)  
 STA. 56+50 TO 62+50, SOLID LT & RT

646.412 DURABLE 4 INCH YELLOW LINE, THERMOPLASTIC  
 (ALL LINES WILL INCLUDE @ BREAKS FOR SIDE ROADS)  
 STA. 56+50 TO 58+42, SOLID LT & RT  
 STA. 58+42 TO 62+50, DOUBLE SOLID LT & RT (INCLUDING DIAGONALS)

646.602 TEMPORARY 4 INCH WHITE LINE, PAINT  
 (ALL LINES WILL INCLUDE EDGE LINE BREAKS AND RADI FOR SIDE ROADS)  
 STA. 56+50 TO 62+50, SOLID LT & RT

646.612 TEMPORARY 4 INCH YELLOW LINE, PAINT  
 (ALL LINES WILL INCLUDE @ BREAKS FOR SIDE ROADS)  
 STA. 56+50 TO 58+42, SOLID LT & RT  
 STA. 58+42 TO 62+50, DOUBLE SOLID LT & RT (INCLUDING DIAGONALS)

619.17 YIELDING MARKER POSTS  
 STA. 57+65, RT

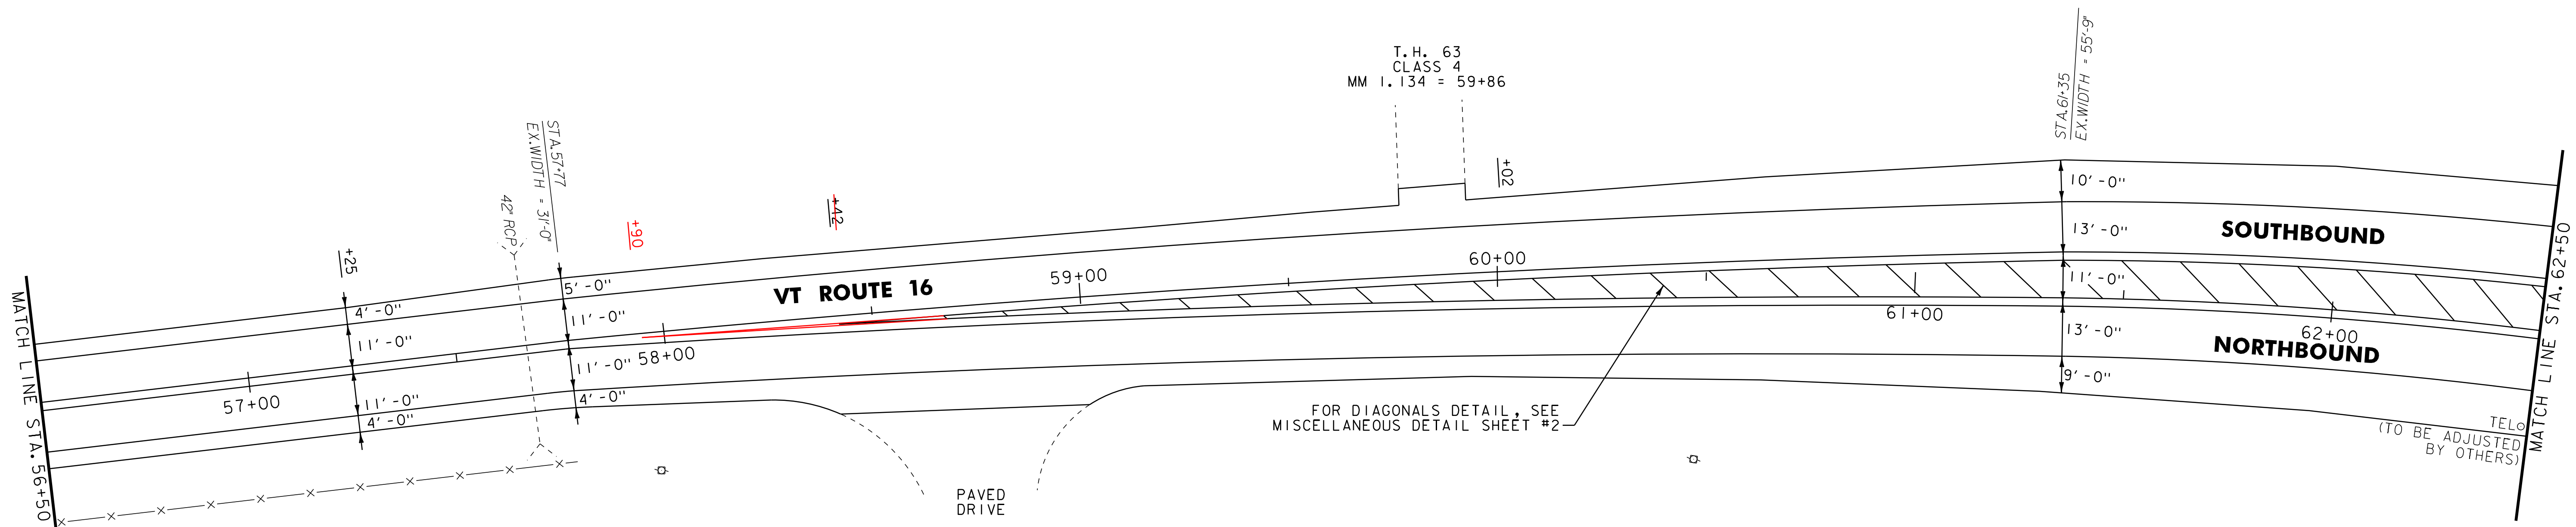

- NOTES:
- FOR LEGENDS, SEE LAYOUT SHEET #1.
  - ALL EXISTING SIGNS NOT SHOWN SHALL BE RETAINED.

NOT TO SCALE



**PROJECT LAYOUT SHEET #27**

PROJECT NAME: GLOVER - BARTON  
 PROJECT NUMBER: STP 2318(I)

FILE NAME: p01b034.dgn  
 PROJECT LEADER: JLL  
 DESIGNED BY: STANTEC  
 IPARM FILE: p01b034I27.i

PLOT DATE: 28-NOV-2012 15:0  
 DRAWN BY: STANTEC  
 CHECKED BY: STANTEC  
 SHEET 39 OF 60